




Notes:
1. All comments are applicable to similar details.
Membrane is shown in the architectural facade drawings below, however, specialised membranes are required at window reveals, including window sills, lap joints, and membrane terminations. Refer to the Inhabit F3P1 P60B. Where information is not available, liaise with the product supplier, architect, and facade consultant.
3. Glazing and its interface details need to be reviewed as part of the shop drawings for FP1.4 verification.
4. The Inhabit weatherproofing mark-ups on the architectural drawings are to be read in conjunction with the Inhabit F3P1 P60B.
5. The aluminium sill flashing shall be installed with end dams at each end and fully sealed at corners and at vertical steel post interfaces. The flashing shall be continuous and wrap around the steel posts. Junctions shall be verified by water hose testing.
6. For all screw installations between the timber/aluminium framed cladding and the substrate, apply a blob of sealant prior to installing the screw, and seal the screw heads afterwards. Stainless steel screw/anchors are to be used.
7. The following items shall be inspected and agreed during the first panel installation:
a. Lap over AM-2b with sill tape (at the top leg)
b. Weep holes within the system
c. Drainage within AM-2b

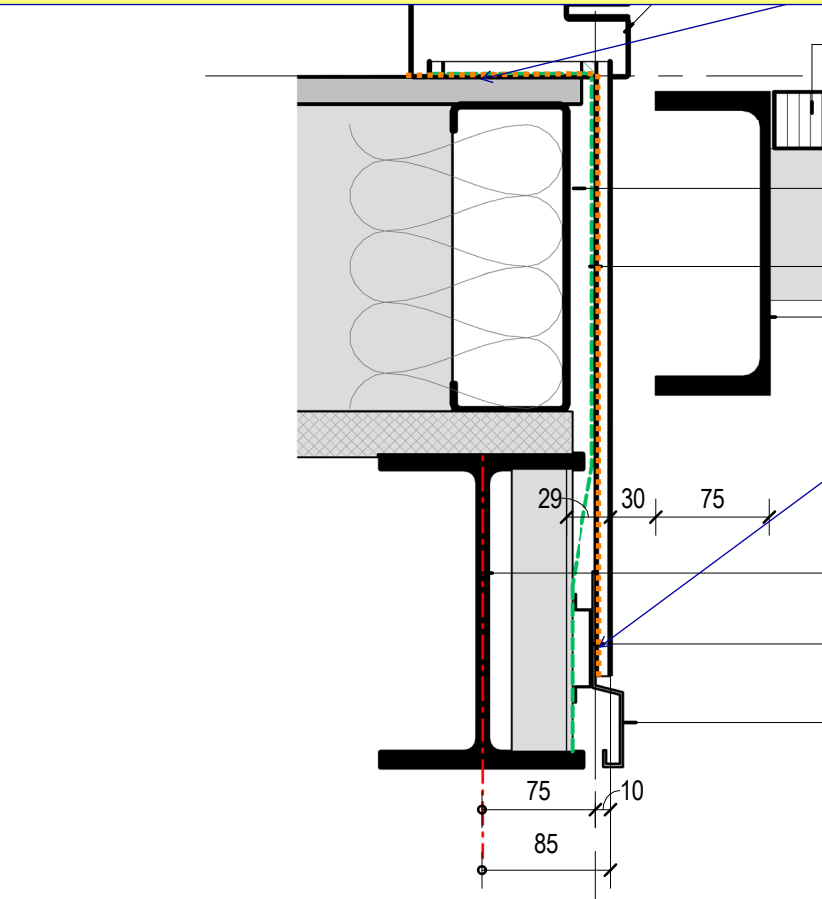


1 West Entry Link - North Edge
1:5

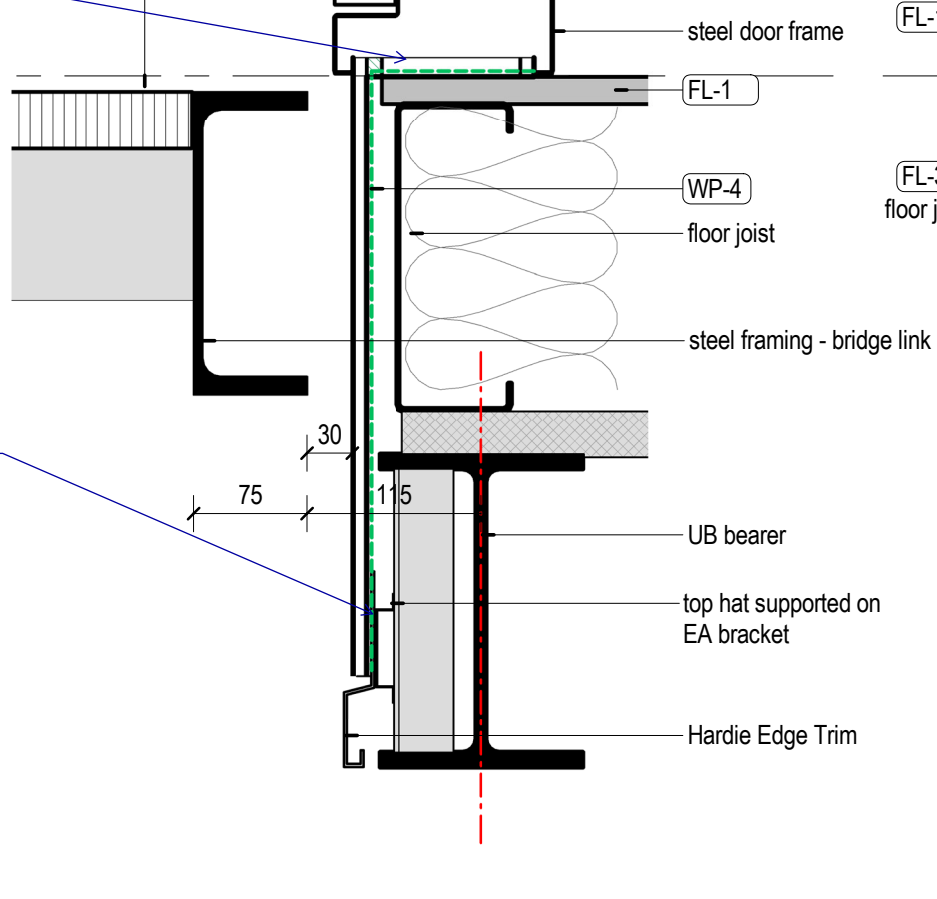


2 West Entry Link - South Edge
1:5

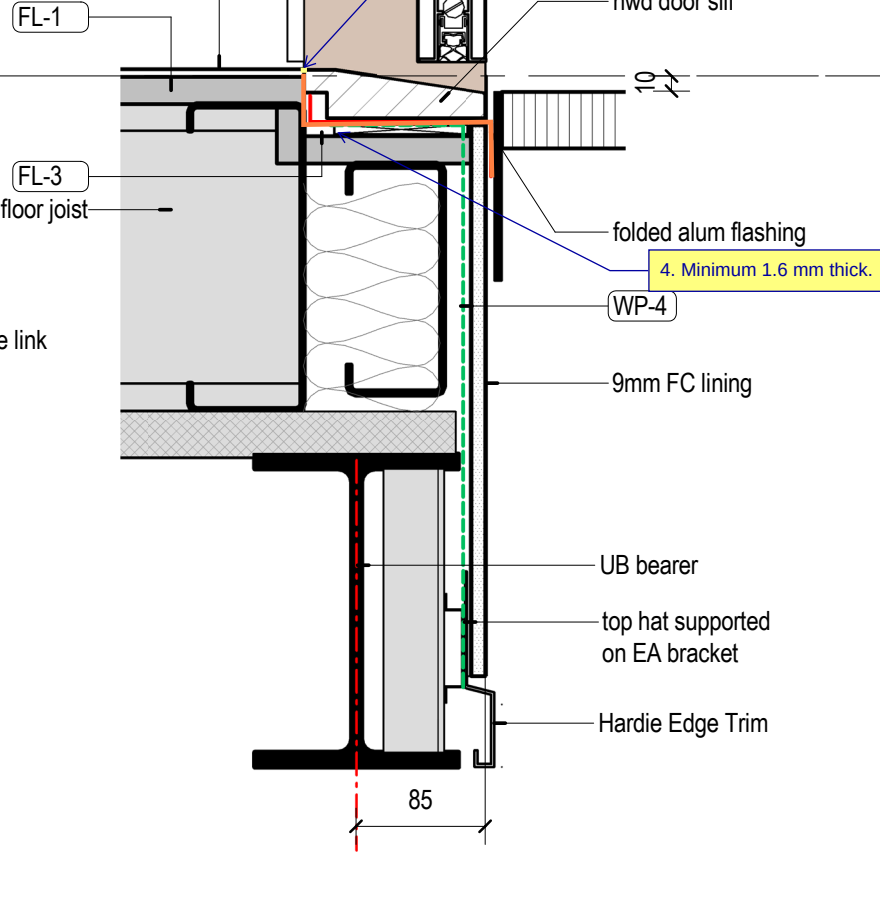


3 West Entry Link - Door Threshold
1:5

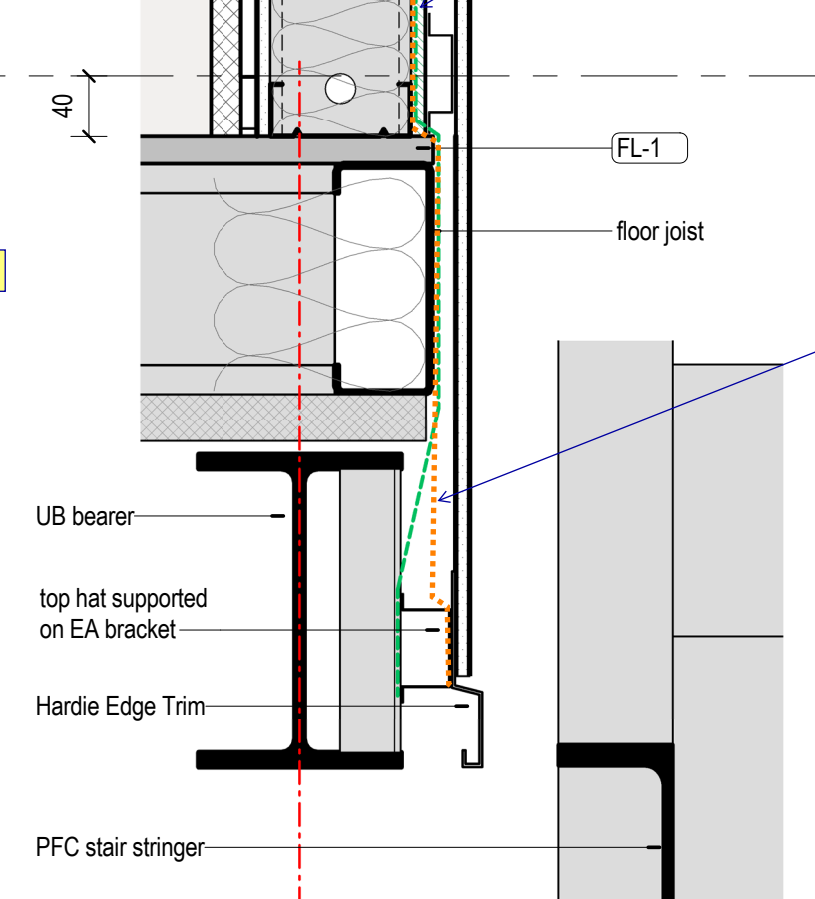

4 Stair 1 South Edge
1:5

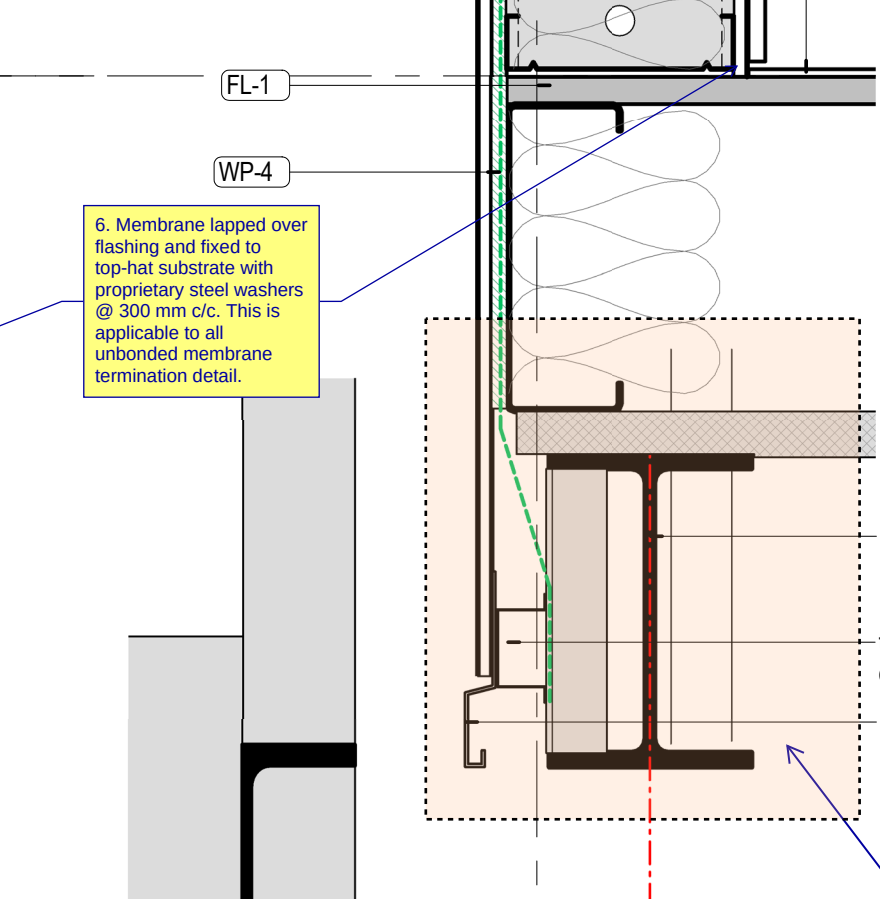

5 Stair 1 North Edge
1:5

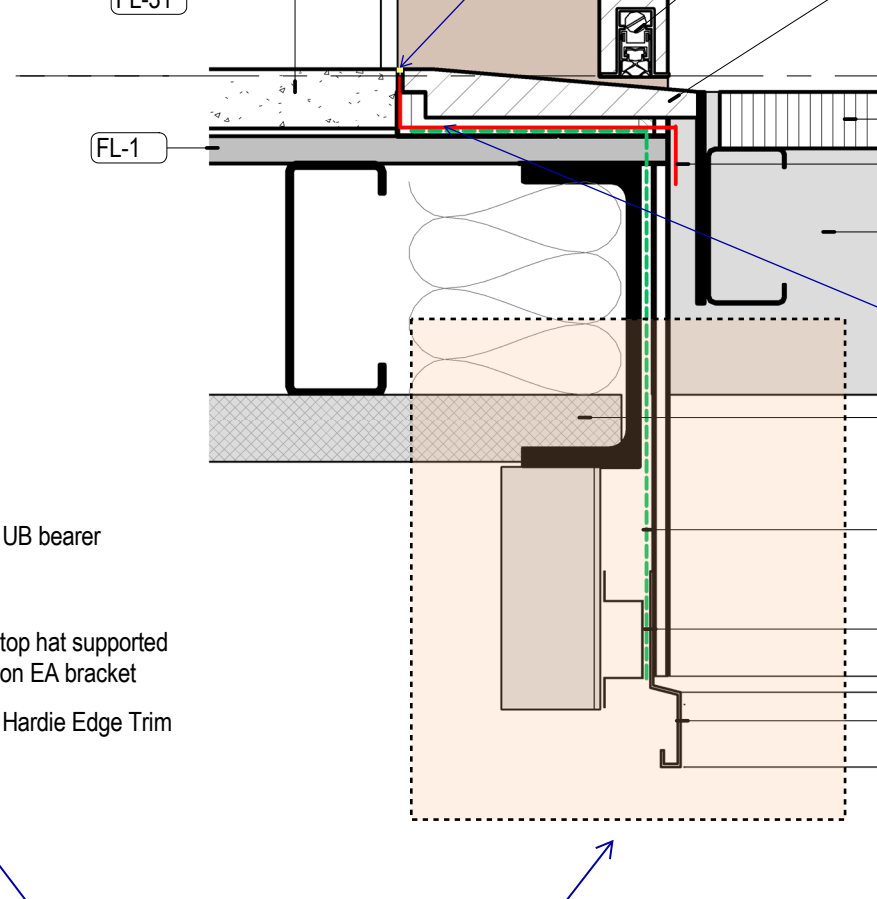

6 Stair 1 - Door Threshold
1:5

rev	date	description	initial
1	08/09/2025	QS Issue	JB
2	18/09/2025	100% DD Issue	JB
3	21/11/2025	CD Coordination Issue	JB
4	28/11/2025	Pre-Tender Estimate	JB
5	16/12/2025	Facade Detail Update	JB



Level 0
62650

8 Aluminium flashing is to be installed with end dams at each end and fully sealed at the corners and vertical steel-post interfaces. The flashing must be continuous and wrap around the steel posts.

DETAILS NOTES

- All aluminium flashings @ floor level to be min. 1.6 thick. Flashings to be installed with end dams at each end and fully sealed at the corners and vertical framing junctions. Flashings must be continuous and wrap around steel columns where they exist. Water hose test required for weatherproofing validation and flood test required for sub-sill after installation of sub-jamb & sub-sill.
- For all screw fixings between timber or aluminium framed cladding and the substrate, apply a blob of sealant before installation and seal screw heads after. Use stainless steel screws/anchors only.
- Install separation tape between dissimilar materials to prevent corrosion.

FACADE LEGEND

- WP-2 Ext. bonded membrane
- Folded aluminium flashing
- WP-1 or 3 Floor Waterproof Membrane
- WP-4 Ext. non-bonded membrane
- Roof sarking

Drawings include colour information. A black & white copy may not have all the information. This background is coloured blue.

brian hooperarchitect
m3architecture
ph +61 7 3831 4644
11 saint james street petrie tce q 4000
info@m3architecture.com
www.m3architecture.com

client **stanwell**

project **Stanwell New Projects Office**
Switchyard Road,
Stanwell, QLD, 4702

title **Section Details - Facade - Entries**


drawn bg
checked jb
date Nov 2025
scale 1:5 at A1
drawing 25010 / cd A-720002 / 5

copyright ©
These designs, plans, specifications and the copyright herein are the property of the architect and must not be used, reproduced, or copied wholly or in part without the written permission of m3architecture Pty Ltd abn 23 079 044 545. Use figured dimensions in preference to scale. If there are any questions contact the architect.


1:5 at A1
0 50 100 150 200 250mm

rev	date	description	initial
1	15/08/2025	Coordination Issue	JB
2	08/09/2025	QS Issue	JB
3	19/09/2025	100% DD Issue	JB
4	10/11/2025	Prelim Detail Issue	JB
5	21/11/2025	CD Coordination Issue	JB
6	28/11/2025	Pre-Tender Estimate	JB
7	16/12/2025	Facade Detail Update	JB


Notes:
1. All comments are applicable to similar details.
2. Membrane is shown in the architectural facade drawings below; however, specialised membranes are required at window reveals, including window sills, lap joints, and membrane terminations. Refer to the inhabit F3P1 PBD. Where information is not available, liaise with the product supplier, architect, and facade consultant.
3. Glazing and its interface details need to be reviewed as part of the shop drawings for FPI.4 verification.
4. The inhabit waterproofing mark-ups on the architectural drawings are to be read in conjunction with the inhabit F3P1 PBD.
5. The aluminium sill flashing shall be installed with end dams at each end and fully sealed at corners and at vertical steel post interfaces. The flashing shall be continuous and wrap around the steel posts. Junctions shall be verified by water hose testing.
6. For all screw installations between the timber/aluminium-framed cladding and the substrate, apply a blob of sealant prior to installing the screw, and seal the screw heads afterwards. Stainless steel screws/anchors are to be used.
7. The following items shall be respected and agreed during the first panel installation:
a. Lap over AM-2b with sill tape (at the top leg)
b. Weep holes within the system
c. Drainage within AM-2b

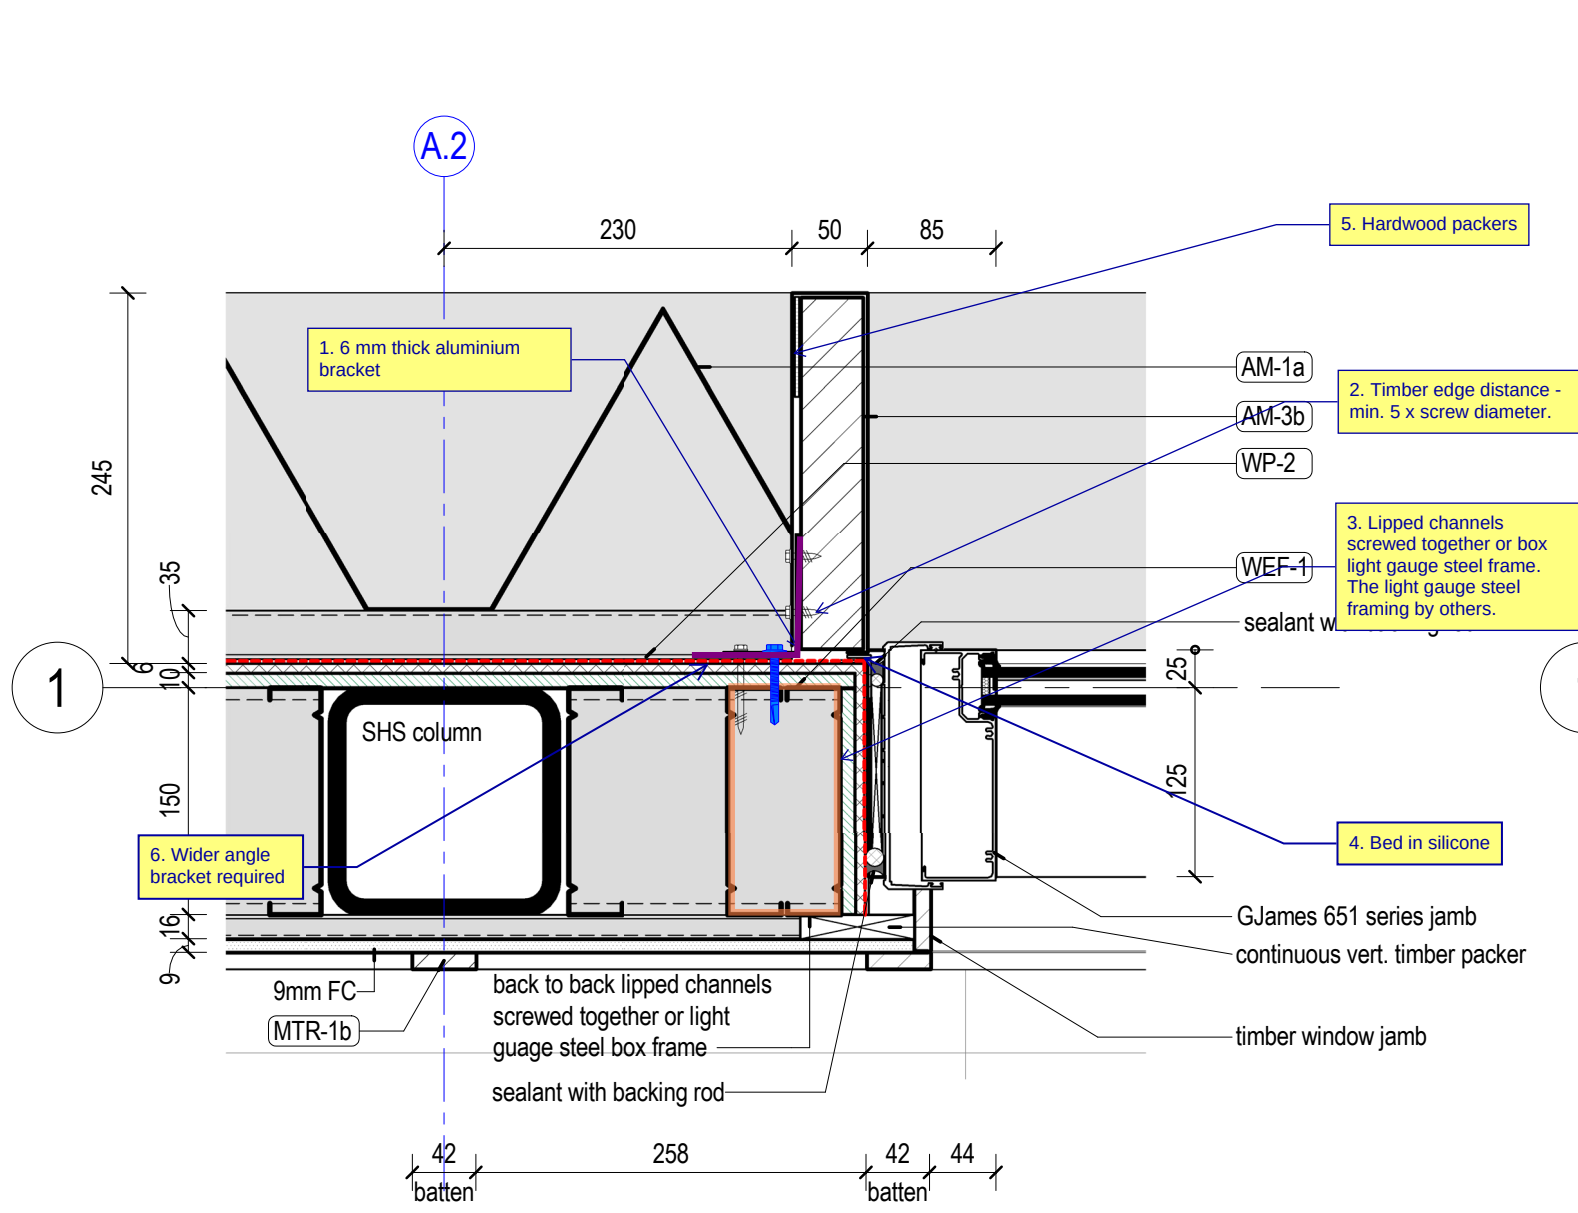


1 WEF-21 Window Jamb
1:5 Typical Window Jamb

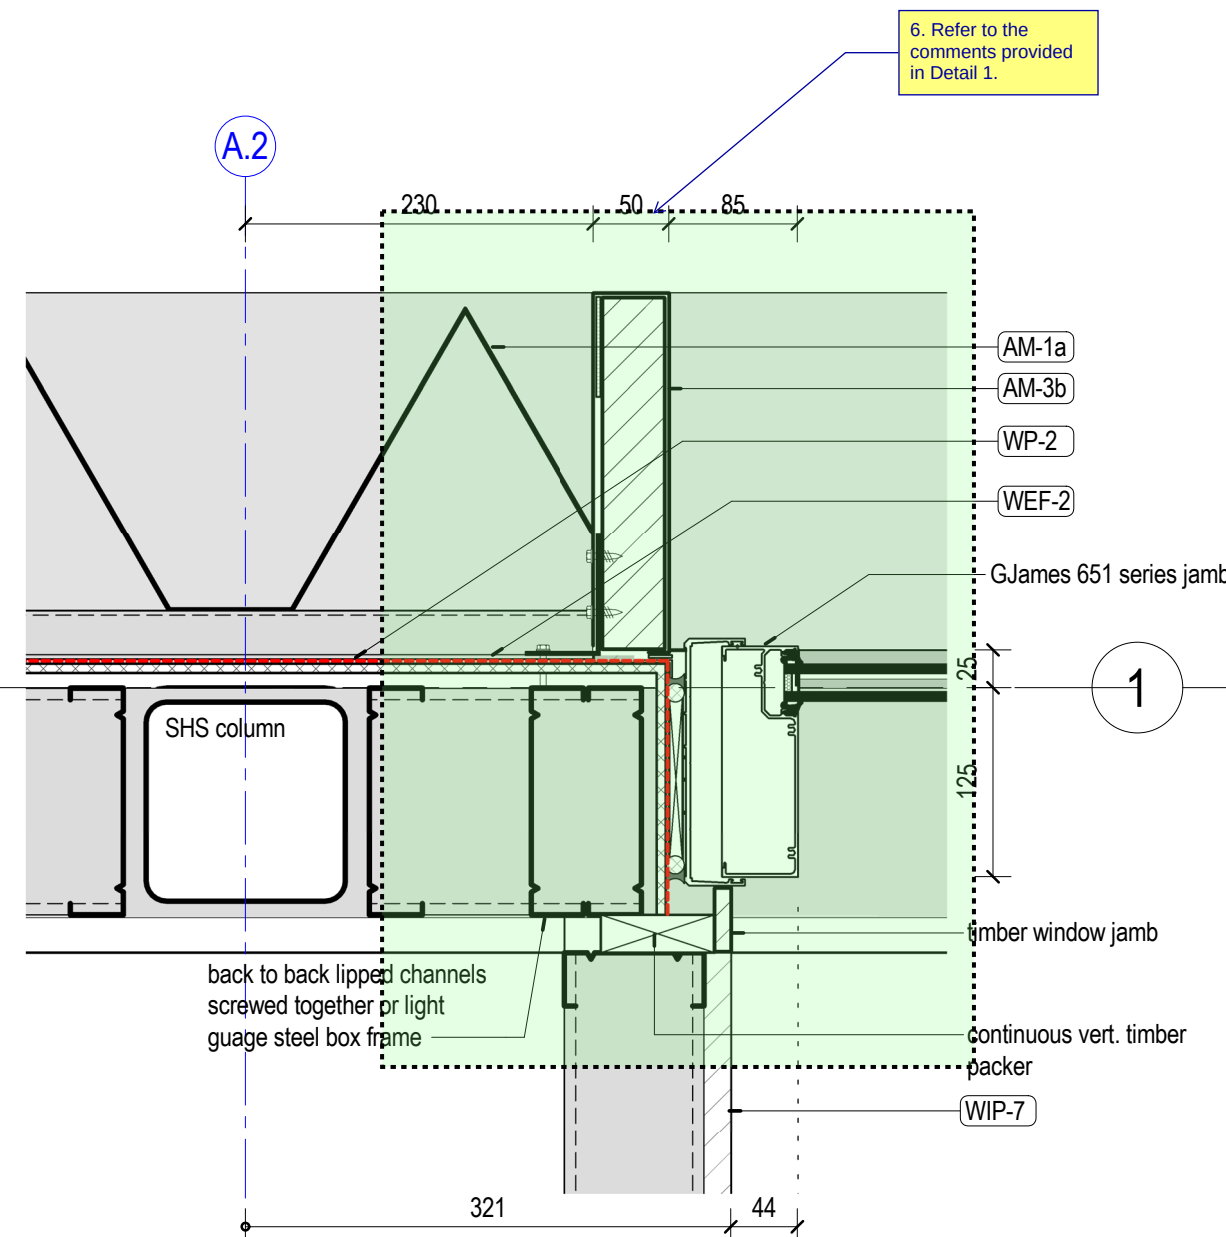

2 WEF-21 Window Jamb @ High Level
1:5

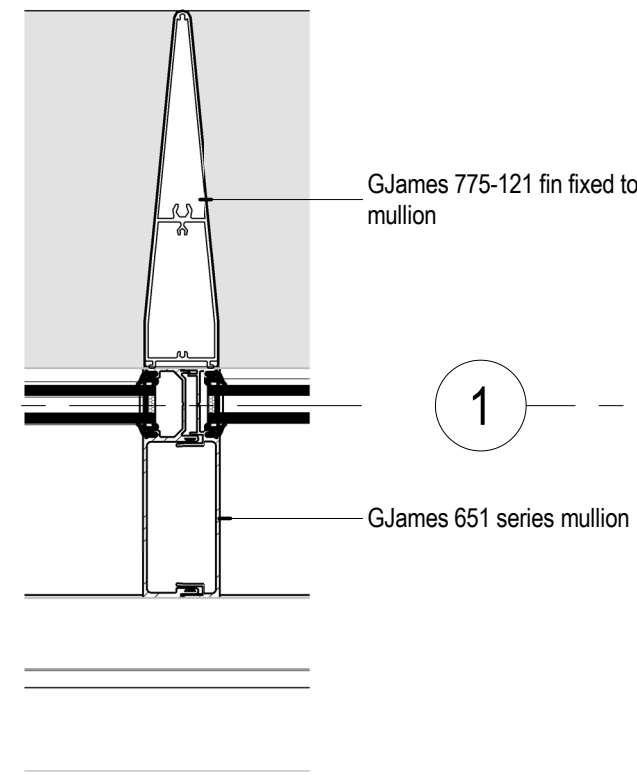

3 WEF-21 Window Fin
1:5 Typical

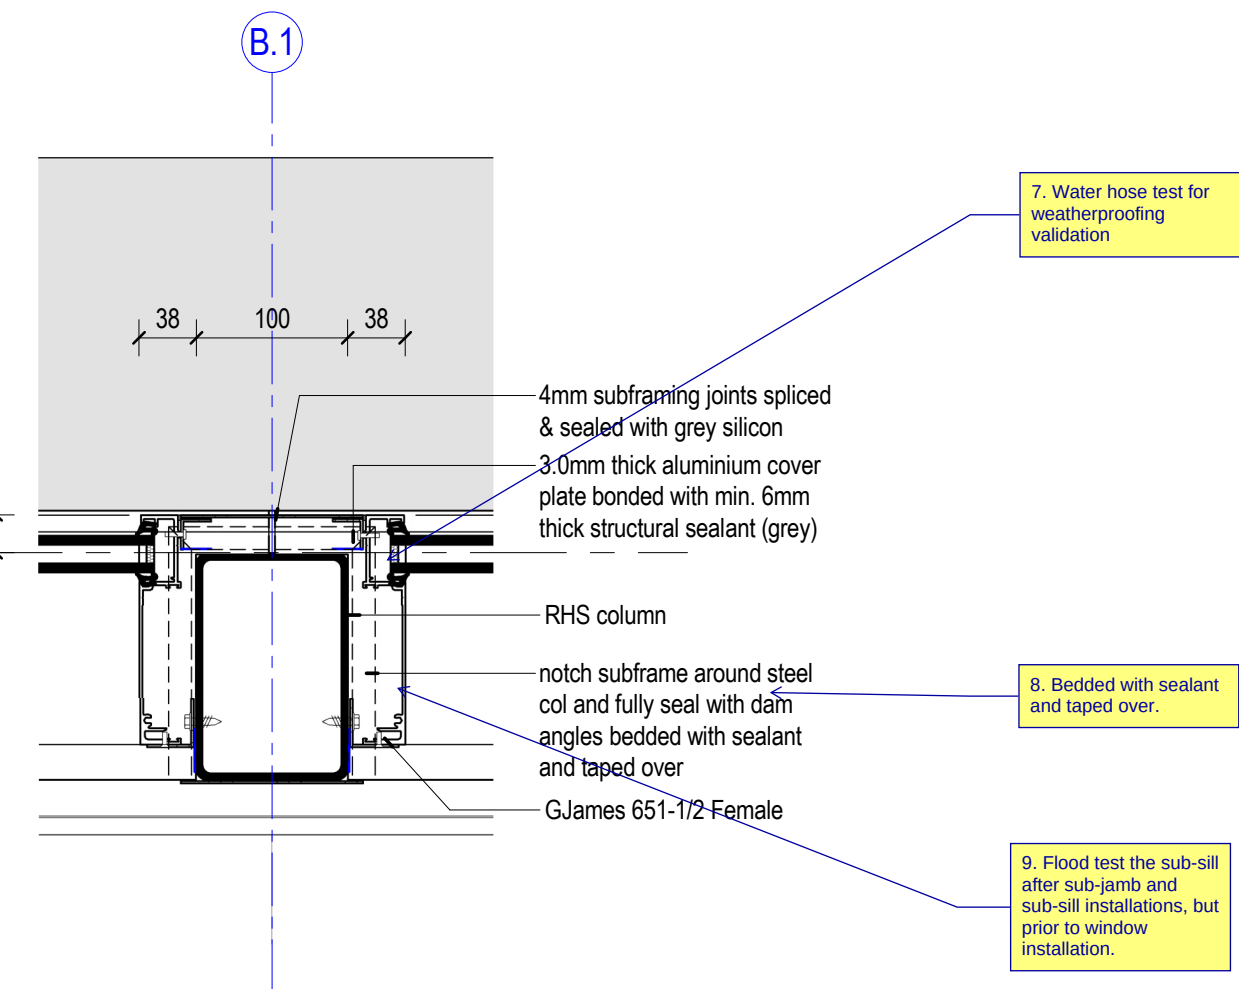

4 WEF-21 Window Column
1:5 Typical

DETAILS NOTES

- All aluminium flashings @ floor level to be min. 1.6 thick. Flashings to be installed with end dams at each end and fully sealed at the corners and vertical framing junctions. Flashings must be continuous and wrap around steel columns where they exist. Water hose test required for waterproofing validation and flood test required for sub-sill after installation of sub-jamb & sub-sill.
- For all screw fixings between timber or aluminium framed cladding and the substrate, apply a blob of sealant before installation and seal screw heads after. Use stainless steel screws/anchors only.
- Install separation tape between dissimilar materials to prevent corrosion.

FACADE LEGEND

- WP-2 Ext. bonded membrane
- Folded aluminium flashing
- WP-1 or 3 Floor Waterproof Membrane
- WP-4 Ext. non-bonded membrane
- Roof sarking

Drawings include colour information. A black & white copy may not have all the information. This background is coloured blue.

**brian hooperarchitect
m3architecture**
ph +61 7 3831 4644
11 saint james street petrie tce q 4000
info@m3architecture.com
www.m3architecture.com

stanwell


project Stanwell New Projects Office
Switchyard Road,
Stanwell, QLD, 4702

title Plan Details - Facade


drawn bg
checked jb
date Nov 2025
scale 1:5 at A1
drawing 25010 / cd A-710001 / 7

copyright ©
These designs, plans, specifications and the copyright herein are the property of the architect and must not be used, reproduced, or copied wholly or in part without the written permission of m3architecture pty ltd abn 23 079 044 545.
Use figured dimensions in preference to scale.
If there are any questions contact the architect.


1:1 at A1
0 10 20 30 40 50mm

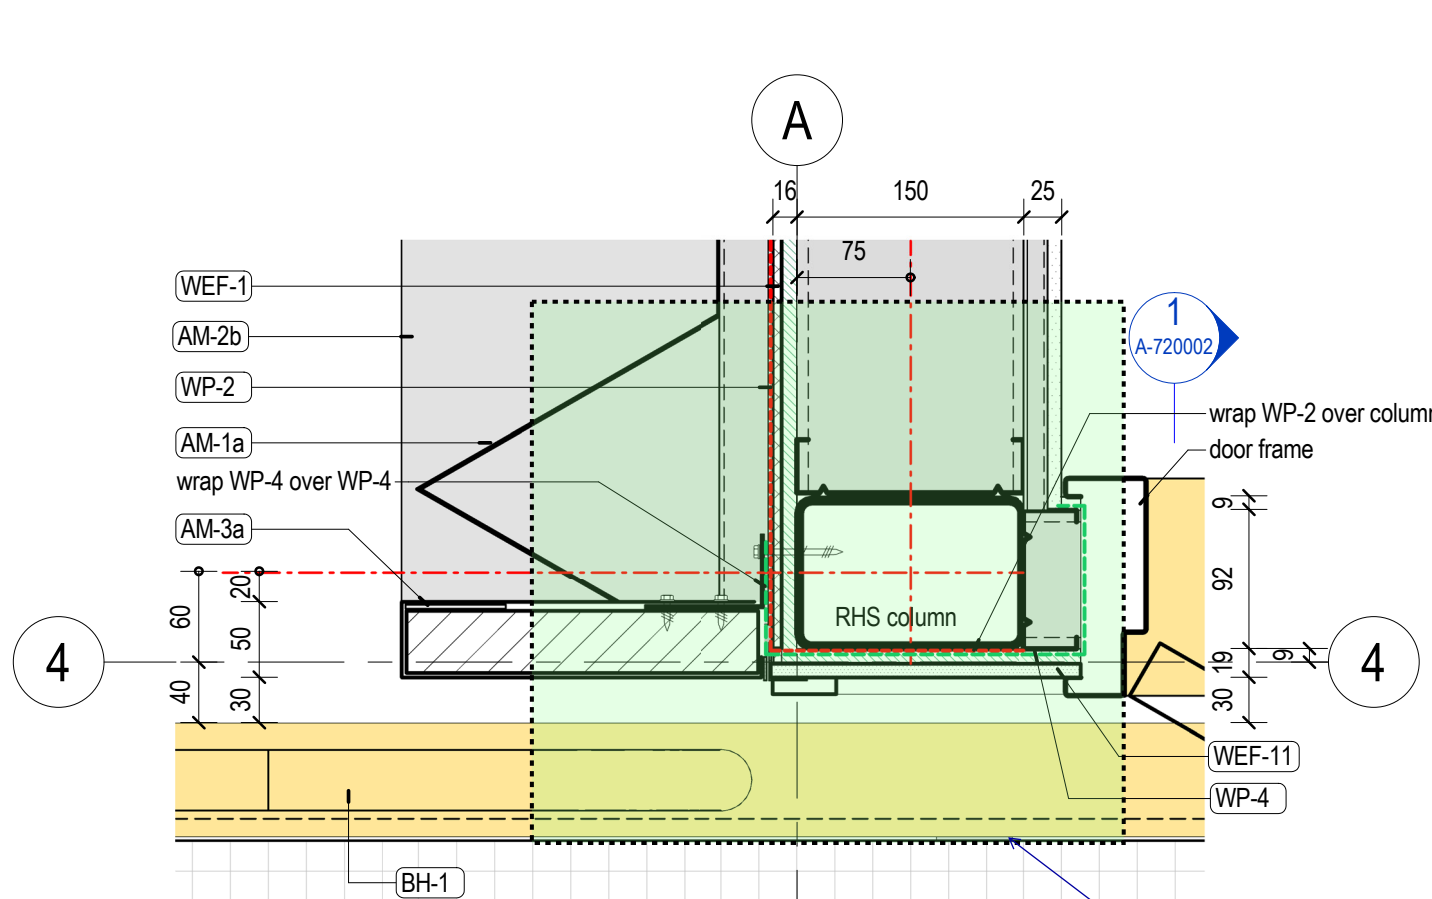


5 West Entry - Vert. Flashing
1:5 North

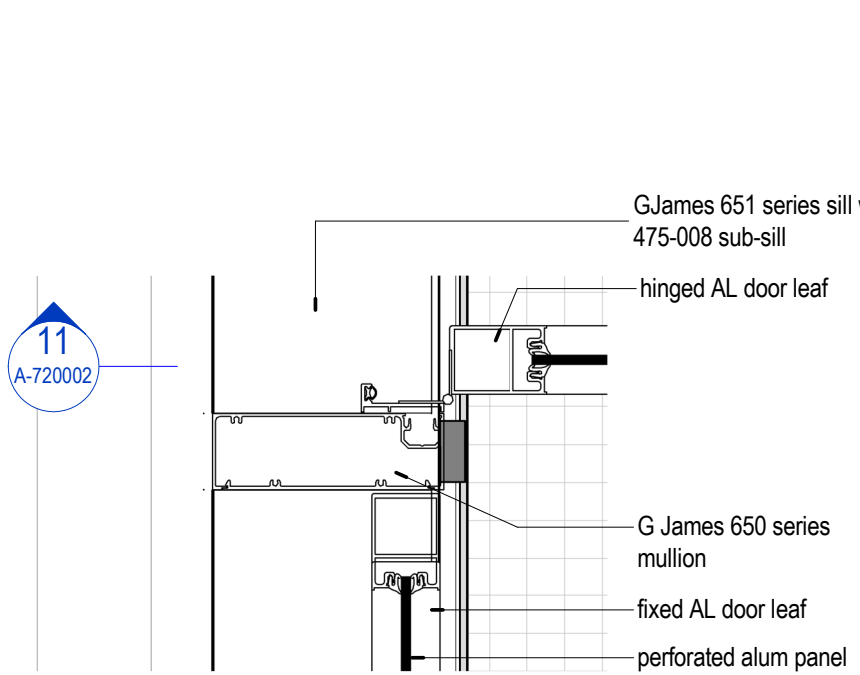


14 East Entry - Door Jamb
1:5 North

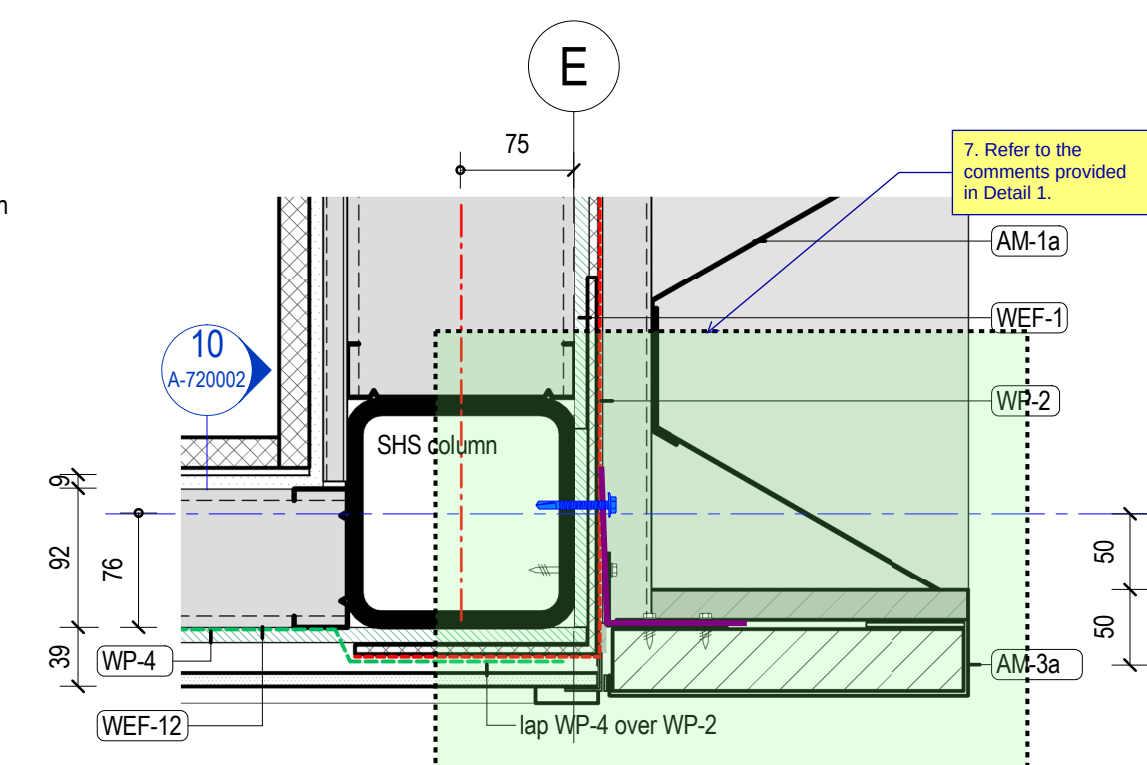


6 East Entry - Vert. Flashing
1:5 North

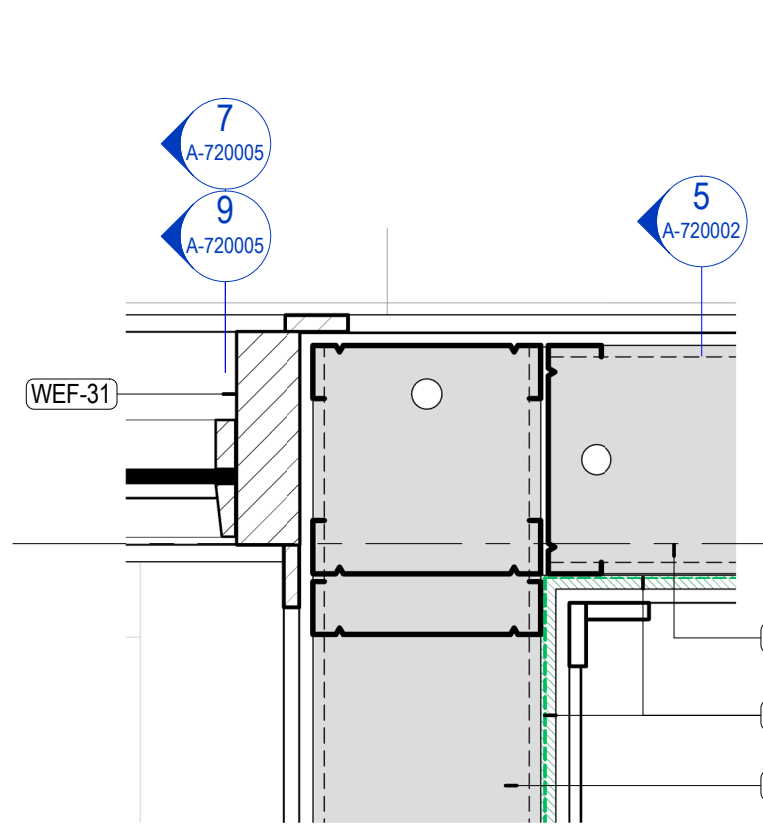


12 Wall Junction - Stair 1
1:5 North

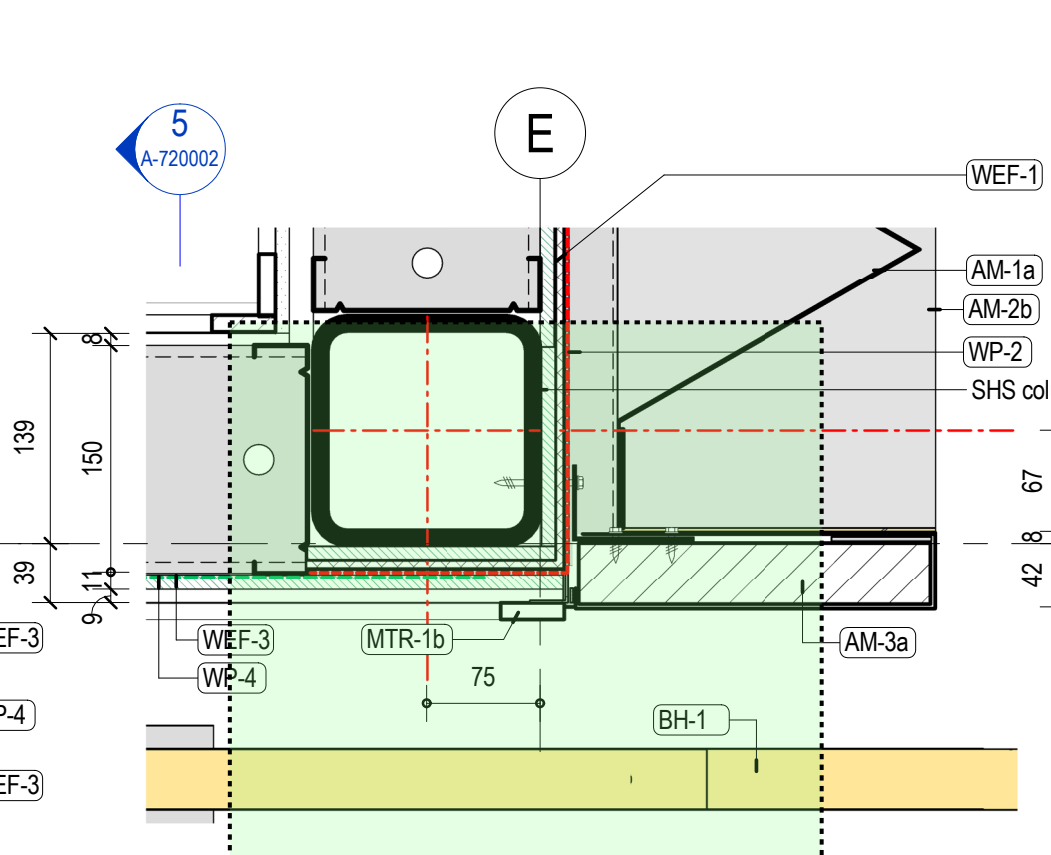


7 Vert. Flashing - Stair 1
1:5 North

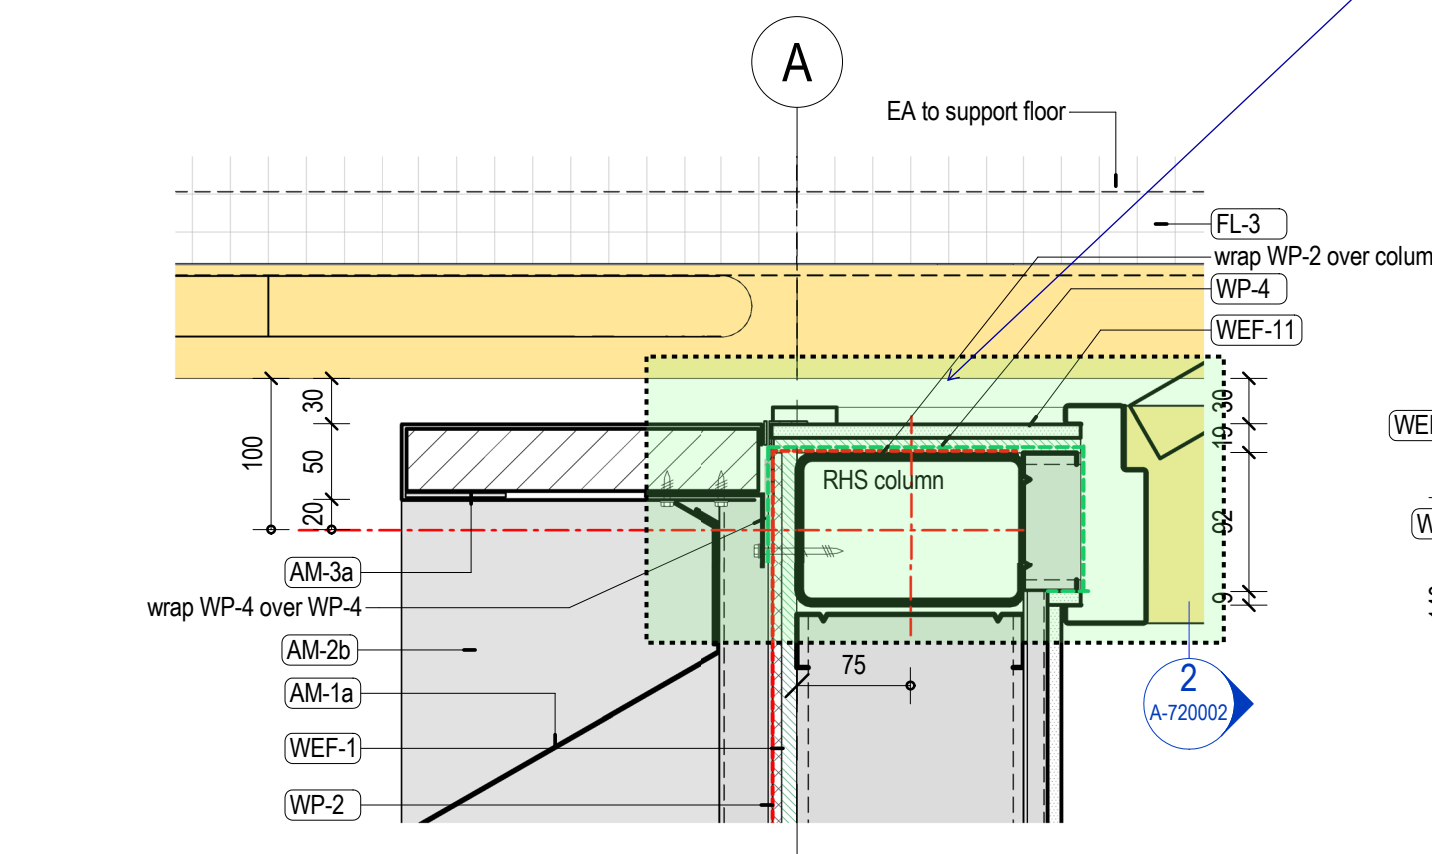


8 West Entry - Vert. Flashing
1:5 South

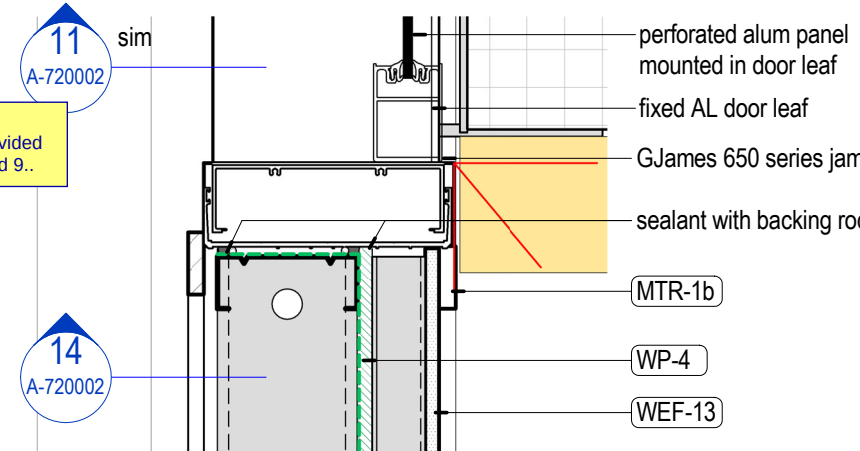


11 East Entry - Gate Jamb
1:5 South

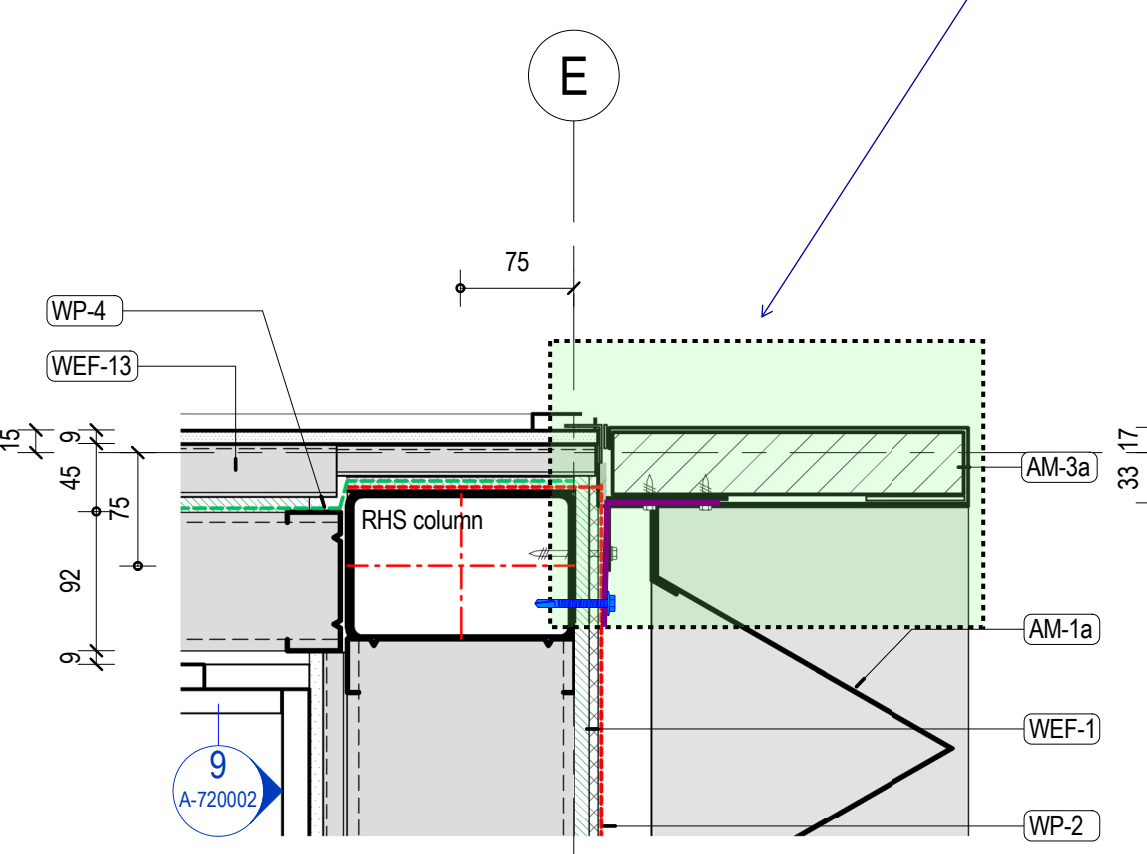

9 East Entry - Vert. Flashing
1:5 South


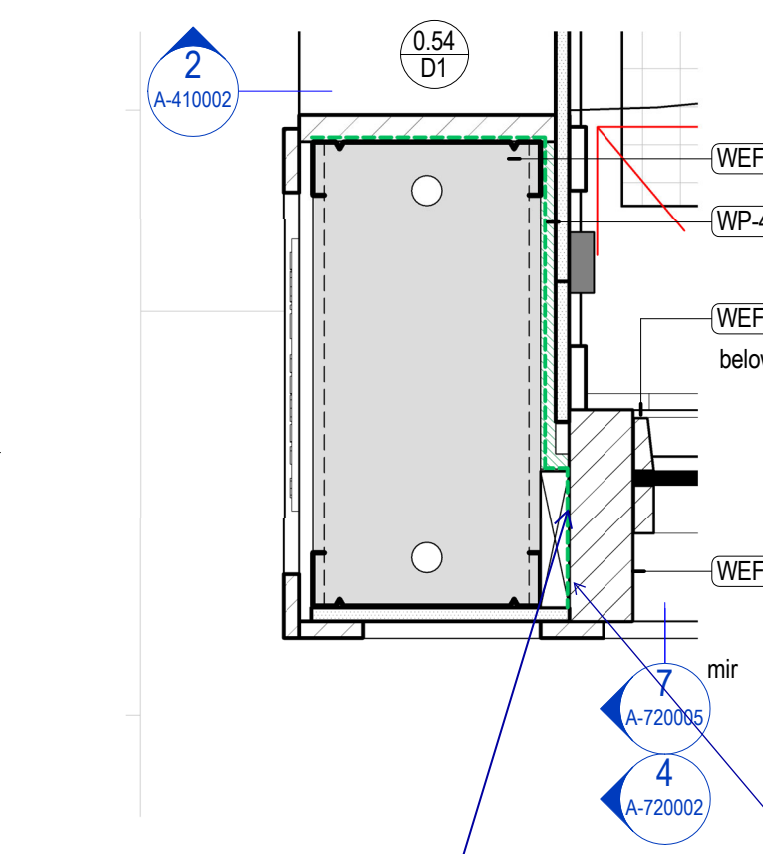


13 Wall Junction - Stair 1
1:5 South

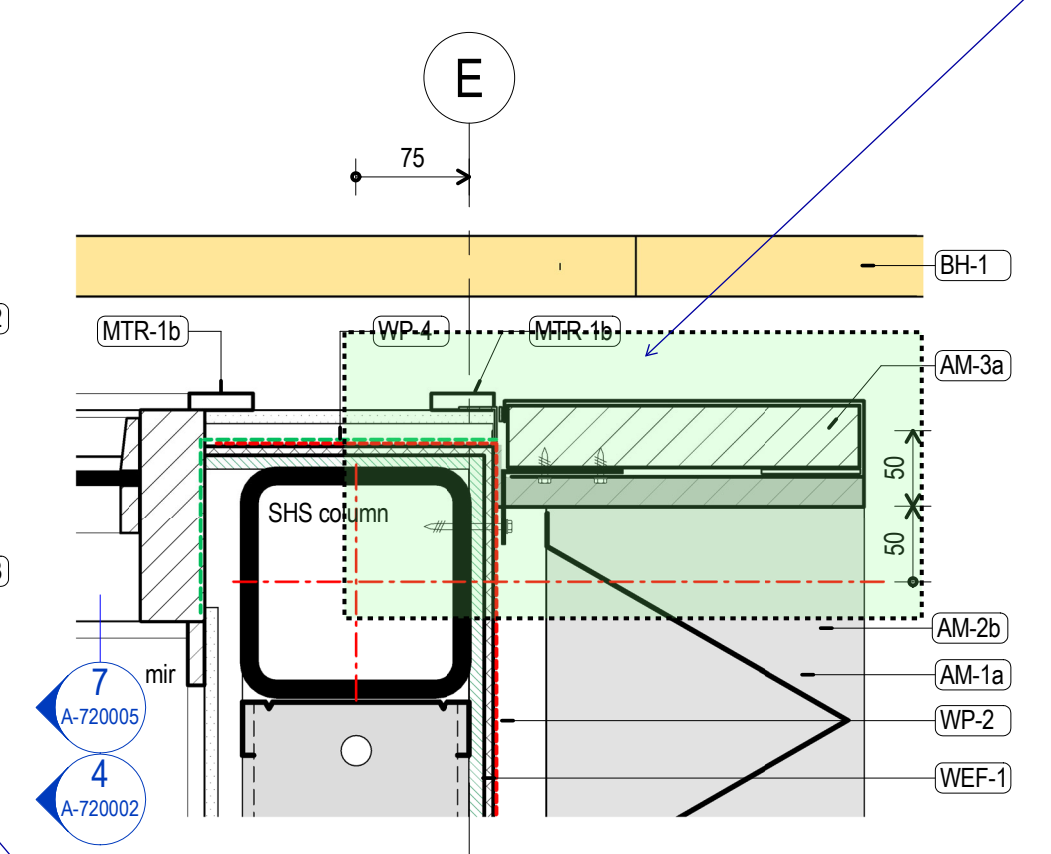


10 Vert. Flashing - Stair 1
1:5 South


1.2.4 DOCUMENT REVIEW The reviewer shall review the documents submitted by the contractor to ensure that they are complete and accurate. The reviewer shall also ensure that the documents are in accordance with the contract requirements. The reviewer shall provide a written report of the review to the contractor within the specified time frame.	
A Reviewed by Contractor	B Reviewed by Consultant
C Reviewed by Employer	D Reviewed by Architect
Normal Kesejahteraan Date: 17/12/2025	
 Inhabiti Inhabiti Australia Pty Ltd	

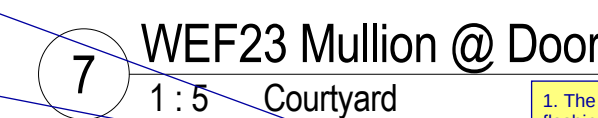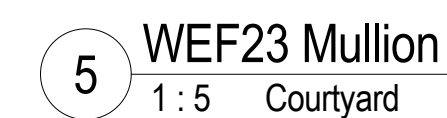


1:1 at A1

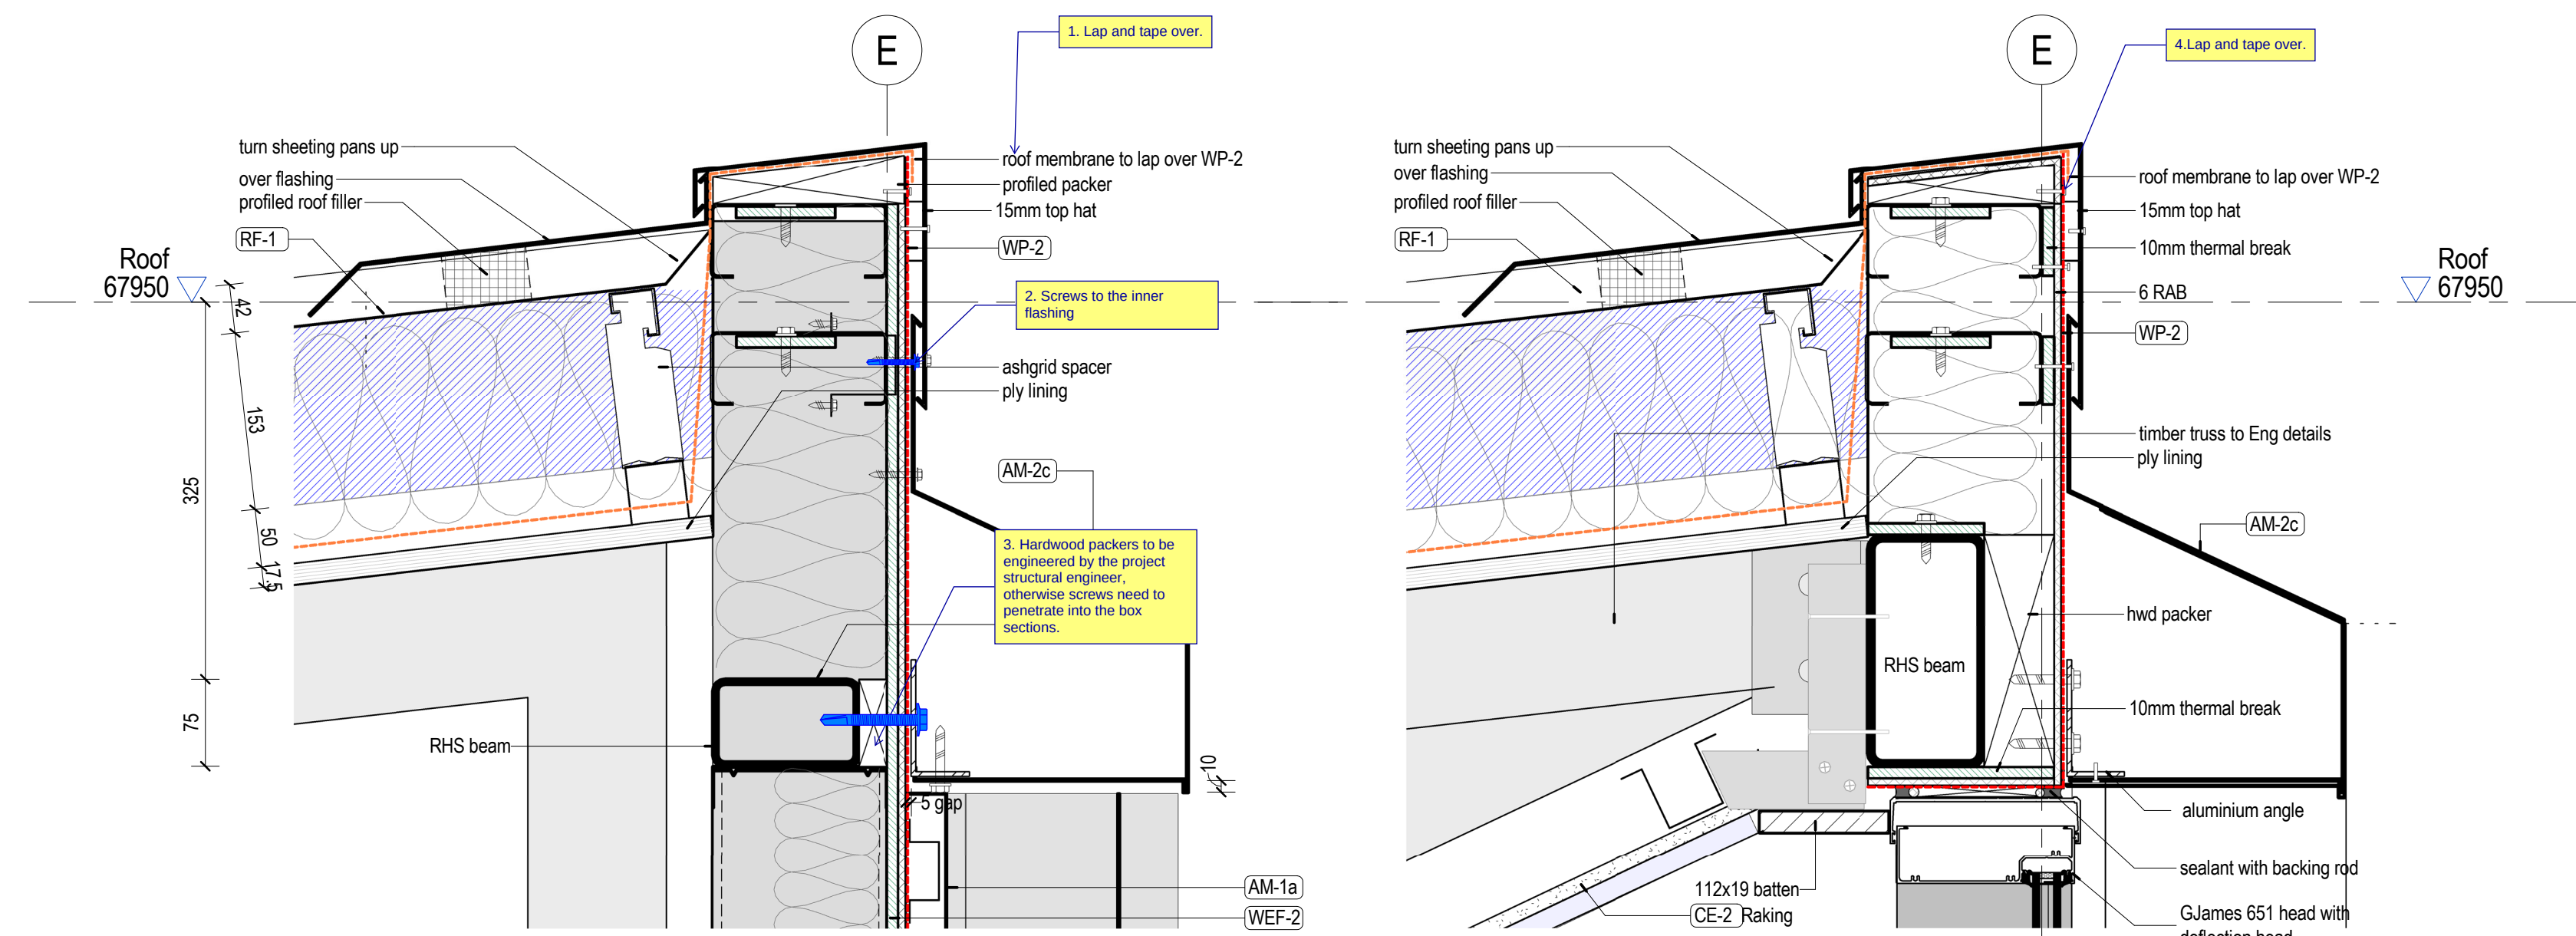


1 Parapet Flashing Detail
1 : 5 Typical

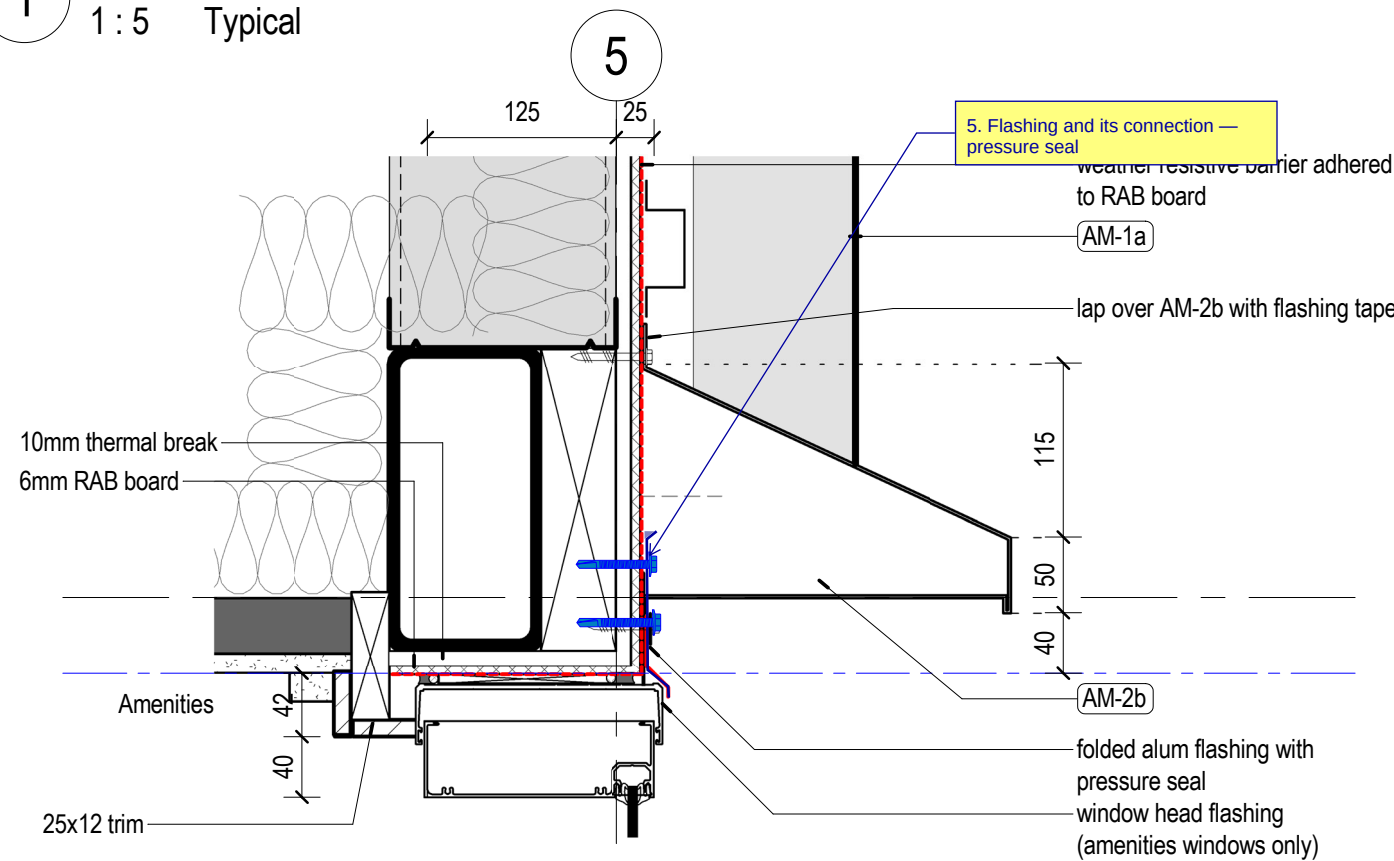


4 Row 3 Flashing Detail
1 : 5 Window Head - Amenities

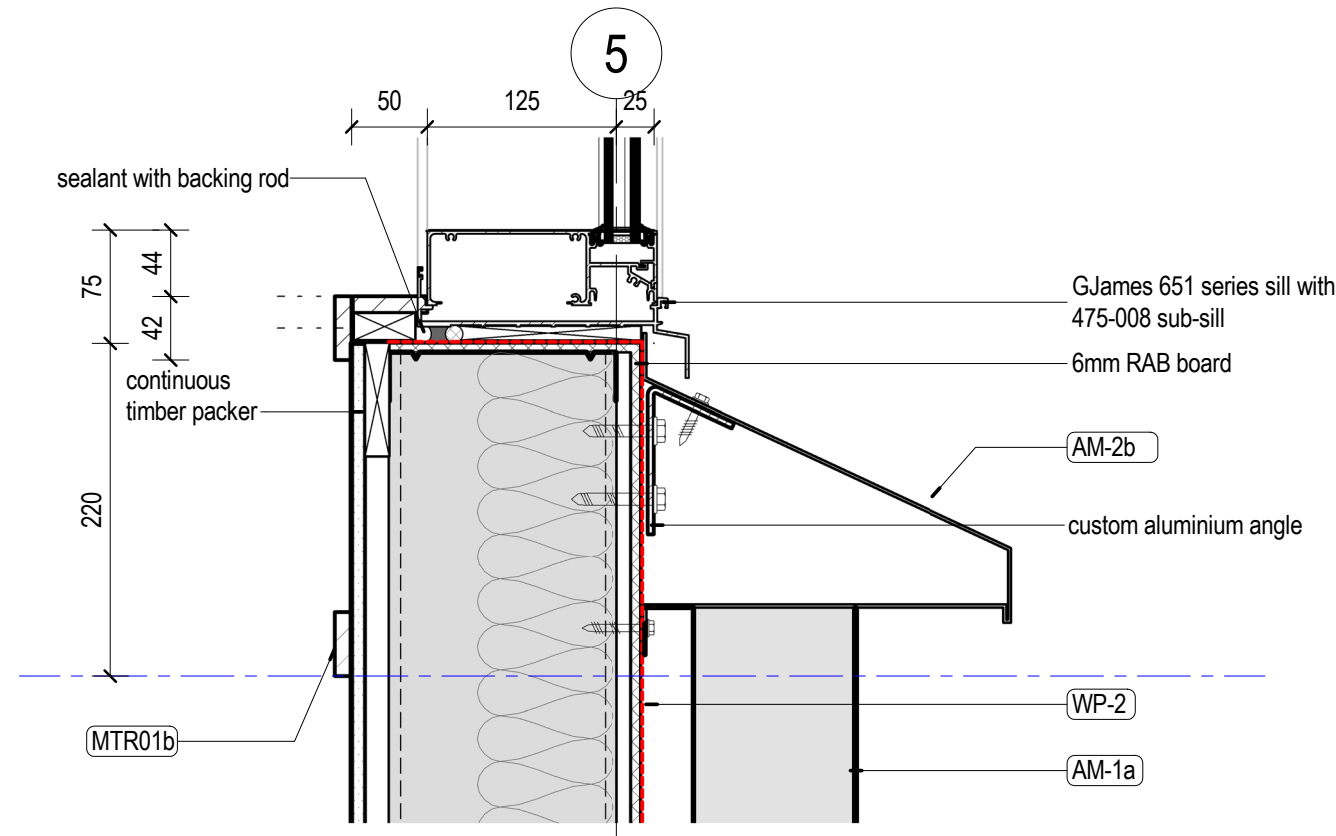


6 Row 2 Flashing Detail
1 : 5 Typ. Window Sill Amenities

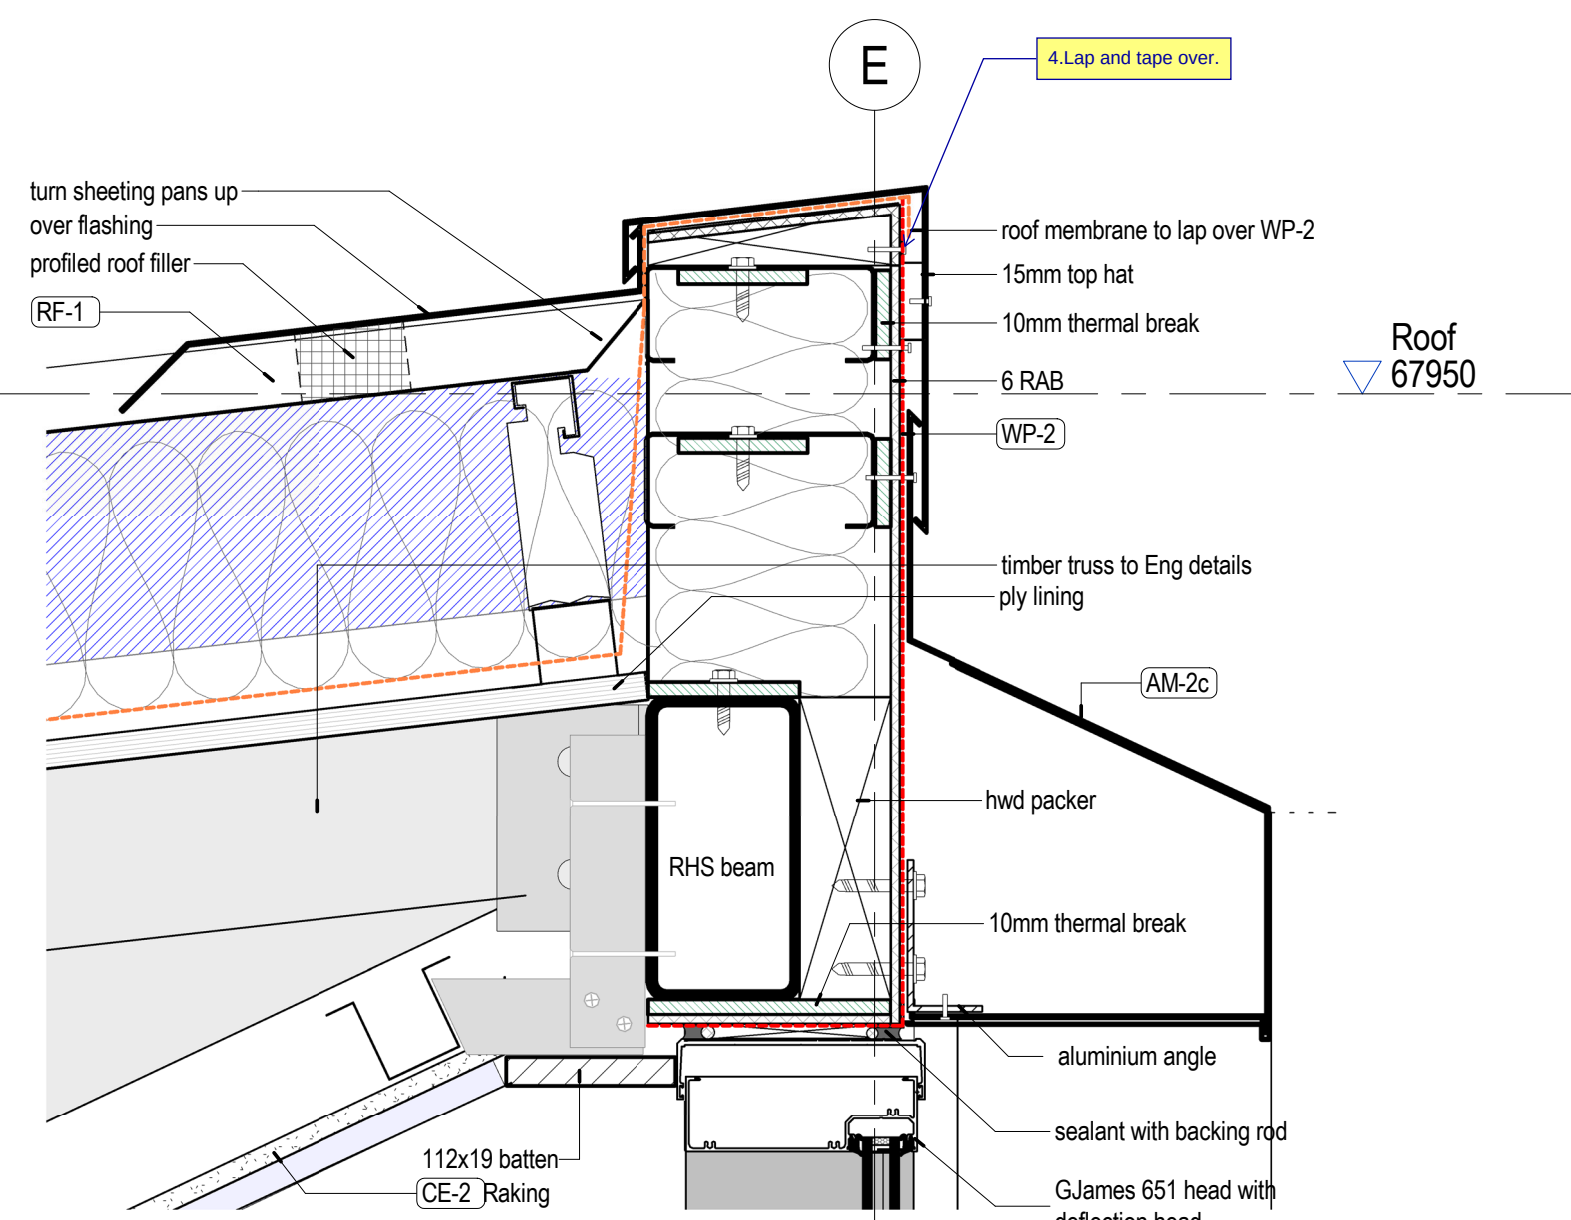


2 Parapet Flashing Detail
1 : 5 Typ. Window Head

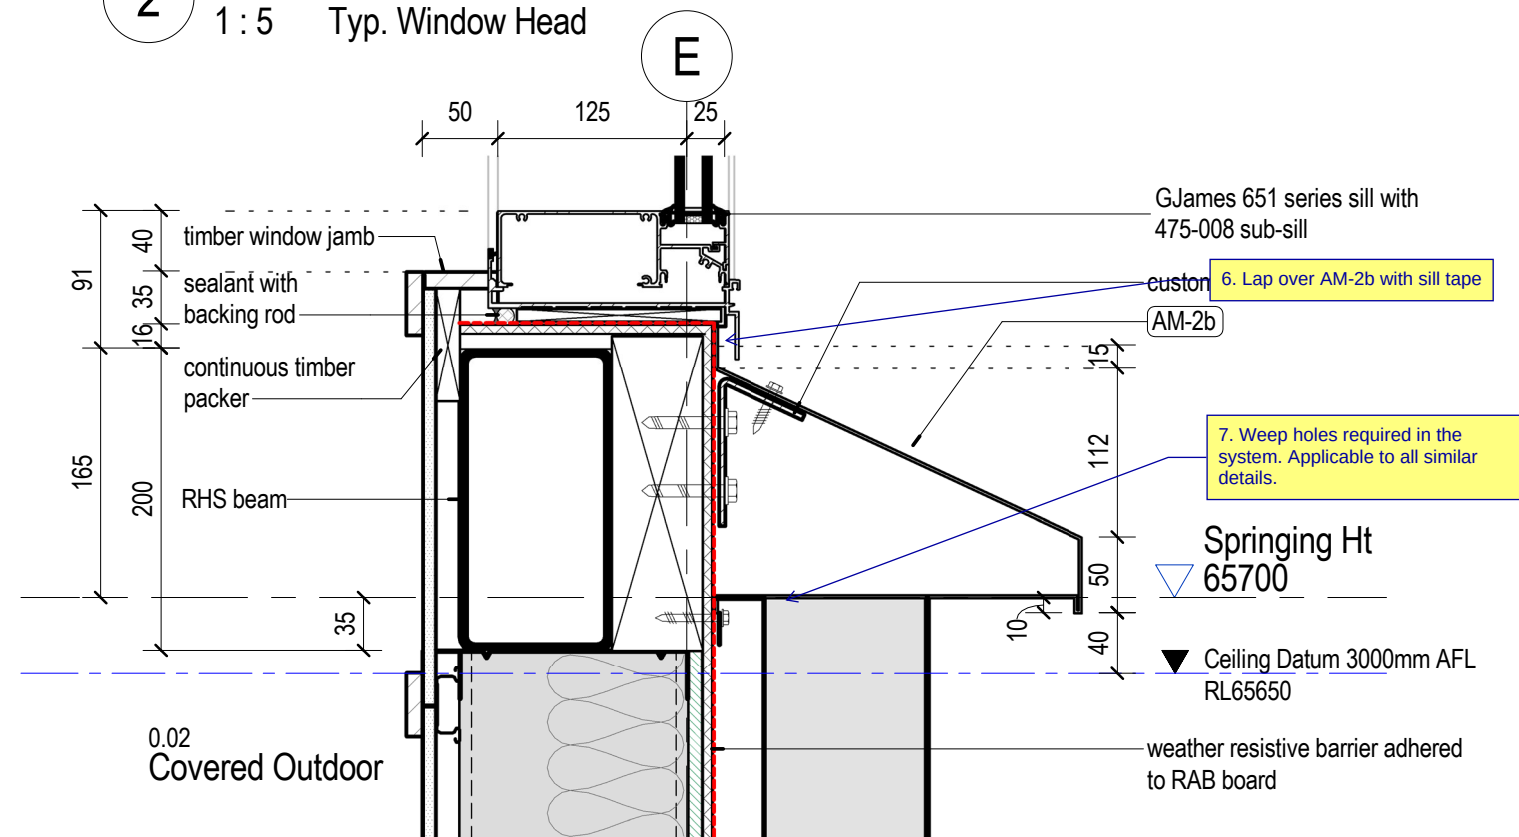


5 Row 3 Flashing Detail
1 : 5 Typ. Window Sill

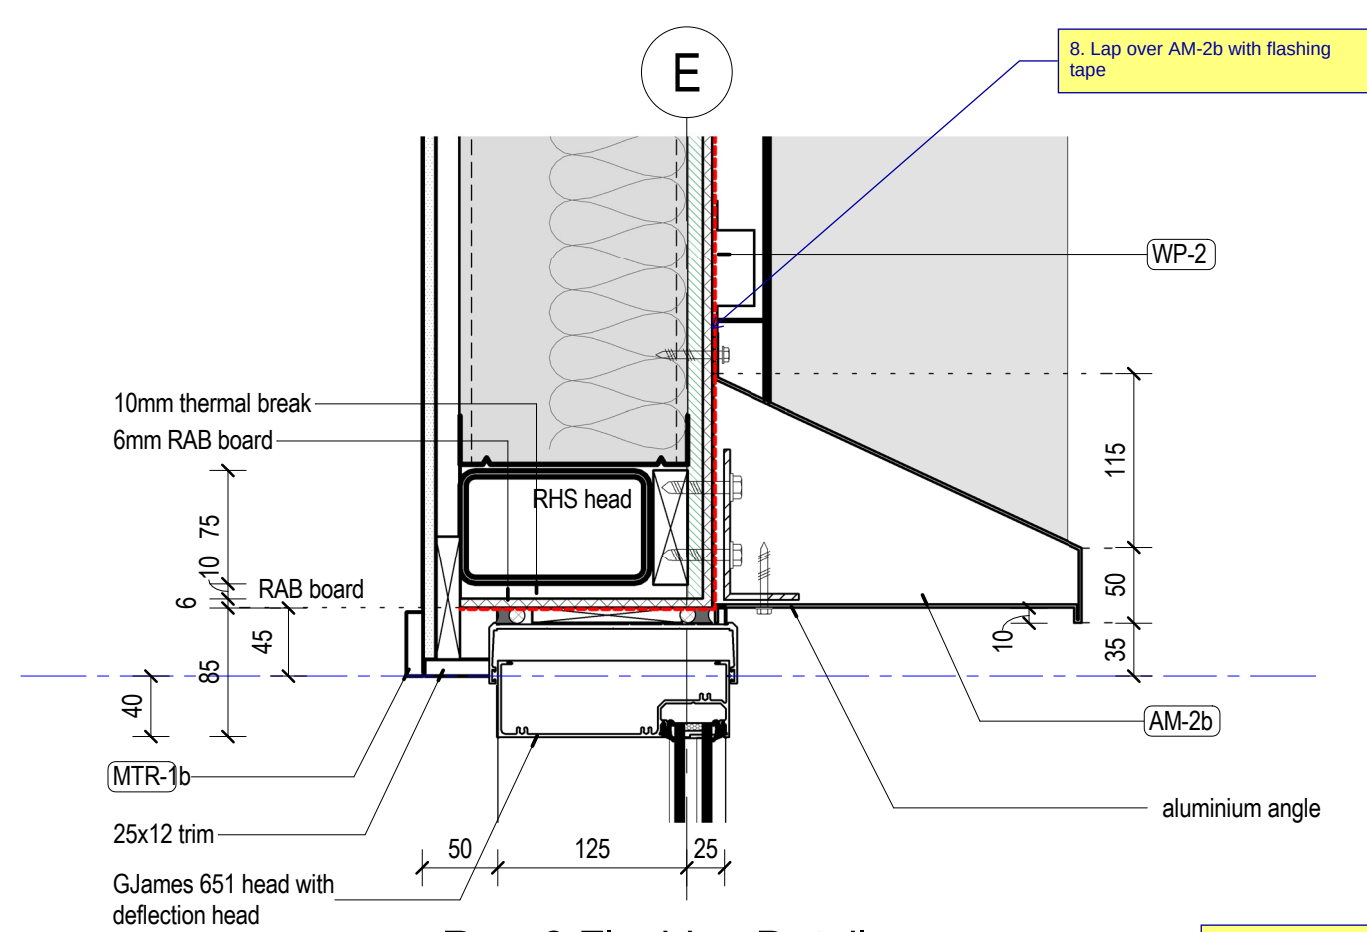


7 Row 2 Flashing Detail
1 : 5 Typ. Window Head

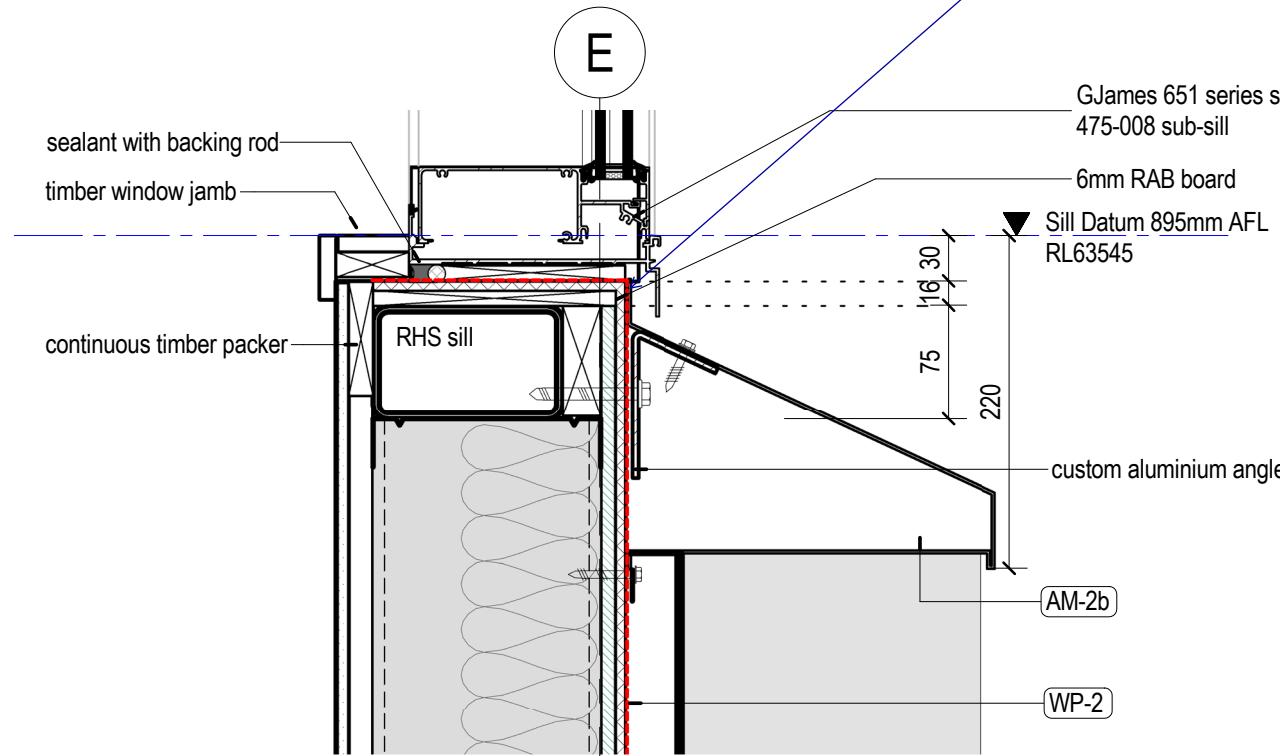

9 Row 1 Flashing Detail
1 : 5 Typ. Window Sill

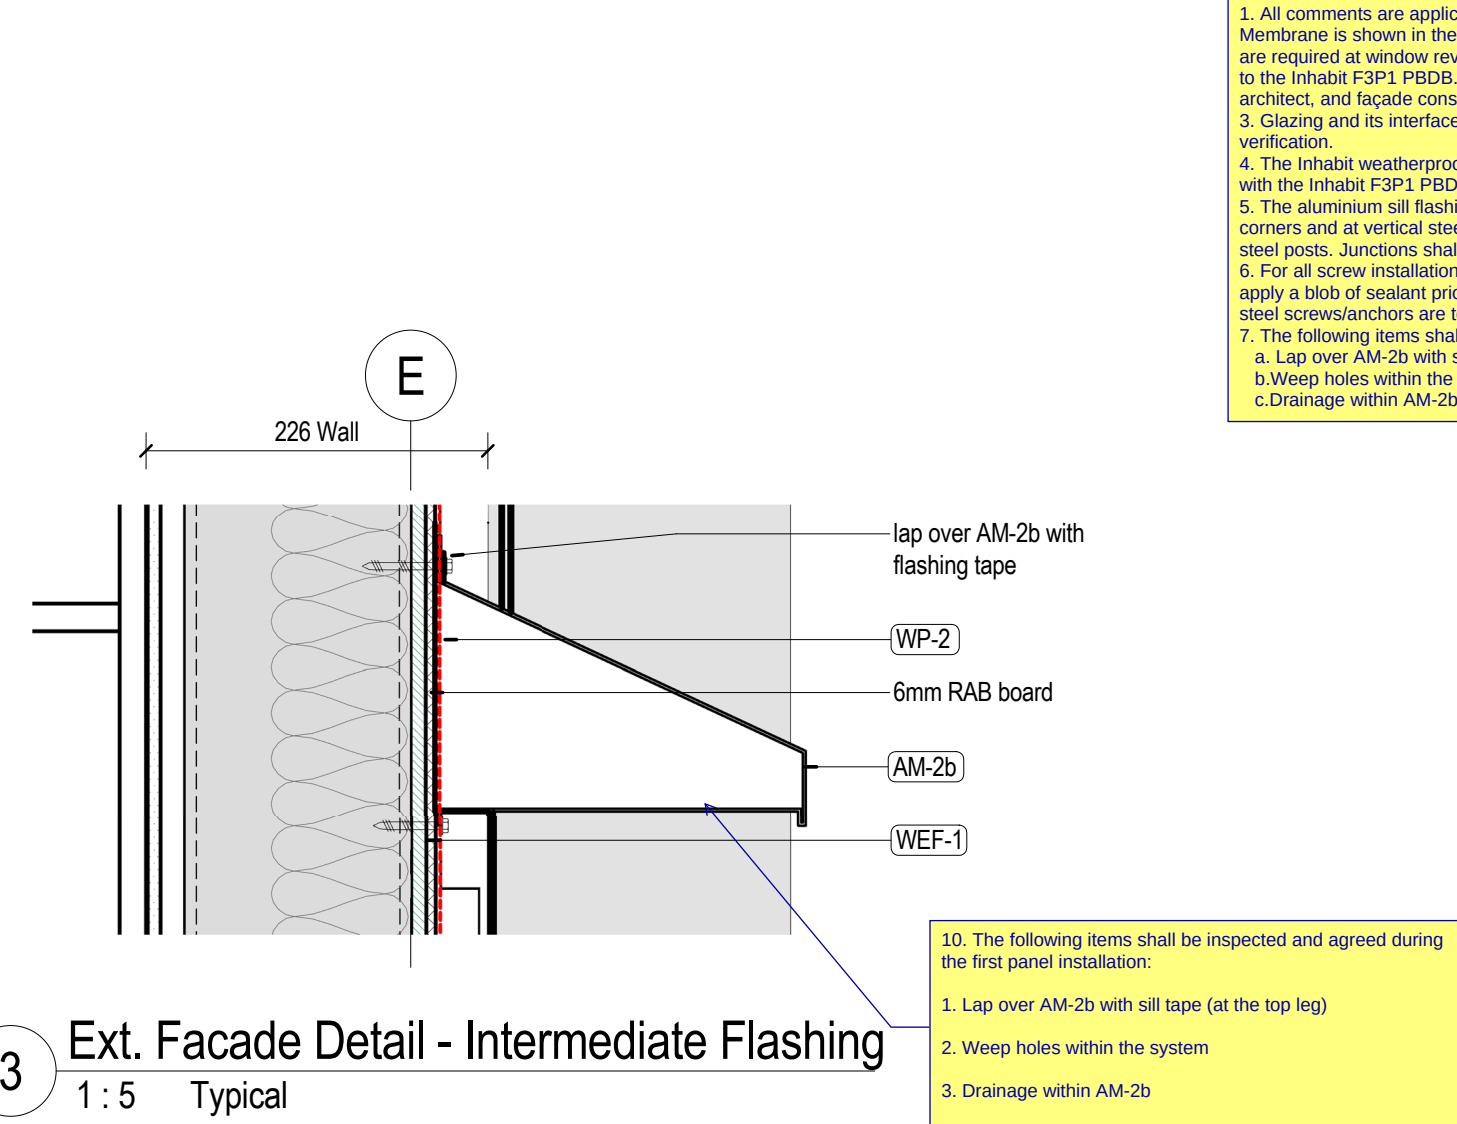


3 Ext. Facade Detail - Intermediate Flashing
1 : 5 Typical

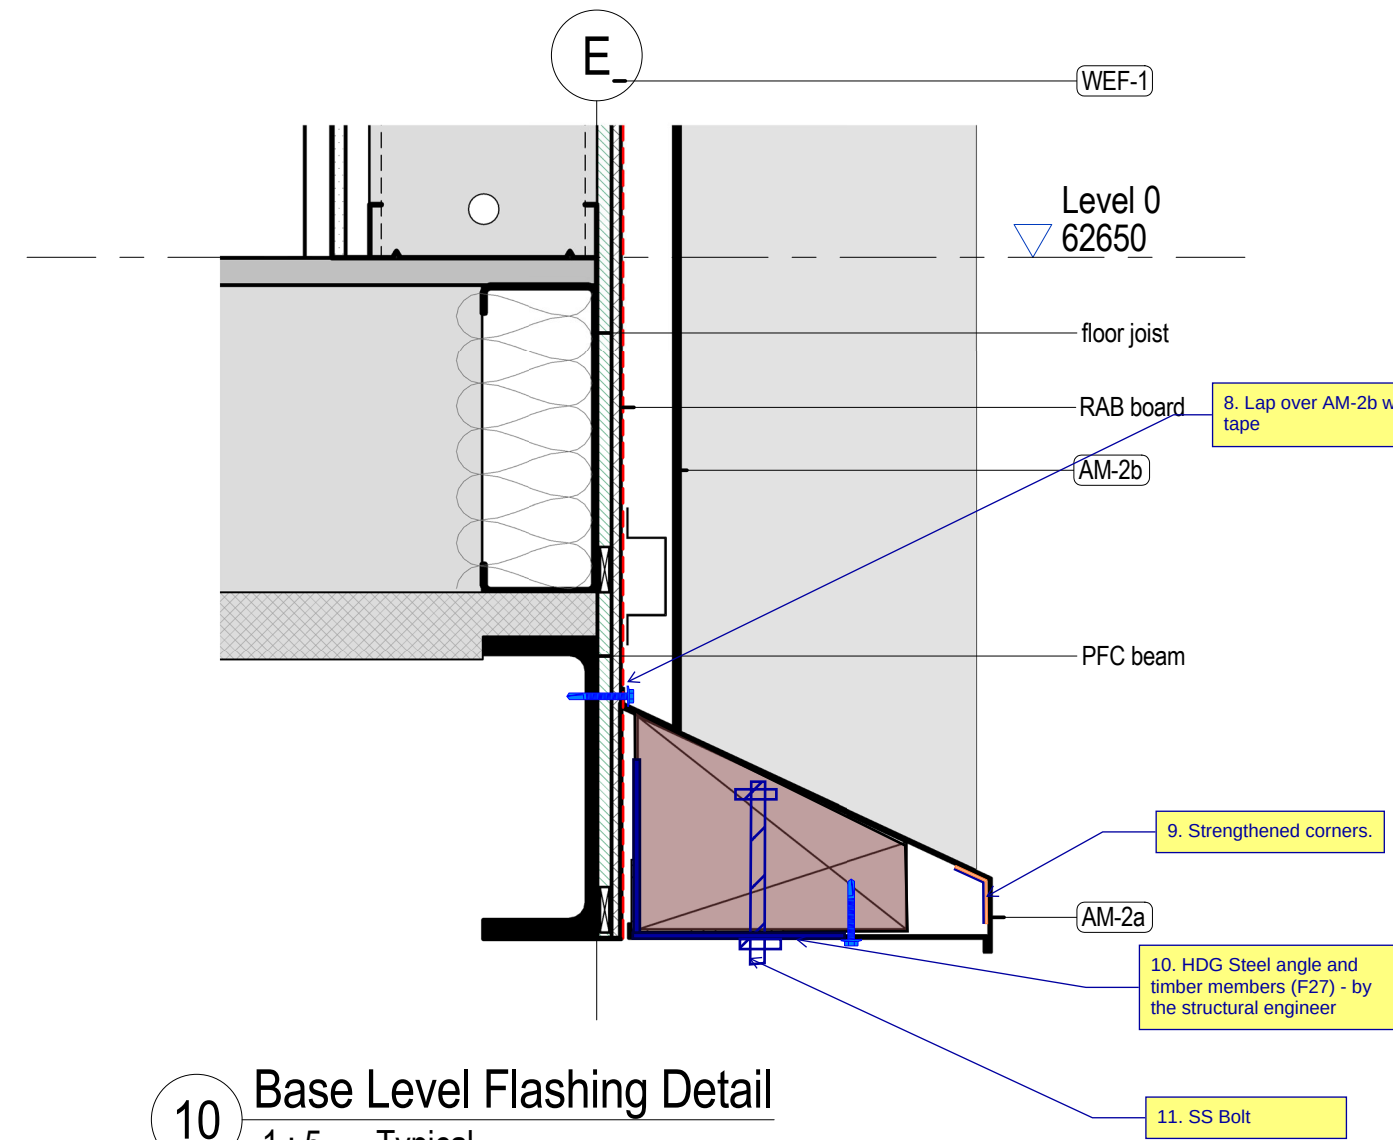

10 Base Level Flashing Detail
1 : 5 Typical

Notes:
1. All comments are applicable to similar details.
2. Membrane is shown in the architectural facade drawings below, however, specialised membranes are required at window reveals, including window sills, lap joints, and membrane terminations. Refer to the Inhabit F&P1 PBD8. Where information is not available, liaise with the product supplier, architect, and facade consultant.
3. Glazing and its interface details need to be reviewed as part of the shop drawings for FP1.4 verification.
4. The inhabit weatherproofing mark-ups on the architectural drawings are to be read in conjunction with the Inhabit F&P1 PBD8.
5. The aluminium sill flashing shall be installed with end dams at each end and fully sealed at corners and at vertical steel post interfaces. The flashing shall be continuous and wrap around the steel posts. Junctions shall be verified by water hose testing.
6. For all screw installations between the timber/aluminium-framed cladding and the substrate, apply a blob of sealant prior to installing the screw, and seal the screw heads afterwards. Stainless steel screws/anchors are to be used.
7. The following items shall be inspected and agreed during the first panel installation:
a. Lap over AM-2b with sill tape (at the top leg)
b. Weep holes within the system
c. Drainage within AM-2b


rev	date	description	initial
1	15/08/2025	Coordination Issue	JB
2	08/09/2025	QS Issue	JB
3	19/09/2025	100% QS Issue	JB
4	21/11/2025	CD Coordination Issue	JB
5	28/11/2025	Pre-Tender Estimate	JB
6	18/12/2025	Facade Detail Update	JB

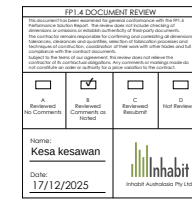

DETAILS NOTES

1. All aluminium flashings @ floor level to be min. 1.6 thick. Flashings to be installed with end dams at each end and fully sealed at the corners and vertical framing junctions. Flashings must be continuous and wrap around steel columns where they exist. Water hose test required for weatherproofing validation and flood test required for sub-sill after installation of sub-jamb & sub-sill.
2. For all screw fixings between timber or aluminium framed cladding and the substrate, apply a blob of sealant before installation and seal screw heads after. Use stainless steel screws/anchors only.
3. Install separation tape between dissimilar materials to prevent corrosion.

FACADE LEGEND

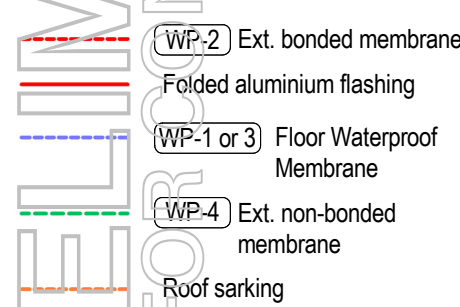

Drawings include colour information. A black & white copy may not have all the information. This background is coloured blue.

brian hooperarchitect
m3architecture
ph: +61 7 3831 4644
11 saint james street petrie tce q 4000
info@m3architecture.com
www.m3architecture.com

client **stanwell**

project **Stanwell New Projects Office**
Switchyard Road,
Stanwell, QLD, 4702


title **Section Details - Facade -**
External

drawn bg
checked jb
date Nov 2025
scale 1 : 5 at A1
drawing 25010 / cd A-720001 / 6


copyright ©
These designs, plans, specifications and the copyright herein are the property of the architect and must not be used, reproduced, or copied wholly or in part without the written permission of m3architecture Pty Ltd abn 23 079 044 545.
Use figured dimensions in preference to scale.
If there are any questions contact the architect.

1:5 at A1
0 50 100 150 200 250mm


Notes:
1. All comments are applicable to similar details.
2. Gutter design by the hydraulic engineer.
3. Roofing design, including all roof flashings, to comply with AS 1562.1 and HB 39.
Roofing contractor to confirm compliance of design and installation via Form 12.

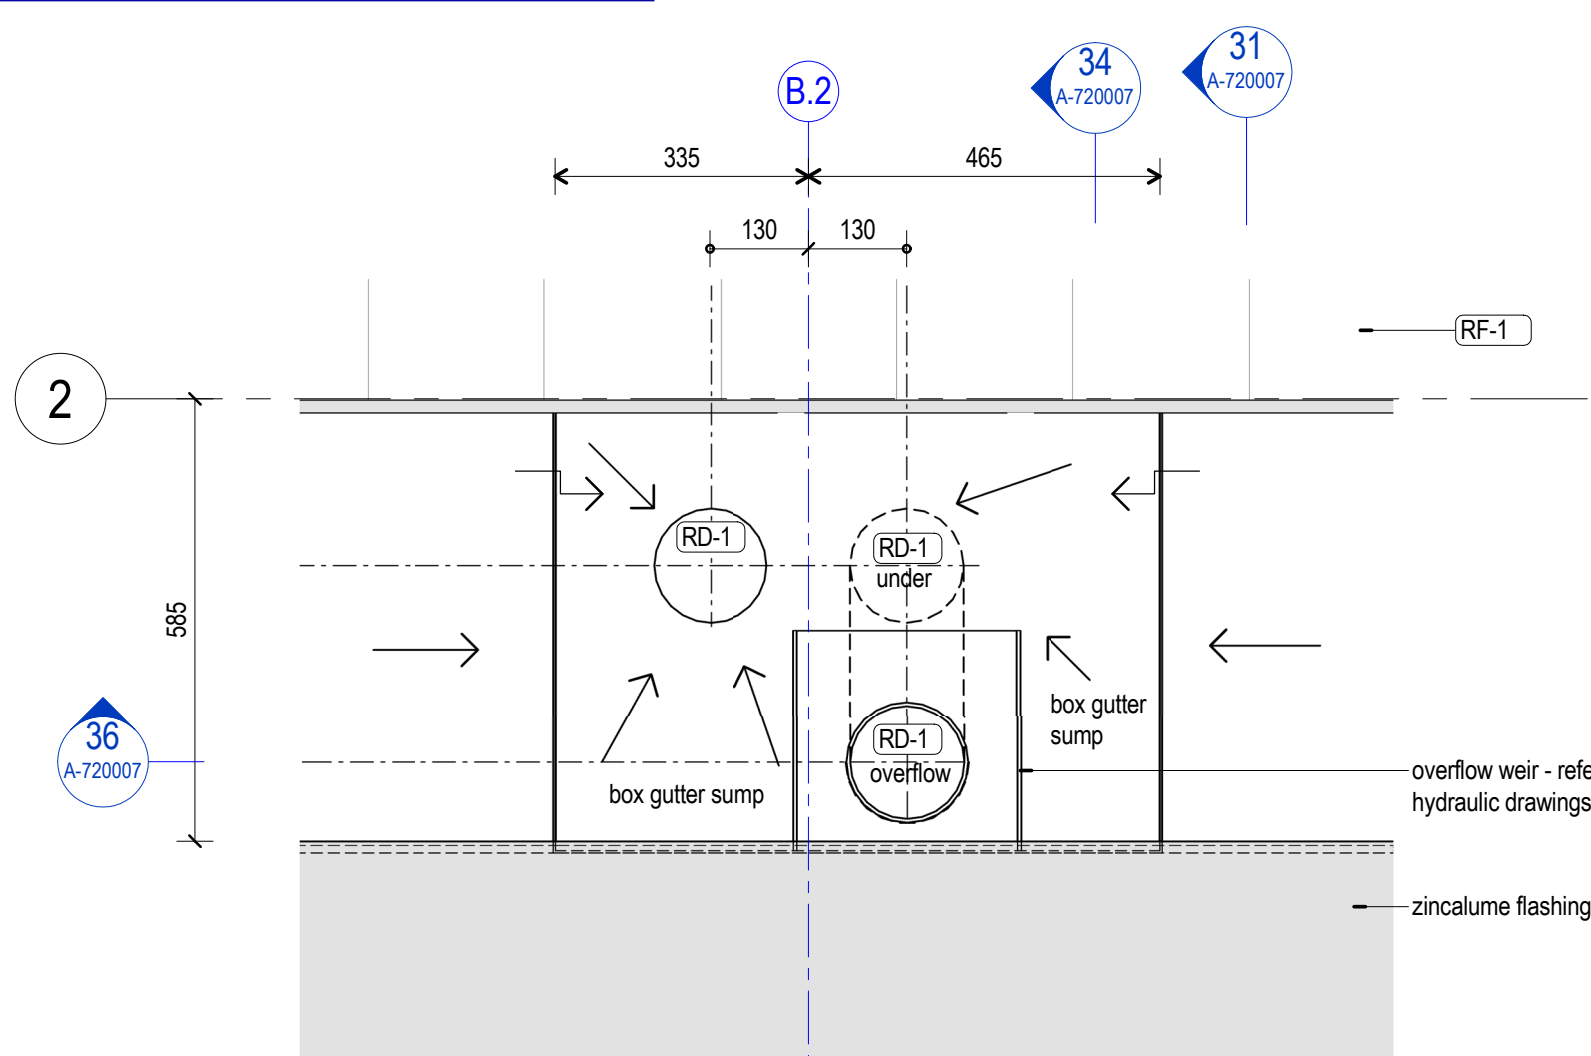


28 RG-1 Box Gutter Sump Plan
1:10

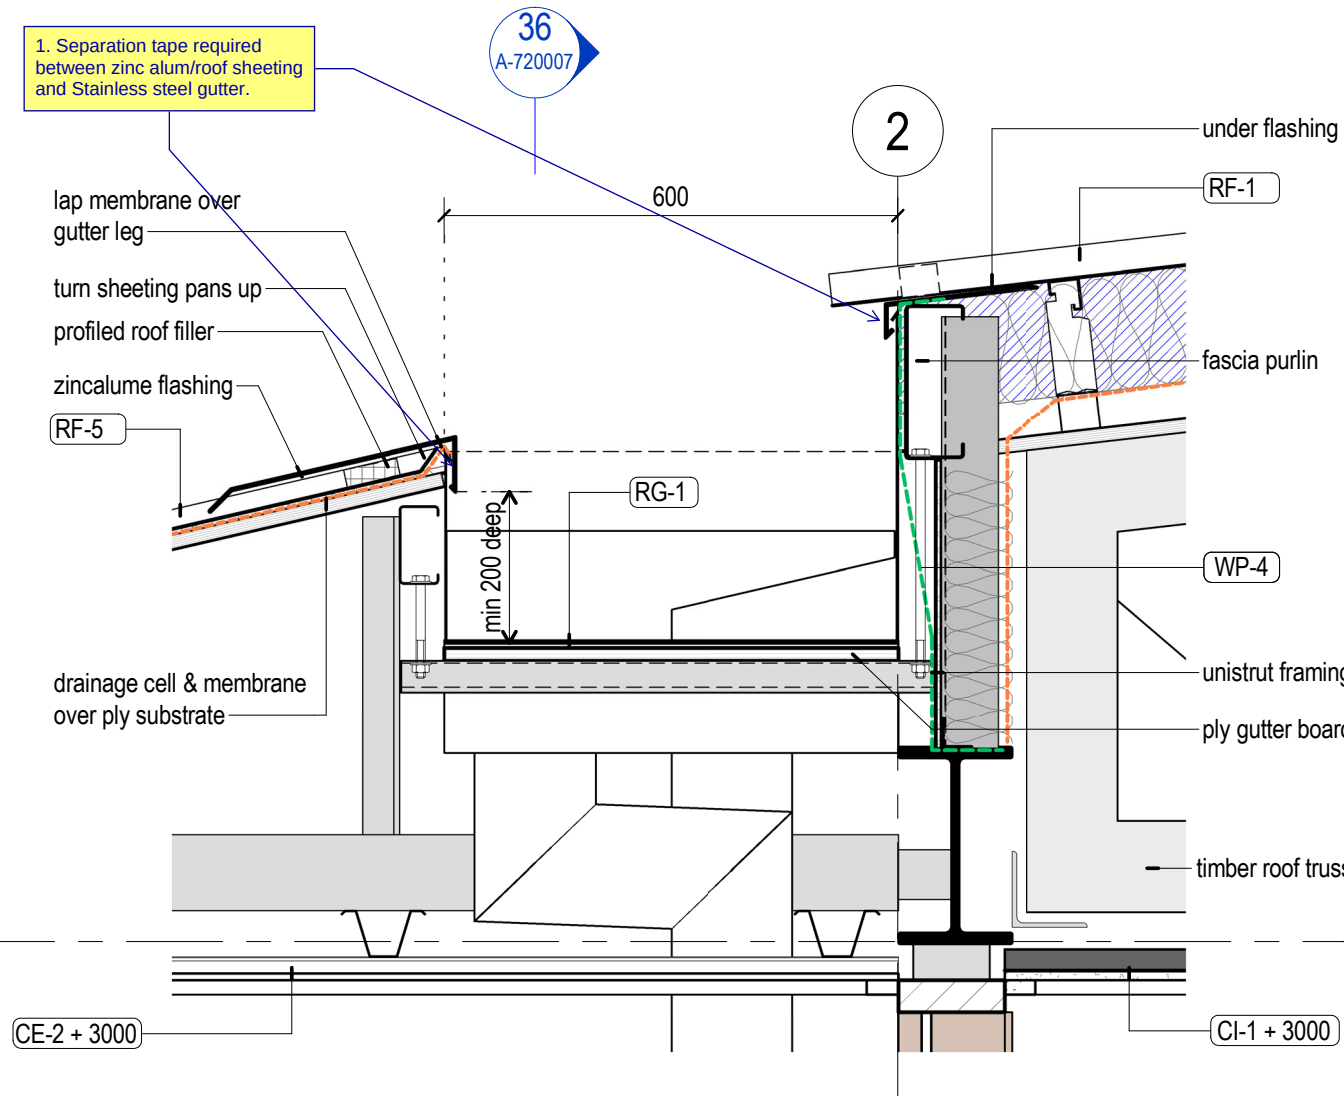


31 RG-1 Box Gutter Section
1:10

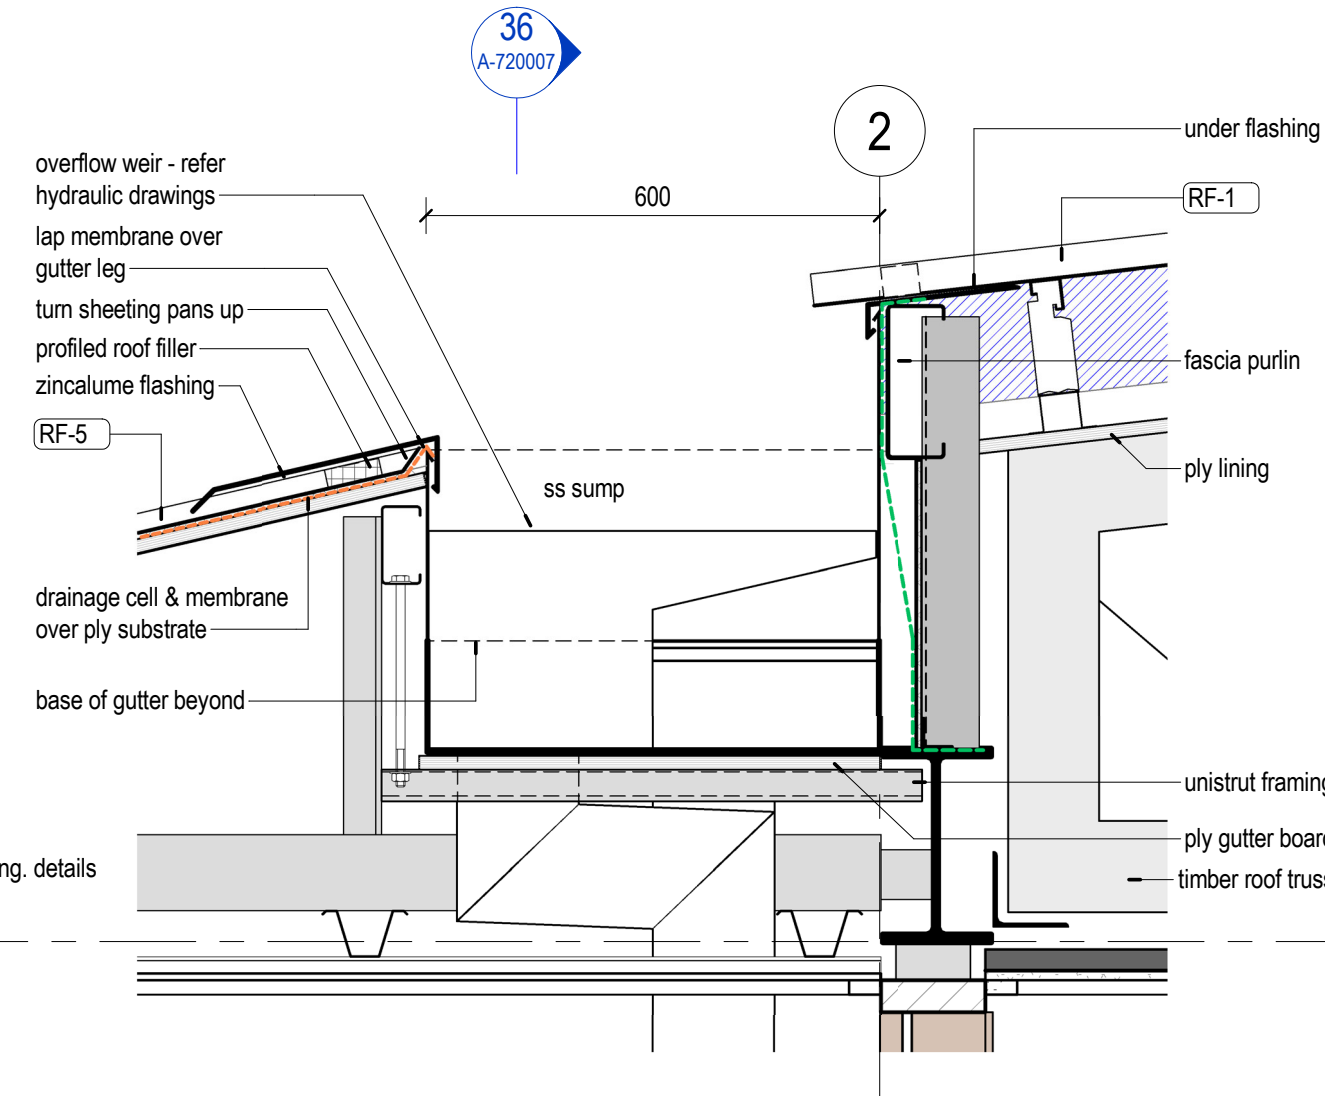


34 RG-1 Box Gutter Sump Section
1:10

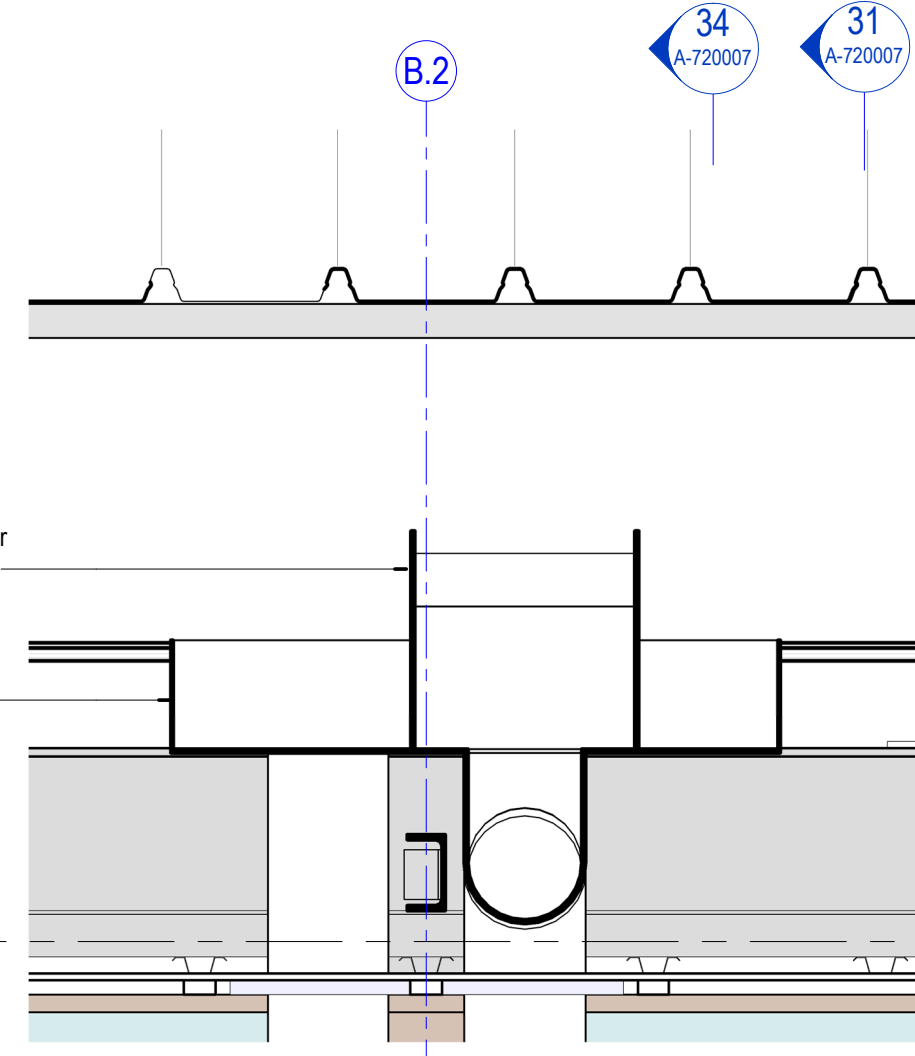


36 RG-1 Box Gutter Sump Long Section
1:10

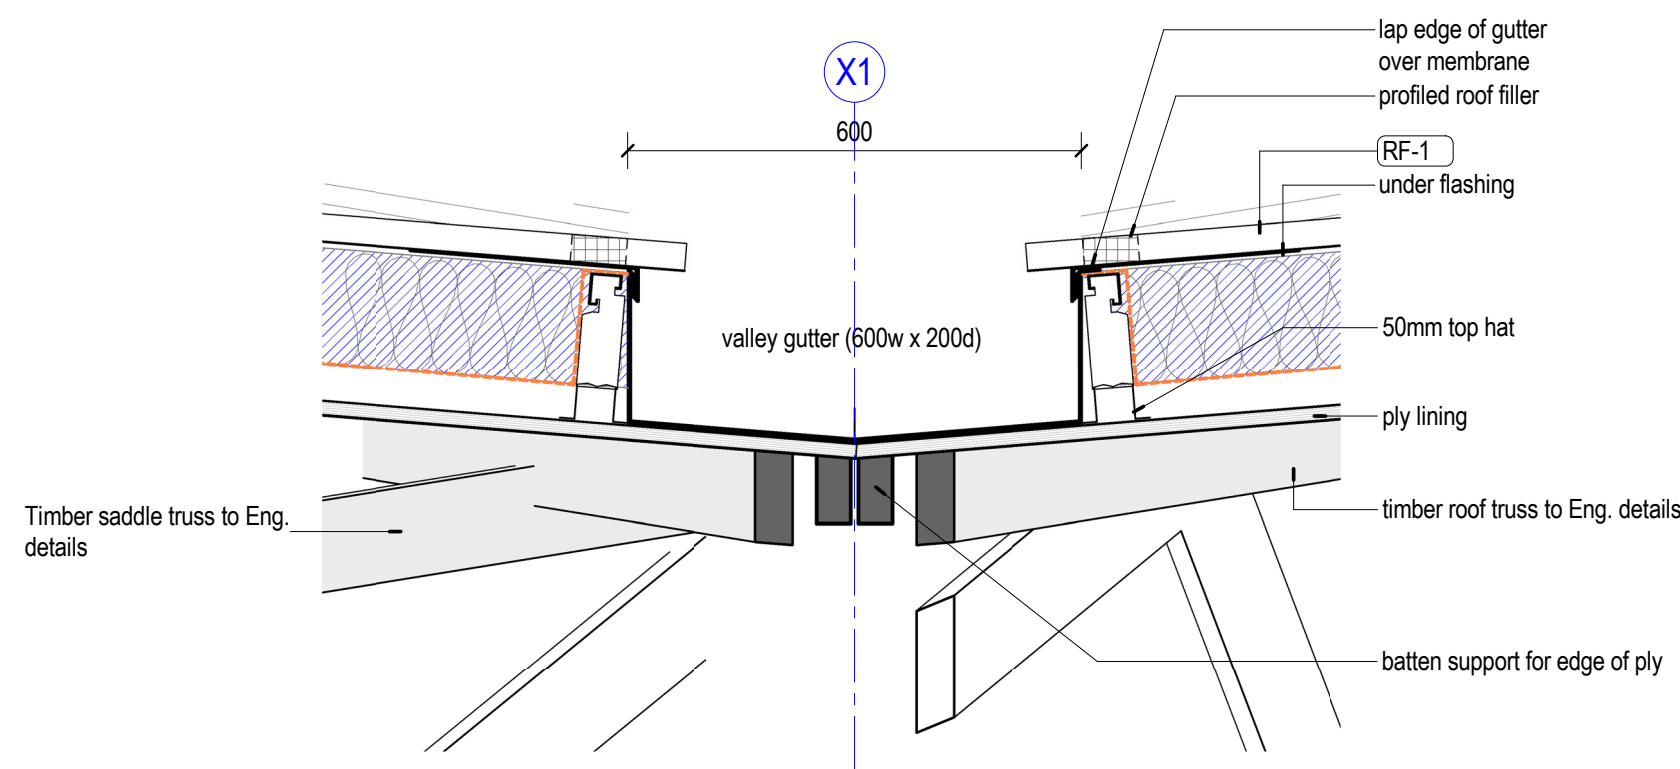


37 Valley Gutter Detail Section
1:10

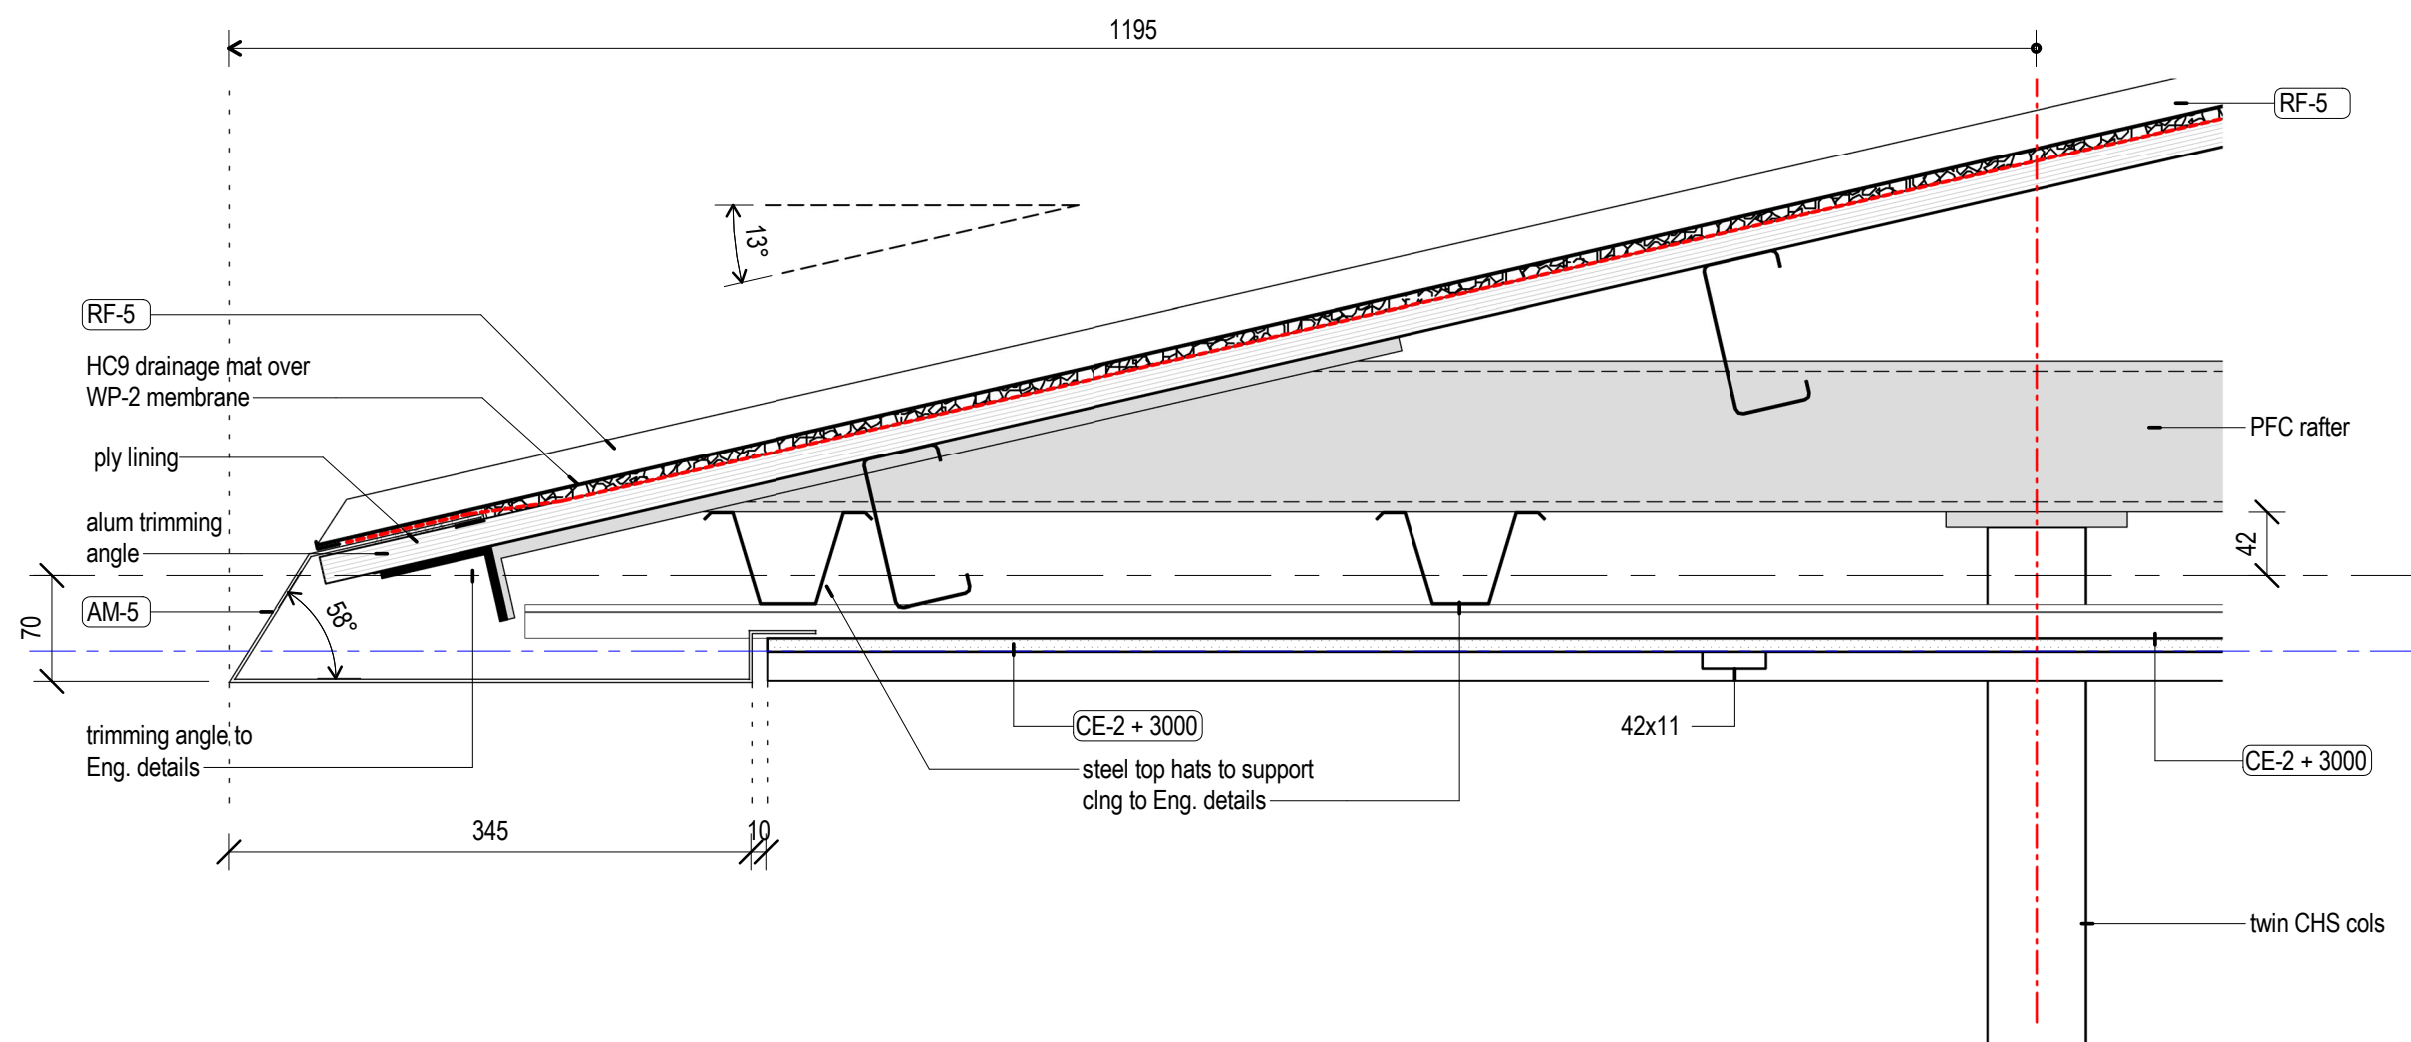


1 Courtyard North + West Facade Section
1:5

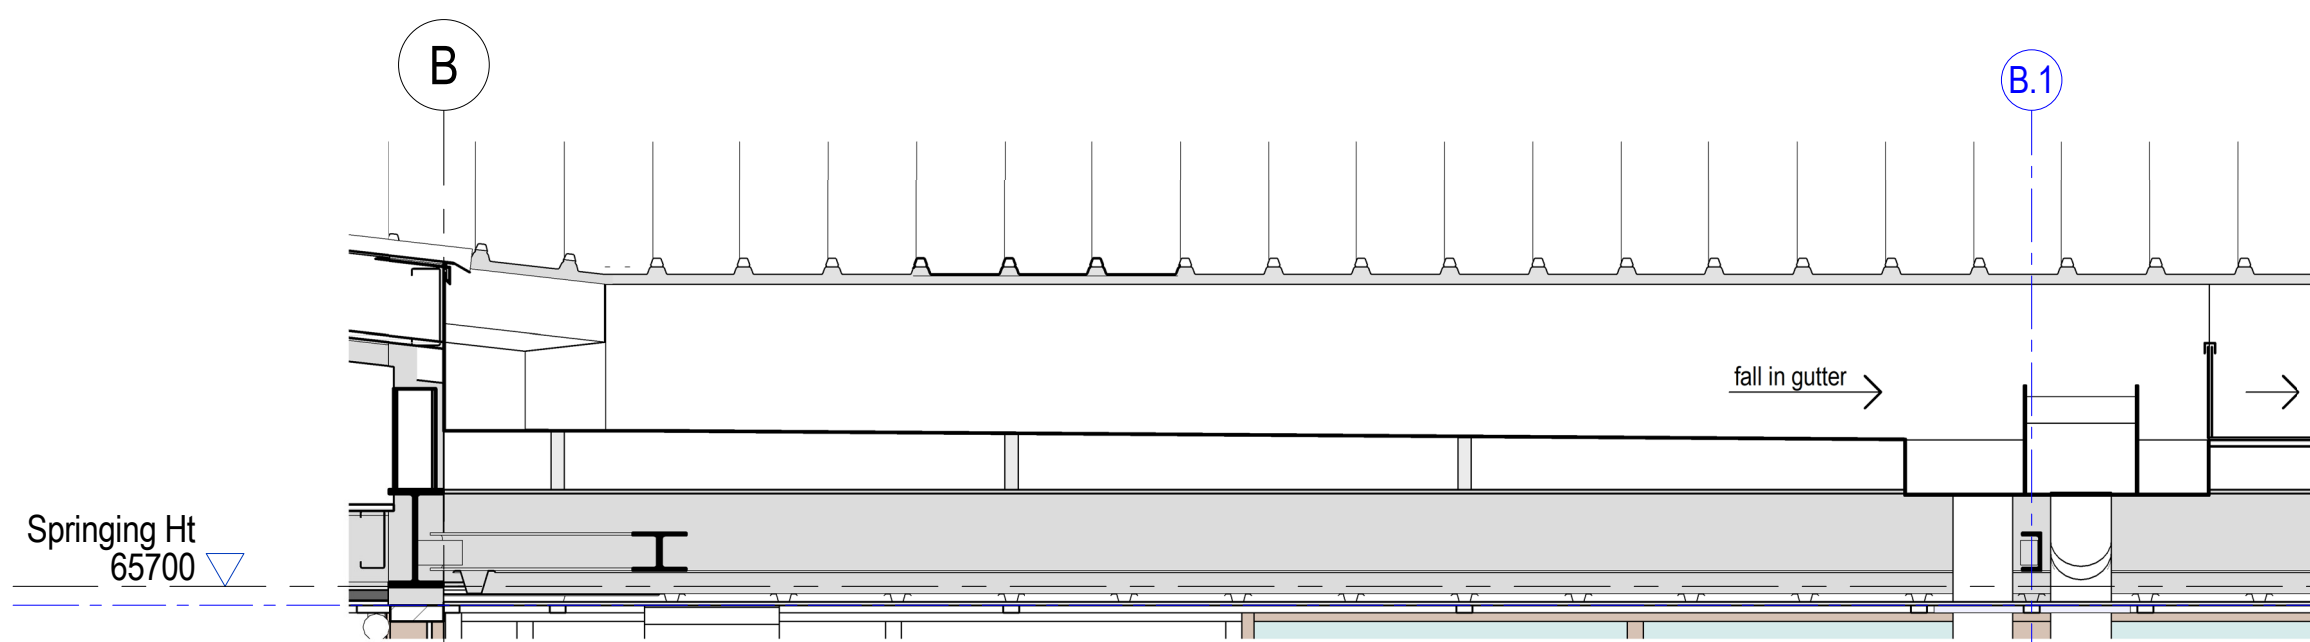

6 Valley Gutter to Sump
1:20

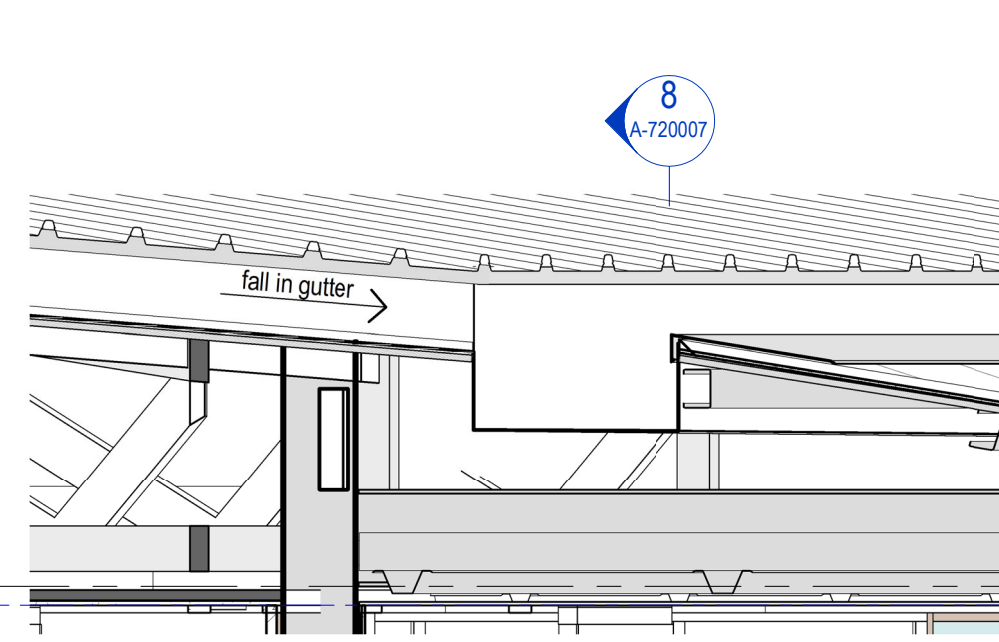

7 Valley Gutter Discharge
1:20

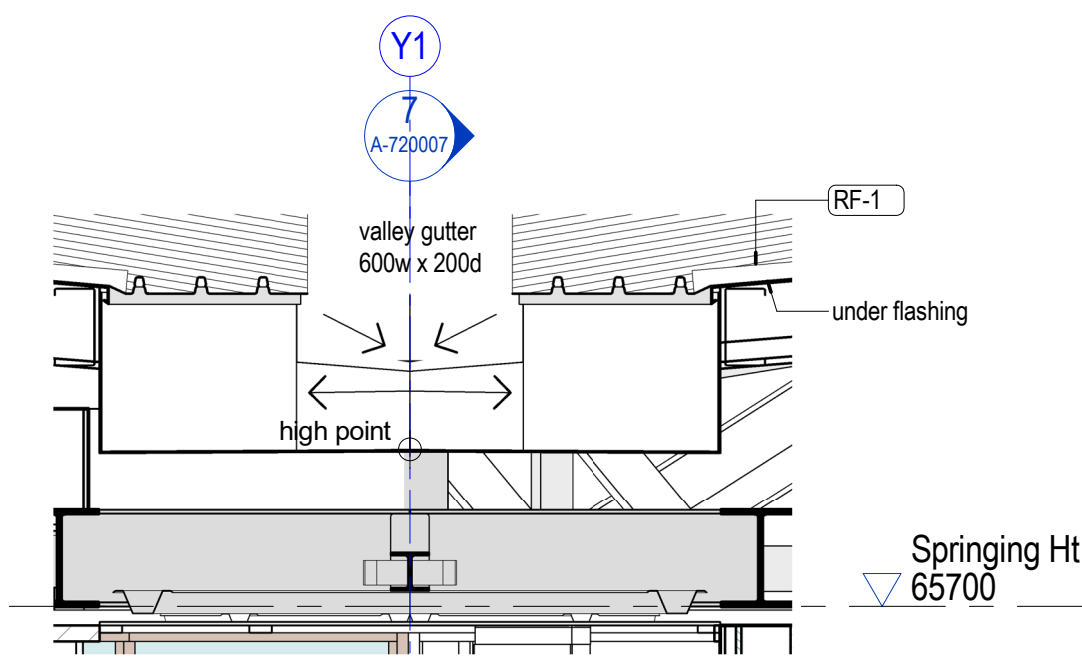

8 Valley Gutter Discharge Elevation
1:20

rev	date	description	initial
1	08/09/2025	QS Issue	JB
2	19/09/2025	100% DD Issue	JB
3	21/11/2025	CD Coordination Issue	JB
4	28/11/2025	Pre-Tender Estimate	JB
5	16/12/2025	Facade Detail Update	JB



DETAILS NOTES

- All aluminium flashings @ floor level to be min. 1.6 thick. Flashings to be installed with end dams at each end and fully sealed at the corners and vertical framing junctions. Flashings must be continuous and wrap around steel columns where they exist. Water hose test required for weatherproofing validation and flood test required for sub-sill after installation of sub-jamb & sub-sill.
- For all screw fixings between timber or aluminium framed cladding and the substrate, apply a blob of sealant before installation and seal screw heads after. Use stainless steel screws/anchors only.
- Install separation tape between dissimilar materials to prevent corrosion.

FACADE LEGEND

- WP-2 Ext. bonded membrane
- Folded aluminium flashing
- WP-1 or 3 Floor Waterproof Membrane
- WP-4 Ext. non-bonded membrane
- Roof sarking

Drawings include colour information. A black & white copy may not have all the information. This background is coloured blue.

brian hooperarchitect
m3architecture

ph: +61 7 3831 4644
11 saint james street petrie tce q 4000
info@m3architecture.com
www.m3architecture.com

client **stanwell**

project **Stanwell New Projects Office**
Switchyard Road,
Stanwell, QLD, 4702

title **Section Details - Roof**

drawn bg
checked JB
date Nov 2025
scale As indicated at A1
drawing 25010 / cd A-720007 / 5

copyright ©
These designs, plans, specifications and the copyright herein are the property of the architect and must not be used, reproduced, or copied wholly or in part without the written permission of m3architecture Pty Ltd abn 23 079 044 545. Use figured dimensions in preference to scale. If there are any questions contact the architect.

1:5 at A1
0 50 100 150 200 250mm