


BUILDING 33 REDEVELOPMENT

554/700 YAAMBA ROAD,
NORMAN GARDENS QLD 4701

COVER SHEET DRAWING LIST		
CQU-ROK-033-GN-ARC-	00-00	COVER SHEET
CQU-ROK-033-GN-ARC-	10-00	SITE CONTEXT PLAN
CQU-ROK-033-GN-ARC-	10-01	PROPOSED SITE PLAN
CQU-ROK-033-GN-ARC-	20-00	EXISTING PLAN - GROUND FLOOR
CQU-ROK-033-GN-ARC-	20-01	DEMOLITION PLAN - GROUND FLOOR
CQU-ROK-033-GN-ARC-	20-10	EXISTING CEILING PLAN - GROUND FLOOR
CQU-ROK-033-GN-ARC-	20-11	DEMOLITION CEILING PLAN - GROUND FLOOR
CQU-ROK-033-GN-ARC-	21-10	FLOOR PLAN - GROUND FLOOR
CQU-ROK-033-GN-ARC-	21-11	ROOF PLAN- NEW MECHANICAL PLATFORMS & WALKWAY
CQU-ROK-033-GN-ARC-	22-10	PERFORMANCE PLAN - GROUND FLOOR
CQU-ROK-033-GN-ARC-	22-20	PERFORMANCE CEILING PLAN - GROUND FLOOR
CQU-ROK-033-GN-ARC-	23-11	SLAB PLAN - GROUND FLOOR
CQU-ROK-033-GN-ARC-	25-11	PARTITION PLAN - GROUND FLOOR
CQU-ROK-033-GN-ARC-	26-11	CEILING PLAN - GROUND FLOOR
CQU-ROK-033-GN-ARC-	28-11	FINISHES PLAN - GROUND FLOOR
CQU-ROK-033-GN-ARC-	28-12	FURNITURE & JOINERY PLAN - GROUND FLOOR
CQU-ROK-033-GN-ARC-	30-00	BUILDING ELEVATIONS - SHEET 1
CQU-ROK-033-GN-ARC-	30-01	BUILDING ELEVATIONS - SHEET 2
CQU-ROK-033-GN-ARC-	31-00	BUILDING SECTIONS
CQU-ROK-033-GN-ARC-	40-00	CONSTRUCTION DETAILS - SHEET 1
CQU-ROK-033-GN-ARC-	40-01	CONSTRUCTION DETAILS - SHEET 2
CQU-ROK-033-GN-ARC-	40-02	CONSTRUCTION DETAILS- SHEET 3
CQU-ROK-033-GN-ARC-	50-11	DOOR SCHEDULE
CQU-ROK-033-GN-ARC-	50-41	TYPICAL UNISEX ACCESSIBLE WET AREA SETOUTS
CQU-ROK-033-GN-ARC-	60-01	INTERNAL ELEVATIONS - SHEET 1
CQU-ROK-033-GN-ARC-	60-02	INTERNAL ELEVATIONS - SHEET 2
CQU-ROK-033-GN-ARC-	60-03	INTERNAL ELEVATIONS - SHEET 3
CQU-ROK-033-GN-ARC-	61-00	AMENITIES - SHEET 1
CQU-ROK-033-GN-ARC-	64-00	INTERIOR DETAILS
CQU-ROK-033-GN-ARC-	70-01	JOINERY DETAILS
CQU-ROK-033-GN-ARC-	70-02	JOINERY DETAILS
CQU-ROK-033-GN-ARC-	70-03	JOINERY DETAILS
CQU-ROK-033-GN-ARC-	70-04	JOINERY DETAILS
CQU-ROK-033-GN-ARC-	70-05	JOINERY DETAILS
CQU-ROK-033-GN-ARC-	70-06	JOINERY DETAILS
CQU-ROK-033-GN-ARC-	70-07	JOINERY DETAILS
CQU-ROK-033-GN-ARC-	70-08	JOINERY DETAILS
CQU-ROK-033-GN-ARC-	70-09	JOINERY DETAILS
CQU-ROK-033-GN-ARC-	70-10	JOINERY DETAILS
CQU-ROK-033-GN-ARC-	72-00	TYPICAL JOINERY DETAILS
CQU-ROK-033-GN-ARC-	72-01	TYPICAL JOINERY DETAILS

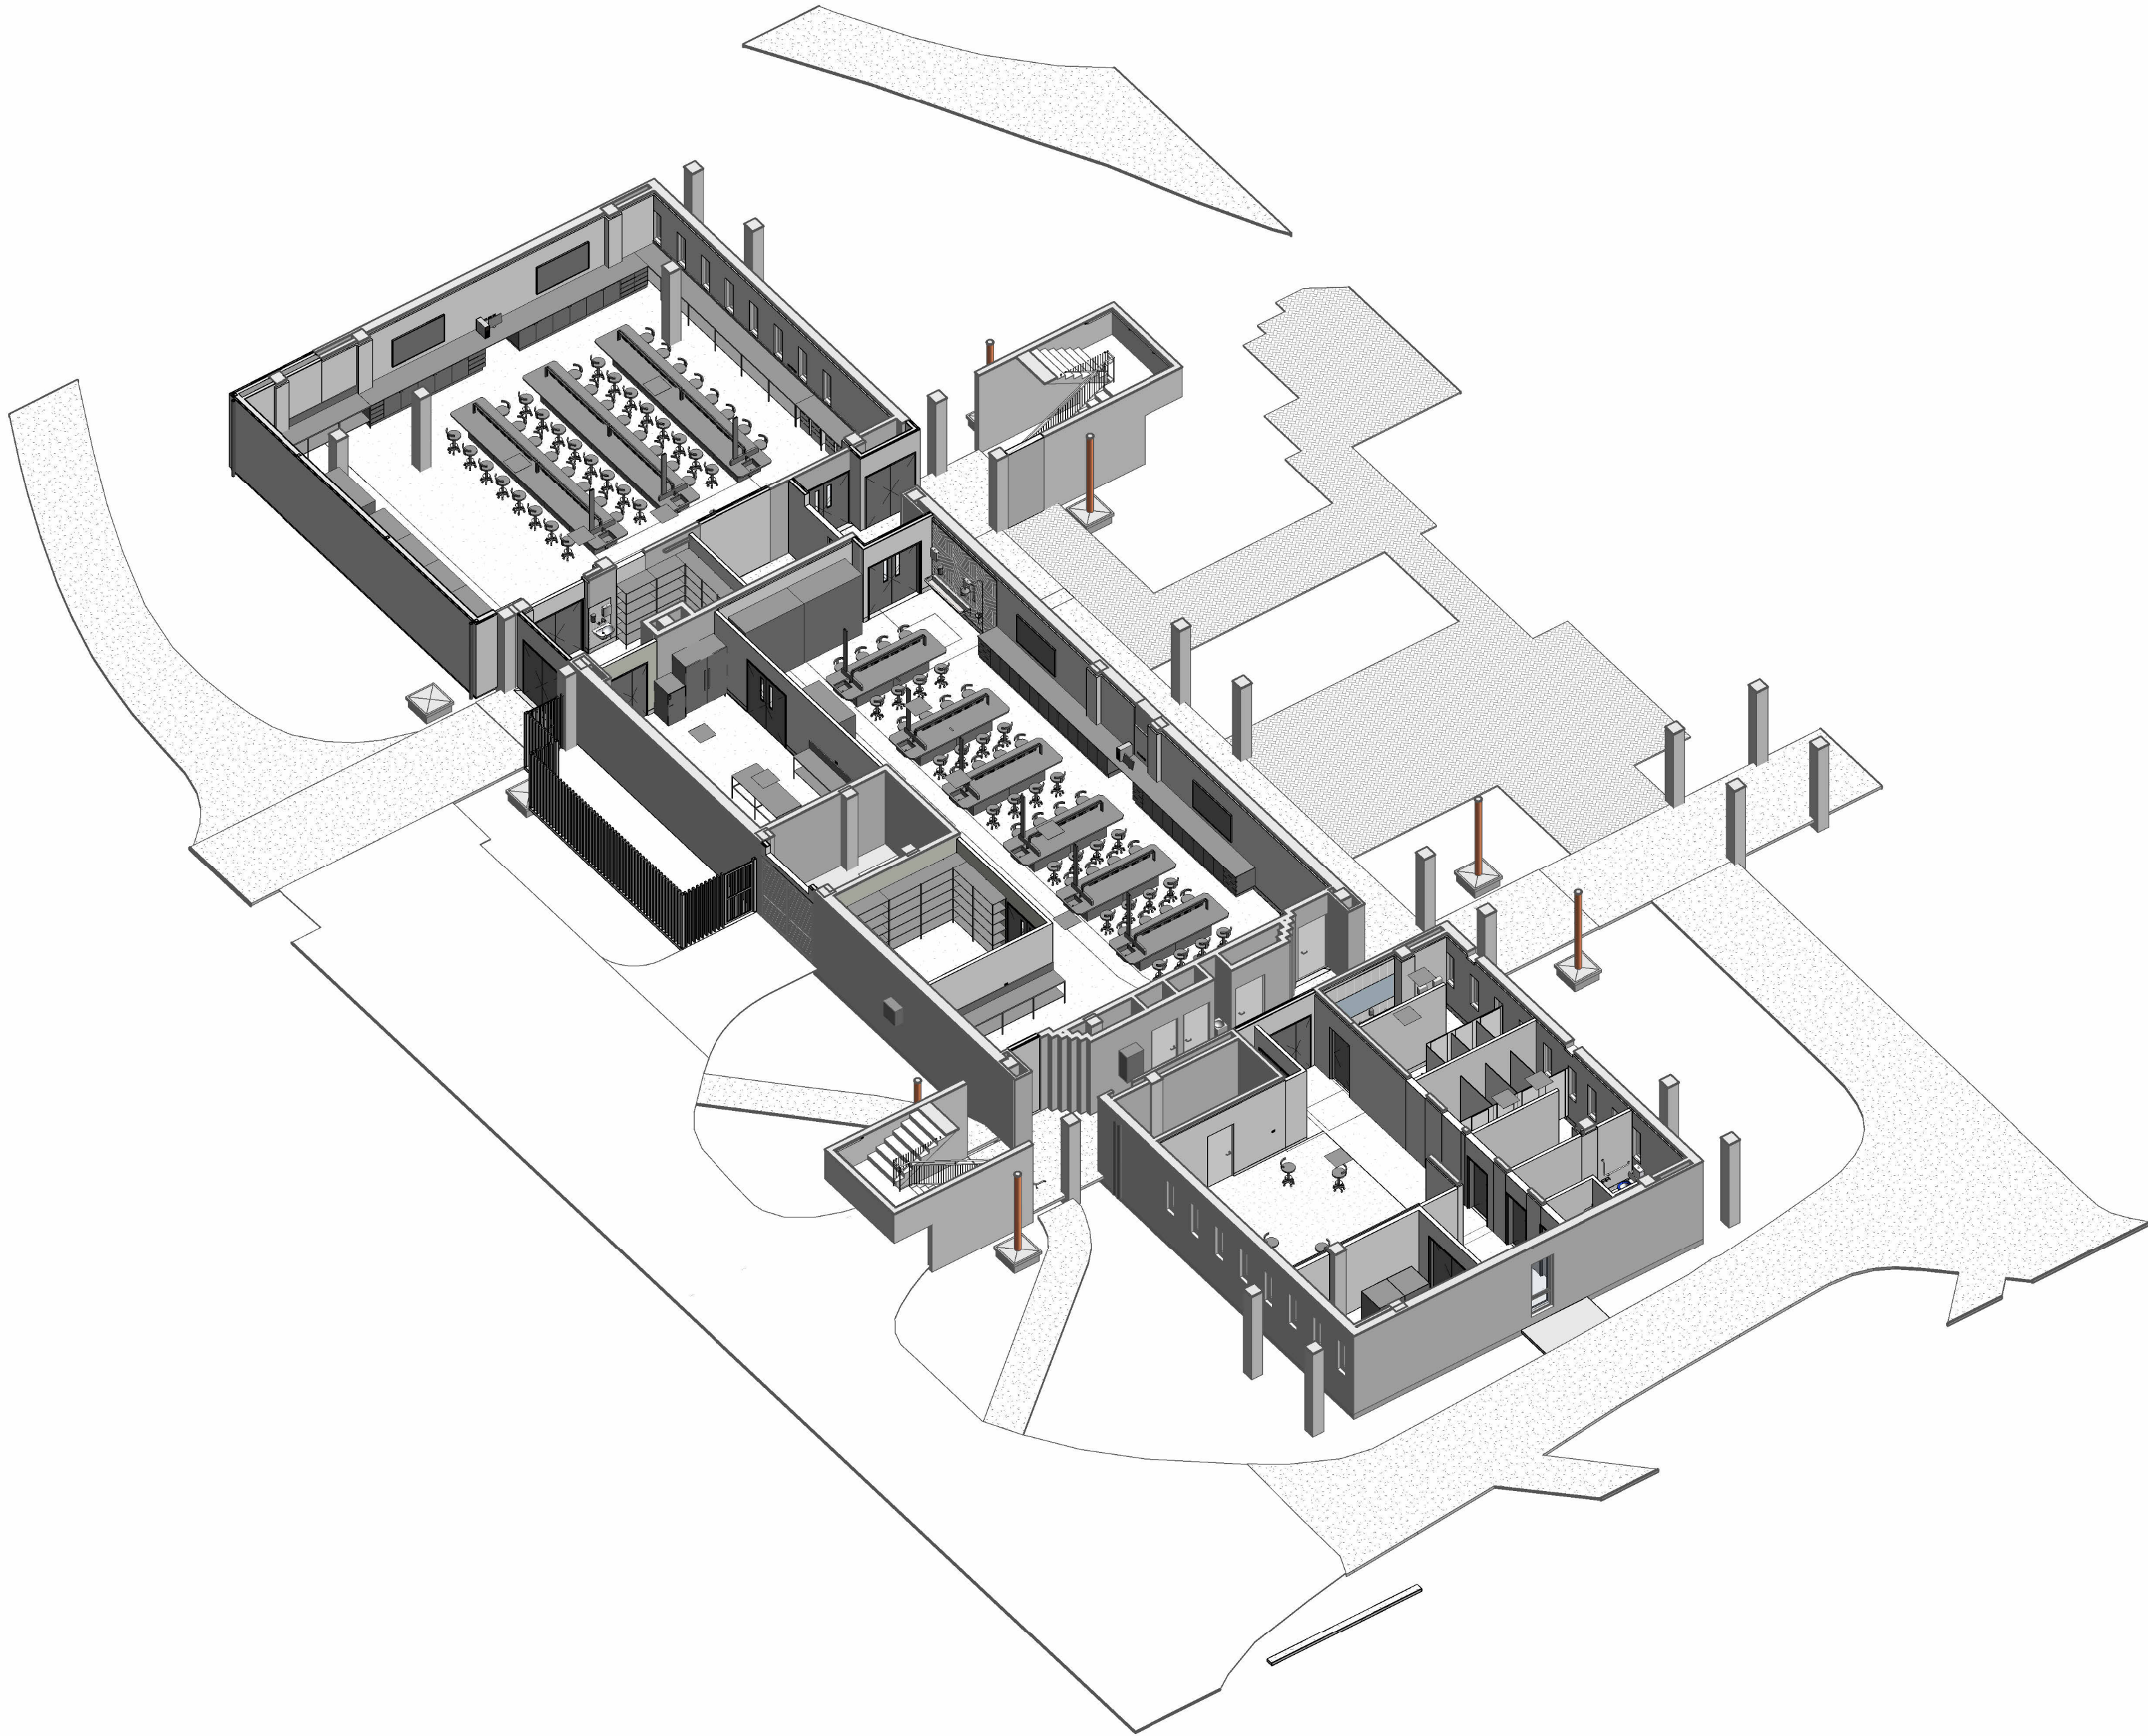

AS CONSTRUCTED

thomson
adsett

Telephone +61 7 3840 9999
bne@thomsonadsett.com
Level 9, 470 St Pauls Terrace
Fortitude Valley
Qld 4006 Australia
thomsonadsett.com

© Copyright
These drawings and designs and the copyright thereof are the property of Thomson Adsett Pty Ltd and must not be used, retained or copied without written permission of Thomson Adsett Pty Ltd. ABN 76 105 314 654 Trading as ThomsonAdsett. Dimensions take precedence over scaling. Do not measure off drawings as print sizes may vary

BUILDING 33 REDEVELOPMENT

554/700 YAAMBA ROAD,
NORMAN GARDENS QLD 4701

for
CQUniversity
NORTH ROCKHAMPTON CAMPUS
& GIRVAN



GIRVAN

B	25/06/2024	AS CONSTRUCTED	PB
A	02/02/2024	IFC	PB
4	20/09/2023	ISSUE FOR INFORMATION	WL
3	11/09/2023	AMENDED 60% DD ISSUE	PB
2	28/08/2023	60% DD ISSUE	WL
1	04/08/2023	PRELIMINARY ISSUE	WL

rev/	date	details	init.
------	------	---------	-------

drawn	date
WL	JUL 2023
checked	date
NC	JUL 2023
verified	date
GK	DEC 2023

scale	
-------	--

COVER SHEET

scale	project no.
@ A1	23.0078.17

sheet no.	revision
CQU-ROK-033-GN-ARC-00-00	B

original sheet size - A1 (594mm x 841mm)

C:\REVIT\LOCAL\FILES\23.0078.17_CQU Building 33 Redevelopment_2023_Philip Bugden.nt 21/07/2024 4:52:16 PM

554/700 YAAMBA ROAD,
NORMAN GARDENS QLD 4701

for
CQUniversity
NORTH ROCKHAMPTON CAMPUS
& GIRVAN



GIRVAN

B	25/06/2024	AS CONSTRUCTED	PB
A	02/02/2024	IFC	PB
4	20/09/2023	ISSUE FOR INFORMATION	WL
3	11/09/2023	AMENDED 60% DD ISSUE	PB
2	28/08/2023	60% DD ISSUE	WL
1	04/08/2023	PRELIMINARY ISSUE	WL
rev	date	details	init.

drawn	date
WL	JUL 2023
checked	date
NC	JUL 2023
verified	date
GK	DEC 2023

scale



SITE CONTEXT PLAN

scale
1 : 2500 @ A1
sheet no.
CQU-ROK-033-GN-ARC-10-00
revision
B

original sheet size - A1 (594mm x 841mm)

AS CONSTRUCTED



BUILDING REFURBISHMENT ON
GROUND FLOOR ONLY (SHOWN IN
HATCH AREA)

BRUCE HIGHWAY

AS CONSTRUCTED

BUILDING 33
REDEVELOPMENT

554/700 YAAMBA ROAD,
NORMAN GARDENS QLD 4701

for
CQUniversity
NORTH ROCKHAMPTON CAMPUS
& GIRVAN



GIRVAN

B	25/06/2024	AS CONSTRUCTED	PB
A	02/02/2024	IFC	PB
4	20/09/2023	ISSUE FOR INFORMATION	WL
3	11/09/2023	AMENDED 60% DD ISSUE	PB
2	28/08/2023	60% DD ISSUE	WL
1	04/08/2023	PRELIMINARY ISSUE	WL

rev	date	details	init
-----	------	---------	------

drawn	date
WL	JUL 2023
checked	date
NC	JUL 2023
verified	date
GK	DEC 2023

scale


PROPOSED SITE PLAN


scale
1 : 200 @ A1

project no.
23.0078.17

sheet no.
CQU-ROK-033-GN-ARC-10-01

revision
B

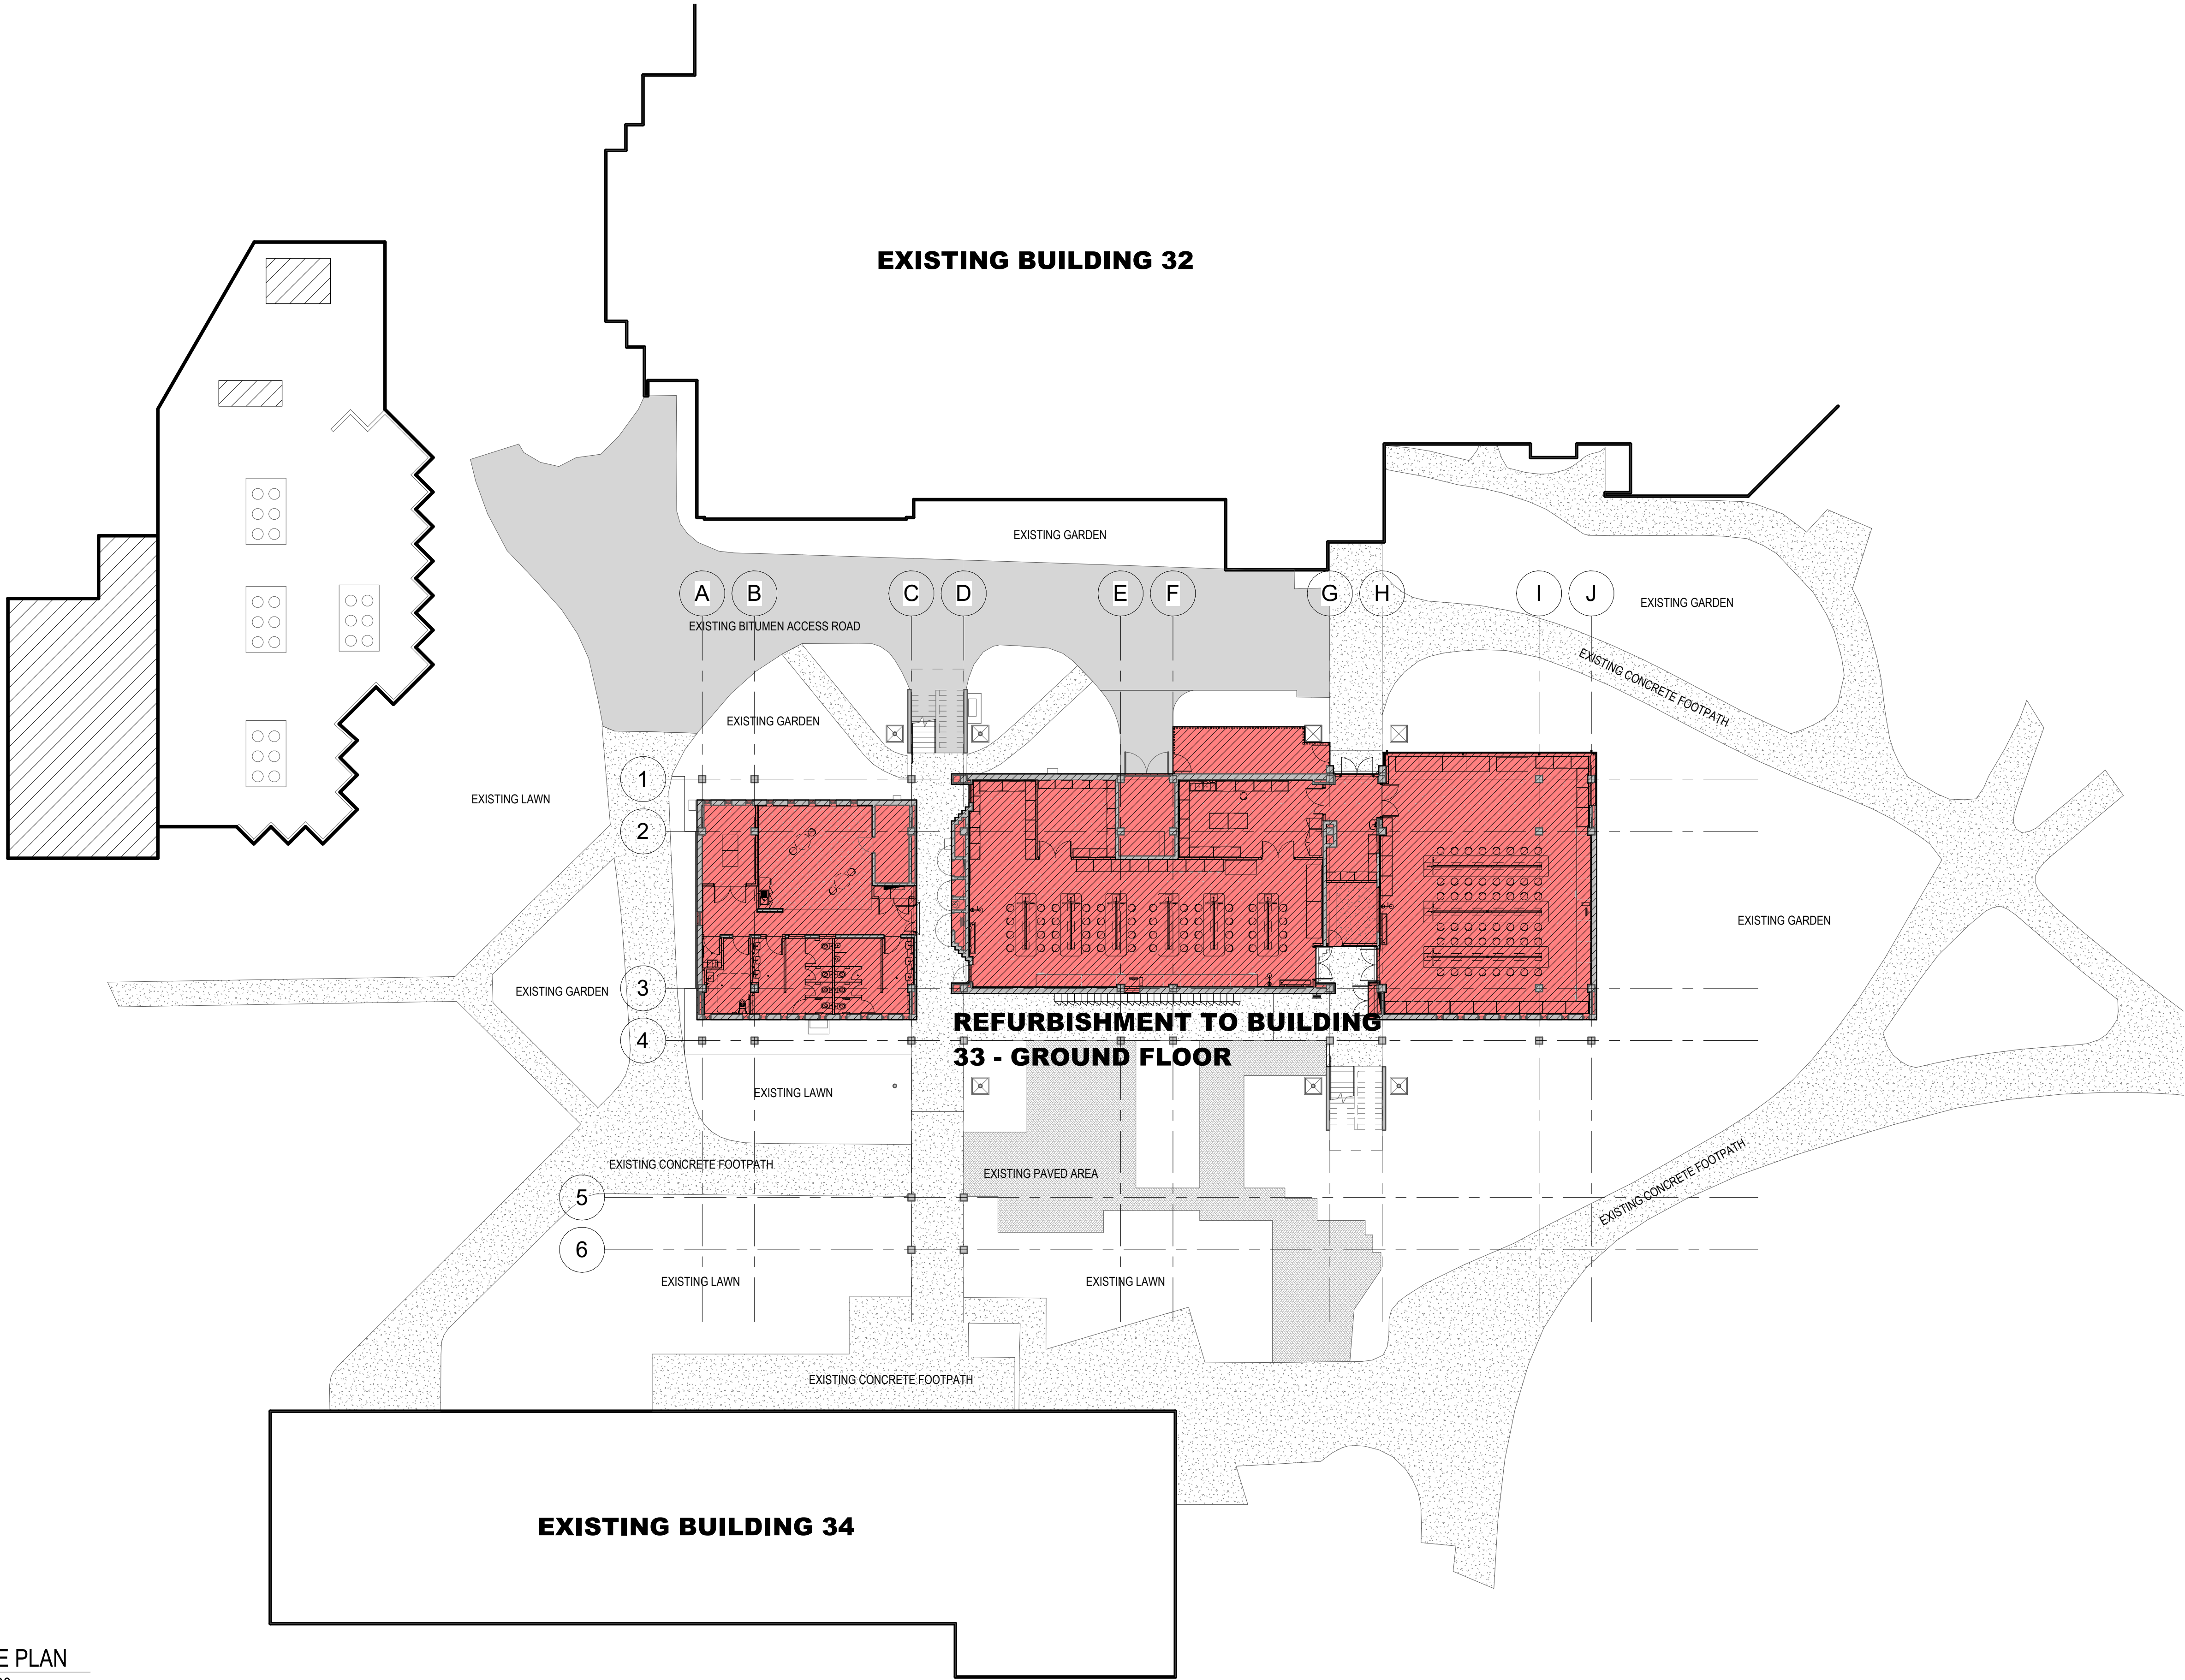

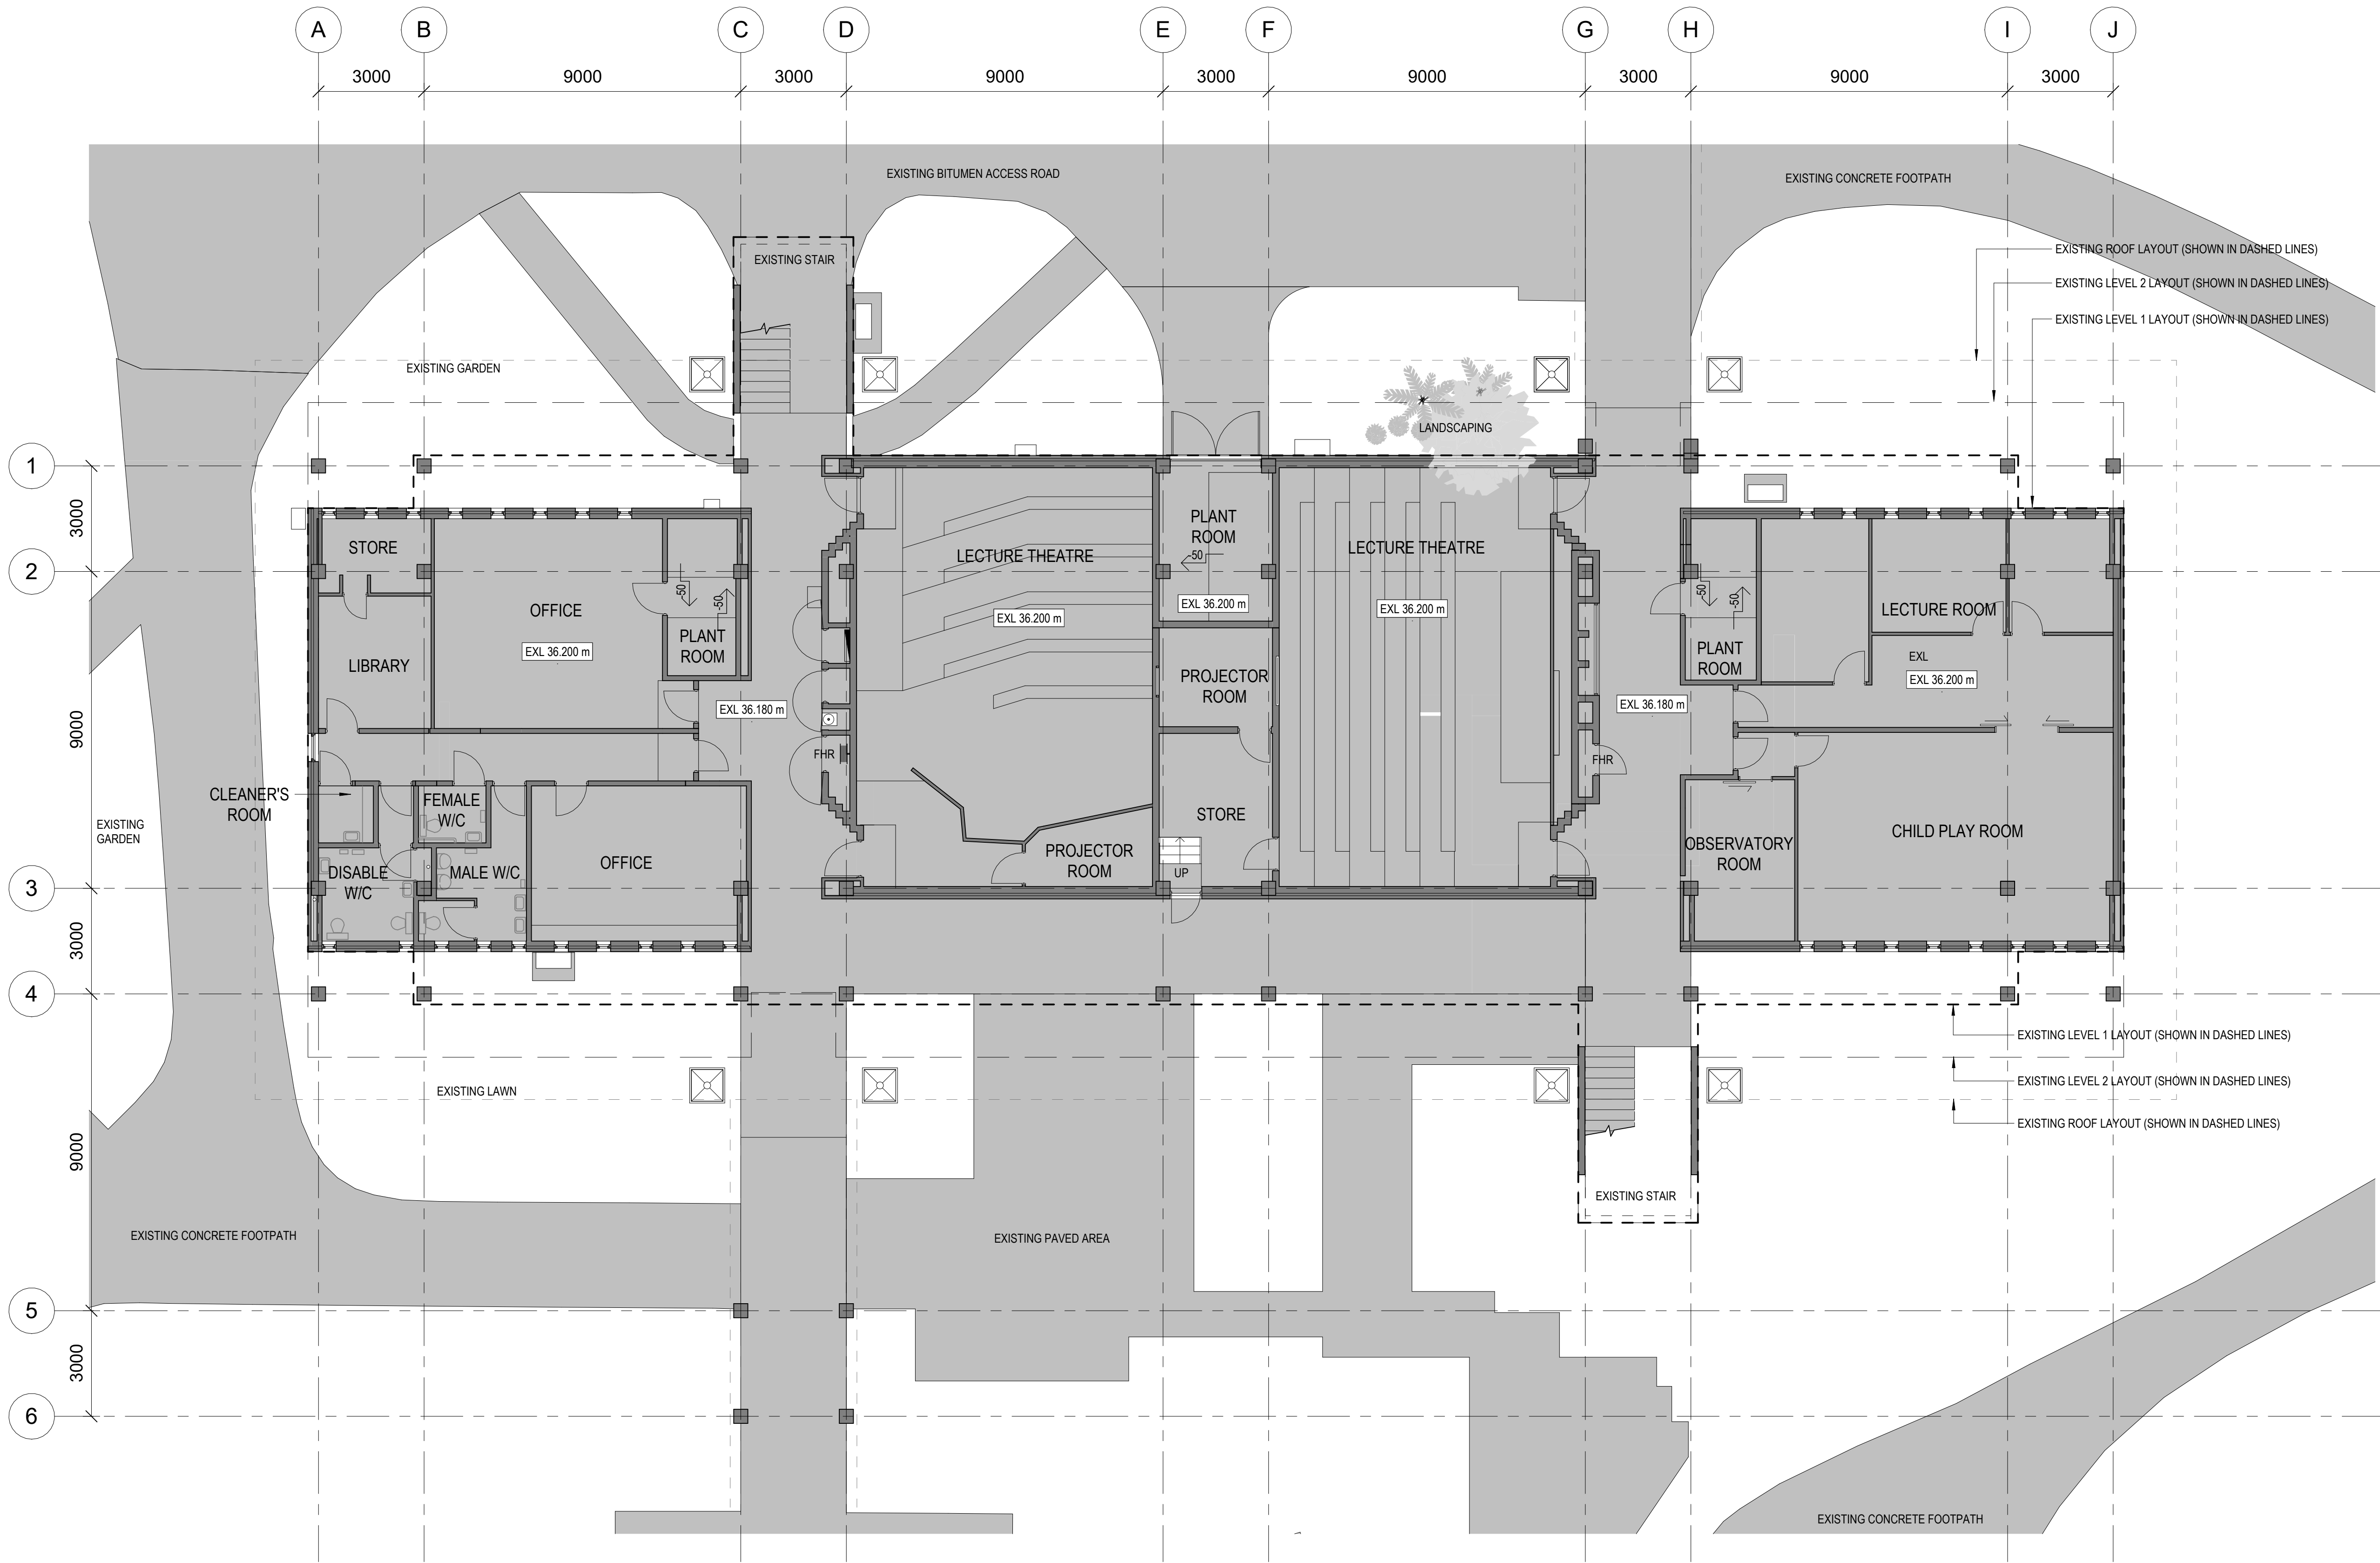

LEGEND	
EXL	EXISTING FLOOR LEVEL

1 EXISTING GROUND FLOOR PLAN
1 : 100

NOTE:
- CHECK EXISTING SITE LEVELS & BUILDING SFL
ON SITE

thomson
adsett

Telephone +61 7 3840 9999
bne@thomsonadsett.com
Level 9, 470 St Pauls Terrace
Fortitude Valley
Qld 4006 Australia
thomsonadsett.com

© Copyright
These drawings and designs and the copyright
thereof are the property of Thomson Adsett Pty
Ltd and must not be used, retained or copied
without written permission of Thomson Adsett
Pty Ltd. ABN 76 105 314 654 Trading as
ThomsonAdsett. Dimensions take precedence
over scaling. Do not measure off drawings as
print sizes may vary

BUILDING 33
REDEVELOPMENT

554/700 YAAMBA ROAD,
NORMAN GARDENS QLD 4701

for
CQUniversity
NORTH ROCKHAMPTON CAMPUS
& GIRVAN



GIRVAN

B	25/06/2024	AS CONSTRUCTED	PB
A	02/02/2024	IFC	PB
4	20/09/2023	ISSUE FOR INFORMATION	WL
3	11/09/2023	AMENDED 60% DD ISSUE	PB
2	28/08/2023	60% DD ISSUE	WL
1	04/08/2023	PRELIMINARY ISSUE	WL

rev	date	details	init.
-----	------	---------	-------

drawn	date
WL	JUL 2023
checked	date
NC	JUL 2023
verified	date
GK	DEC 2023

scale

EXISTING PLAN - GROUND
FLOOR

scale project no.
1 : 100 @ A1 23.0078.17

sheet no.
CQU-ROK-033-GN-ARC-20-00

revision
B

original sheet size - A1 (594mm x 841mm)

AS CONSTRUCTED

C:\REVIT\LOCAL FILES\23\0078.17_CQU Building 33 Redevelopment_2023_Philip Bugden.nt 2/07/2024 4:53:10 PM

BUILDING 33 REDEVELOPMENT

554/700 YAAMBA ROAD,
NORMAN GARDENS QLD 4701

for
CQUniversity
NORTH ROCKHAMPTON CAMPUS
& GIRVAN



GIRVAN

B	25/06/2024	AS CONSTRUCTED	PB
A	02/02/2024	IFC	PB
4	20/09/2023	ISSUE FOR INFORMATION	WL
3	11/09/2023	AMENDED 60% DD ISSUE	PB
2	28/08/2023	60% DD ISSUE	WL
1	04/08/2023	PRELIMINARY ISSUE	WL

rev	date	details	init
-----	------	---------	------

drawn	date
WL	JUL 2023
checked	date
NC	JUL 2023
verified	date
GK	DEC 2023

scale

DEMOLITION PLAN - GROUND FLOOR


scale
1 : 100 @ A1

project no.
23.0078.17

sheet no.
CQU-ROK-033-GN-ARC-20-01

revision
B

original sheet size - A1 (594mm x 841mm)

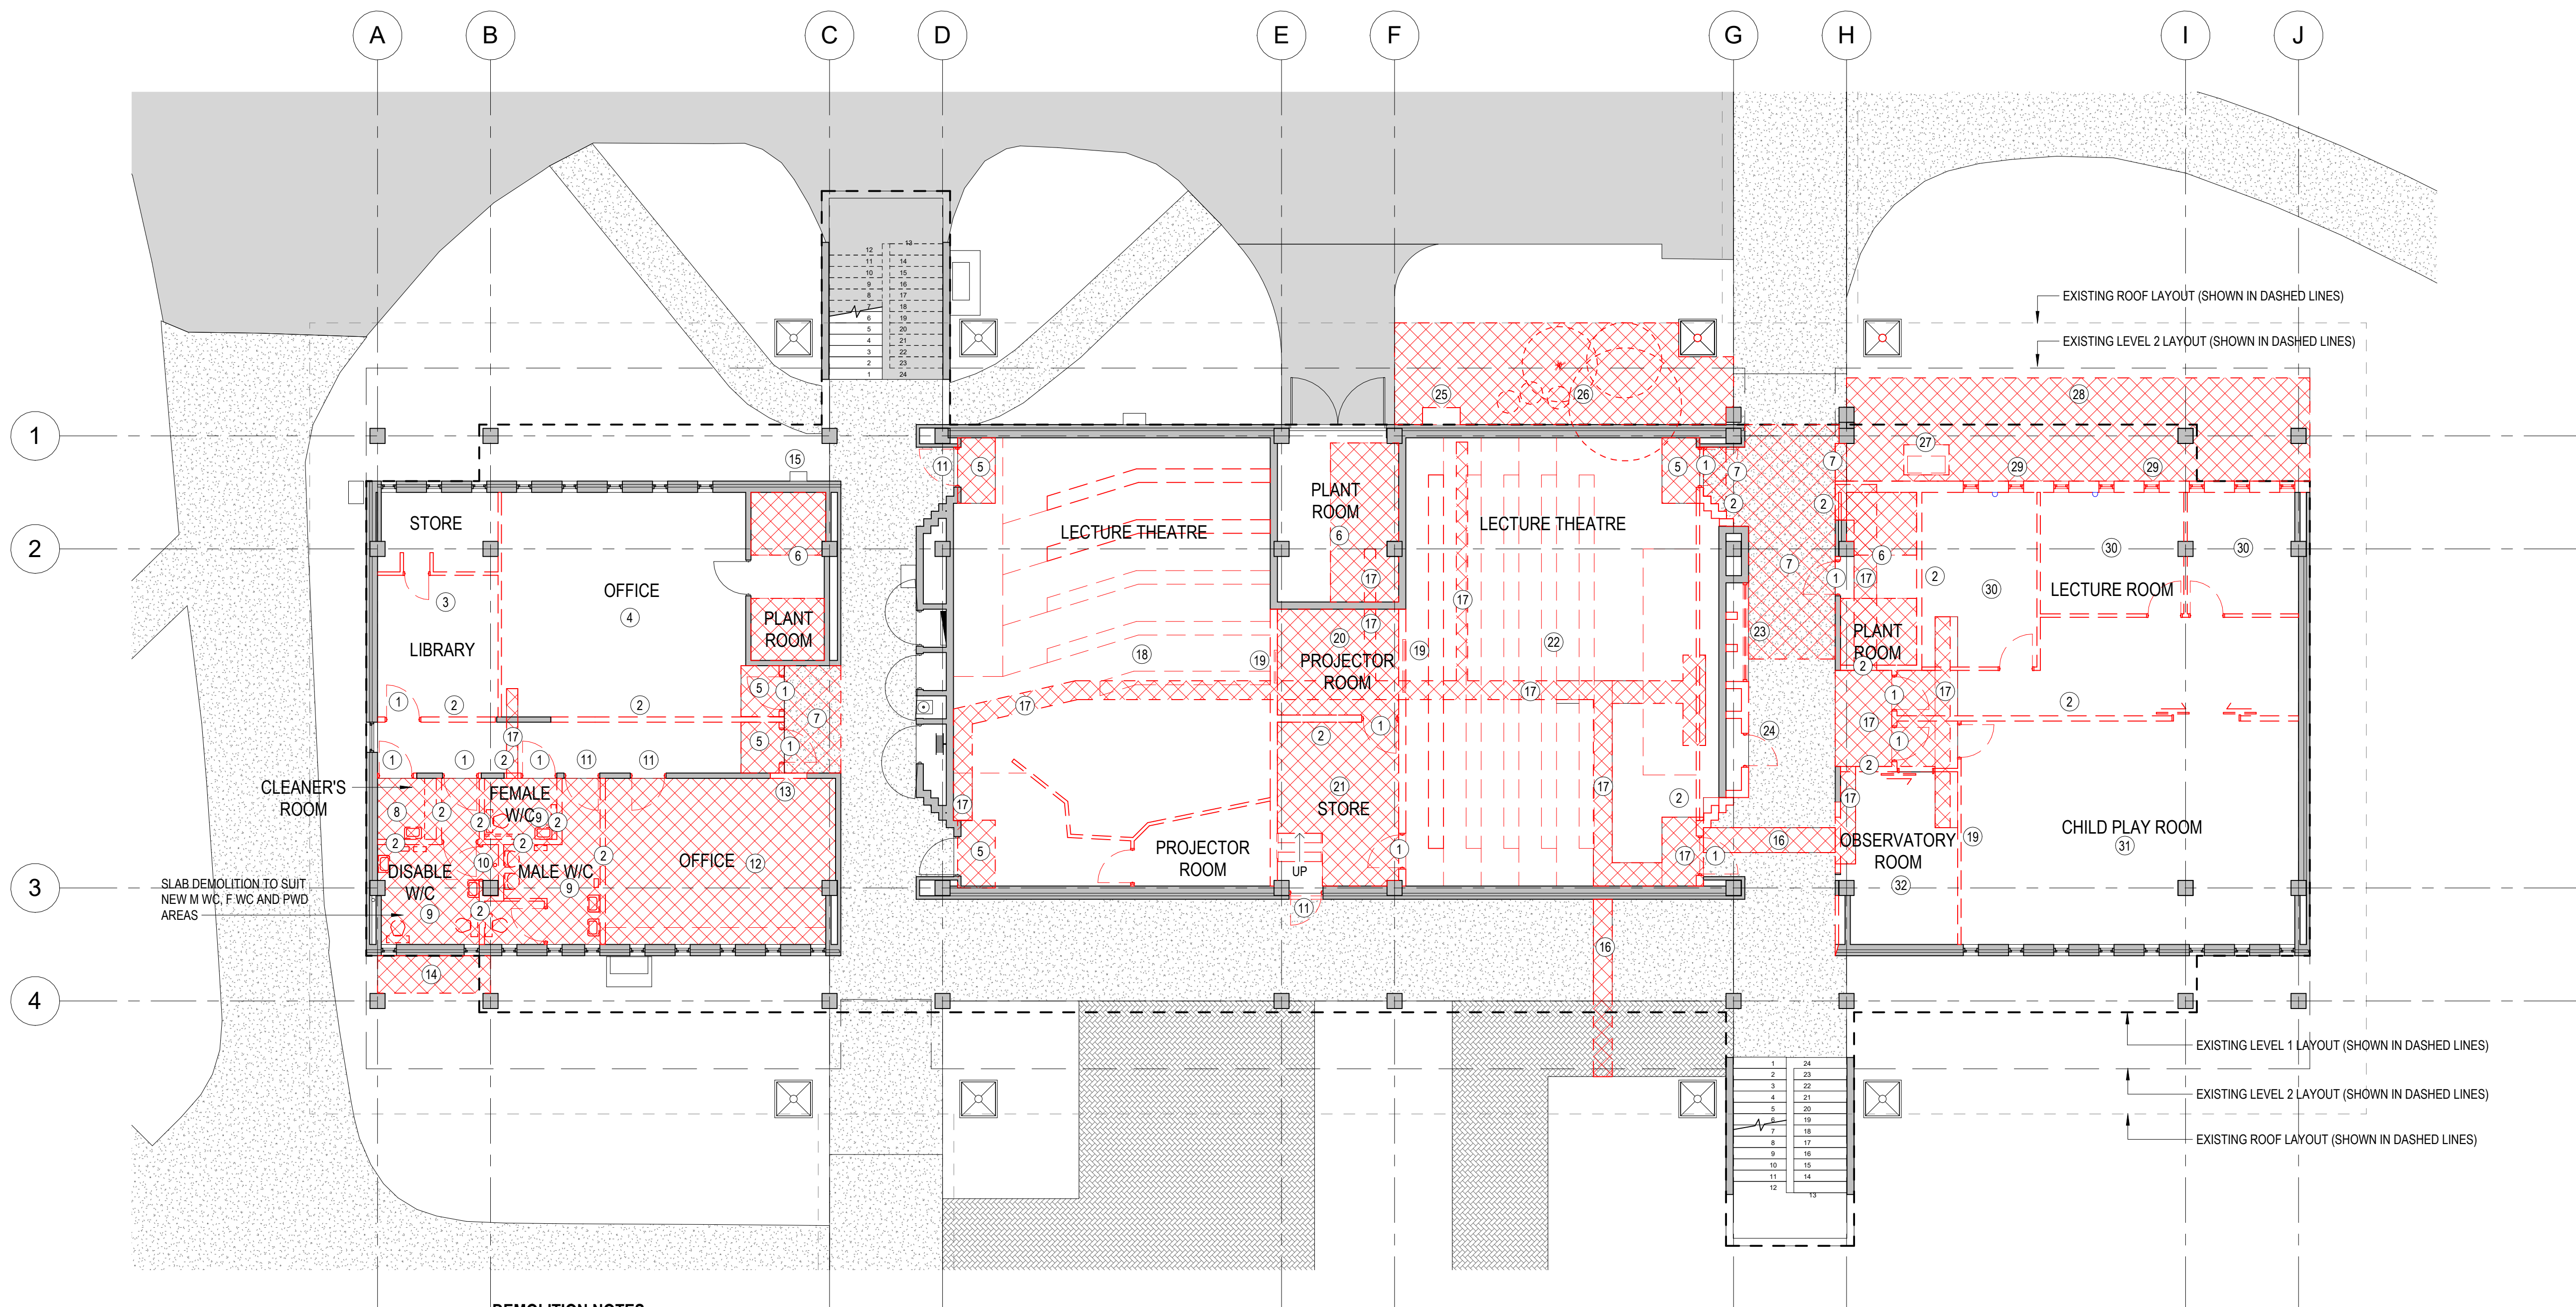

DEMOLITION NOTES:

- DEMOLISH EXISTING DOOR/ DOORS & PART OF THE EXISTING BLOCKWORKS
- DEMOLISH EXISTING BLOCKWORKS (STRUCTURAL ENGINEER TO REVIEW & ASSESS THE DEMOLITION AREA OF EXISTING WALL)
- DEMOLISH EXISTING FLOOR FINISH & SKIRTING BOARD. DISCONNECT ALL EXISTING ELECTRICAL SERVICES AND REMOVE ALL EXISTING LIGHTING, LIGHT SWITCH, GPDS & DATA. DEMOLISH EXISTING LIGHTWEIGHT WALLS.
- DEMOLISH EXISTING FLOOR FINISH & SKIRTING BOARD. DISCONNECT & REMOVE ALL EXISTING ELECTRICAL SERVICES
- DEMOLISH EXISTING 30mm FLOOR MATT REBATE & FILL-IN THE SETDOWN WITH NEW TOPPING. NEW FLOOR LEVEL (SFL) TO MATCH EXISTING ROOM LEVEL (COS)
- DEMOLISH EXISTING CONCRETE PLINTH- NEW FINISH LEVEL TO MATCH GROUND FLOOR SFL. DEMOLISH ALL EXISTING DUCTWORKS & PIPEWORKS. SEAL OFF & CAP OFF ALL EXISTING HYDRAULIC SERVICES. DISCONNECT & REMOVE ALL EXISTING ELECTRICAL SERVICES. ANY EXISTING SERVICES PENO TO SLAB ABOVE AND TO THE WALLS TO BE FILLED WITH FIRE RATED MATERIAL TO ACHIEVE FRL-120/120
- NEW TOPPING TO TOP OF THE EXISTING CORRIDOR SLAB. NEW FLOOR LEVEL (SFL) TO MATCH EXISTING ROOM LEVEL (COS)
- OPTION 1- DEMOLISH EXISTING SLAB-
I) TO CREATE NEW SLAB WITH 50mm SETDOWN FOR NEW TOPPING
II) FOR NEW PIPEWORKS CONNECTION & INSTALLATION.
*STRUCTURAL ENGINEER TO REVIEW THE EXTENT OF DEMOLITION AREA

OPTION 2- JACKHAMMER EXISTING SLAB & TOPPING TO CREATE NEW 50mm SETDOWN FOR NEW TOPPING. MAKE TRENCH TO EXISTING SLAB ONLY FOR NEW PIPEWORKS CONNECTION & INSTALLATION.

REMOVE ALL EXISTING JOINERY & PLUMBING FIXTURE. DISCONNECT & SEAL OFF ALL EXISTING PIPEWORKS. DISCONNECT & REMOVE ALL EXISTING ELECTRICAL SERVICES.

- OPTION 1- DEMOLISH EXISTING SLAB-
I) TO CREATE NEW SLAB WITH 50mm SETDOWN FOR NEW TOPPING
II) FOR NEW PIPEWORKS CONNECTION & INSTALLATION
*STRUCTURAL ENGINEER TO REVIEW THE EXTENT OF DEMOLITION AREA

OPTION 2- JACKHAMMER EXISTING SLAB & TOPPING TO CREATE NEW 50mm SETDOWN FOR NEW TOPPING. MAKE TRENCH TO EXISTING SLAB ONLY FOR NEW PIPEWORKS CONNECTION & INSTALLATION.

REMOVE ALL EXISTING PLUMBING FITTING & FIXTURES, SANITARY ITEMS & GRAB RAILS. DEMOLISH ALL EXISTING FLOOR AND WALL TILES & PARTITION. DISCONNECT & SEAL OFF ALL EXISTING PIPEWORKS. DISCONNECT & REMOVE ALL EXISTING ELECTRICAL SERVICES.
- DISCONNECT & RELOCATE EXISTING HYDRAULIC STACK TO NEW LOCATION. DEMOLISHED EXISTING DOOR & WALL
- DEMOLISH EXISTING DOOR & DOOR FRAME. FILL-IN THE OPENING WITH NEW WALL AND MAKE GOOD- REFER DETAILS TO PARTITION PLAN
- OPTION 1- DEMOLISH EXISTING SLAB-
I) TO FORM NEW SLAB WITH 50mm SETDOWN FOR NEW TOPPING
II) FOR NEW PIPEWORKS CONNECTION & INSTALLATION.

OPTION 2- JACKHAMMER EXISTING SLAB TO FORM NEW 50mm SETDOWN FOR NEW TOPPING. MAKE TRENCH TO EXISTING SLAB ONLY FOR NEW PIPEWORKS CONNECTION & INSTALLATION.

DEMOLISH ALL EXISTING FLOOR FINISH & SKIRTING. REMOVE ALL EXISTING JOINERY. DISCONNECT & REMOVE ALL EXISTING ELECTRICAL SERVICES.

- DEMOLISH EXISTING BLOCKWORKS FOR NEW DOOR
- DEMOLISH EXISTING GRAVEL GARDEN FOR NEW HYDRAULIC SERVICES CONNECTION. BACK-FILL TOP SOIL & PROVIDE NEW GRAVEL GARDEN TO MATCH EXISTING AFTER DEMOLITION & SERVICES INSTALLATION
- RETAIN EXISTING MECHANICAL DUCTING/ PIPEWORKS. REFER DETAILS TO MECHANICAL ENG. DRAWINGS
- DEMOLISH EXISTING CORRIDOR SLAB TO CREATE NEW CONCRETE SLAB AND FOR NEW PIPEWORKS INSTALLATION & CONNECTION. NEW SLAB LEVEL & FINISH TO MATCH EXISTING CORRIDOR SLAB.
- DEMOLISH/ JACKHAMMER EXISTING SLAB & SETDOWN TO CREATE NEW CONCRETE SLAB AND FOR NEW PIPEWORKS INSTALLATION & CONNECTION. CHECK HYDRAULIC DRAWINGS FOR DETAILS
- DEMOLISH EXISTING PLATFORM, CASEWORKS/ JOINERY, WALL MOUNTED ACOUSTIC PANELS, FLOOR FINISH, RAMP & RAILING, WALL PARTITION, WINDOW AND DOOR. DISCONNECT & REMOVE ALL ELECTRICAL SERVICES. RETURN ALL EXISTING ELECTRICAL ITEMS/ EQUIPMENTS TO CQU
- DEMOLISH EXISTING BLOCKWORKS, WINDOW & WALL MOUNTED ACOUSTIC PANELS
- DEMOLISH EXISTING PLATFORM & SKIRTING. DISCONNECT & REMOVE ALL EXISTING ELECTRICAL SERVICES.
- DEMOLISH EXISTING PLATFORM, STAIR, RAILING & SKIRTING. DISCONNECT & REMOVE ALL EXISTING ELECTRICAL SERVICES

- DEMOLISH EXISTING PLATFORM, STAGE, INTERNAL PARTITION WALL, CASEWORKS/ JOINERY, WALL MOUNTED ACOUSTIC PANELS, FLOOR FINISH & RAILING. DISCONNECT & REMOVE ALL ELECTRICAL SERVICES. RETURN ALL EXISTING ELECTRICAL ITEMS/ EQUIPMENTS TO SCHOOL
- DEMOLISH EXISTING DISPLAY CABINET & BLOCKWORKS (STRUCTURAL ENGINEER TO REVIEW & ASSESS THE DEMOLITION AREA OF EXISTING WALL)
- RE-USE AND RE-HINGE EXISTING FHR DOOR
- REMOVE & RELOCATE EXISTING WALL MOUNTED CONDENSER UNIT & PIPEWORKS. NEW LOCATION TBC
- DEMOLISH EXISTING GARDEN & TREES
- DEMOLISH EXISTING FLOOR MOUNTED CONDENSER UNIT, PIPEWORKS AND EXISTING CONCRETE PAD.
- DEMOLISH EXISTING GRAVEL GARDEN & REMOVE BOULDER WALL ROCKS (C.O.S.) FOR NEW FLOOR & WALL CONSTRUCTION
- DEMOLISH EXISTING EXTERNAL WALL/ CAVITY BLOCKWORKS & EXTERNAL WINDOWS. STRUCTURAL ENGINEER TO ASSESS & REVIEW THE DEMOLITION AREA OF EXISTING WALL
- DEMOLISH EXISTING FLOOR FINISH, SKIRTING BOARD, PARTITION WALL & DOOR. DISCONNECT & REMOVE ALL EXISTING ELECTRICAL SERVICES.
- DEMOLISH EXISTING FLOOR FINISH, SKIRTING, CONDUIT BOX, JOINERY PARTITION WALL & DOOR. DISCONNECT & REMOVE ALL EXISTING ELECTRICAL SERVICES.
- DEMOLISH EXISTING PLATFORM, FLOOR FINISH, SKIRTING, JOINERY, PARTITION AND DOOR. DISCONNECT & REMOVE ALL EXISTING ELECTRICAL SERVICES

AS CONSTRUCTED

C:\REVIT\LOCAL\FILES\23\0078.17_CQU Building 33 Redevelopment_2023_Philip Bugden.nt
20/07/2024 4:52:11 PM

BUILDING 33
REDEVELOPMENT

554/700 YAAMBA ROAD,
NORMAN GARDENS QLD 4701

for
CQUniversity
NORTH ROCKHAMPTON CAMPUS
& GIRVAN



GIRVAN

B	25/06/2024	AS CONSTRUCTED	PB
A	02/02/2024	IFC	PB
4	20/09/2023	ISSUE FOR INFORMATION	WL
3	11/09/2023	AMENDED 60% DD ISSUE	PB
2	28/08/2023	60% DD ISSUE	WL
1	04/08/2023	PRELIMINARY ISSUE	WL

rev	date	details	init
-----	------	---------	------

drawn	date
WL	JUL 2023
checked	date
NC	JUL 2023
verified	date
GK	DEC 2023


scale

EXISTING CEILING PLAN -
GROUND FLOOR

scale 1 : 100 @ A1 project no. 23.0078.17

sheet no. CQU-ROK-033-GN-ARC-20-10

revision B

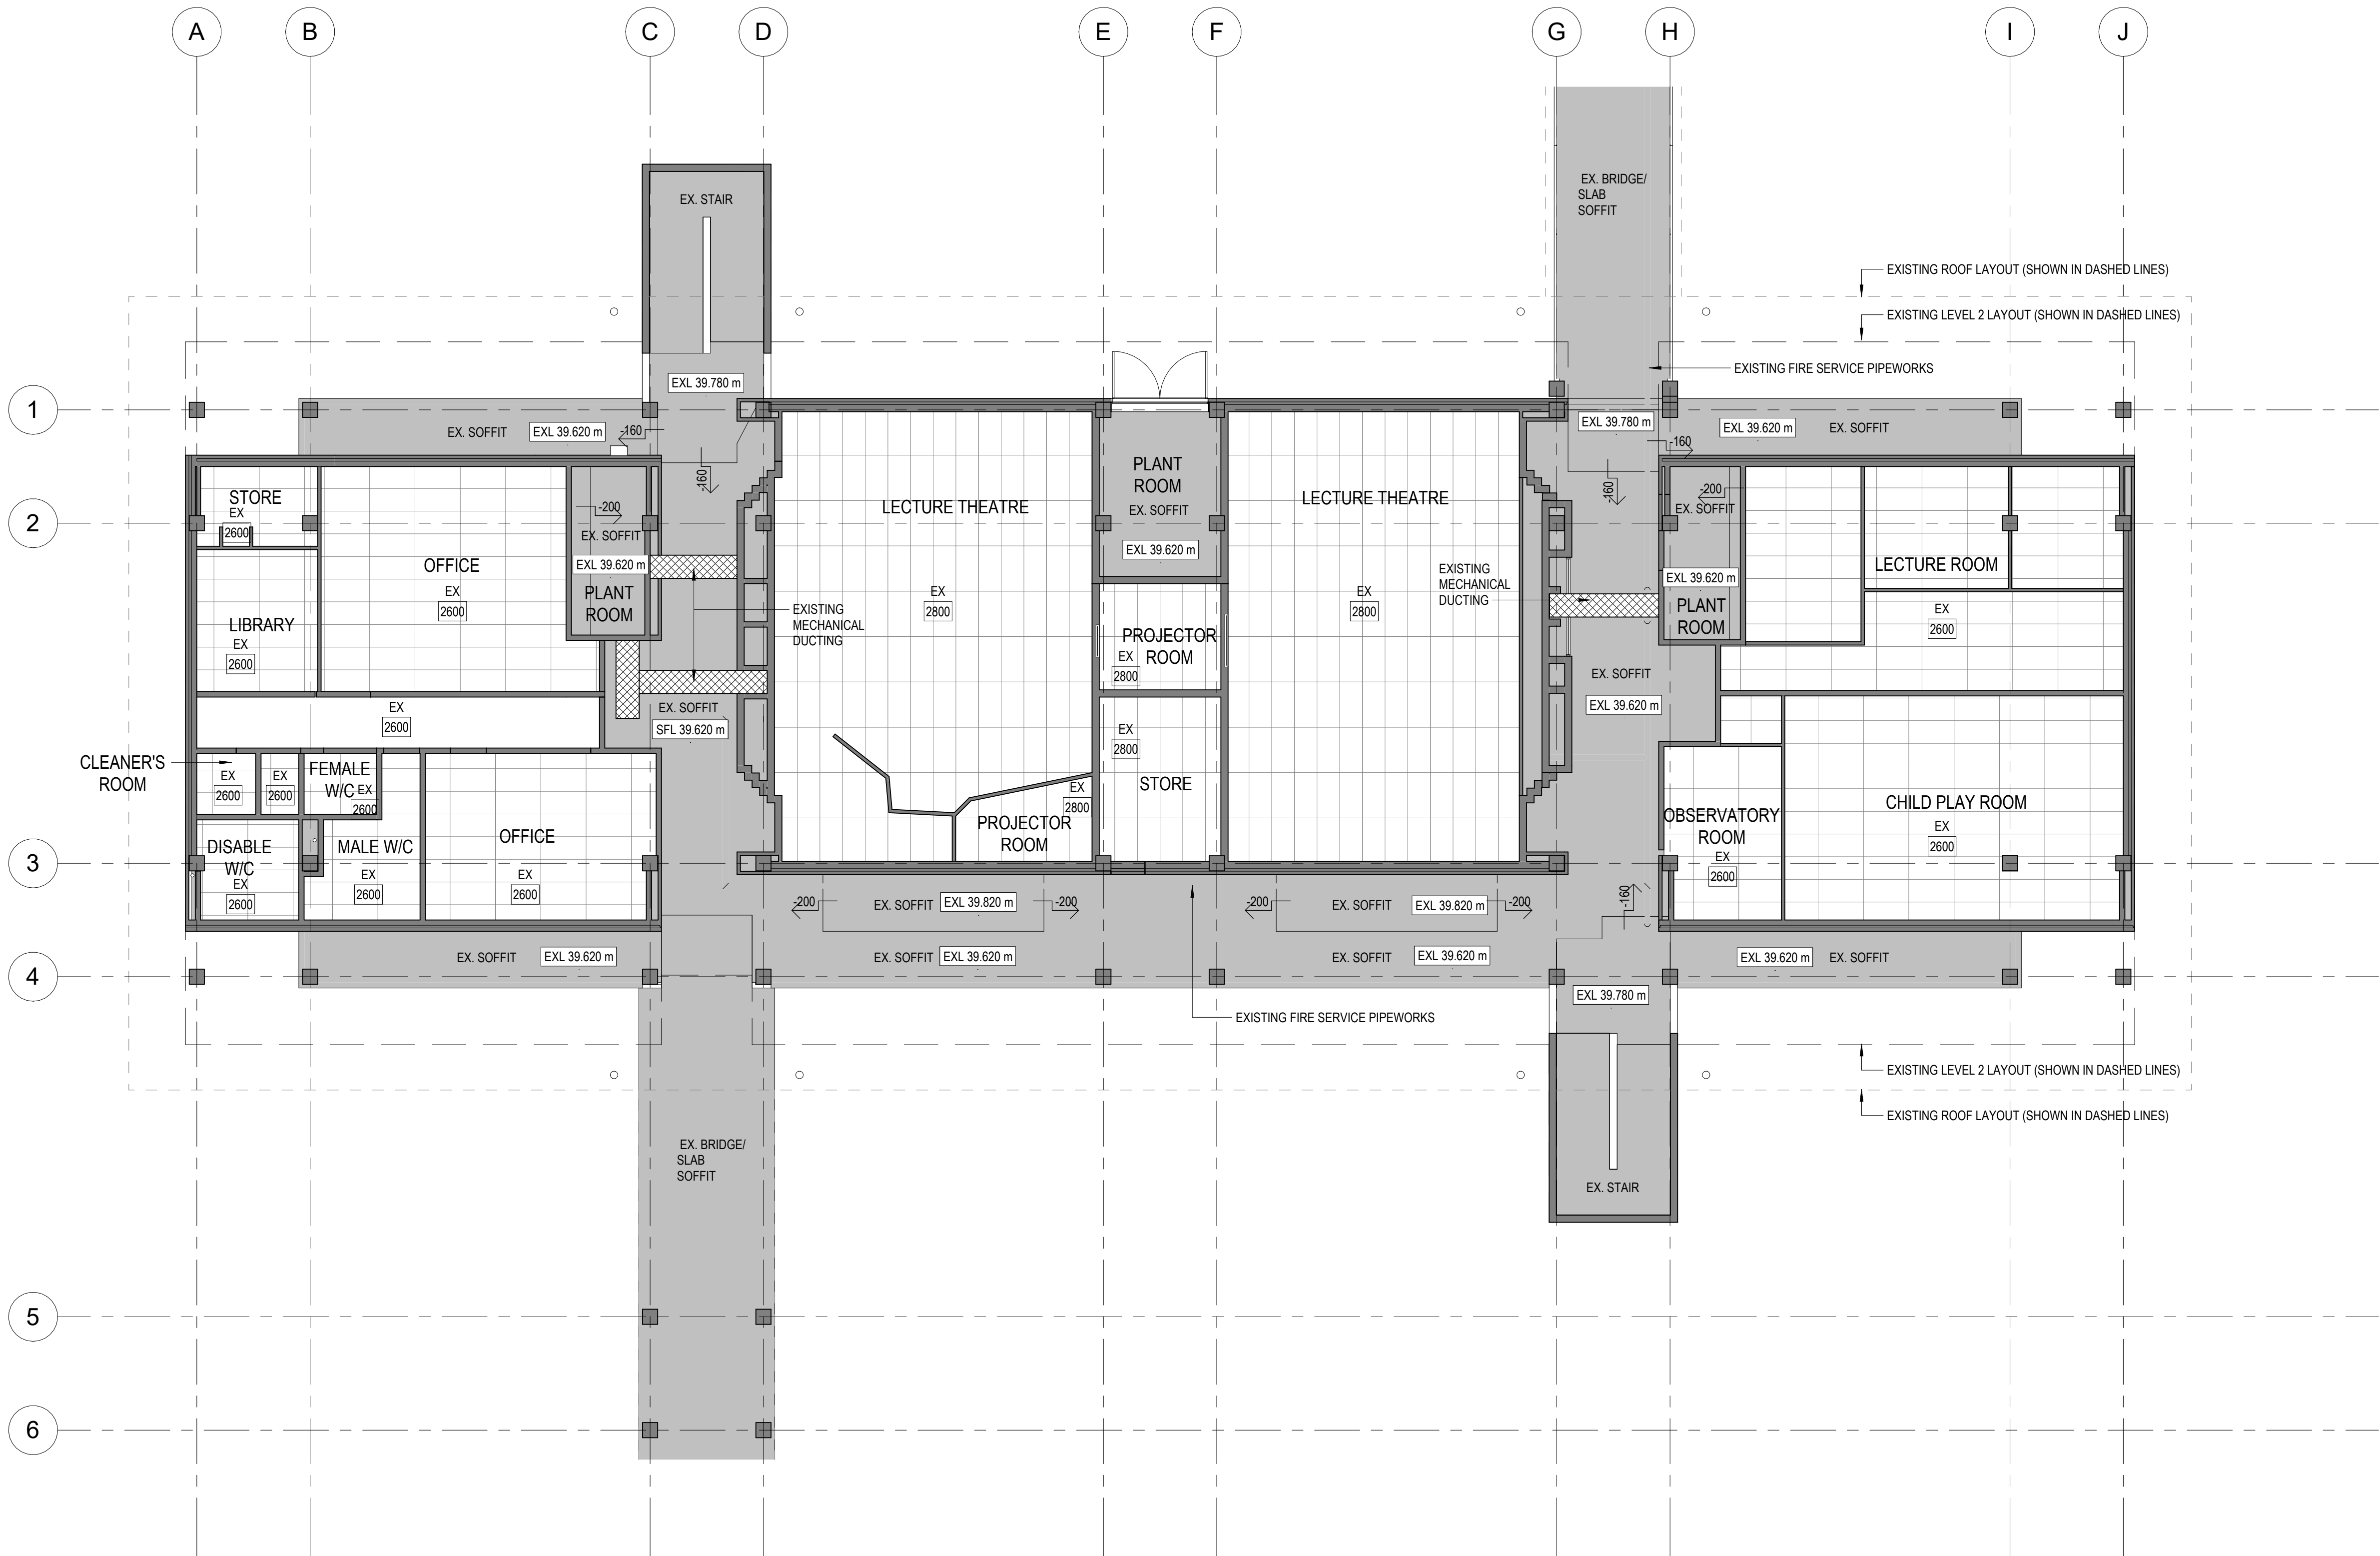

1 EXISTING CEILING PLAN - GROUND FLOOR
1 : 100

HATCH LEGEND:
EXISTING WALL & COLUMN
EXISTING SOFFIT

AS CONSTRUCTED

BUILDING 33 REDEVELOPMENT

554/700 YAAMBA ROAD,
NORMAN GARDENS QLD 4701

for
CQUniversity
NORTH ROCKHAMPTON CAMPUS
& GIRVAN



GIRVAN

B	25/06/2024	AS CONSTRUCTED	PB
A	02/02/2024	IFC	PB
4	20/09/2023	ISSUE FOR INFORMATION	WL
3	11/09/2023	AMENDED 60% DD ISSUE	PB
2	28/08/2023	60% DD ISSUE	WL
1	04/08/2023	PRELIMINARY ISSUE	WL

rev	date	details	init
-----	------	---------	------

drawn	date
WL	JUL 2023
checked	date
NC	JUL 2023
verified	date
GK	DEC 2023

scale

DEMOLITION CEILING PLAN - GROUND FLOOR

scale
1 : 100 @ A1


project no.
23.0078.17

sheet no.
CQU-ROK-033-GN-ARC-20-11

revision
B

original sheet size - A1 (594mm x 841mm)

AS CONSTRUCTED

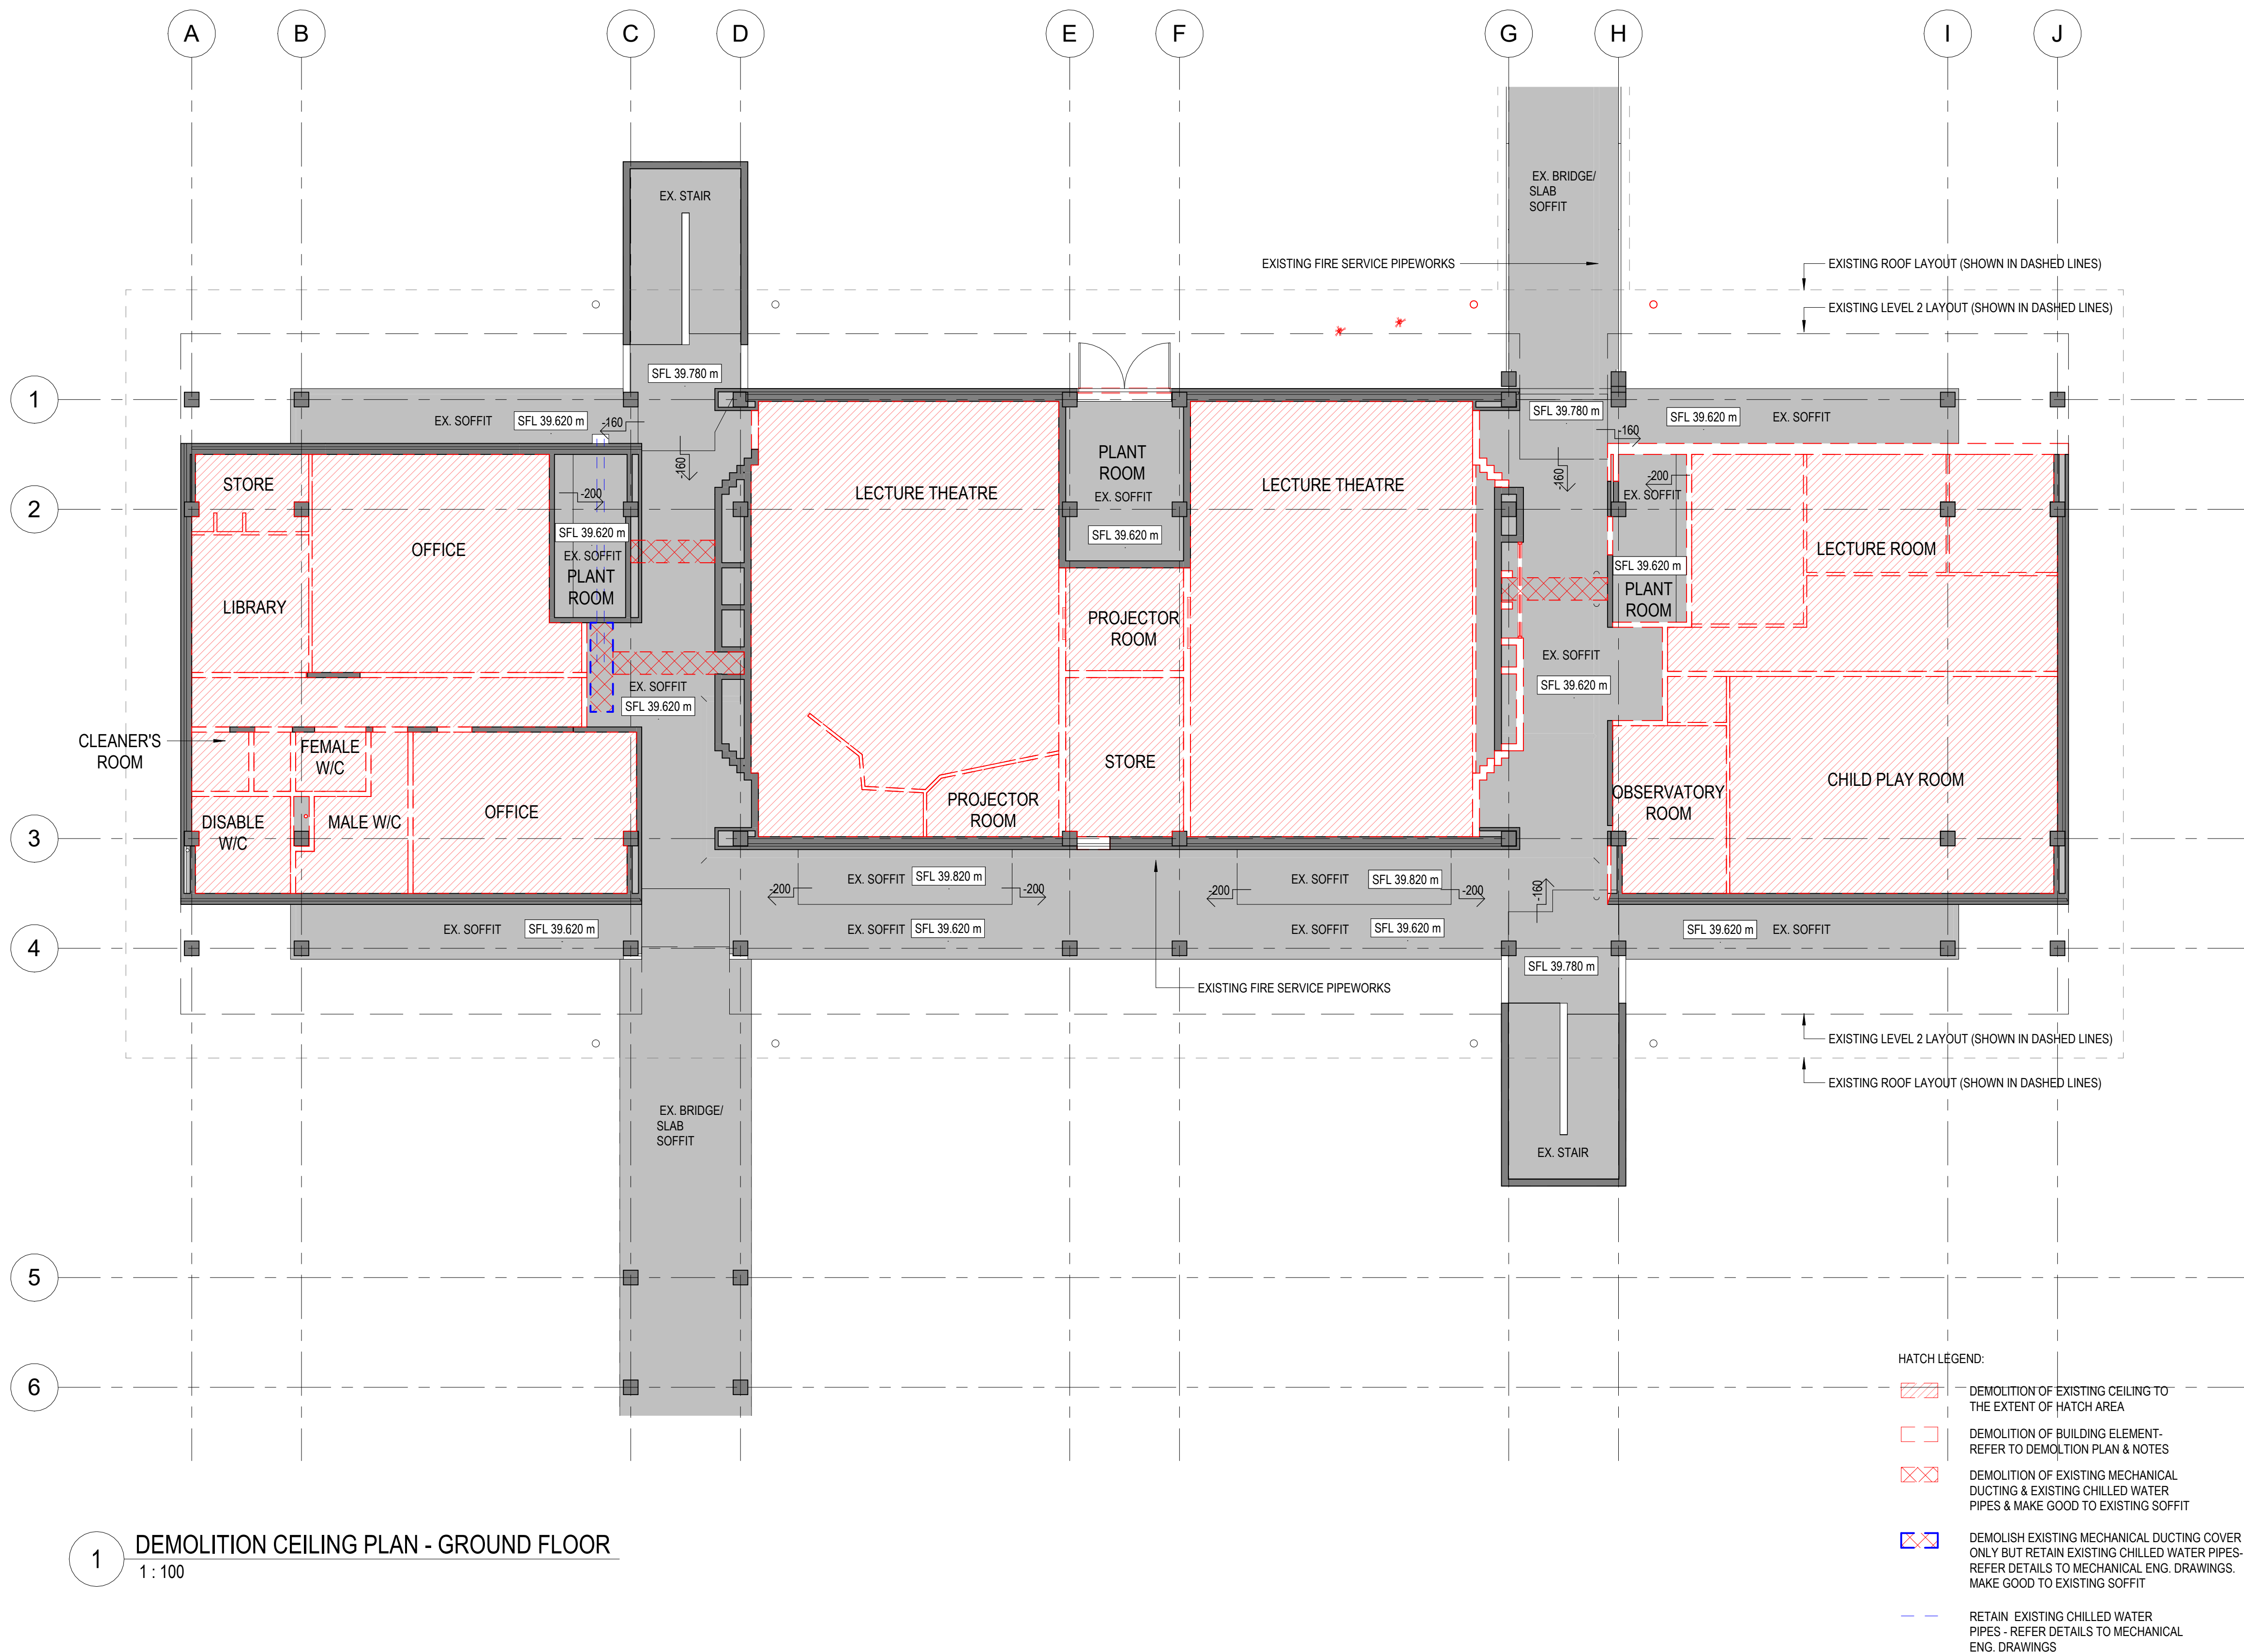

BUILDING 33 REDEVELOPMENT

554/700 YAAMBA ROAD,
NORMAN GARDENS QLD 4701

for
CQUUniversity
NORTH ROCKHAMPTON CAMPUS
& GIRVAN



GIRVAN

B	25/06/2024	AS CONSTRUCTED	PB
A	02/02/2024	IFC	PB
10	25/01/2024	AMENDED FUME CUPBOARD SIZING	PB
9	20/12/2023	REVISED ISSUE	PB
8	19/12/2023	REVISED ISSUE	PB
7	06/11/2023	REVISED ISSUE	AP
6	05/10/2023	REVISED PLANT ROOM	PB
5	28/09/2023	REVISED PLANT ROOM LOCATION	PB
4	20/09/2023	ISSUE FOR INFORMATION	WL
3	11/09/2023	AMENDED 60% DD ISSUE	PB
2	28/08/2023	60% DD ISSUE	WL
1	04/08/2023	PRELIMINARY ISSUE	WL

rev	date	details	init
-----	------	---------	------

drawn	date
TA	JUL 2023
checked	date
NC	JUL 2023
verified	date
GK	DEC 2023

scale

FLOOR PLAN - GROUND FLOOR

scale project no.
1 : 100 @ A1 23.0078.17

sheet no.
CQU-ROK-033-GN-ARC-21-10

revision
B


SYMBOL LEGEND

EX	EXISTING WINDOW
EX	EXISTING DOOR
D01	NEW DOOR TYPE (REFER DETAILS TO DOOR SCHEDULE)
G.01	NEW DOOR NUMBER
G.01	ROOM NUMBER


LEGEND

COL-SHS	COLUMN - SQUARE HOLLOW SECTION
DP	DOWNPIPE
LKRS/2	LOCKERS
LSB	LADDER SAFETY BRACKET
MAF	METAL APRON FLASHING
MBF	METAL BARGE FLASHING
MPF	METAL PAN FLASHING
MRS	METAL ROOF SHEETING
SC1	ALUMINIUM BATTEN SCREEN TYPE 1

NOTE:
- BUILDER TO ENSURE ALL EXISTING EXTERNAL
WINDOWS ON GROUND FLOOR ARE NOT
OPERABLE

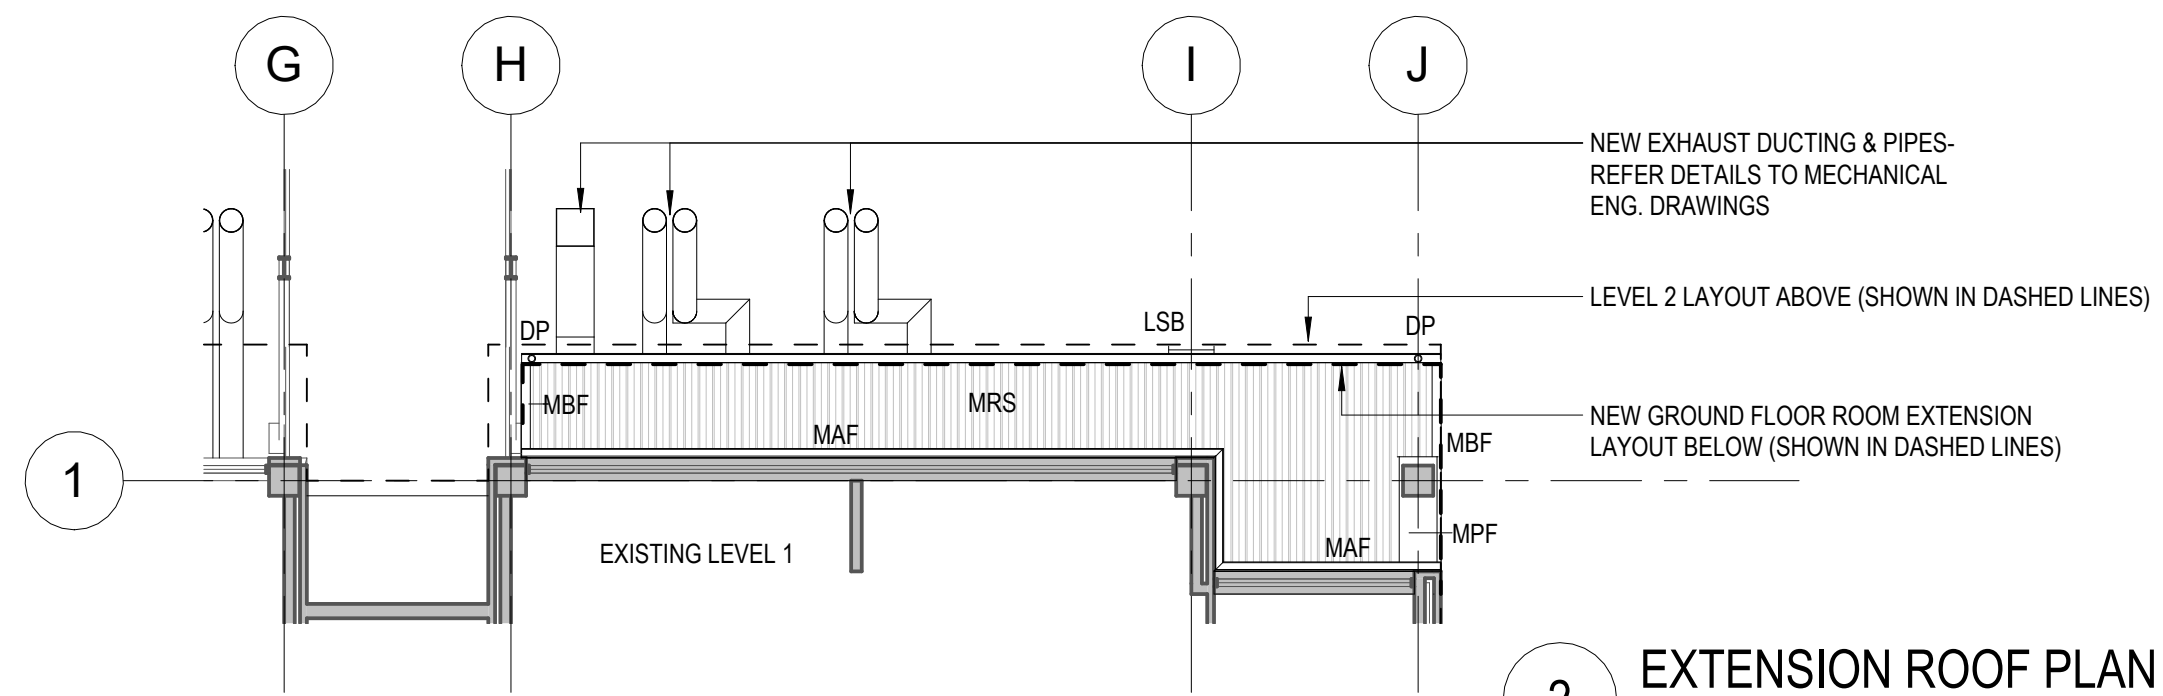


2 EXTENSION ROOF PLAN
1 : 100

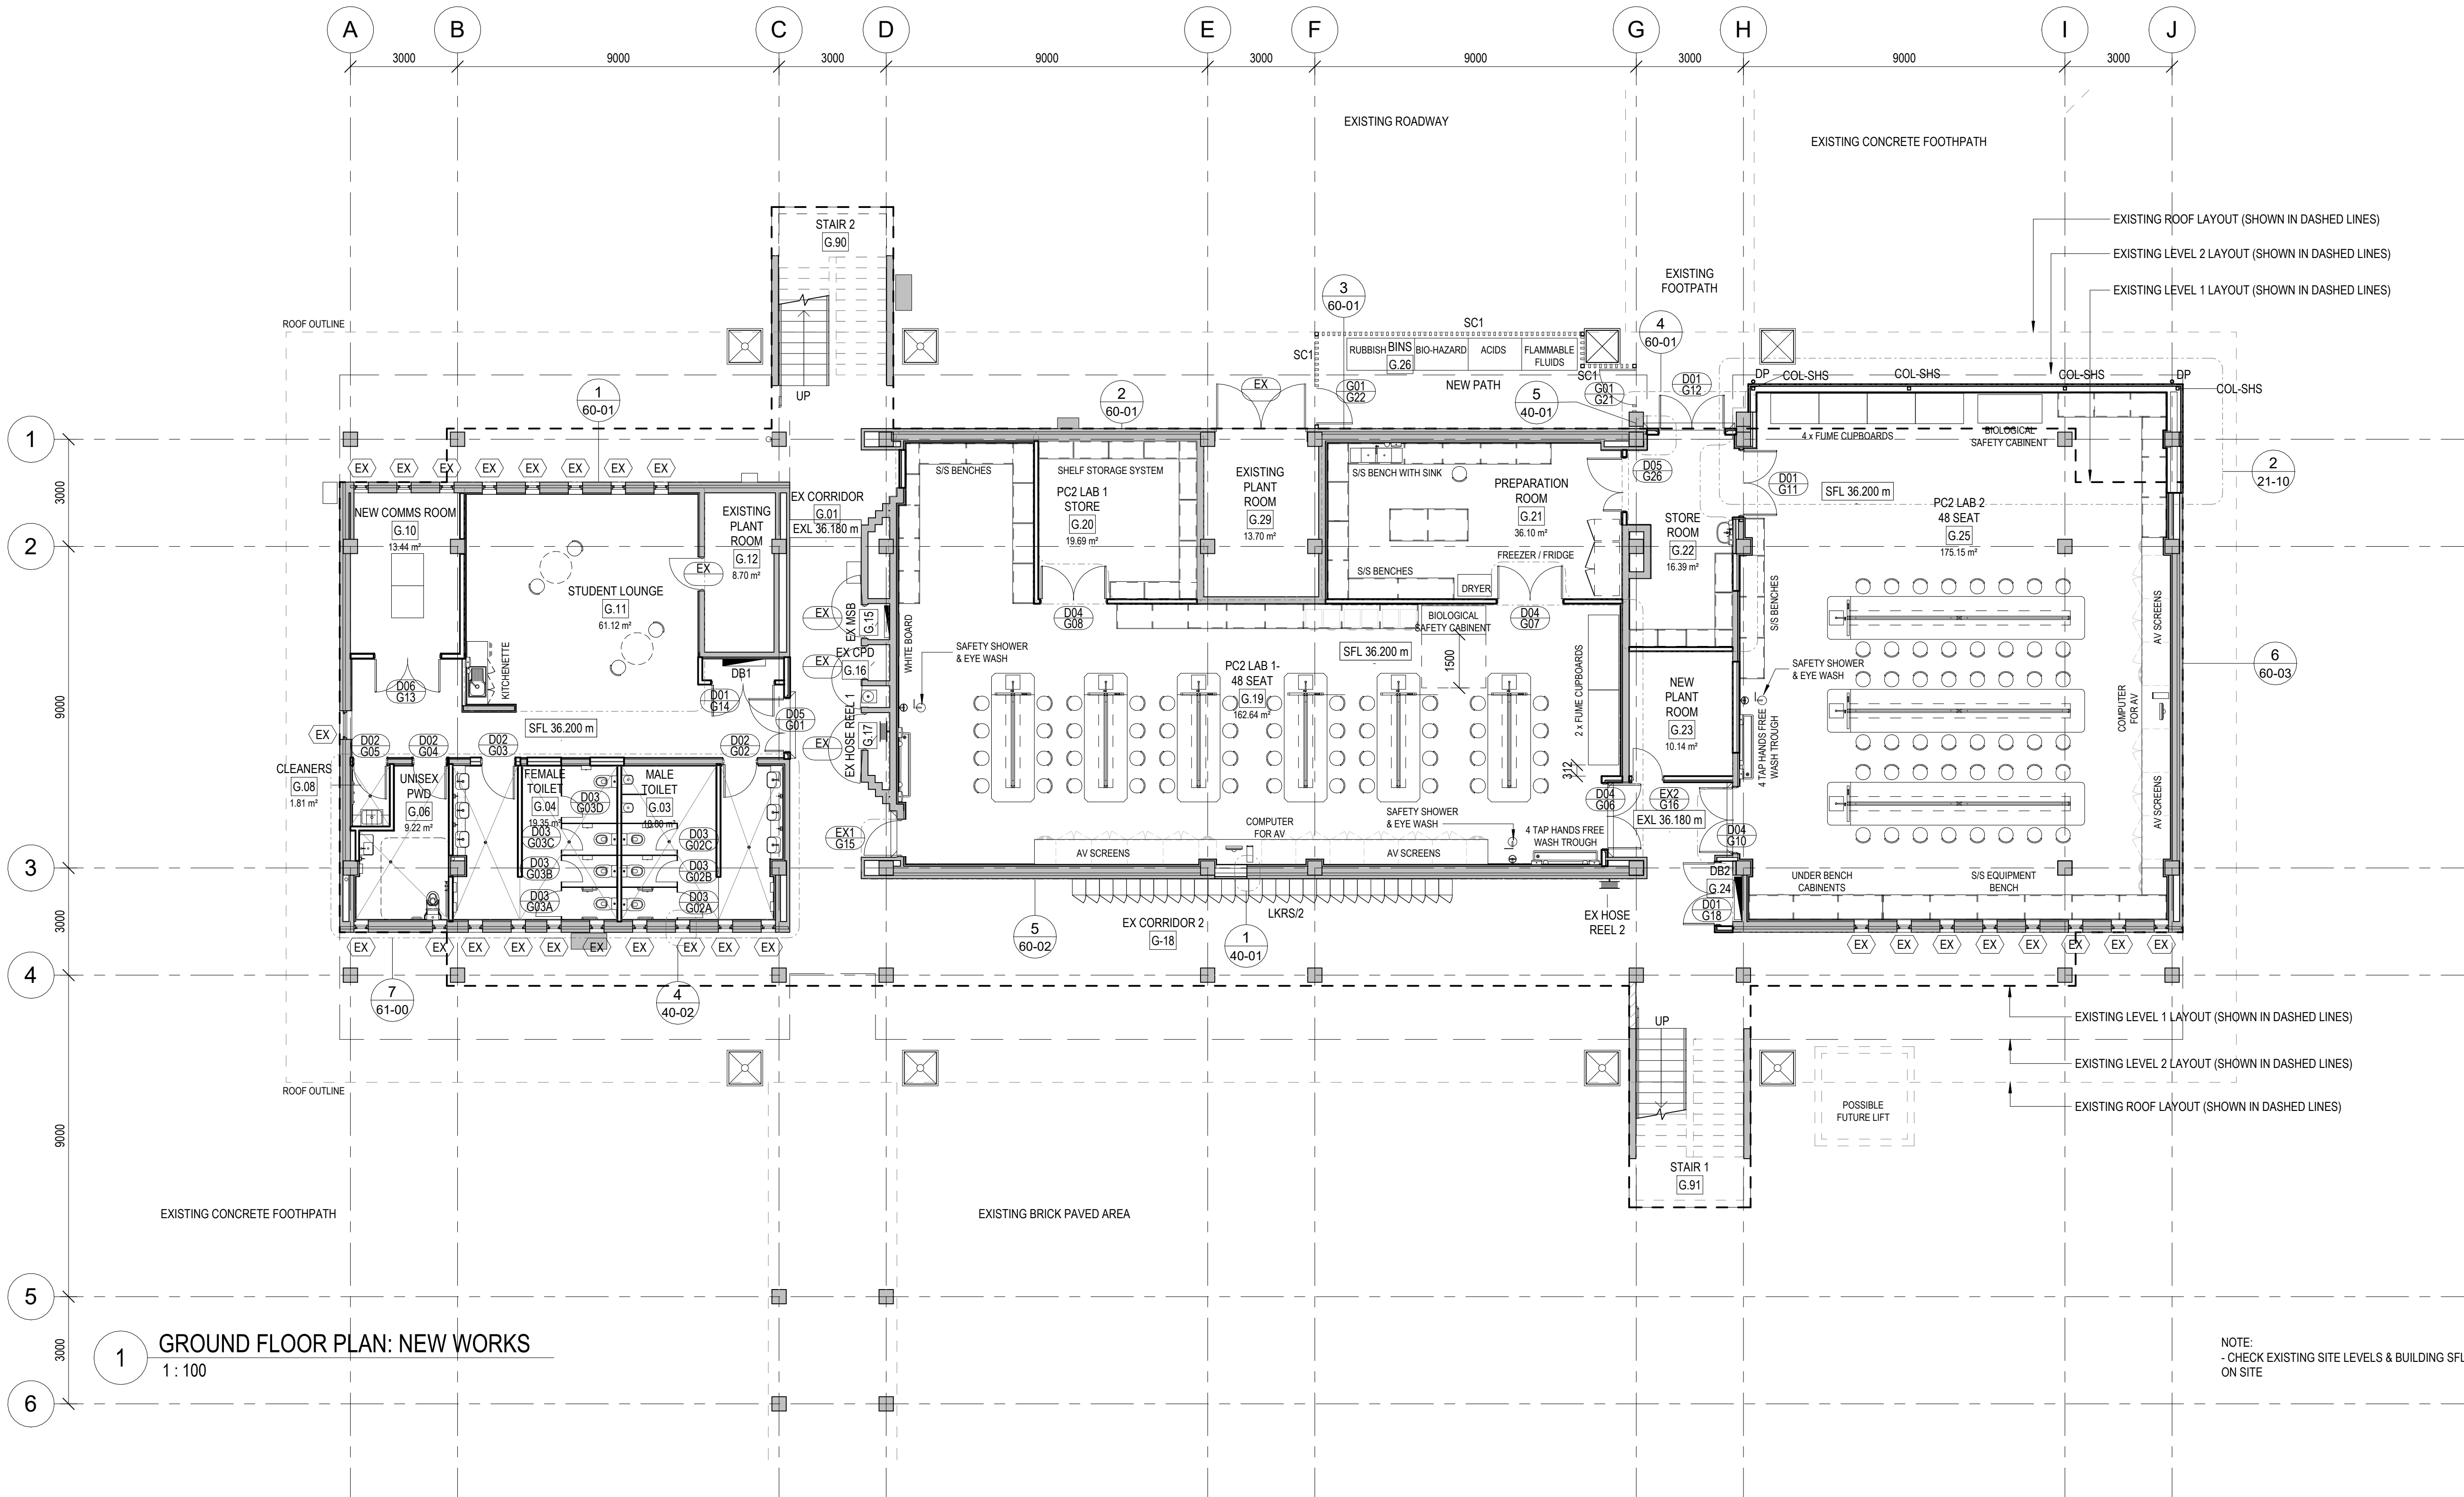

1 GROUND FLOOR PLAN: NEW WORKS
1 : 100

NOTE:
- CHECK EXISTING SITE LEVELS & BUILDING SFL
ON SITE

AS CONSTRUCTED

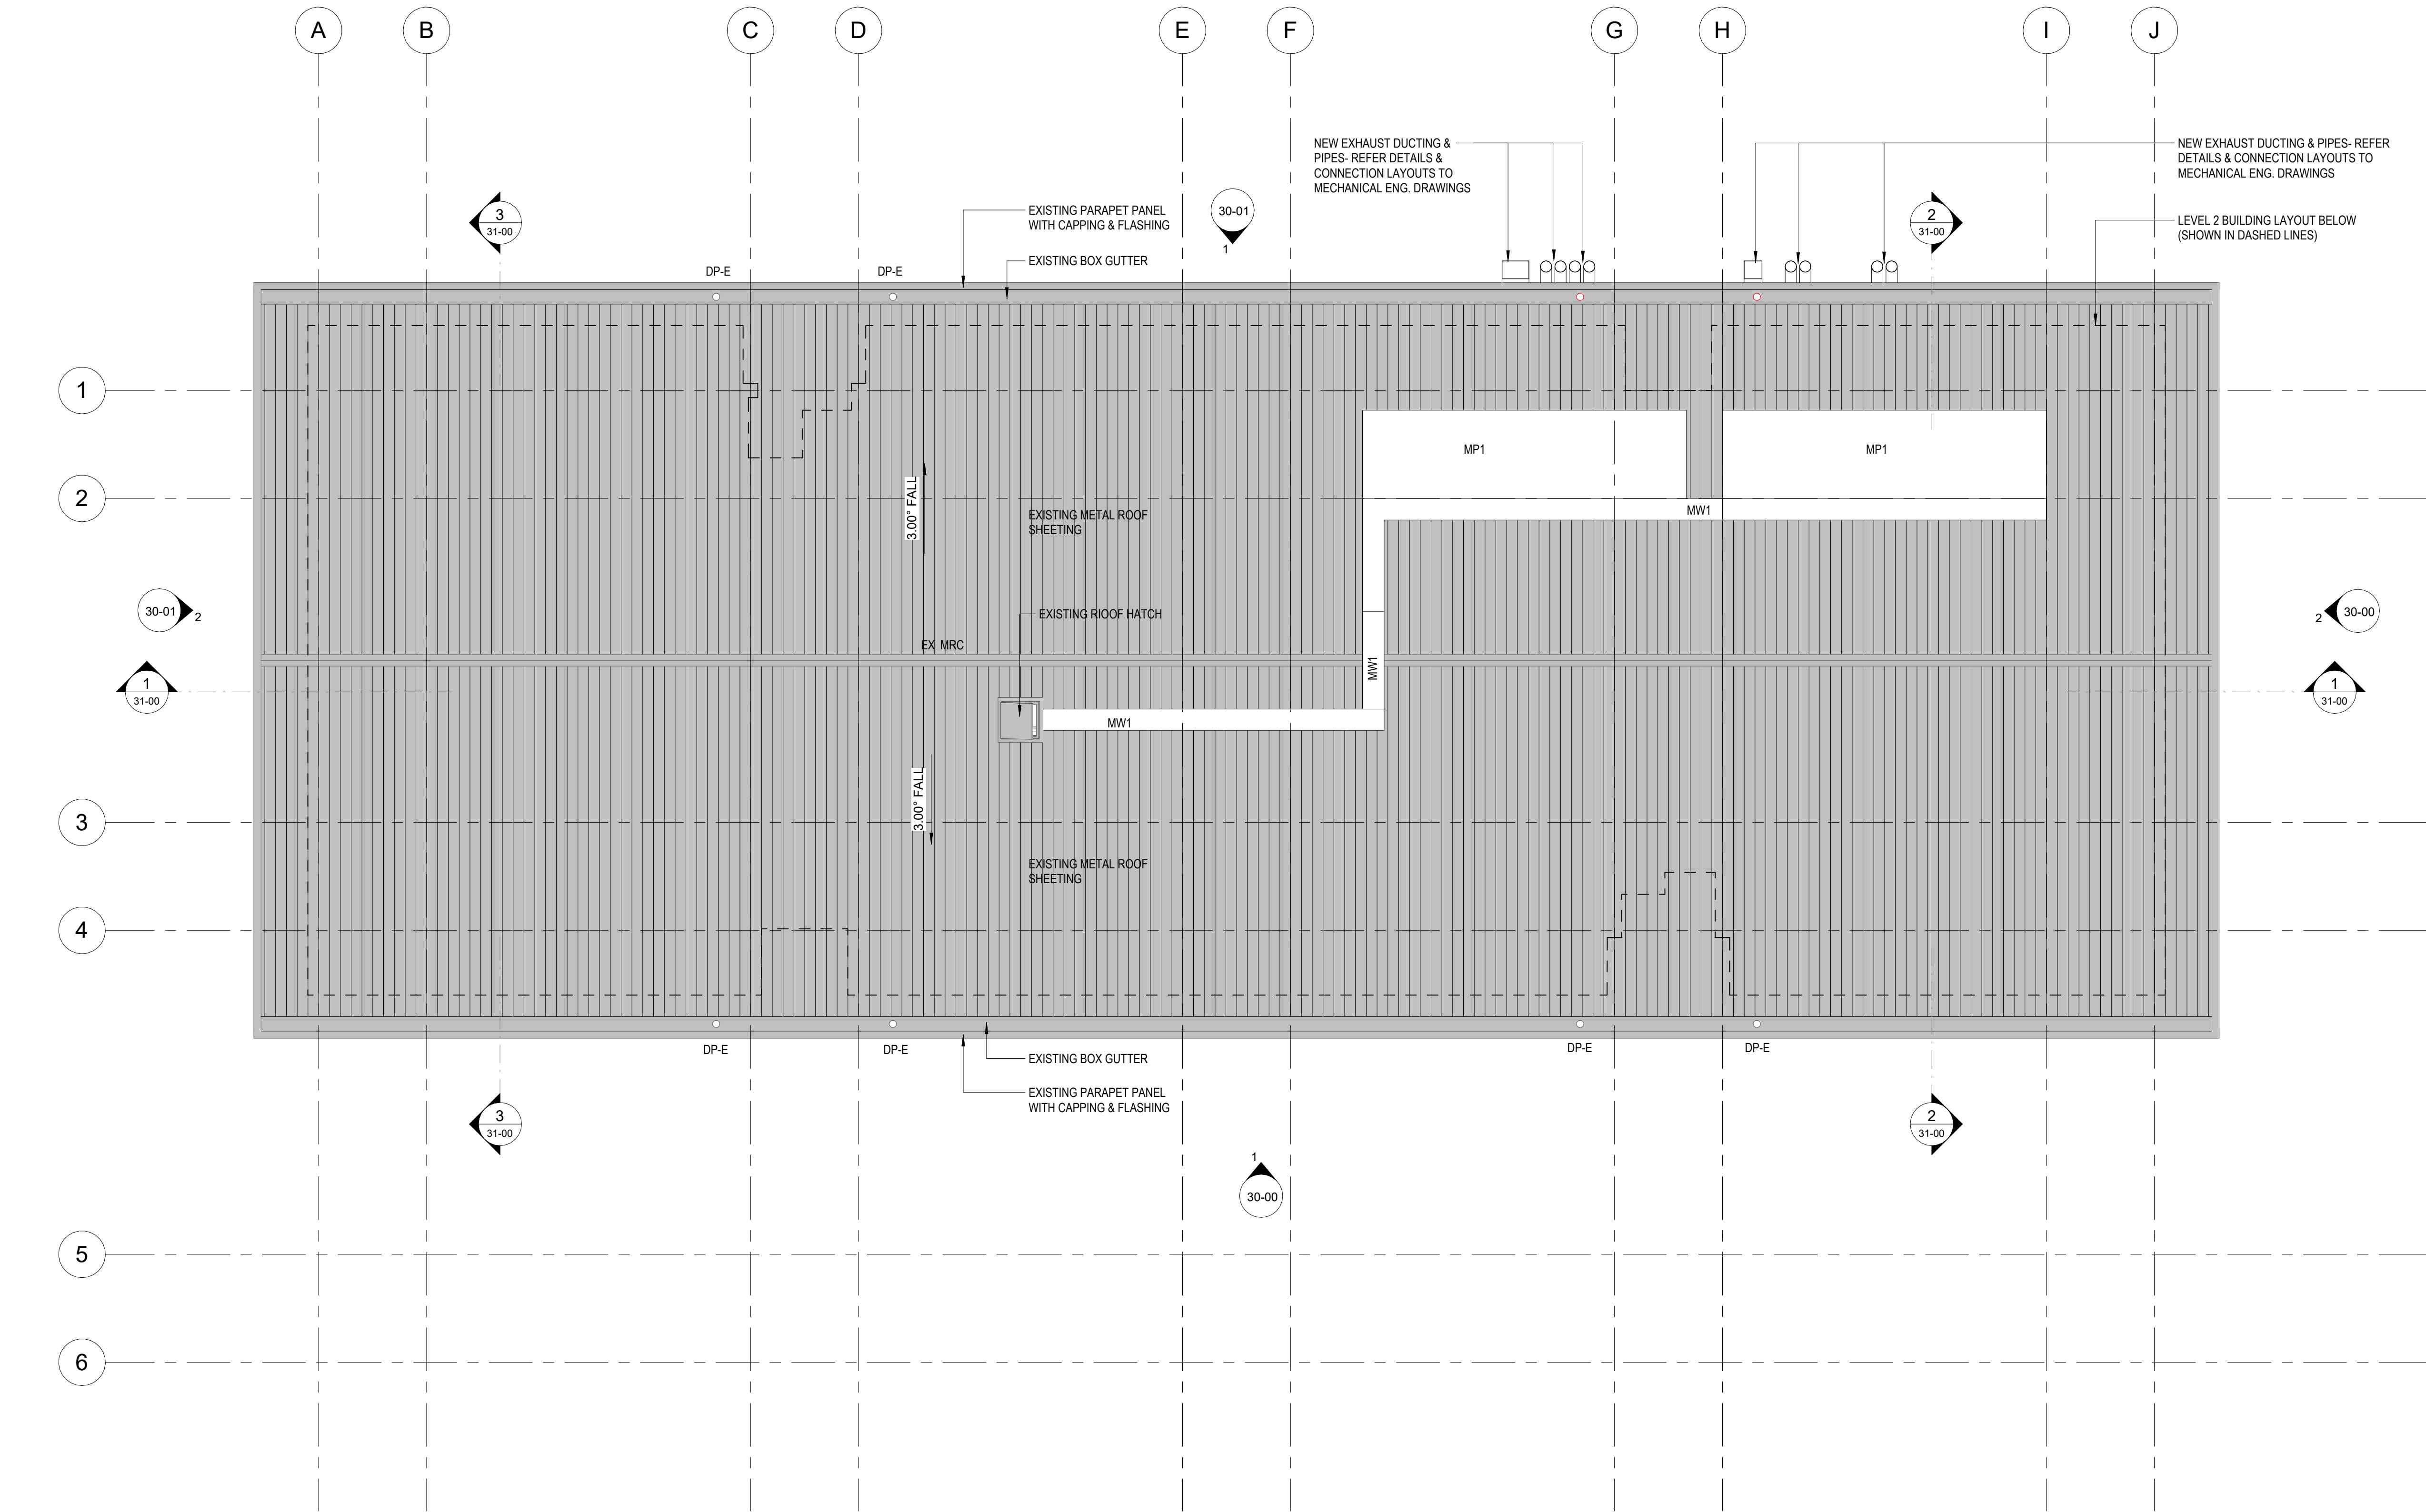

1 ROOF PLAN
A300 1 : 100

LEGEND	
DP-E	DOWNPIPE - EXISTING
EX	EXISTING
MP1	MECHANICAL PLATFORM BY BUILDER
MRC	METAL RIDGE CAPPING
MW1	MECHANICAL WALKWAY BY BUILDER

AS CONSTRUCTED

thomson
adsett

Telephone +61 7 3840 9999
bne@thomsonadsett.com
Level 9, 470 St Pauls Terrace
Fortitude Valley
Qld 4006 Australia
thomsonadsett.com

© Copyright
These drawings and designs and the copyright thereof are the property of Thomson Adsett Pty Ltd and must not be used, retained or copied without written permission of Thomson Adsett Pty Ltd. ABN 76 105 314 654 Trading as ThomsonAdsett. Dimensions take precedence over scaling. Do not measure off drawings as print sizes may vary

BUILDING 33 REDEVELOPMENT

554/700 YAAMBA ROAD,
NORMAN GARDENS QLD 4701

for
CQUniversity
NORTH ROCKHAMPTON CAMPUS
& GIRVAN



GIRVAN

B	25/06/2024	AS CONSTRUCTED	PB
A	02/02/2024	IFC	PB
1	20/09/2023	ISSUE FOR INFORMATION	WL

rev	date	details	init
-----	------	---------	------

drawn	date
TA	JUL 2023
checked	date
NC	JUL 2023
verified	date
GK	DEC 2023

scale

ROOF PLAN- NEW MECHANICAL PLATFORMS & WALKWAY

scale project no.
1 : 100 @ A1 23.0078.17

sheet no.
CQU-ROK-033-GN-ARC-21-11

revision
B

original sheet size - A1 (594mm x 841mm)

C:\REVIT\LOCALFILES\23.0078.17_CQU Building 33 Redevelopment_2023_Philip Bugden.nt

**BUILDING 33
REDEVELOPMENT**

554/700 YAAMBA ROAD,
NORMAN GARDENS QLD 4701

for
CQUniversity
NORTH ROCKHAMPTON CAMPUS
& GIRVAN



GIRVAN

B	25/06/2024	AS CONSTRUCTED	PB
A	02/02/2024	IFC	PB
6	25/01/2024	AMENDED FUME CUPBOARD SIZEING	PB
5	20/12/2023	REVISED ISSUE	PB
4	06/11/2023	REVISED ISSUE	AP
3	20/09/2023	ISSUE FOR INFORMATION	WL
2	11/09/2023	AMENDED 60% DD ISSUE	PB
1	28/08/2023	60% DD ISSUE	WL

rev	date	details	init
-----	------	---------	------

drawn	date
WL	AUG 2023
checked	date
NC	AUG 2023
verified	date
GK	DEC 2023

scale

1

**PERFORMANCE PLAN -
GROUND FLOOR**


scale project no.
1 : 100 @ A1 23.0078.17

sheet no.
CQU-ROK-033-GN-ARC-22-10

revision
B

WALL TONES AND SYMBOL LEGEND

- ACOUSTIC WALL - Rw40 (AS PER CQU- ROOM DATA SHEET REQUIREMENTS)
- FIRE RATED WALL - FRL-/120/120
- R- VALUE - TBC

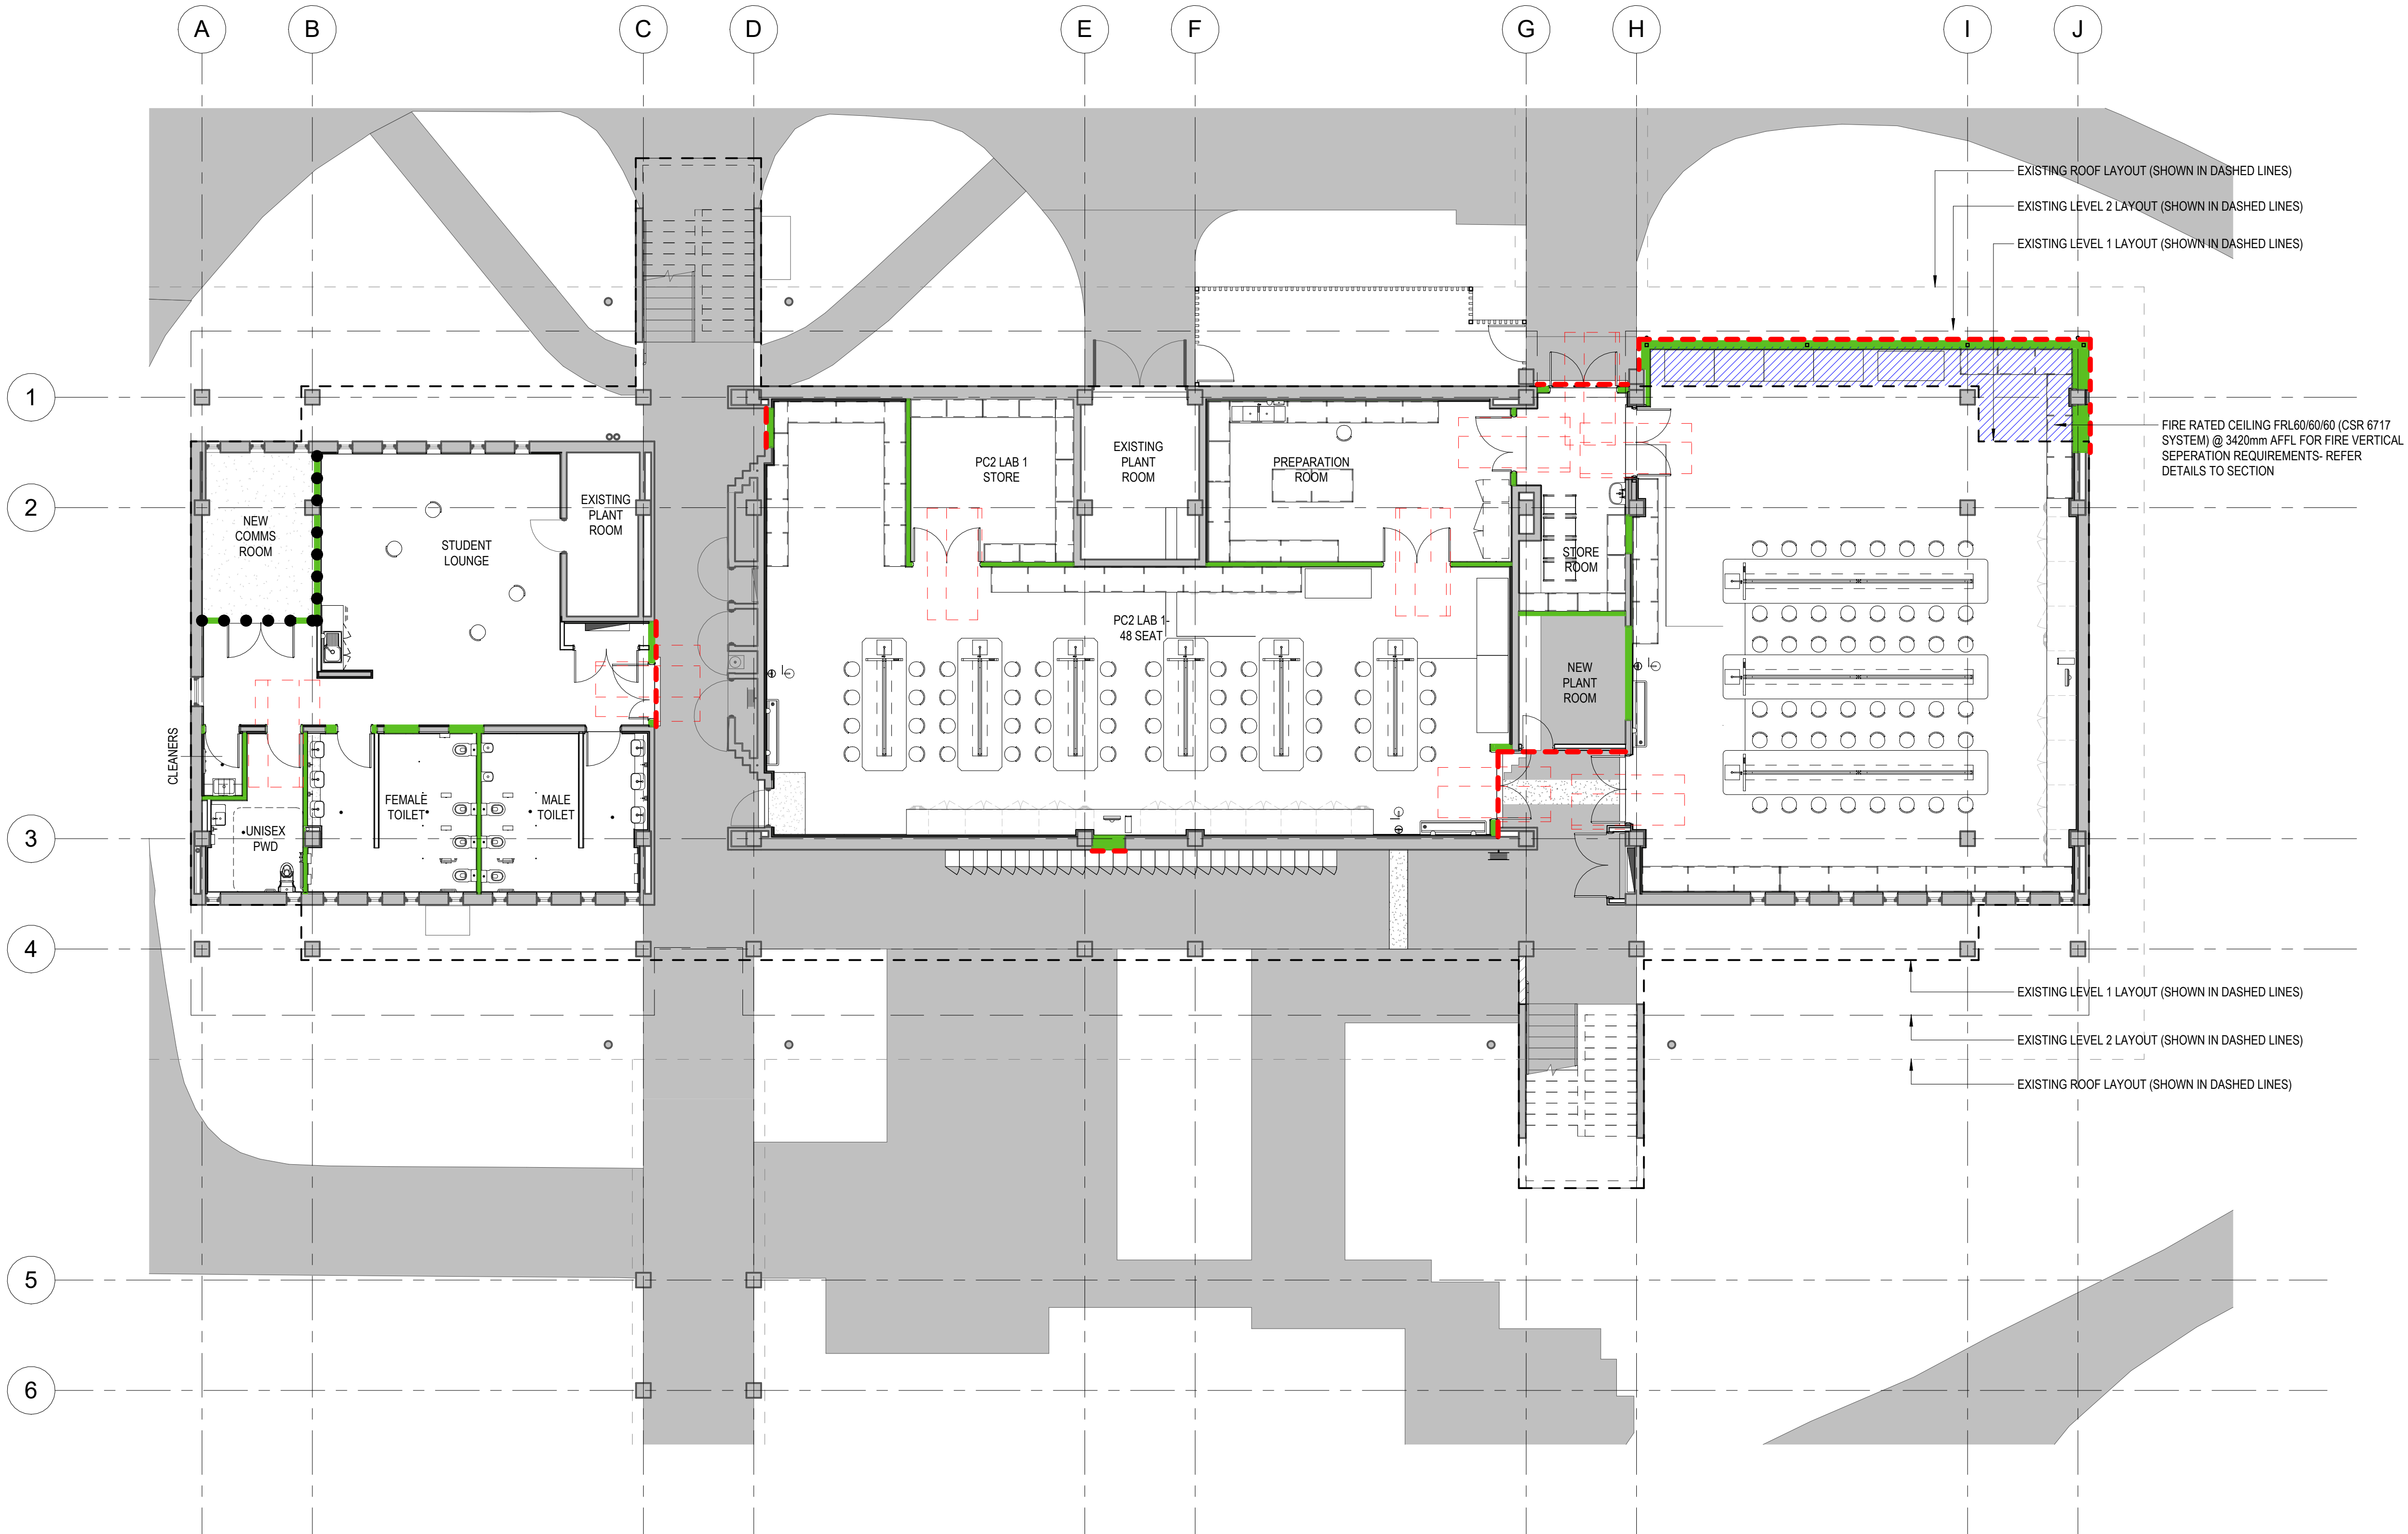

1 PERFORMANCE PLAN - GROUND FLOOR
1 : 100

AS CONSTRUCTED

**BUILDING 33
REDEVELOPMENT**

554/700 YAAMBA ROAD,
NORMAN GARDENS QLD 4701

for
CQUniversity
NORTH ROCKHAMPTON CAMPUS
& GIRVAN



GIRVAN

B	25/06/2024	AS CONSTRUCTED	PB
A	02/02/2024	IFC	PB
3	20/09/2023	ISSUE FOR INFORMATION	WL
2	11/09/2023	AMENDED 60% DD ISSUE	PB
1	28/08/2023	60% DD ISSUE	WL

rev	date	details	init
-----	------	---------	------

drawn	date
WL	AUG 2023
checked	date
NC	AUG 2023
verified	date
GK	DEC 2023


scale

**PERFORMANCE CEILING
PLAN - GROUND FLOOR**

scale project no.
1 : 100 @ A1 23.0078.17


sheet no.
CQU-ROK-033-GN-ARC-22-20

revision
B

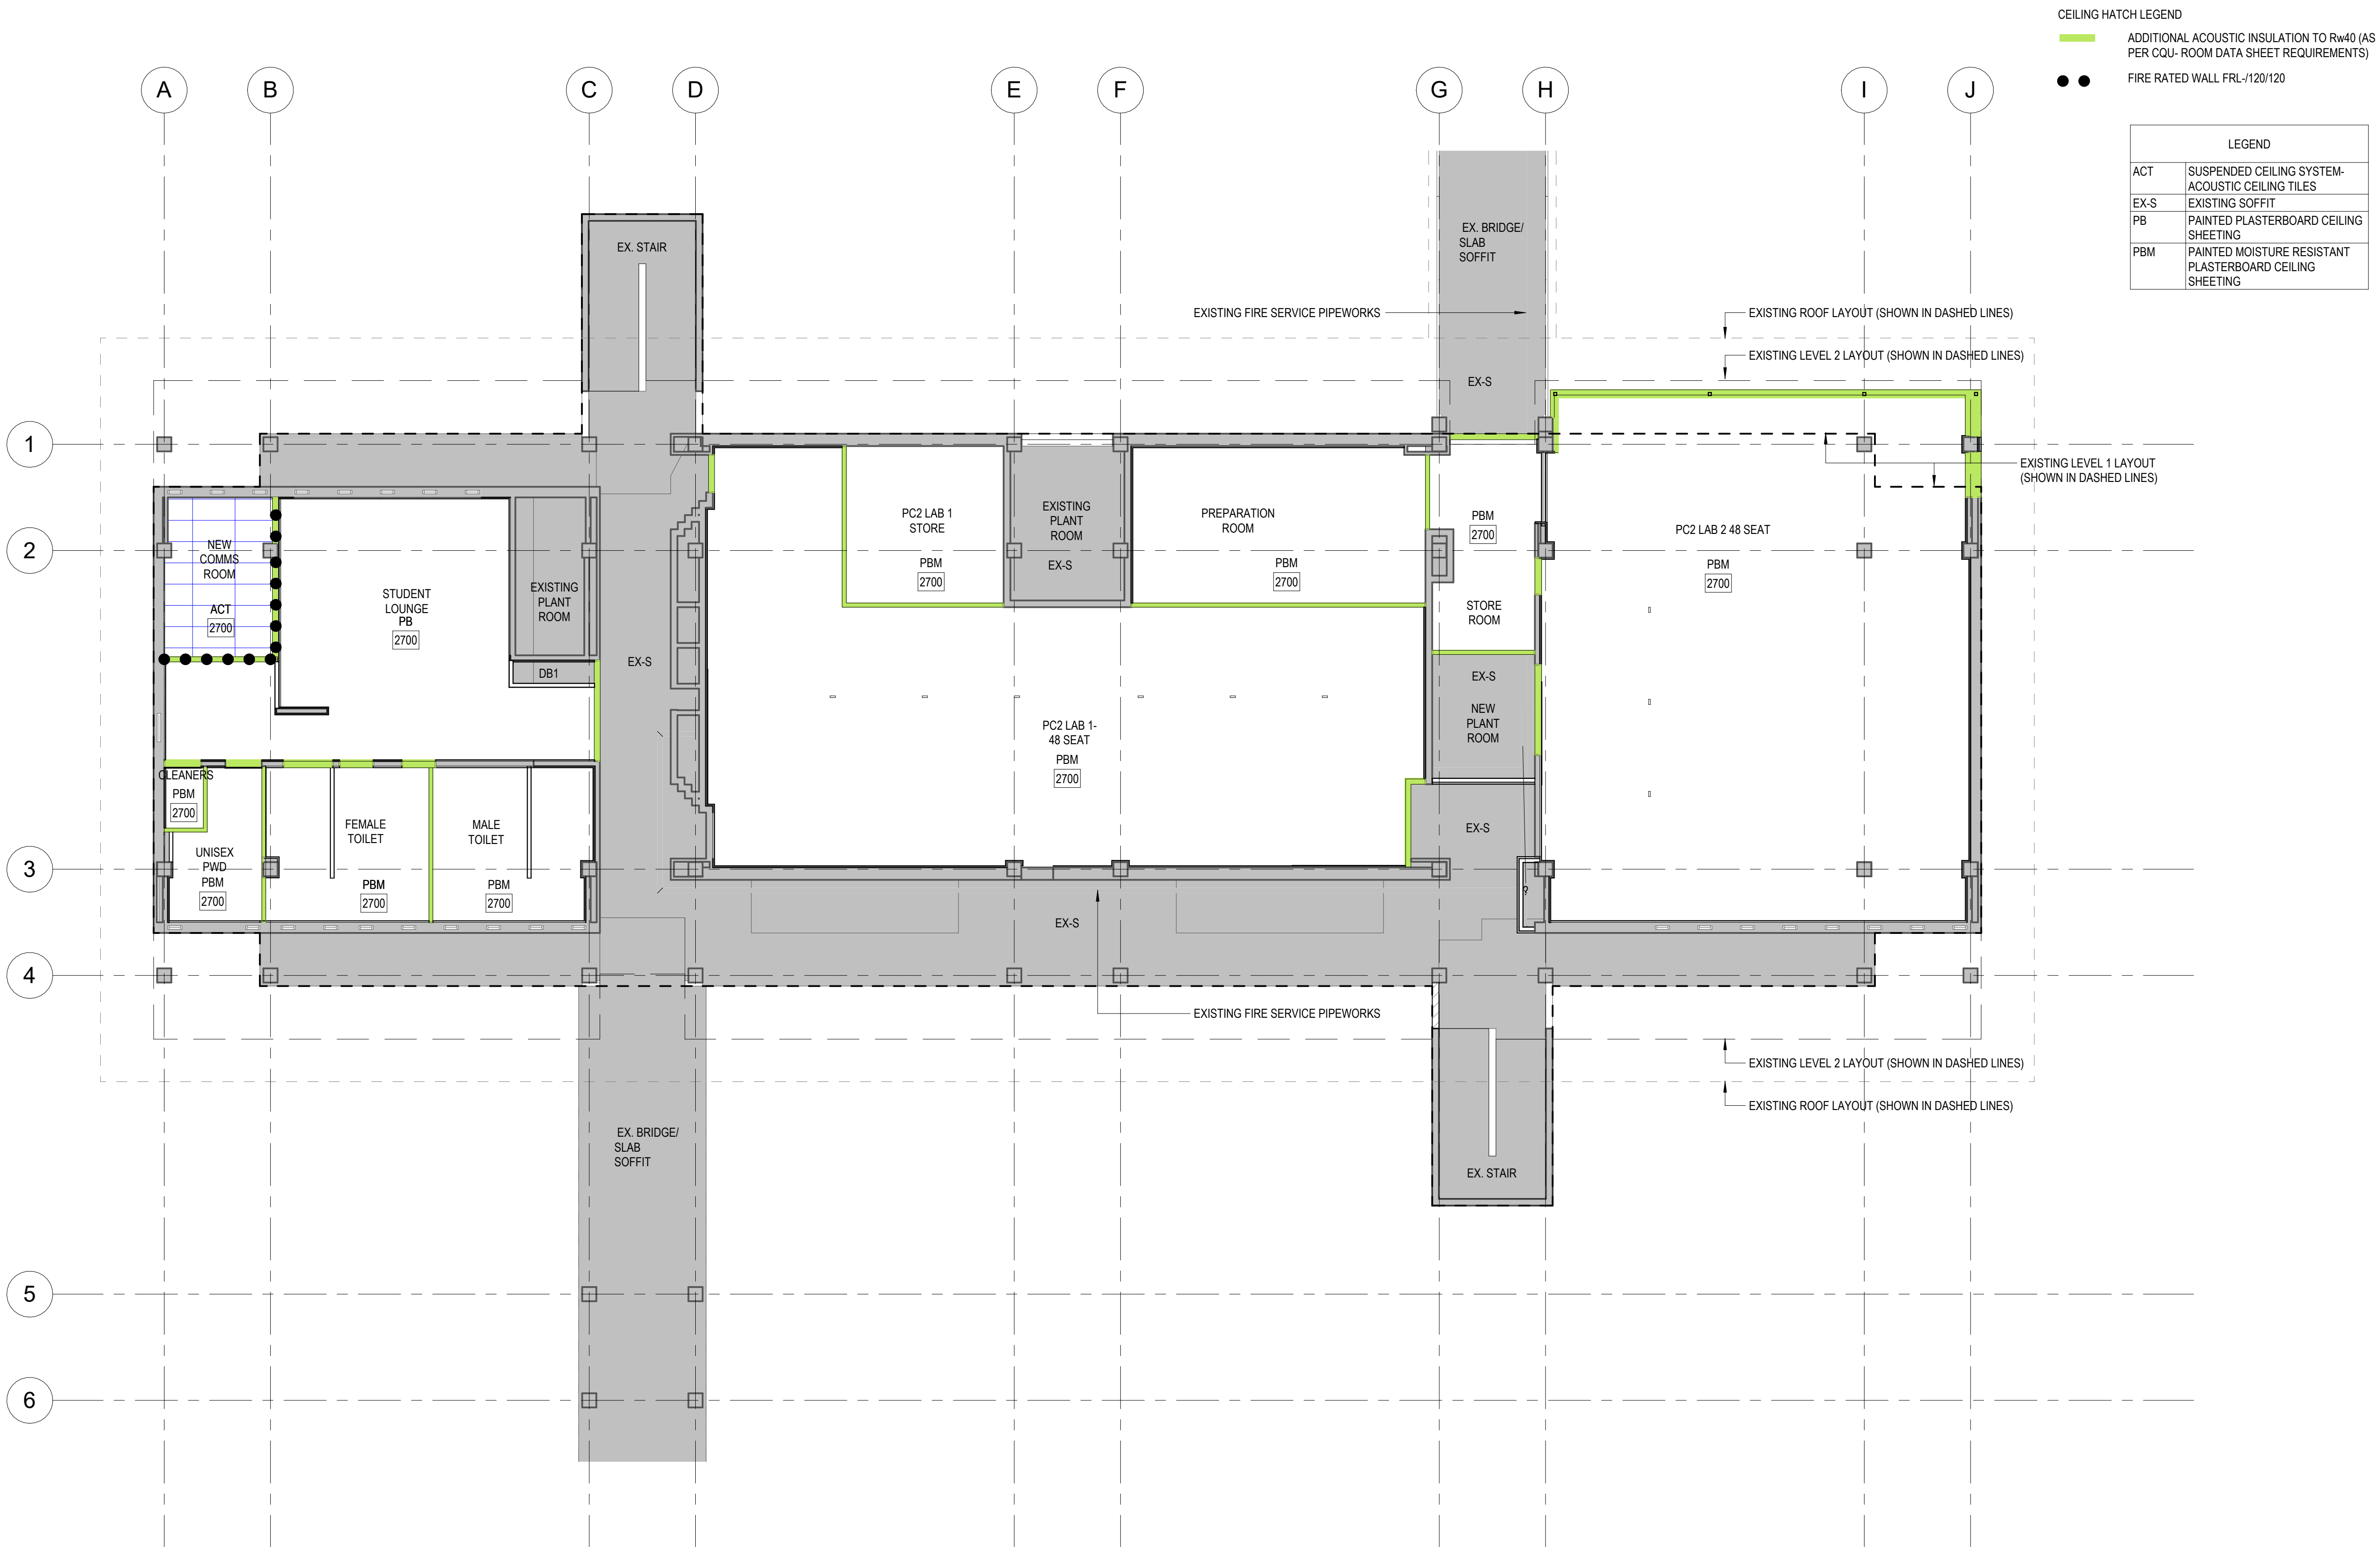

1 PERFORMANCE CEILING PLAN - GROUND FLOOR
1 : 100

AS CONSTRUCTED

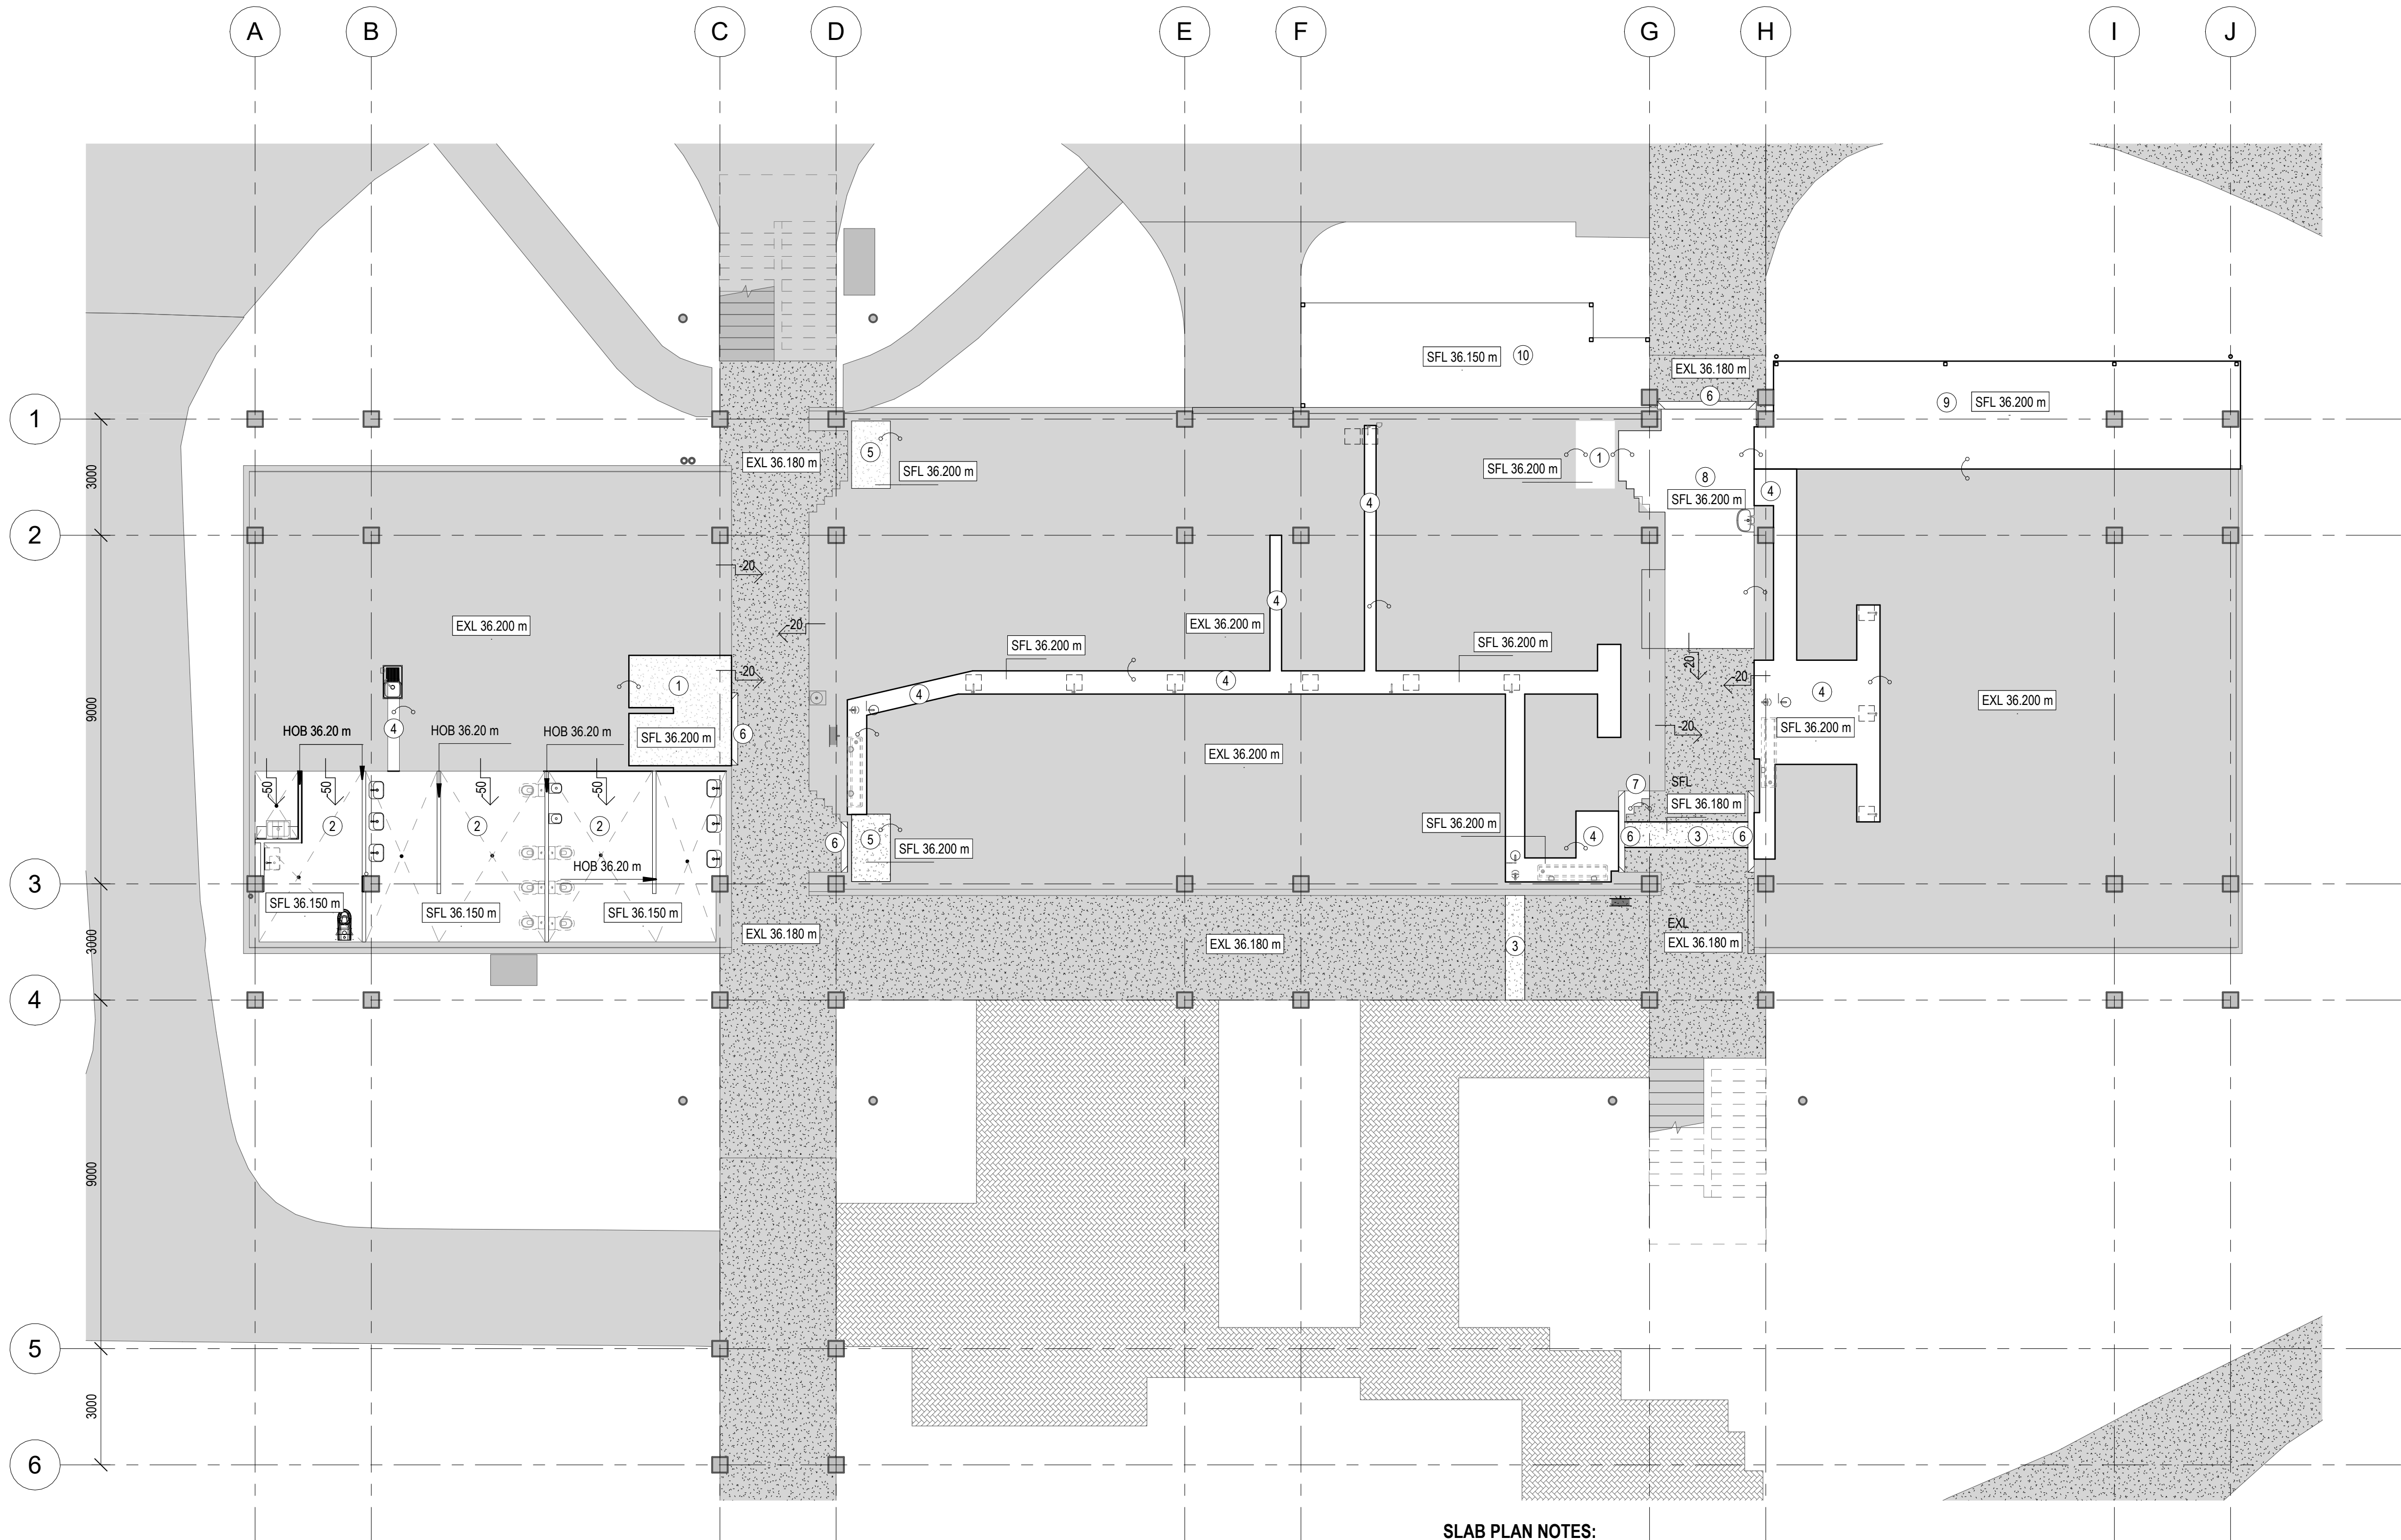

1 SLAB PLAN - GROUND FLOOR
1:100

SLAB PLAN NOTES:

- CHECK ALL EXISTING LEVELS ON SITE

- 1 NEW TOPPING TO EXISTING 30mm MATT. SETDOWN & TO EXISTING CORRIDOR SLAB. NEW FLOOR LEVEL (SFL) TO MATCH EXISTING SLAB LEVEL- COS
- 2 NEW CONCRETE SLAB WITH 50 SETDOWN & TOPPING
- 3 FILL-IN THE TRENCH AREA WITH NEW CONCRETE SLAB. NEW LEVEL (SFL) & FLOOR FINISH TO MATCH EXISTING CORRIDOR SLAB
- 4 FILL-IN THE TRENCH AREA WITH NEW CONCRETE SLAB. NEW LEVEL (SFL) TO MATCH EXISTING SLAB
- 5 NEW TOPPING TO EXISTING 30mm MATT. SETDOWN. NEW FLOOR LEVEL (SFL) TO MATCH EXISTING SLAB LEVEL- COS
- 6 CHECK EXISTING LEVEL & CONFIRM THRESHOLD RAMP REQUIREMENTS. NEW TOPPING TO FORM THRESHOLD RAMP. JACKHAMMER EXISTING SLAB FOR ADDITIONAL NEW TOPPING TO AVOID CRACK AND BREAK OF THRESHOLD RAMP (TBC)
- 7 JACKHAMMER EXISTING SLAB TO MATCH EXISTING CORRIDOR SLAB LEVEL. CHECK EXISTING LEVEL ON SITE
- 8 NEW TOPPING TO EXISTING CORRIDOR SLAB TO MATCH EXISTING ROOM SLAB LEVEL.
- 9 NEW CONCRETE SLAB & FOOTING- REFER DETAILS TO STRUCTURAL ENGINEER'S DRAWINGS
- 10 NEW PATHWAY CONCRETE SLAB & FOOTING- REFER DETAILS TO STRUCTURAL ENGINEER'S DRAWINGS

AS CONSTRUCTED

thomson
adsett

Telephone +61 7 3840 9999
bne@thomsonadsett.com
Level 9, 470 St Pauls Terrace
Fortitude Valley
Qld 4006 Australia
thomsonadsett.com

© Copyright
These drawings and designs and the copyright thereof are the property of Thomson Adsett Pty Ltd and must not be used, retained or copied without written permission of Thomson Adsett Pty Ltd. ABN 76 105 314 654 Trading as ThomsonAdsett. Dimensions take precedence over scaling. Do not measure off drawings as print sizes may vary

BUILDING 33
REDEVELOPMENT

554/700 YAAMBA ROAD,
NORMAN GARDENS QLD 4701

for
CQUniversity
NORTH ROCKHAMPTON CAMPUS
& GIRVAN




GIRVAN

B	25/06/2024	AS CONSTRUCTED	PB
A	02/02/2024	IFC	PB
4	20/09/2023	ISSUE FOR INFORMATION	WL
3	11/09/2023	AMENDED 60% DD ISSUE	PB
2	28/08/2023	60% DD ISSUE	WL
1	04/08/2023	PRELIMINARY ISSUE	WL

rev/	date	details	init.
------	------	---------	-------

drawn	date
WL	AUG 2023
checked	date
NC	AUG 2023
verified	date
GK	DEC 2023

scale

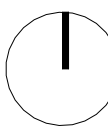

SLAB PLAN - GROUND
FLOOR

scale project no.
1:100 @ A1 23.0078.17

sheet no.
CQU-ROK-033-GN-ARC-23-11

revision
B

original sheet size - A1 (594mm x 841mm)

C:\REVIT\LOCALFILES\23.0078.17_CQU Building 33 Redevelopment_2023_Philip Bugden.nt 2/07/2024 4:52:27 PM

BUILDING 33
REDEVELOPMENT

554/700 YAAMBA ROAD,
NORMAN GARDENS QLD 4701

for
CQUniversity
NORTH ROCKHAMPTON CAMPUS
& GIRVAN



GIRVAN

B	25/06/2024	AS CONSTRUCTED	PB
A	02/02/2024	IFC	PB
4	24/11/2023	REVISED ISSUE	PB
3	20/09/2023	ISSUE FOR INFORMATION	WL
2	11/09/2023	AMENDED 60% DD ISSUE	PB
1	28/08/2023	60% DD ISSUE	WL

rev	date	details	init
drawn	date		
WL	AUG 2023		
checked	date		
NC	AUG 2023		
verified	date		
GK	DEC 2023		


scale

PARTITION PLAN - GROUND
FLOOR

scale project no.
1 : 100 @ A1 23.0078.17

sheet no.
CQU-ROK-033-GN-ARC-25-11

revision
B

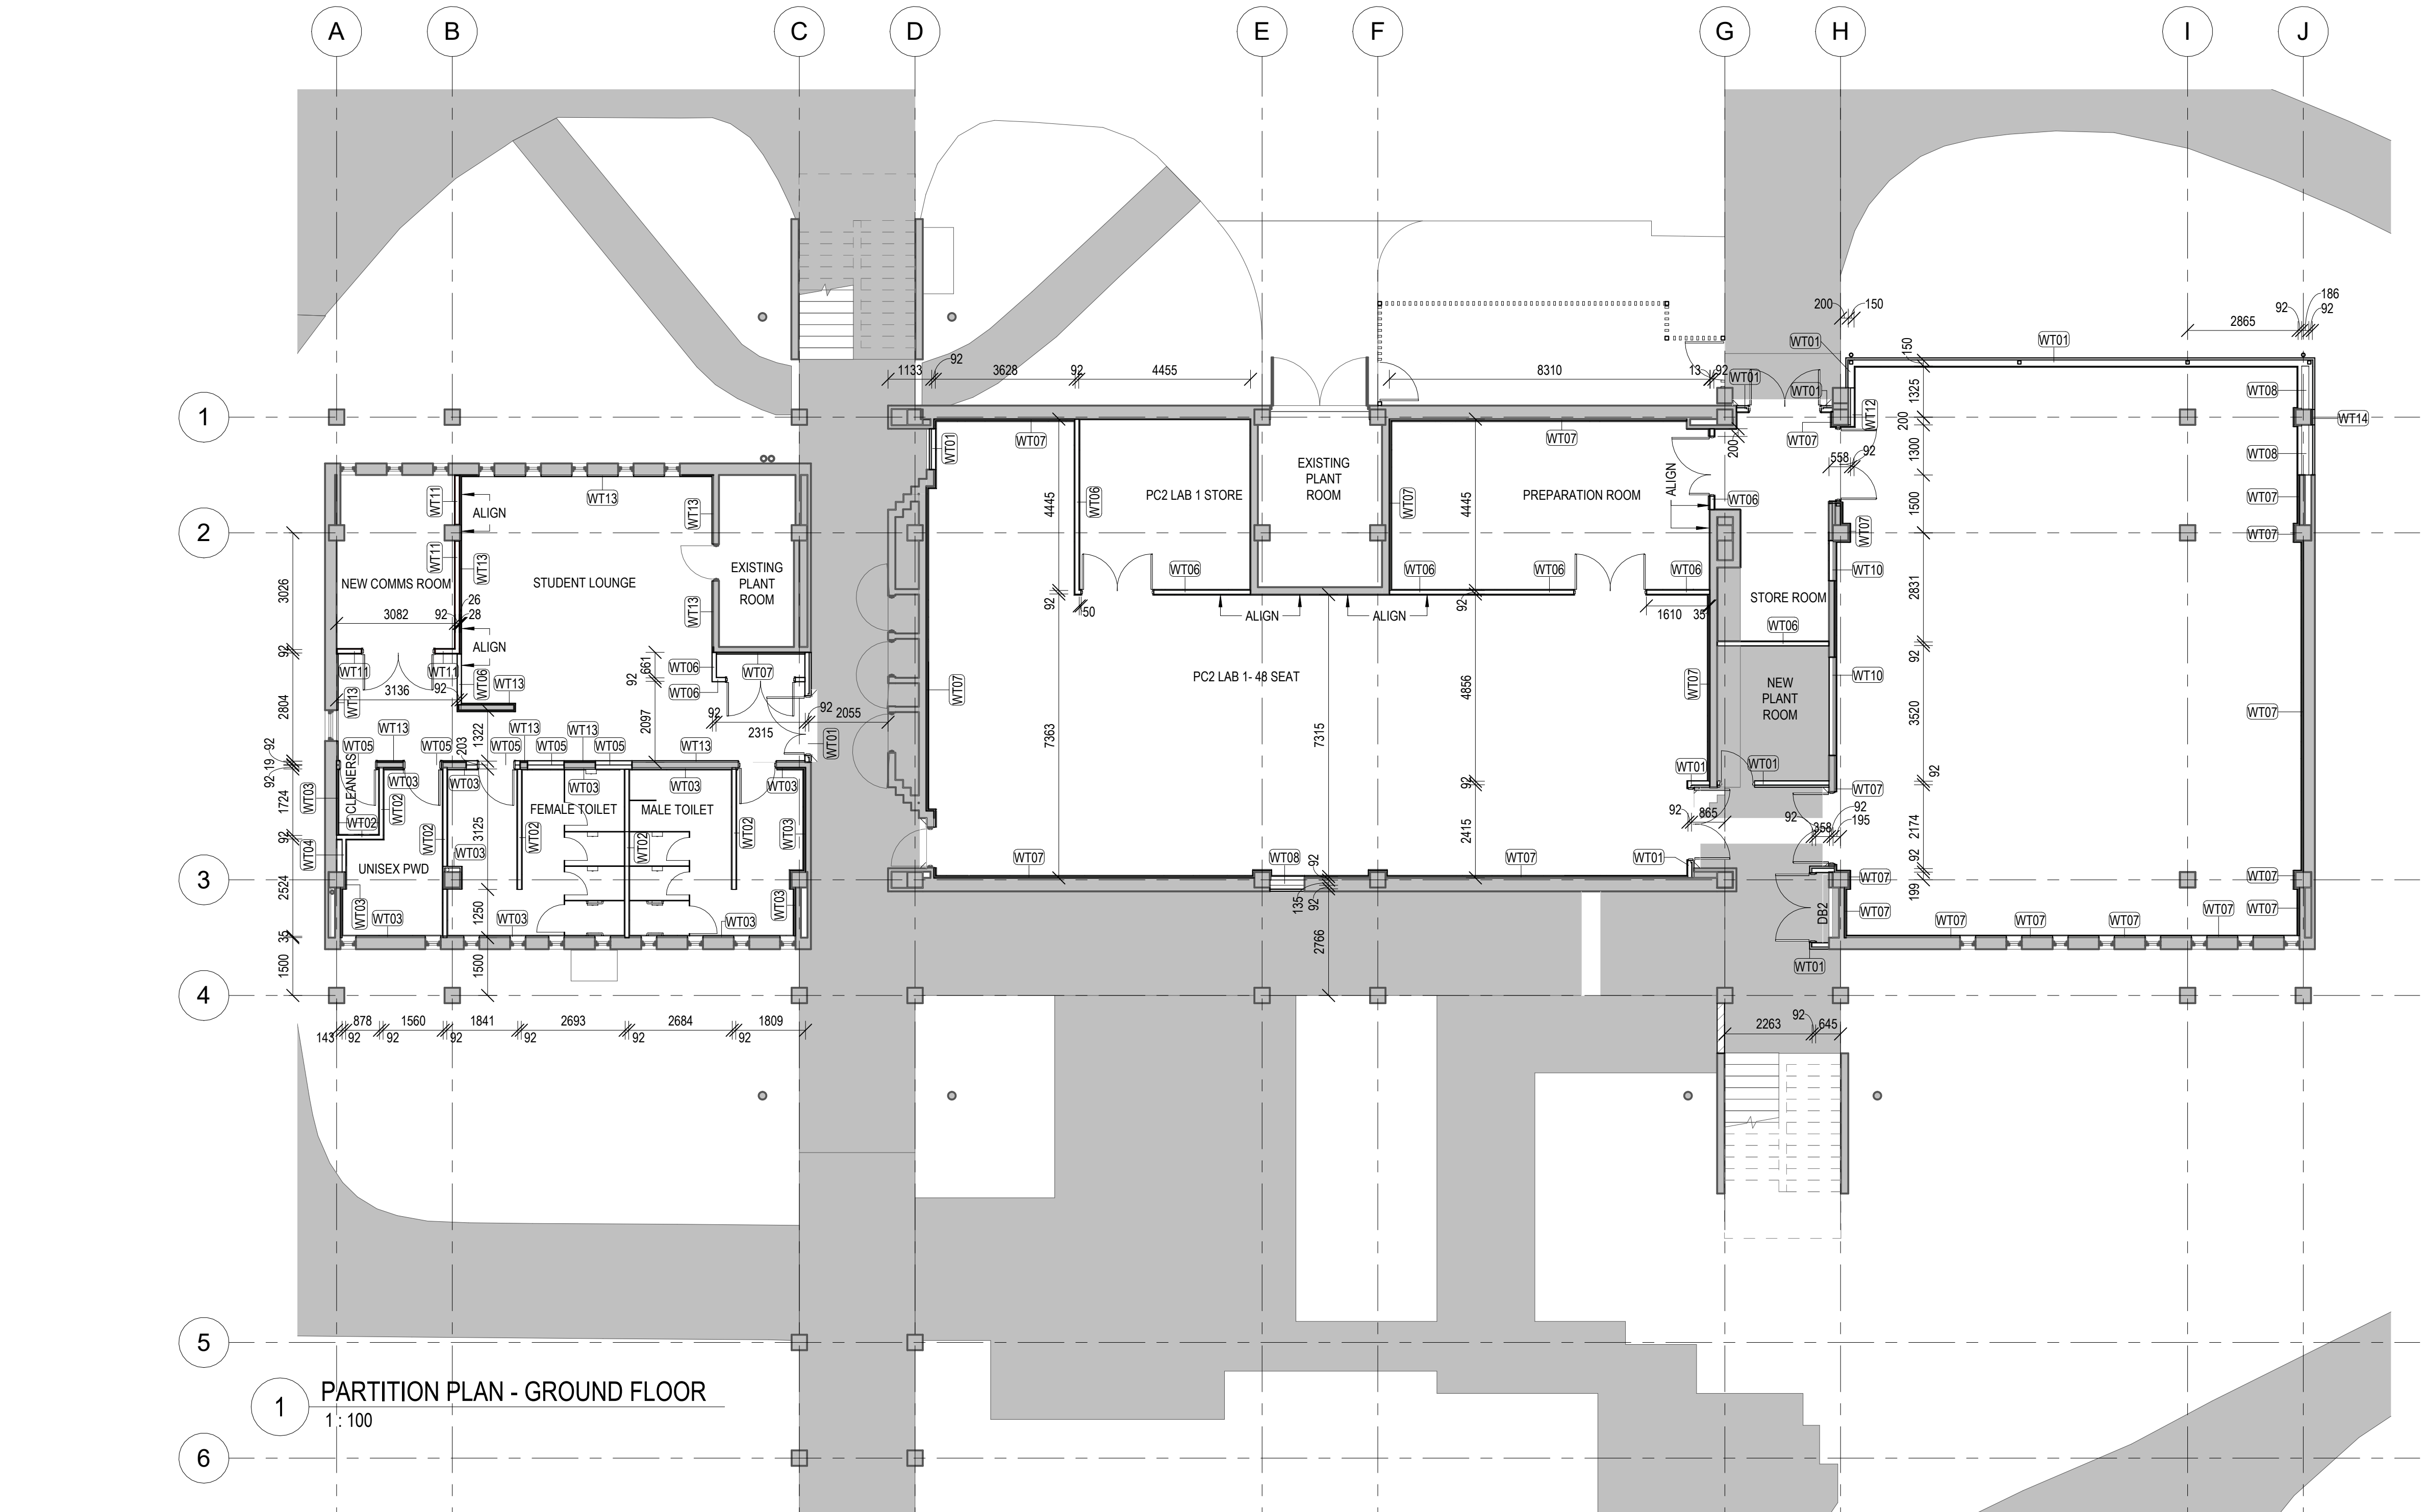


PARTITION PLAN - GROUND FLOOR
1 : 100

WALL TYPES SCHEDULE			
WT01	9mm 35mm 15mm 0mm 6mm 92mm/ 150mm 13mm	CFC CLADDING, EXPRESS JOINT FURRING CHANNEL ZONE FURRING CHANNEL ZONE SARKING CEMINTEL RIGID AIR BARRIER STEEL STUD + R2.5 INSULATION PLASTER BOARD LINING, FLUSH SET	90 GOLD BATTS R2.5 CSR 5030 (CUSTOM)
WT02	9mm 92mm* 9mm	FIBRE CEMENT LINING, FLUSH SET STEEL STUD + 11KG/M ² INSULATION (BETWEEN ROOMS) FIBRE CEMENT LINING, FLUSH SET *PROVIDE PLYWOOD SUPPORT AS NOGGING FOR FF&E FIXING WHERE REQUIRED	75 GW PARTITION 11KGm ²
WT03	9mm 35mm	FIBRE CEMENT LINING, FLUSH SET FURRING CHANNEL/ TOP HAT ZONE	Nil
WT04	9mm 92mm*	FIBRE CEMENT LINING, FLUSH SET STEEL STUD *PROVIDE PLYWOOD SUPPORT AS NOGGING FOR FF&E FIXING WHERE REQUIRED	Nil
WT05	13mm 92mm 19mm 92mm 9mm	PLASTER BOARD LINING, FLUSH SET STEEL STUD + 11KG/M ² INSULATION CAVITY STEEL STUD FIBRE CEMENT LINING, FLUSH SET	75 GW PARTITION 11KGm ²
WT06	13mm 92mm 13mm	PLASTER BOARD LINING, FLUSH SET STEEL STUD + 11KG/M ² INSULATION PLASTER BOARD LINING, FLUSH SET	75 GW PARTITION 11KGm ²

WALL TYPES SCHEDULE			
WT07	13mm 35mm	PLASTER BOARD LINING, FLUSH SET FURRING CHANNEL/ TOP HAT ZONE	Nil
WT08	9mm 35mm 15mm 0mm 6mm 92mm VARIES (COS) 92mm 13mm	CFC CLADDING, EXPRESS JOINT TOP HAT ZONE TOP HAT ZONE SARKING CEMINTEL RIGID AIR BARRIER STEEL STUD + R2.5 INSULATION VOID/ CAVITY STEEL STUD PLASTER BOARD LINING, FLUSH SET	90 GOLD BATTS R2.5 CSR CUSTOM
WT10	13mm 13mm 92mm 35mm 35mm 13mm	PLASTER BOARD LINING, FLUSH SET PLASTER BOARD LINING, FLUSH SET STEEL STUD + 11KG/M ² INSULATION TOP HATS TOP HATS PLASTER BOARD LINING, FLUSH SET	75 GW PARTITION 11KGm ²
WT11	13mm 13mm 92mm 13mm 13mm	FIRE RATED PB LINING FIRE RATED PB LINING STEEL STUD + 11KG/M ² INSULATION FIRE RATED PB LINING FIRE RATED PB LINING	75 GW PARTITION 11KGm ²

WALL TYPES SCHEDULE			
WT12	13mm 92mm	PLASTER BOARD LINING, FLUSH SET STEEL STUD + R2.5 INSULATION	90 GOLD BATTS R2.5
WT13	13mm 28mm	PLASTER BOARD LINING, FLUSH SET FURRING CHANNEL ZONE	Nil
WT14	9mm 35mm 15mm 0mm 6mm 35mm	CFC CLADDING, EXPRESS JOINT TOP HAT ZONE TOP HAT ZONE SARKING CEMINTEL RIGID AIR BARRIER TOP HAT ZONE	Nil

AS CONSTRUCTED

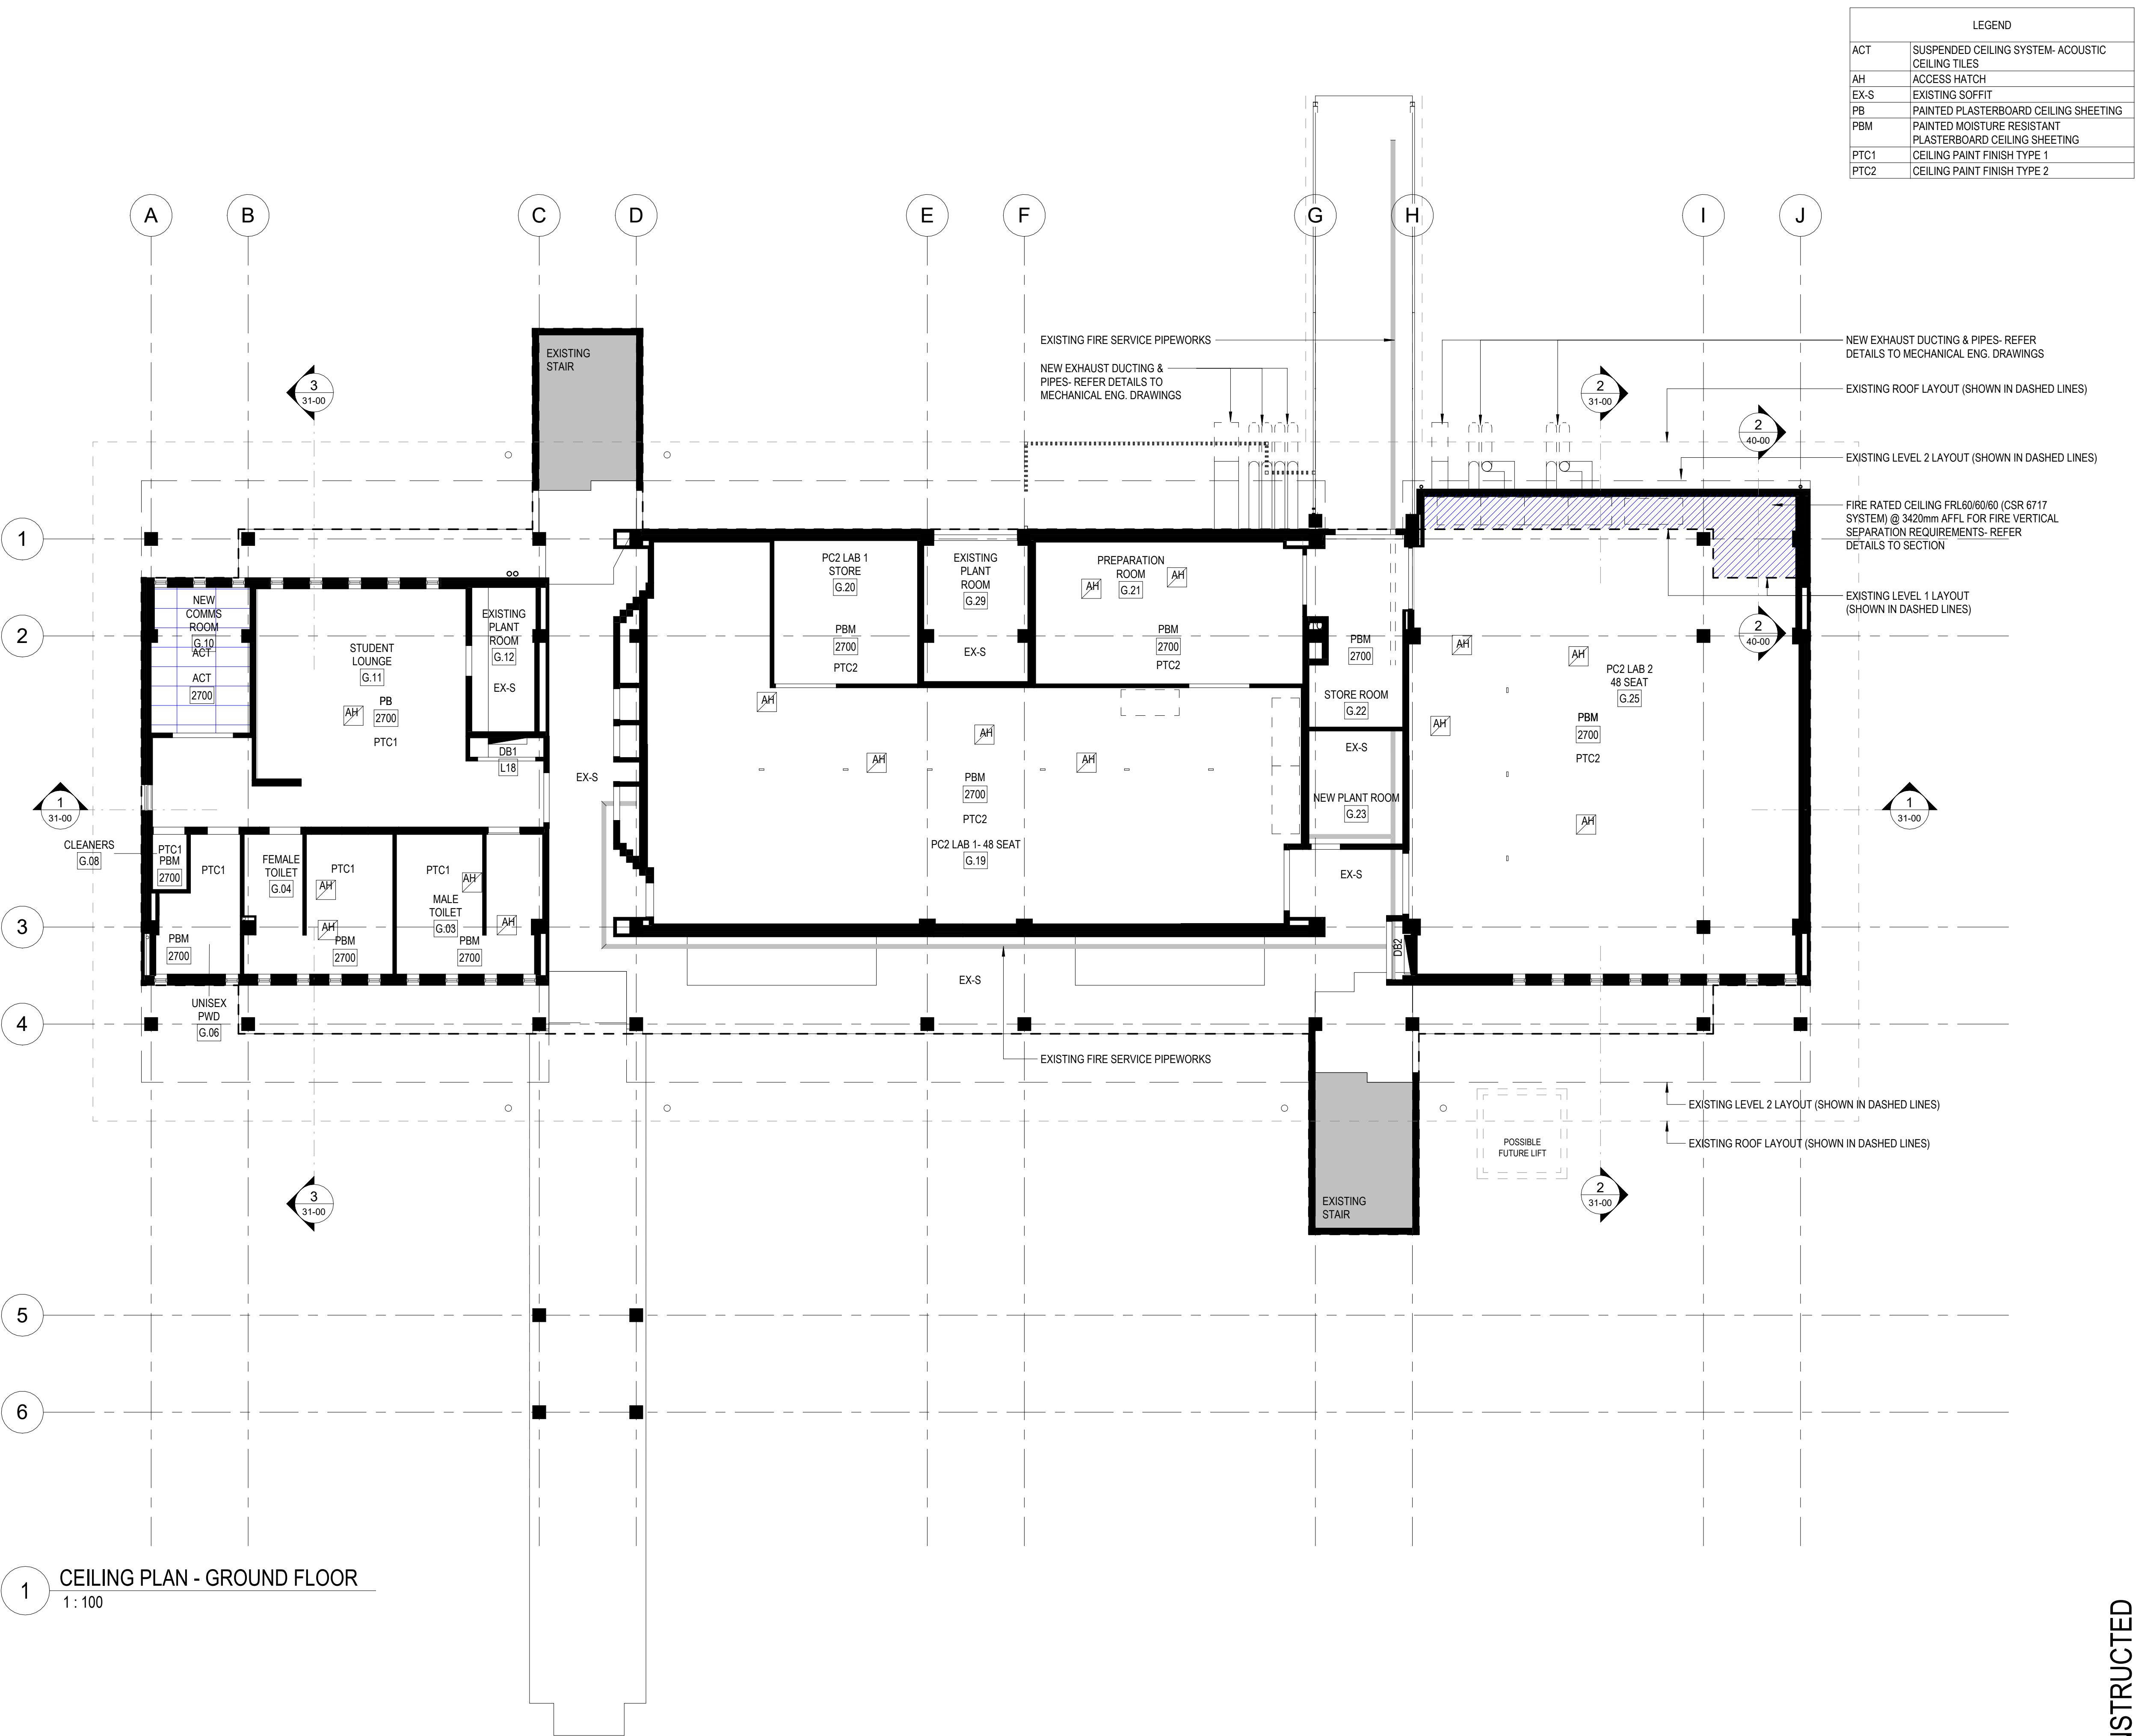

LEGEND	
ACT	SUSPENDED CEILING SYSTEM-ACOUSTIC CEILING TILES
AH	ACCESS HATCH
EX-S	EXISTING SOFFIT
PB	PAINTED PLASTERBOARD CEILING SHEETING
PBM	PAINTED MOISTURE RESISTANT PLASTERBOARD CEILING SHEETING
PTC1	CEILING PAINT FINISH TYPE 1
PTC2	CEILING PAINT FINISH TYPE 2

Telephone +61 7 3840 9999
bne@thomsonadsett.com
Level 9, 470 St Pauls Terrace
Fortitude Valley
Qld 4006 Australia
thomsonadsett.com

© Copyright
These drawings and designs and the copyright thereof are the property of Thomson Adsett Pty Ltd and must not be used, retained or copied without written permission of Thomson Adsett Pty Ltd. ABN 76 105 314 654 Trading as ThomsonAdsett. Dimensions take precedence over scaling. Do not measure off drawings as print sizes may vary

BUILDING 33 REDEVELOPMENT

554/700 YAAMBA ROAD,
NORMAN GARDENS QLD 4701

for
CQUUniversity
NORTH ROCKHAMPTON CAMPUS
& GIRVAN



GIRVAN

B	25/06/2024	AS CONSTRUCTED	PB
A	02/02/2024	IFC	PB
6	25/01/2024	AMENDED FUME CUPBOARD SIZEING	PB
5	19/12/2023	REVISED ISSUE	PB
4	20/09/2023	ISSUE FOR INFORMATION	WL
3	11/09/2023	AMENDED 60% DD ISSUE	PB
2	28/08/2023	60% DD ISSUE	WL
1	04/08/2023	PRELIMINARY ISSUE	WL

rev	date	details	init
-----	------	---------	------

drawn	date
WL	JUL 2023
checked	date
NC	JUL 2023
verified	date
GK	DEC 2023

scale

CEILING PLAN - GROUND FLOOR

scale
1 : 100 @ A1

project no.
23.0078.17

sheet no.
CQU-ROK-033-GN-ARC-26-11

revision
B

original sheet size - A1 (594mm x 841mm)

AS CONSTRUCTED

C:\REVIT\LOCAL\FILES\23.0078.17_CQU Building 33 Redevelopment_2023_Philip Bugden.nt

© Copyright
These drawings and designs and the copyright thereof are the property of Thomson Adsett Pty Ltd and must not be used, retained or copied without written permission of Thomson Adsett Pty Ltd. ABN 76 105 314 654 Trading as ThomsonAdsett. Dimensions take precedence over scaling. Do not measure off drawings as print sizes may vary

BUILDING 33 REDEVELOPMENT

554/700 YAAMBA ROAD,
NORMAN GARDENS QLD 4701

for
CQUniversity
NORTH ROCKHAMPTON CAMPUS
& GIRVAN



GIRVAN

B	25/06/2024	AS CONSTRUCTED	PB
A	02/02/2024	IFC	PB
3	20/12/2023	REVISED ISSUE	PB
2	06/11/2023	REVISED ISSUE	AP
1	20/09/2023	ISSUE FOR INFORMATION	WL
rev	date	details	init.

drawn	date
TA	SEP 2023
checked	date
PB	SEP 2023
verified	date
GK	DEC 2023



FINISHES PLAN - GROUND FLOOR

scale project no.
1 : 100 @ A1 23.0078.17

sheet no. **CQU-ROK-033-GN-ARC-28-11**

B

original sheet size - A1 (594mm x 841mm)

AS CONSTRUCTED

GENERAL NOTES:

- THIS DRAWING IS TO BE READ IN CONJUNCTION WITH ALL PROJECT DRAWINGS, SCHEDULES AND SPECIFICATIONS, PLUS ALL OTHER RELEVANT CONSULTANT DOCUMENTS.
- ALL WORKS TO COMPLY WITH BCA AND AUSTRALIAN STANDARDS.
- ANY DISCREPANCIES ON THE DRAWINGS OR IRREGULARITIES BETWEEN INFORMATION SHOWN ON INTERIOR DRAWINGS AND SERVICES CONSULTANTS DOCUMENTS ARE TO BE REFERRED TO THE DESIGNER FOR CLARIFICATION PRIOR TO THE WORKS PROCEEDING.


FINISHES NOTES:

- ALL JUNCTIONS IN FLOOR FINISHES TO BE FLUSH. REFER 64-00 FOR DETAILS.
- CHANGES TO FLOOR FINISH TO OCCUR UNDER THE CENTRE LINE OF THE DOOR LEAF UNLESS NOTED OTHERWISE
- ALL INTERNAL GLAZING TO HAVE GLAZING FILM AS PER AS1428.1.
- GLAZING FILM TO BE APPLIED TO THE INTERNAL FACE OF GLAZING.
- ALL WALLS TO BE PA01 UNLESS OTHERWISE NOTED.
- ALL INTERNAL SOLID CORE DOORS TO BE PA02 UNLESS OTHERWISE NOTED.

WALL FINISHES LEGEND:

REFER TO FINISHES & FF&E SCHEDULE FOR SPECIFICATION

WFXX	ACOUSTIC WALL FINISH
WFXX	WALL VINYL FINISH
PAXX	FEATURE PAINT FINISH
TLXX	TILE FINISH

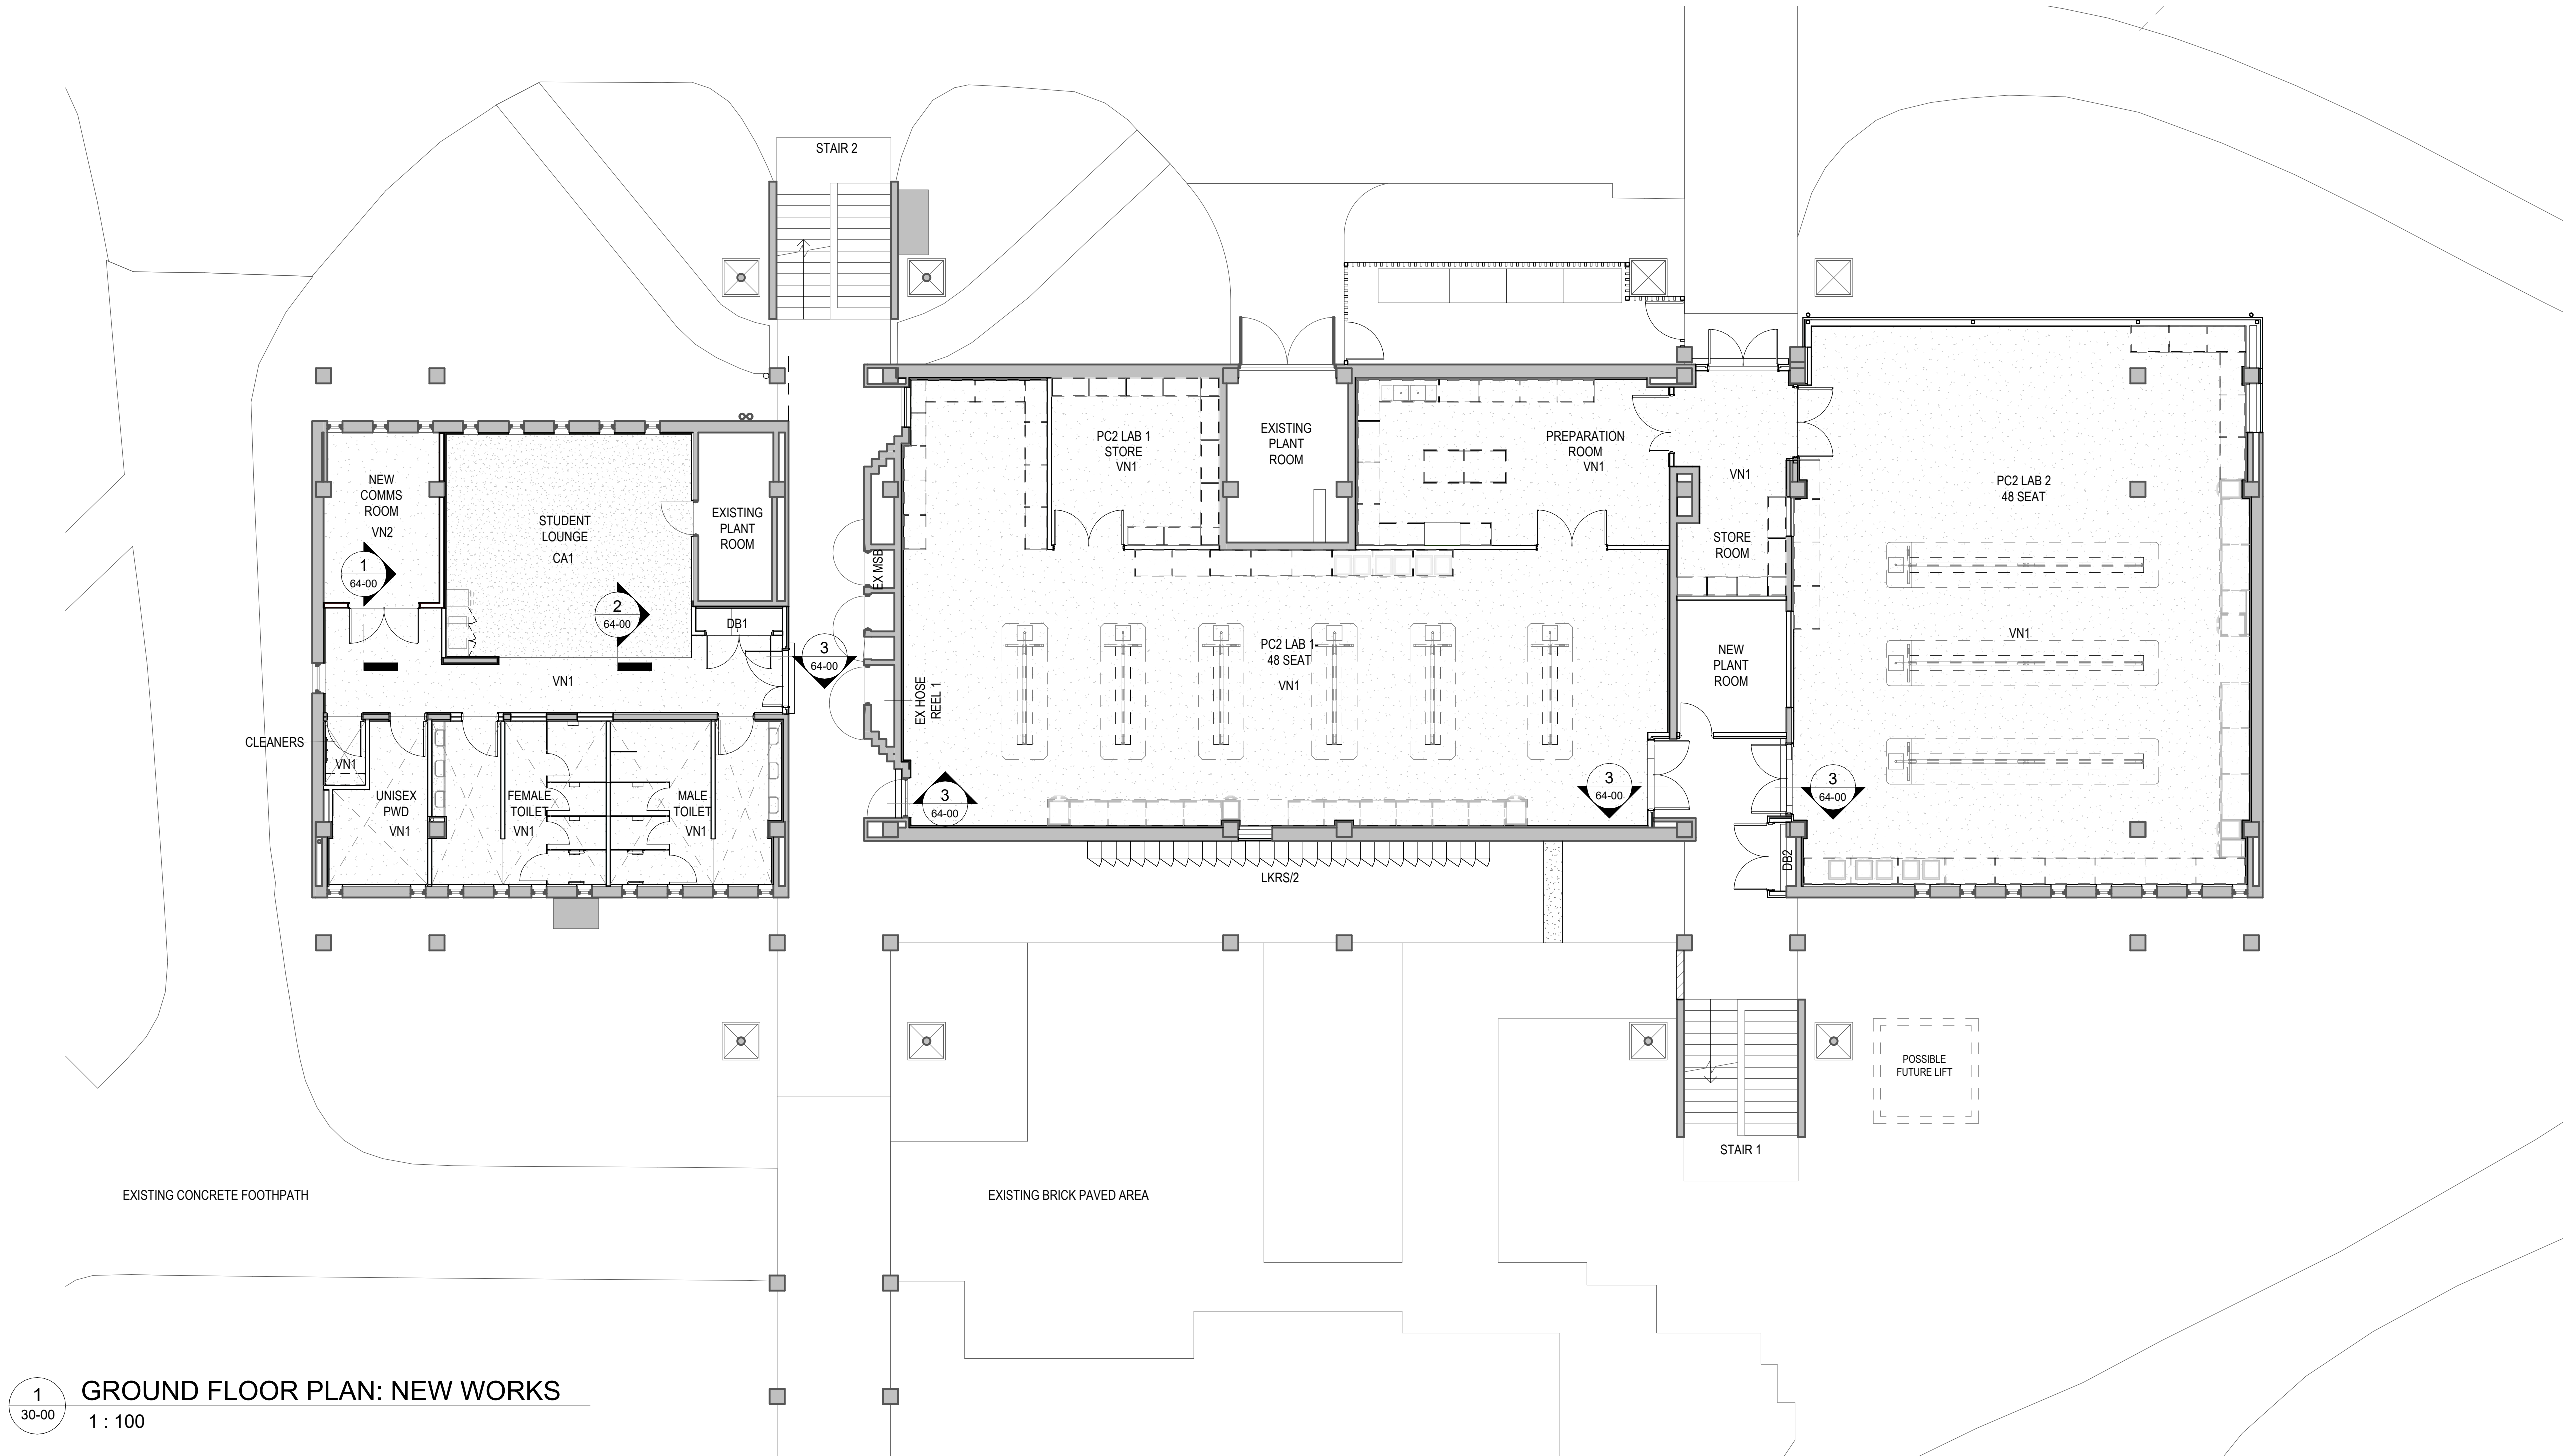

1 GROUND FLOOR PLAN: NEW WORKS
30-00 1 : 100

BUILDING 33
REDEVELOPMENT

554/700 YAAMBA ROAD,
NORMAN GARDENS QLD 4701

for
CQUniversity
NORTH ROCKHAMPTON CAMPUS
& GIRVAN



B	25/06/2024	AS CONSTRUCTED	PB
A	02/02/2024	IFC	PB
6	25/01/2024	AMENDED FUME CUPBOARD SIZING	PB
5	20/12/2023	REVISED ISSUE	PB
4	19/12/2023	REVISED ISSUE	PB
3	24/11/2023	REVISED ISSUE	PB
2	06/11/2023	REVISED ISSUE	AP
1	20/09/2023	ISSUE FOR INFORMATION	WL
rev/	date	details	revision

drawn	date
TA	SEP 2023
checked	date
PB	SEP 2023
verified	date
GK	DEC 2023

scale

FURNITURE & JOINERY
PLAN - GROUND FLOOR

scale project no.
1 : 100 @ A1 23.0078.17


sheet no.
CQU-ROK-033-GN-ARC-28-12

revision
B

original sheet size - A1 (594mm x 841mm)

GENERAL NOTES:

- THIS DRAWING IS TO BE READ IN CONJUNCTION WITH ALL PROJECT DRAWINGS, SCHEDULES AND SPECIFICATIONS, PLUS ALL OTHER RELEVANT CONSULTANT DOCUMENTS.
- ALL WORKS TO COMPLY WITH BCA AND AUSTRALIAN STANDARDS.
- ANY DISCREPANCIES ON THE DRAWINGS OR IRREGULARITIES BETWEEN INFORMATION SHOWN ON INTERIOR DRAWINGS AND SERVICES CONSULTANTS DOCUMENTS ARE TO BE REFERRED TO THE DESIGNER FOR CLARIFICATION PRIOR TO THE WORKS PROCEEDING.

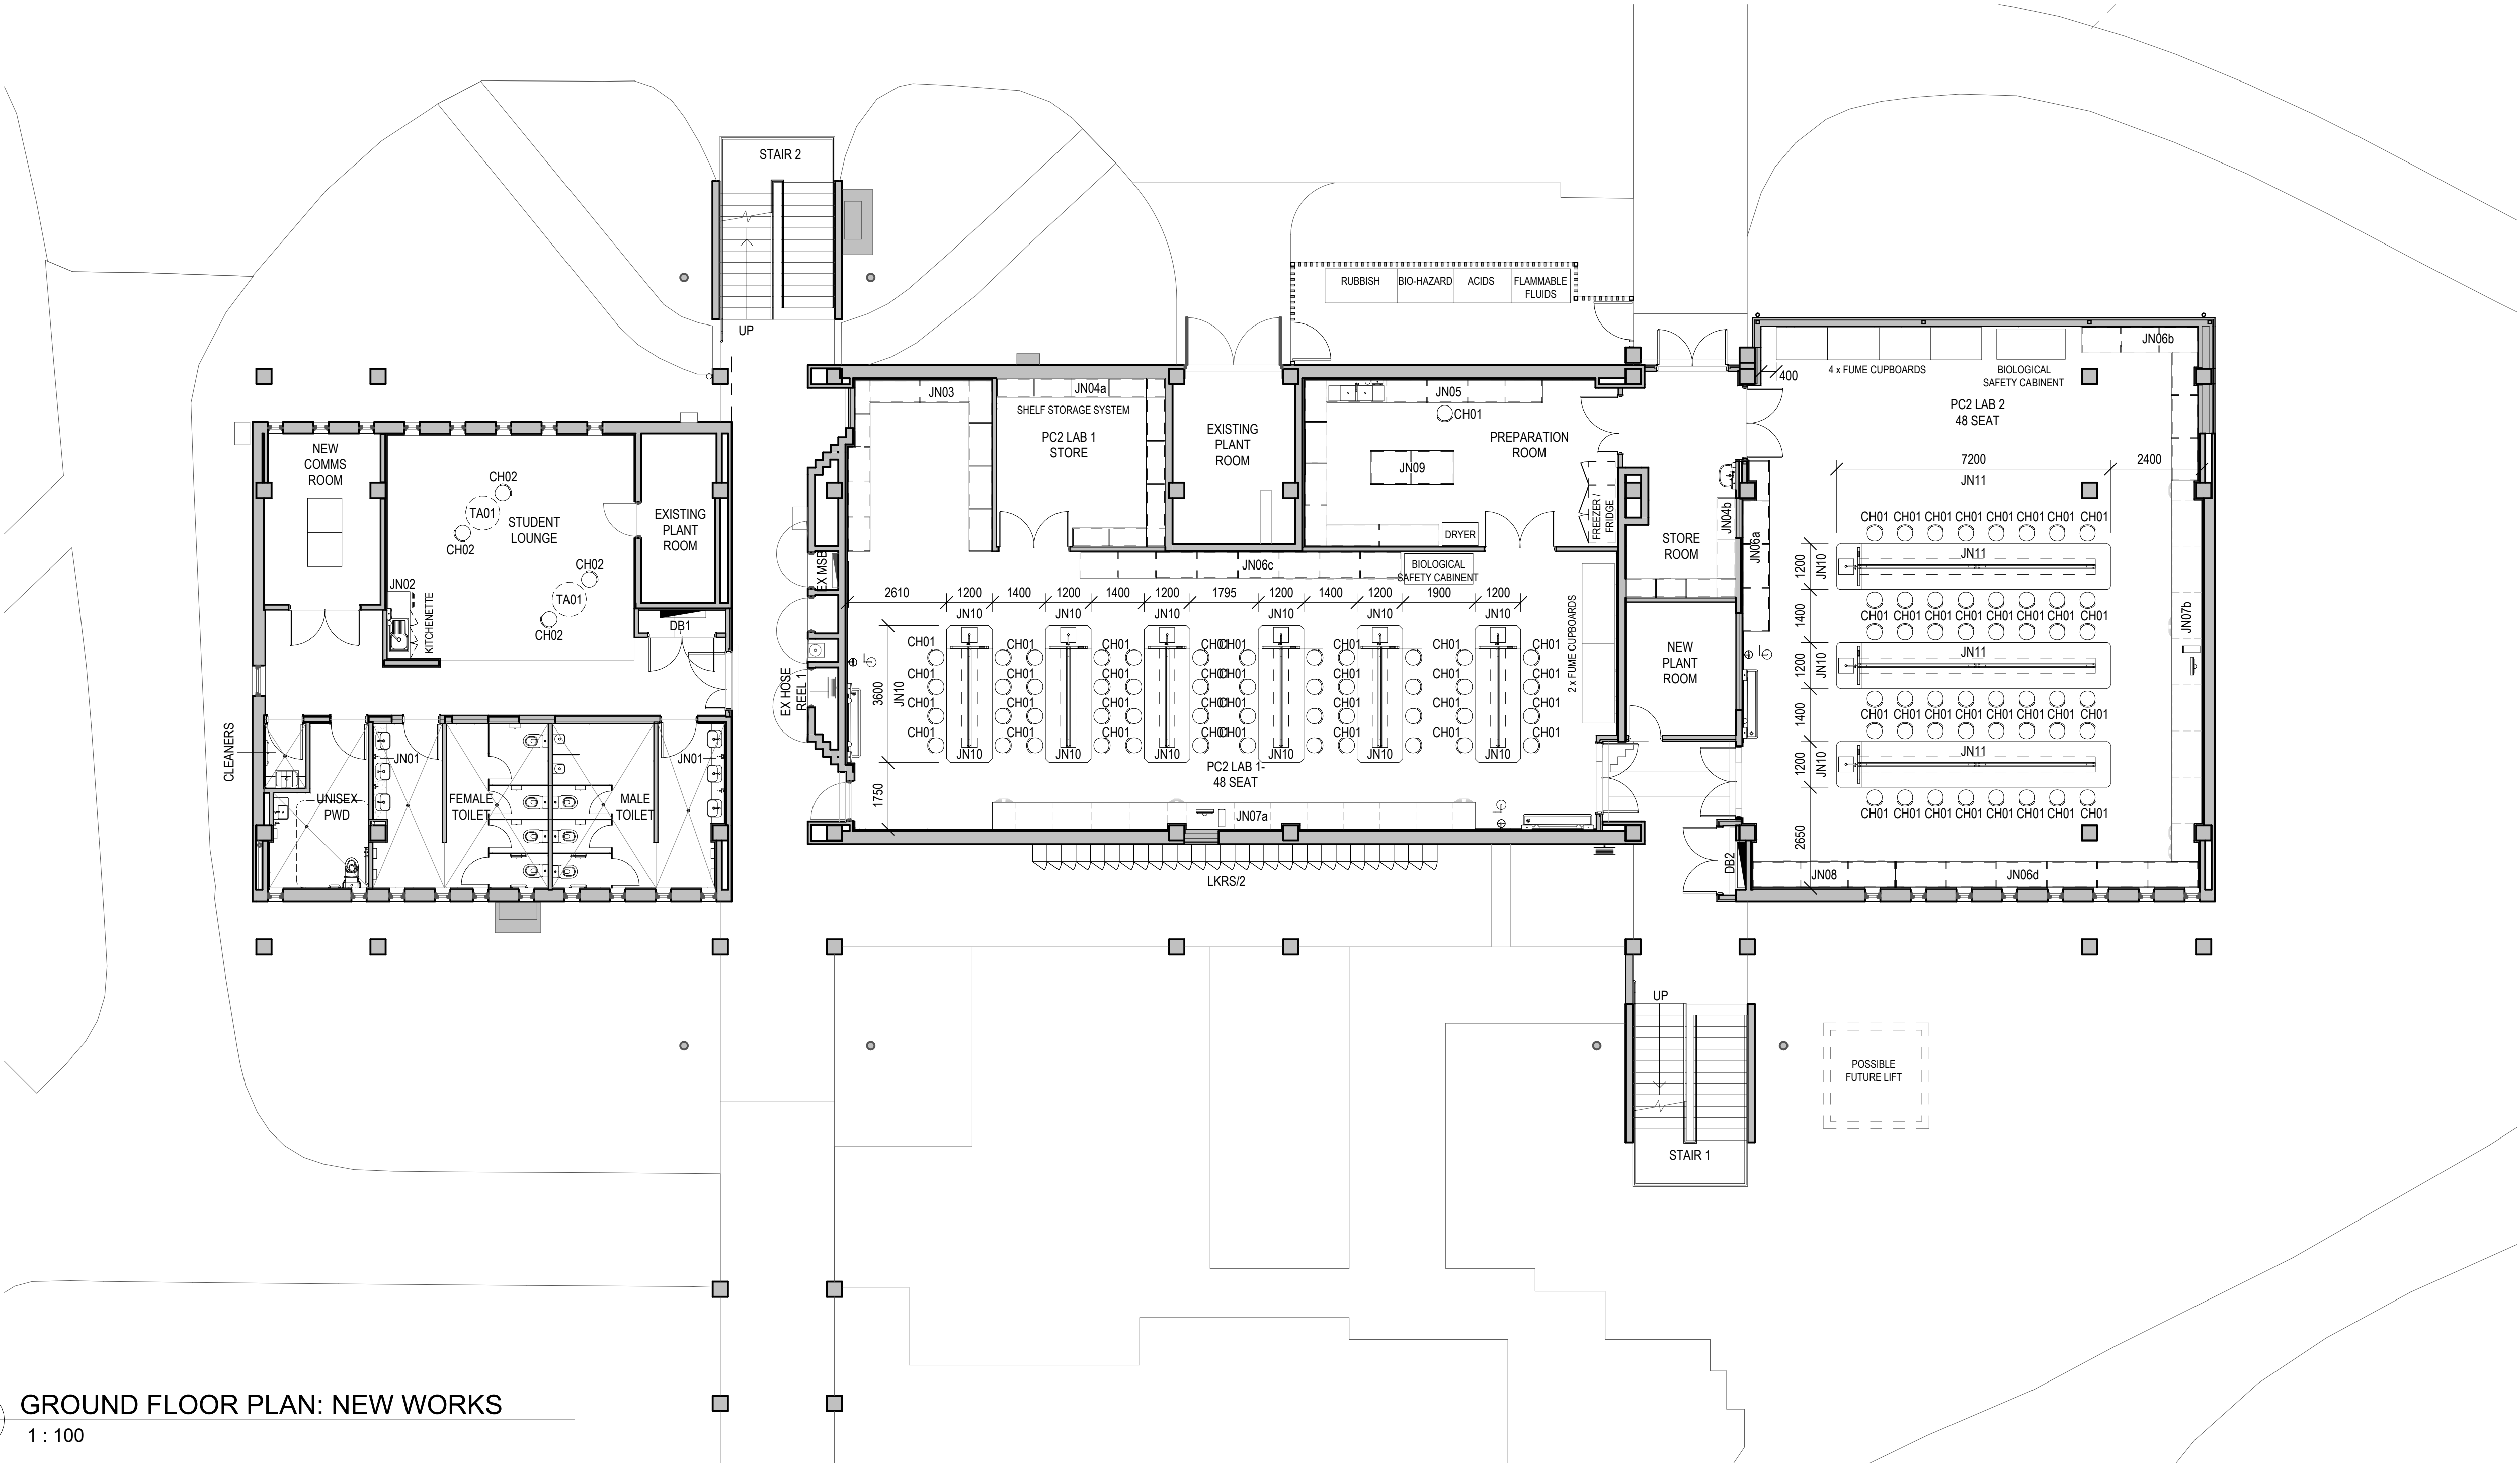

1
30-00
GROUND FLOOR PLAN: NEW WORKS
1 : 100

AS CONSTRUCTED

BUILDING 33 REDEVELOPMENT

554/700 YAAMBA ROAD,
NORMAN GARDENS QLD 4701

for
CQUniversity
NORTH ROCKHAMPTON CAMPUS
& GIRVAN




GIRVAN

B	25/06/2024	AS CONSTRUCTED	PB
A	02/02/2024	IFC	PB
5	05/10/2023	REVISED PLANT ROOM	PB
4	20/09/2023	ISSUE FOR INFORMATION	WL
3	11/09/2023	AMENDED 60% DD ISSUE	PB
2	28/08/2023	60% DD ISSUE	WL
1	04/08/2023	PRELIMINARY ISSUE	WL

rev/ date details init

drawn	date
WL	AUG 2023
checked	date
NC	AUG 2023
verified	date
GK	DEC 2023

scale

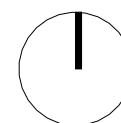


BUILDING ELEVATIONS - SHEET 1

scale project no.
1 : 100 @ A1 23.0078.17

sheet no.
CQU-ROK-033-GN-ARC-30-00

revision
B


original sheet size - A1 (594mm x 841mm)

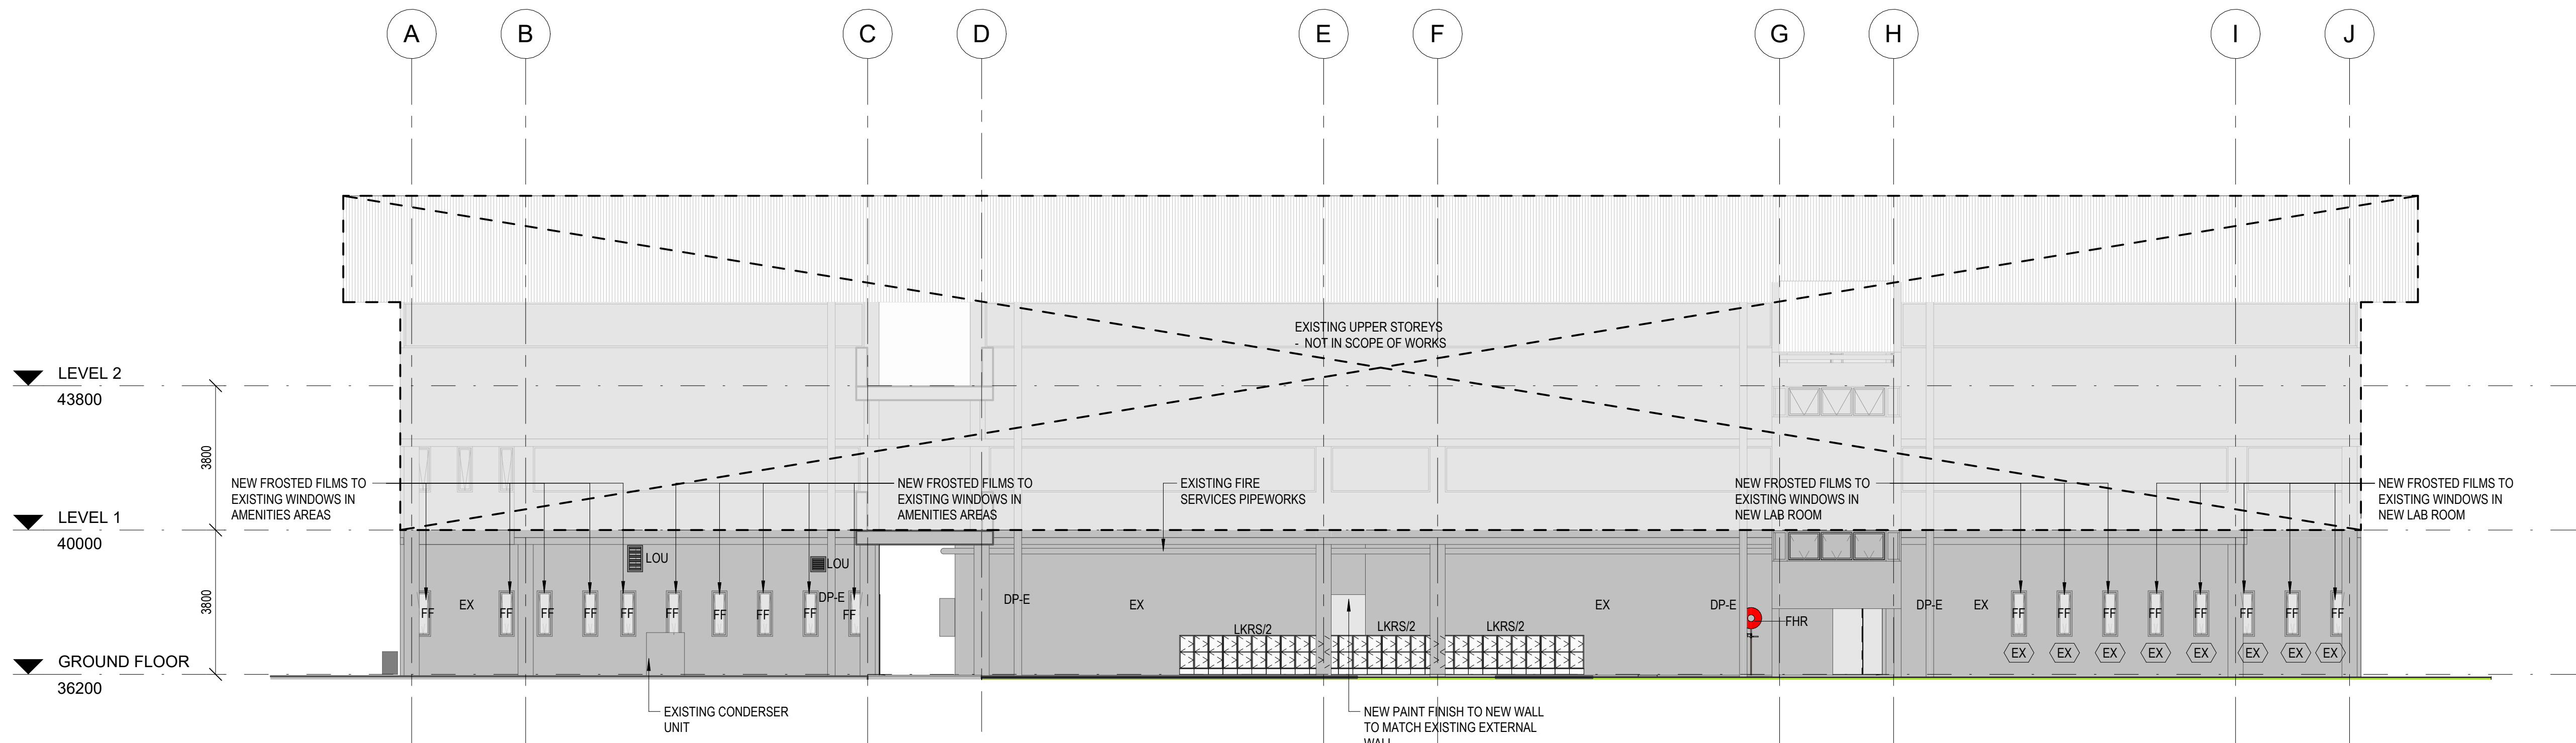

1
21-11
SOUTH ELEVATION - GROUND FLOOR
1 : 100

NOTE:
- BUILDER TO ENSURE ALL EXISTING EXTERNAL
WINDOWS ON GROUND FLOOR ARE NOT
OPERABLE

LEGEND	
DP	DOWNPIPE
DP-E	DOWNPIPE - EXISTING
EX	EXISTING
FF	FROSTED FILM TO WINDOW
FHR	FIRE HOSE REEL
LKRS/2	LOCKERS
LOU	MECHANICAL LOUVRE
MAF	METAL APRON FLASHING
MBF	METAL BARGE FLASHING
MRS	METAL ROOF SHEETING

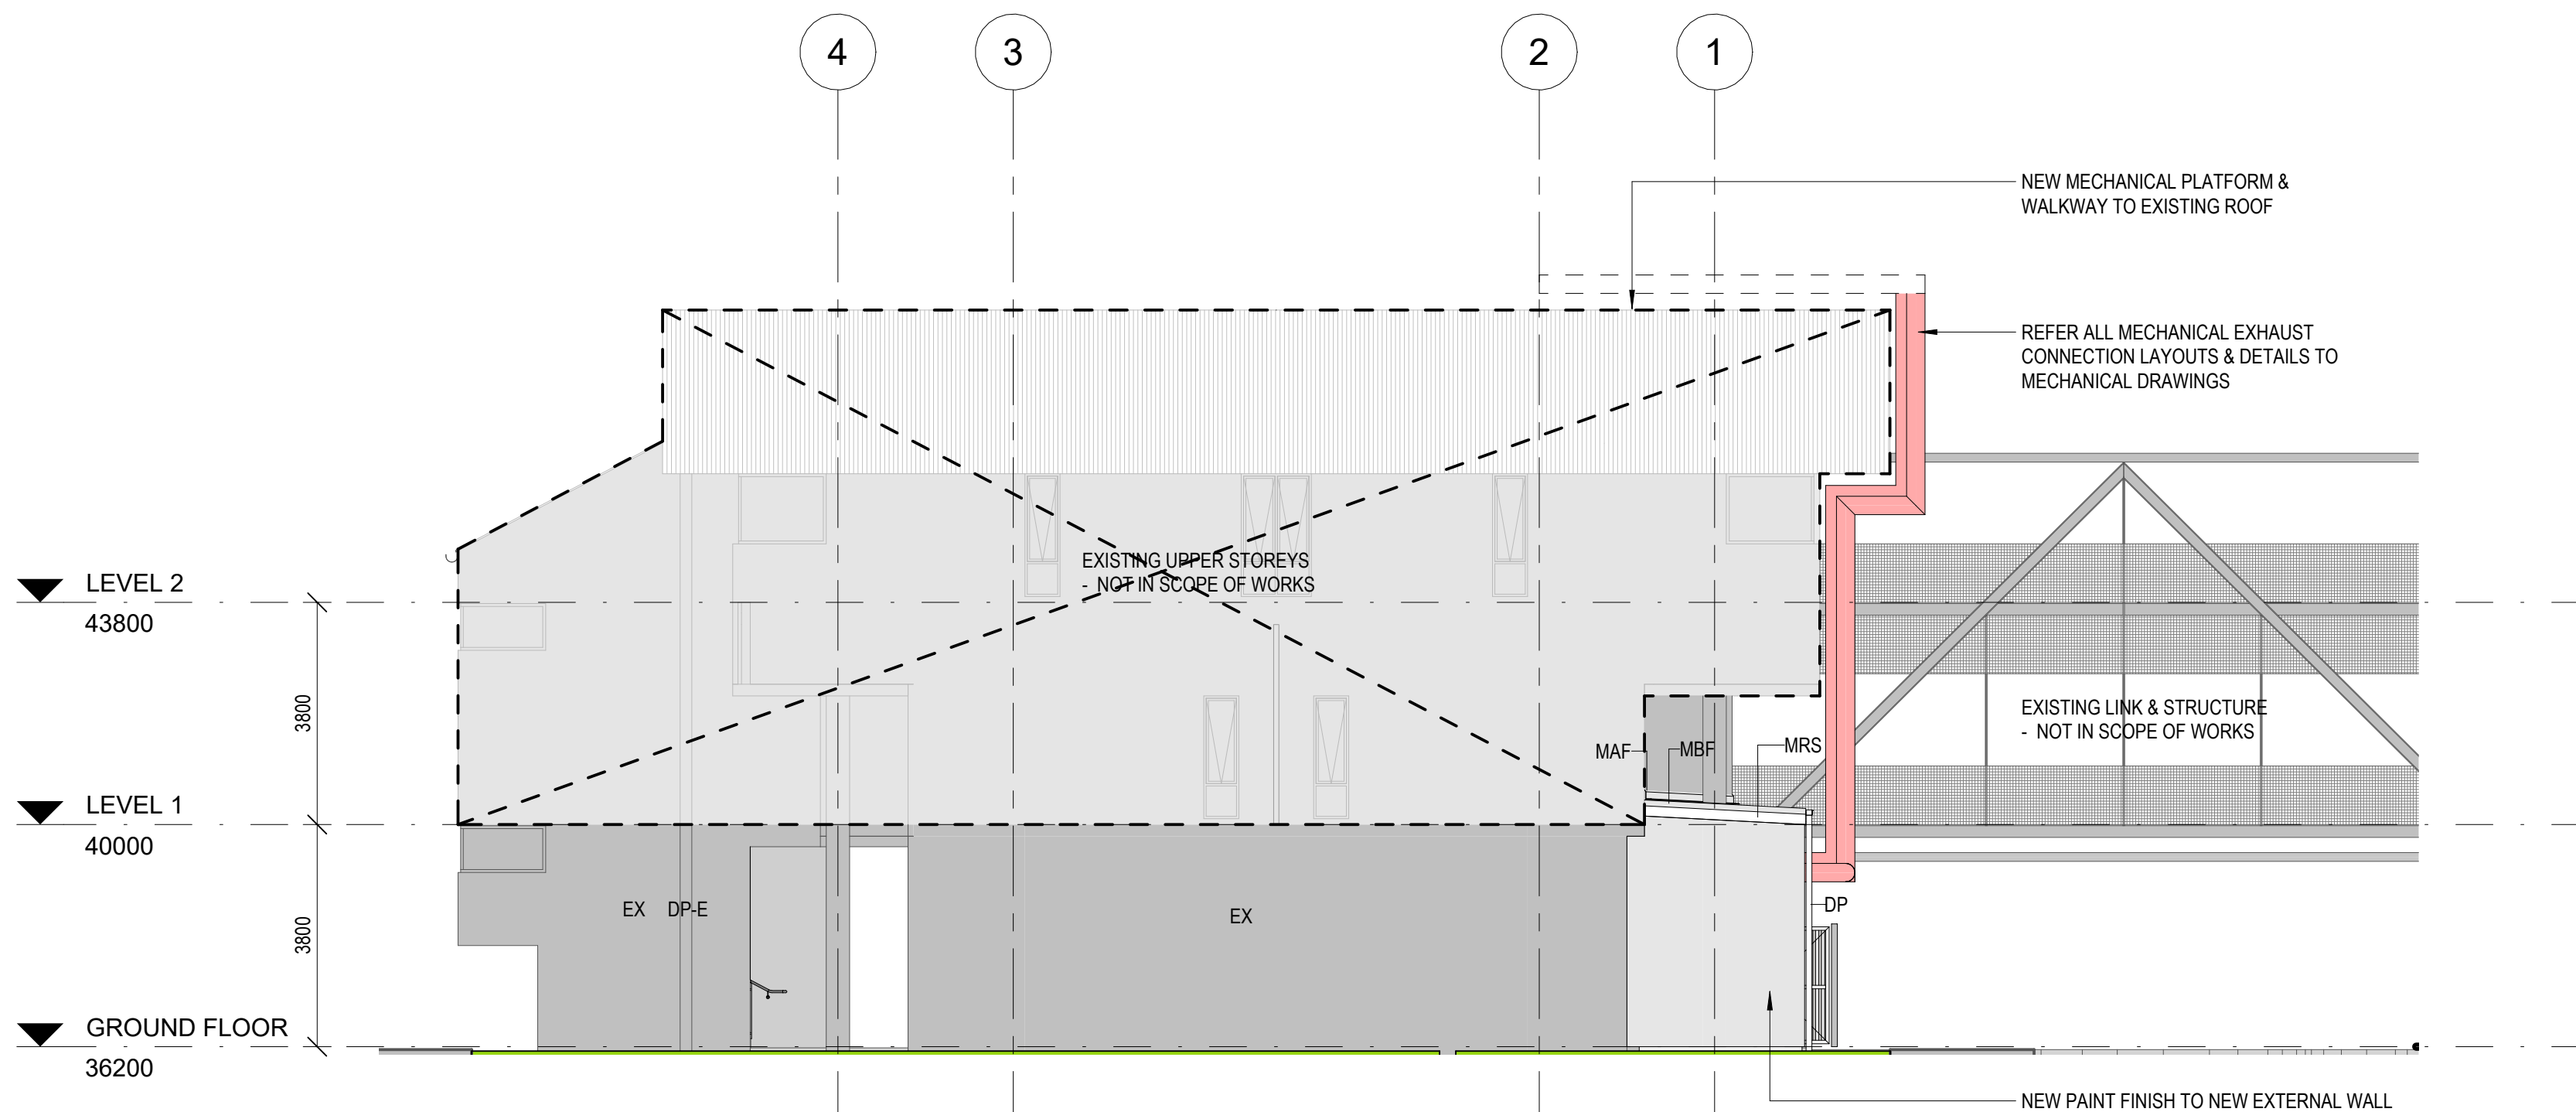

2
21-11
EAST ELEVATION - GROUND FLOOR
1 : 100

AS CONSTRUCTED

BUILDING 33 REDEVELOPMENT

554/700 YAAMBA ROAD,
NORMAN GARDENS QLD 4701

for
CQUUniversity
NORTH ROCKHAMPTON CAMPUS
& GIRVAN



GIRVAN

B	25/06/2024	AS CONSTRUCTED	PB
A	02/02/2024	IFC	PB
5	05/10/2023	REVISED PLANT ROOM	PB
4	20/09/2023	ISSUE FOR INFORMATION	WL
3	11/09/2023	AMENDED 60% DD ISSUE	PB
2	28/08/2023	60% DD ISSUE	WL
1	04/08/2023	PRELIMINARY ISSUE	WL

rev	date	details	init
-----	------	---------	------


drawn	date
WL	AUG 2023
checked	date
NC	AUG 2023
verified	date
GK	DEC 2023

scale

BUILDING ELEVATIONS - SHEET 2

scale	project no.
1 : 100 @ A1	23.0078.17


sheet no.	revision
CQU-ROK-033-GN-ARC-30-01	B

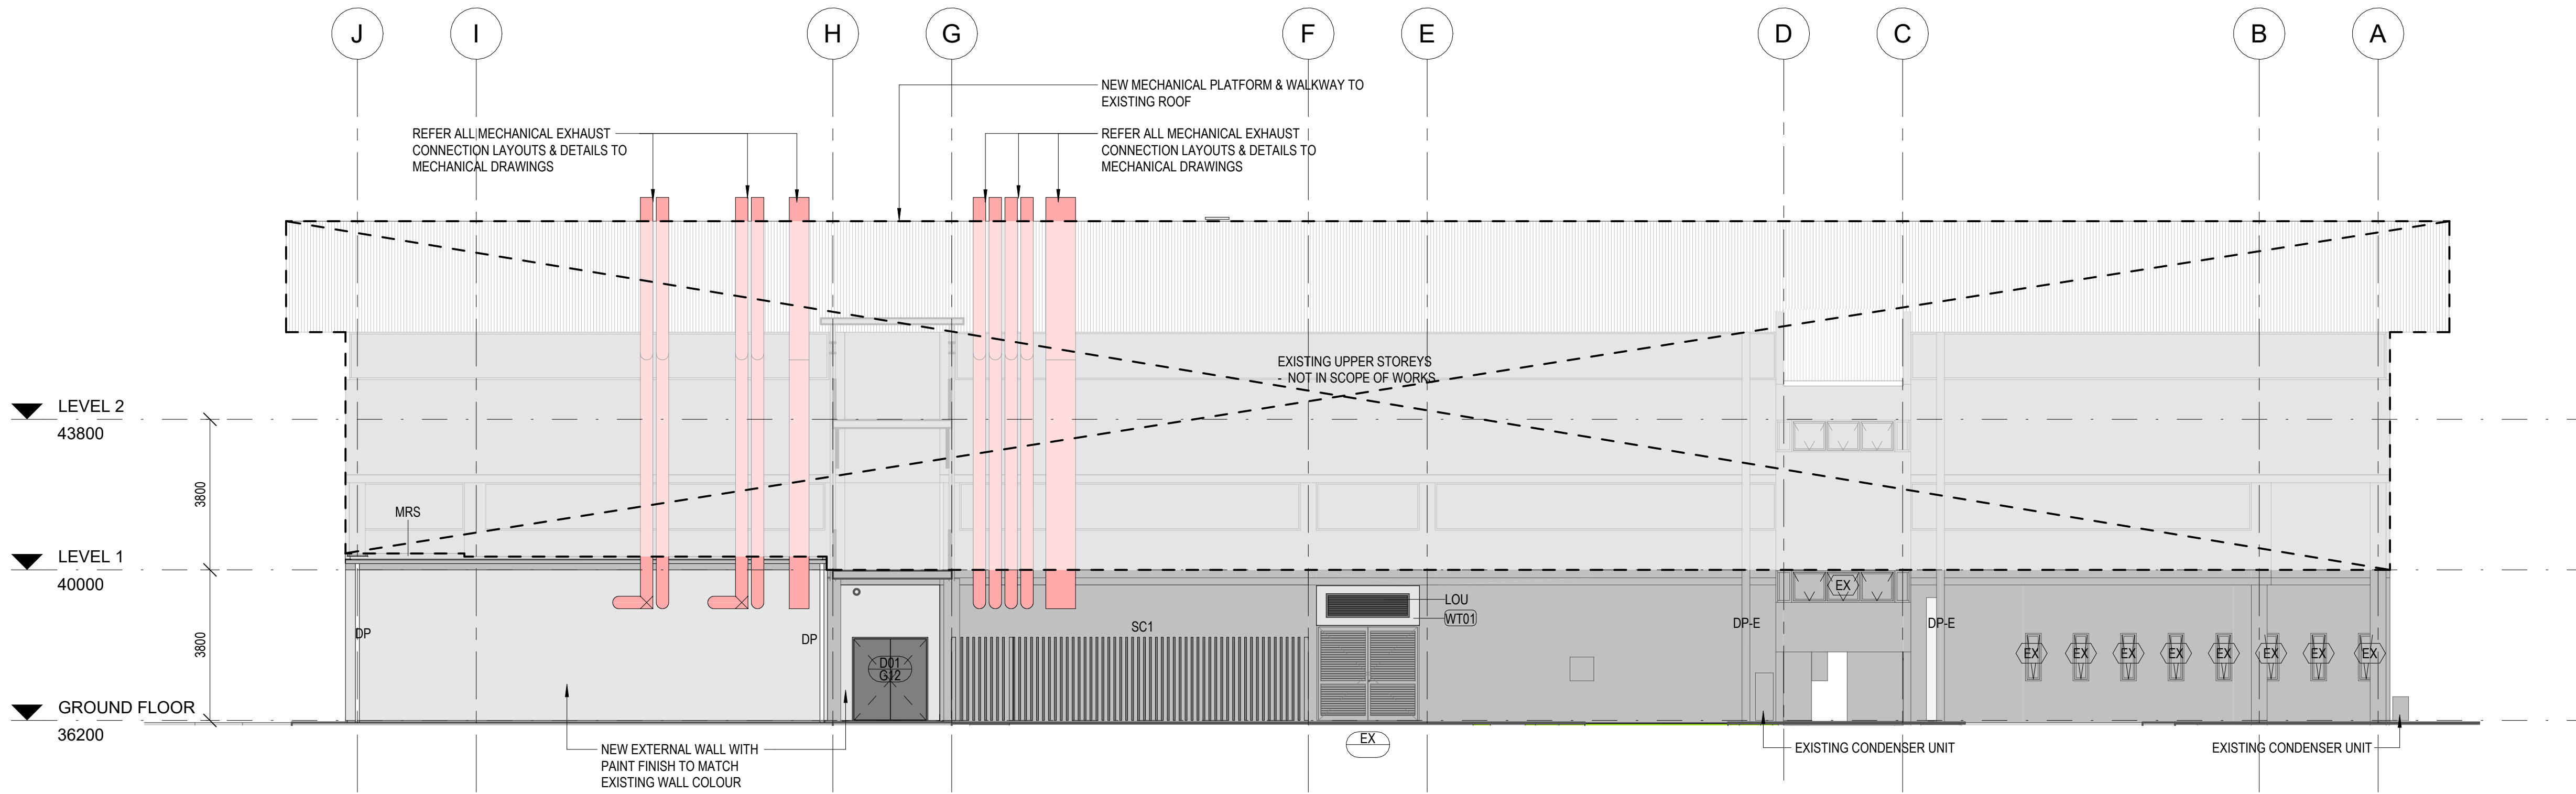

1 NORTH ELEVATION - GROUND FLOOR
1 : 100

NOTE:
- BUILDER TO ENSURE ALL EXISTING EXTERNAL WINDOWS ON GROUND FLOOR ARE NOT OPERABLE

LEGEND	
DP	DOWNPIPE
DP-E	DOWNPIPE - EXISTING
EX	EXISTING
LOU	MECHANICAL LOUVRE
MRS	METAL ROOF SHEETING
SC1	ALUMINIUM BATTEN SCREEN TYPE 1

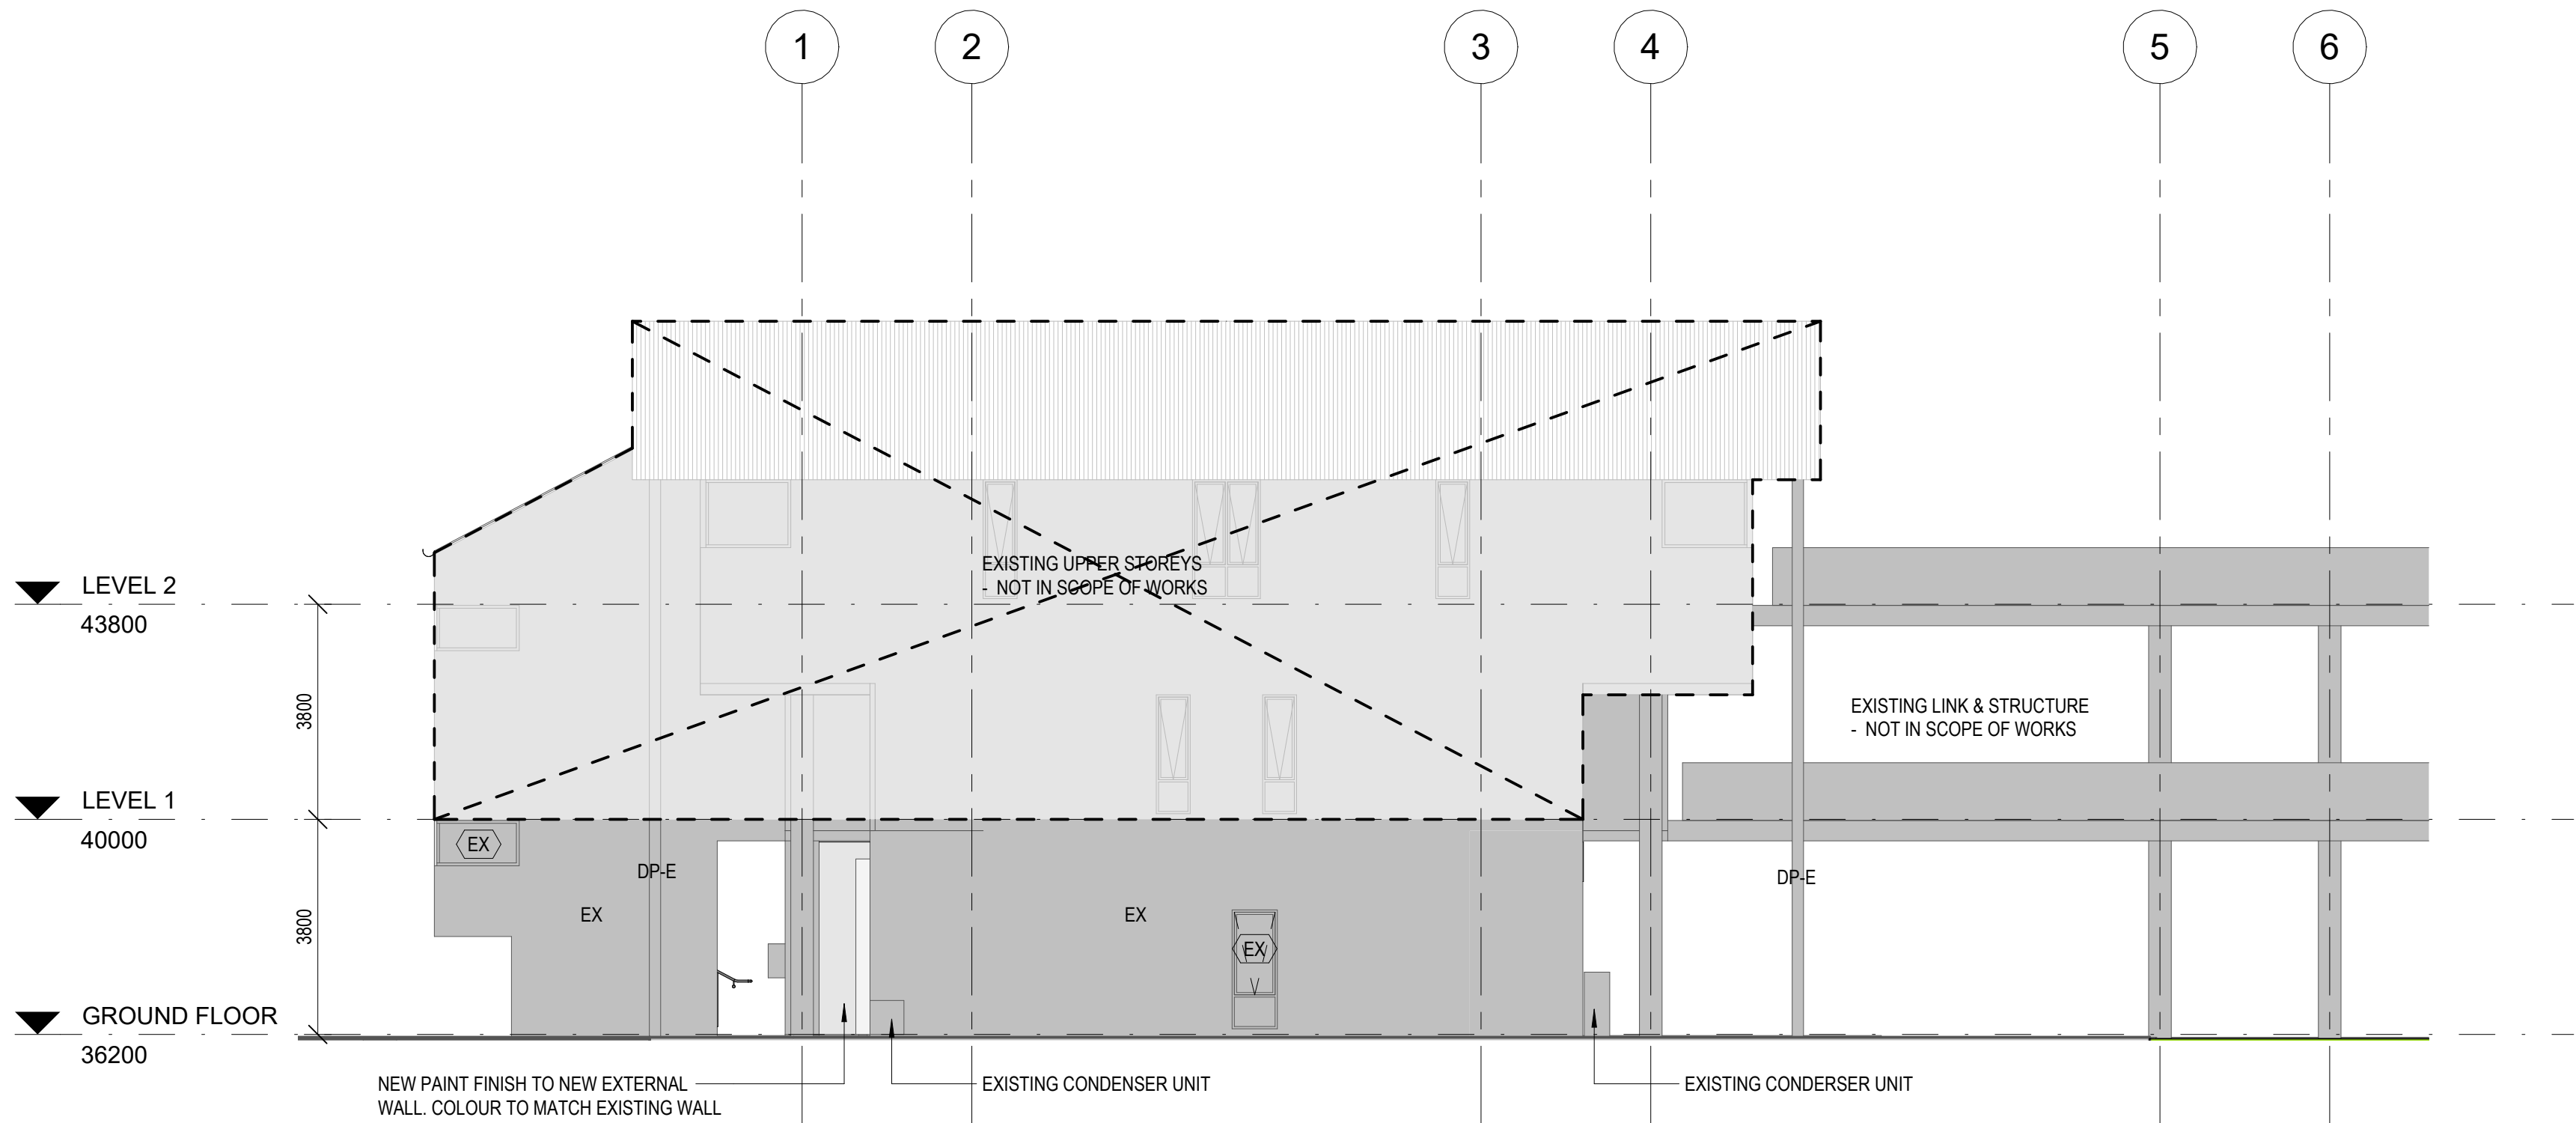

2 WEST ELEVATION - GROUND FLOOR
1 : 100

AS CONSTRUCTED

BUILDING 33 REDEVELOPMENT

554/700 YAAMBA ROAD,
NORMAN GARDENS QLD 4701

for
CQUUniversity
NORTH ROCKHAMPTON CAMPUS
& GIRVAN



GIRVAN

B	25/06/2024	AS CONSTRUCTED	PB
A	02/02/2024	IFC	PB
5	06/11/2023	REVISED ISSUE	AP
4	20/09/2023	ISSUE FOR INFORMATION	WL
3	11/09/2023	AMENDED 60% DD ISSUE	PB
2	28/08/2023	60% DD ISSUE	WL
1	04/08/2023	PRELIMINARY ISSUE	WL

rev	date	details	init
-----	------	---------	------

drawn	date
WL	AUG 2023
checked	date
NC	AUG 2023
verified	date
GK	DEC 2023


scale	1 : 100 @ A1
-------	--------------

BUILDING SECTIONS


scale	project no.
1 : 100 @ A1	23.0078.17

sheet no.
CQU-ROK-033-GN-ARC-31-00


revision
B

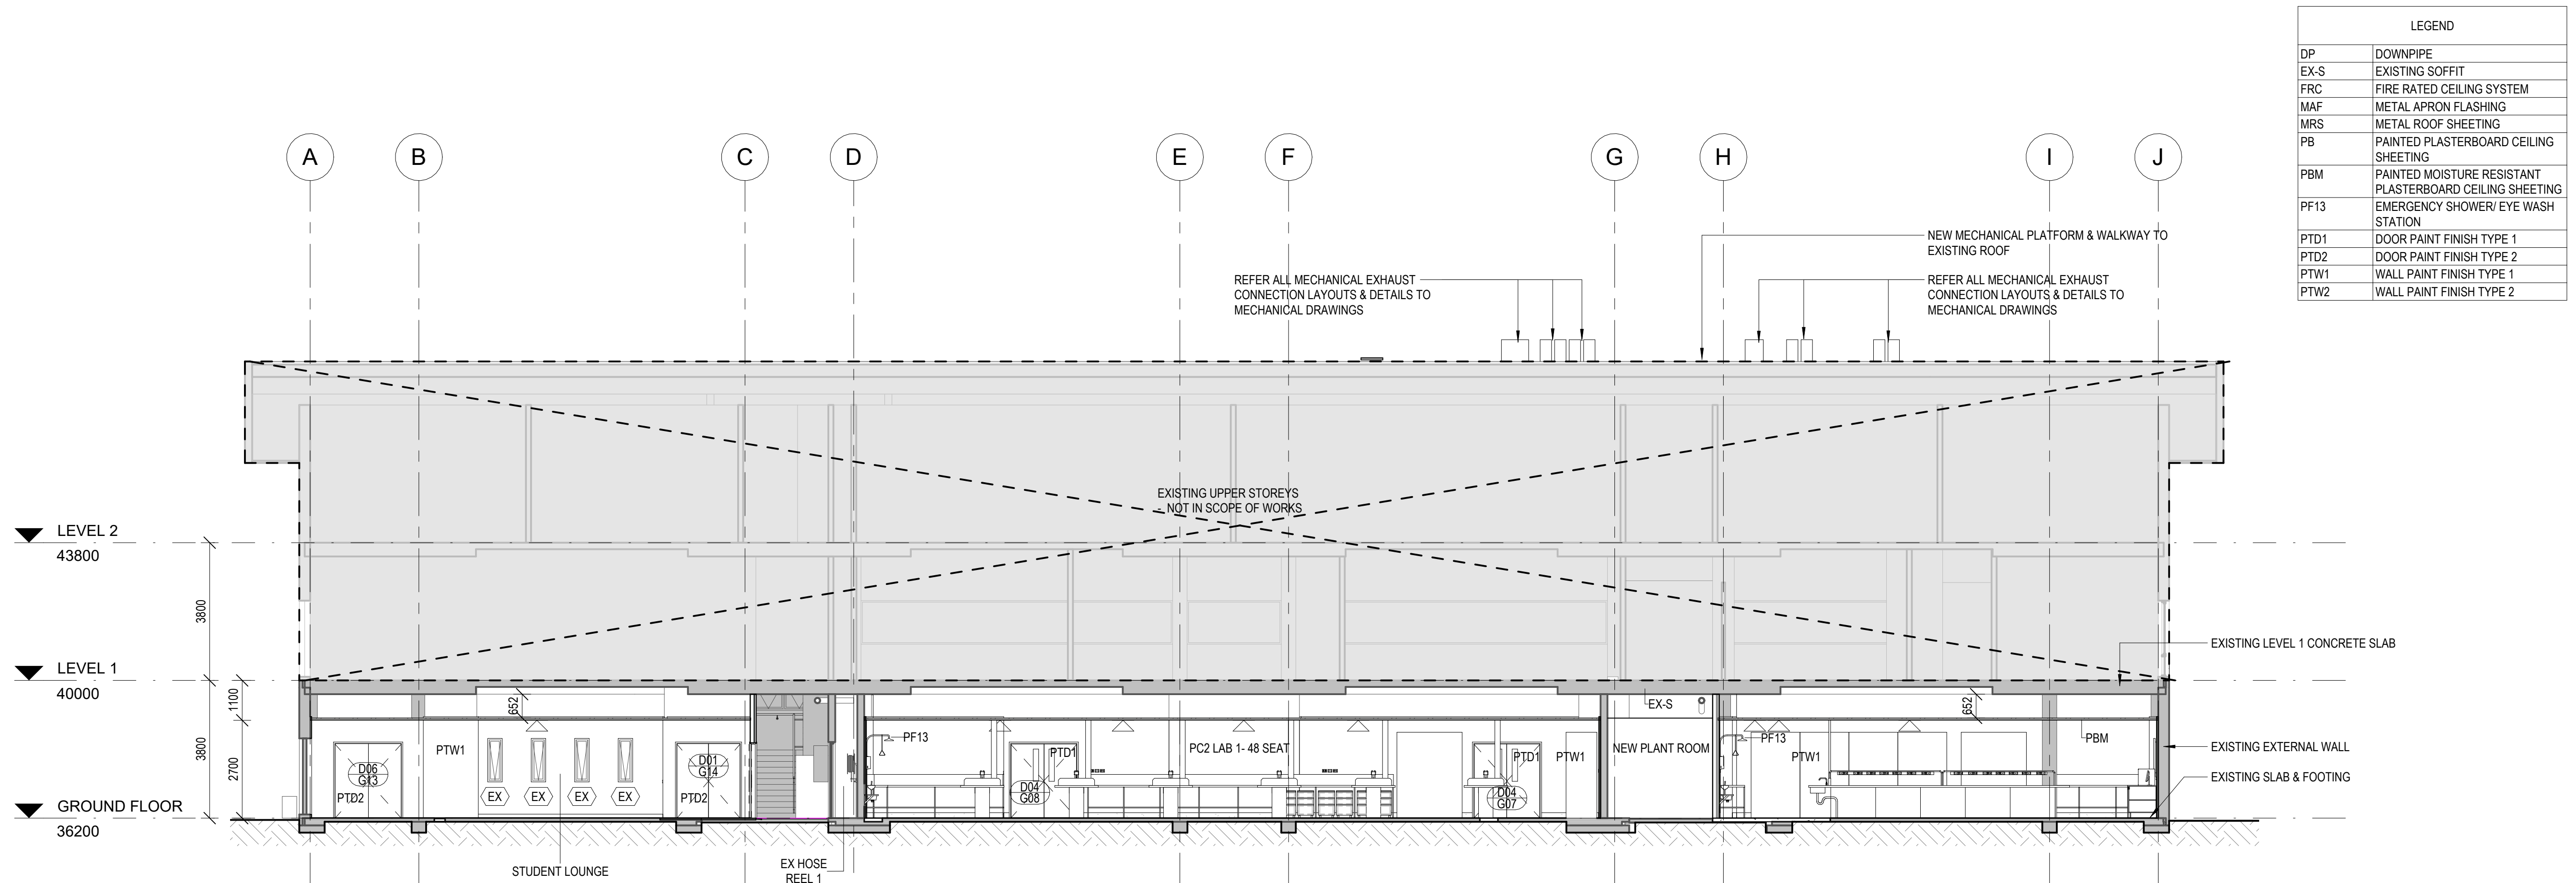

1 LONG SECTION
1 : 100

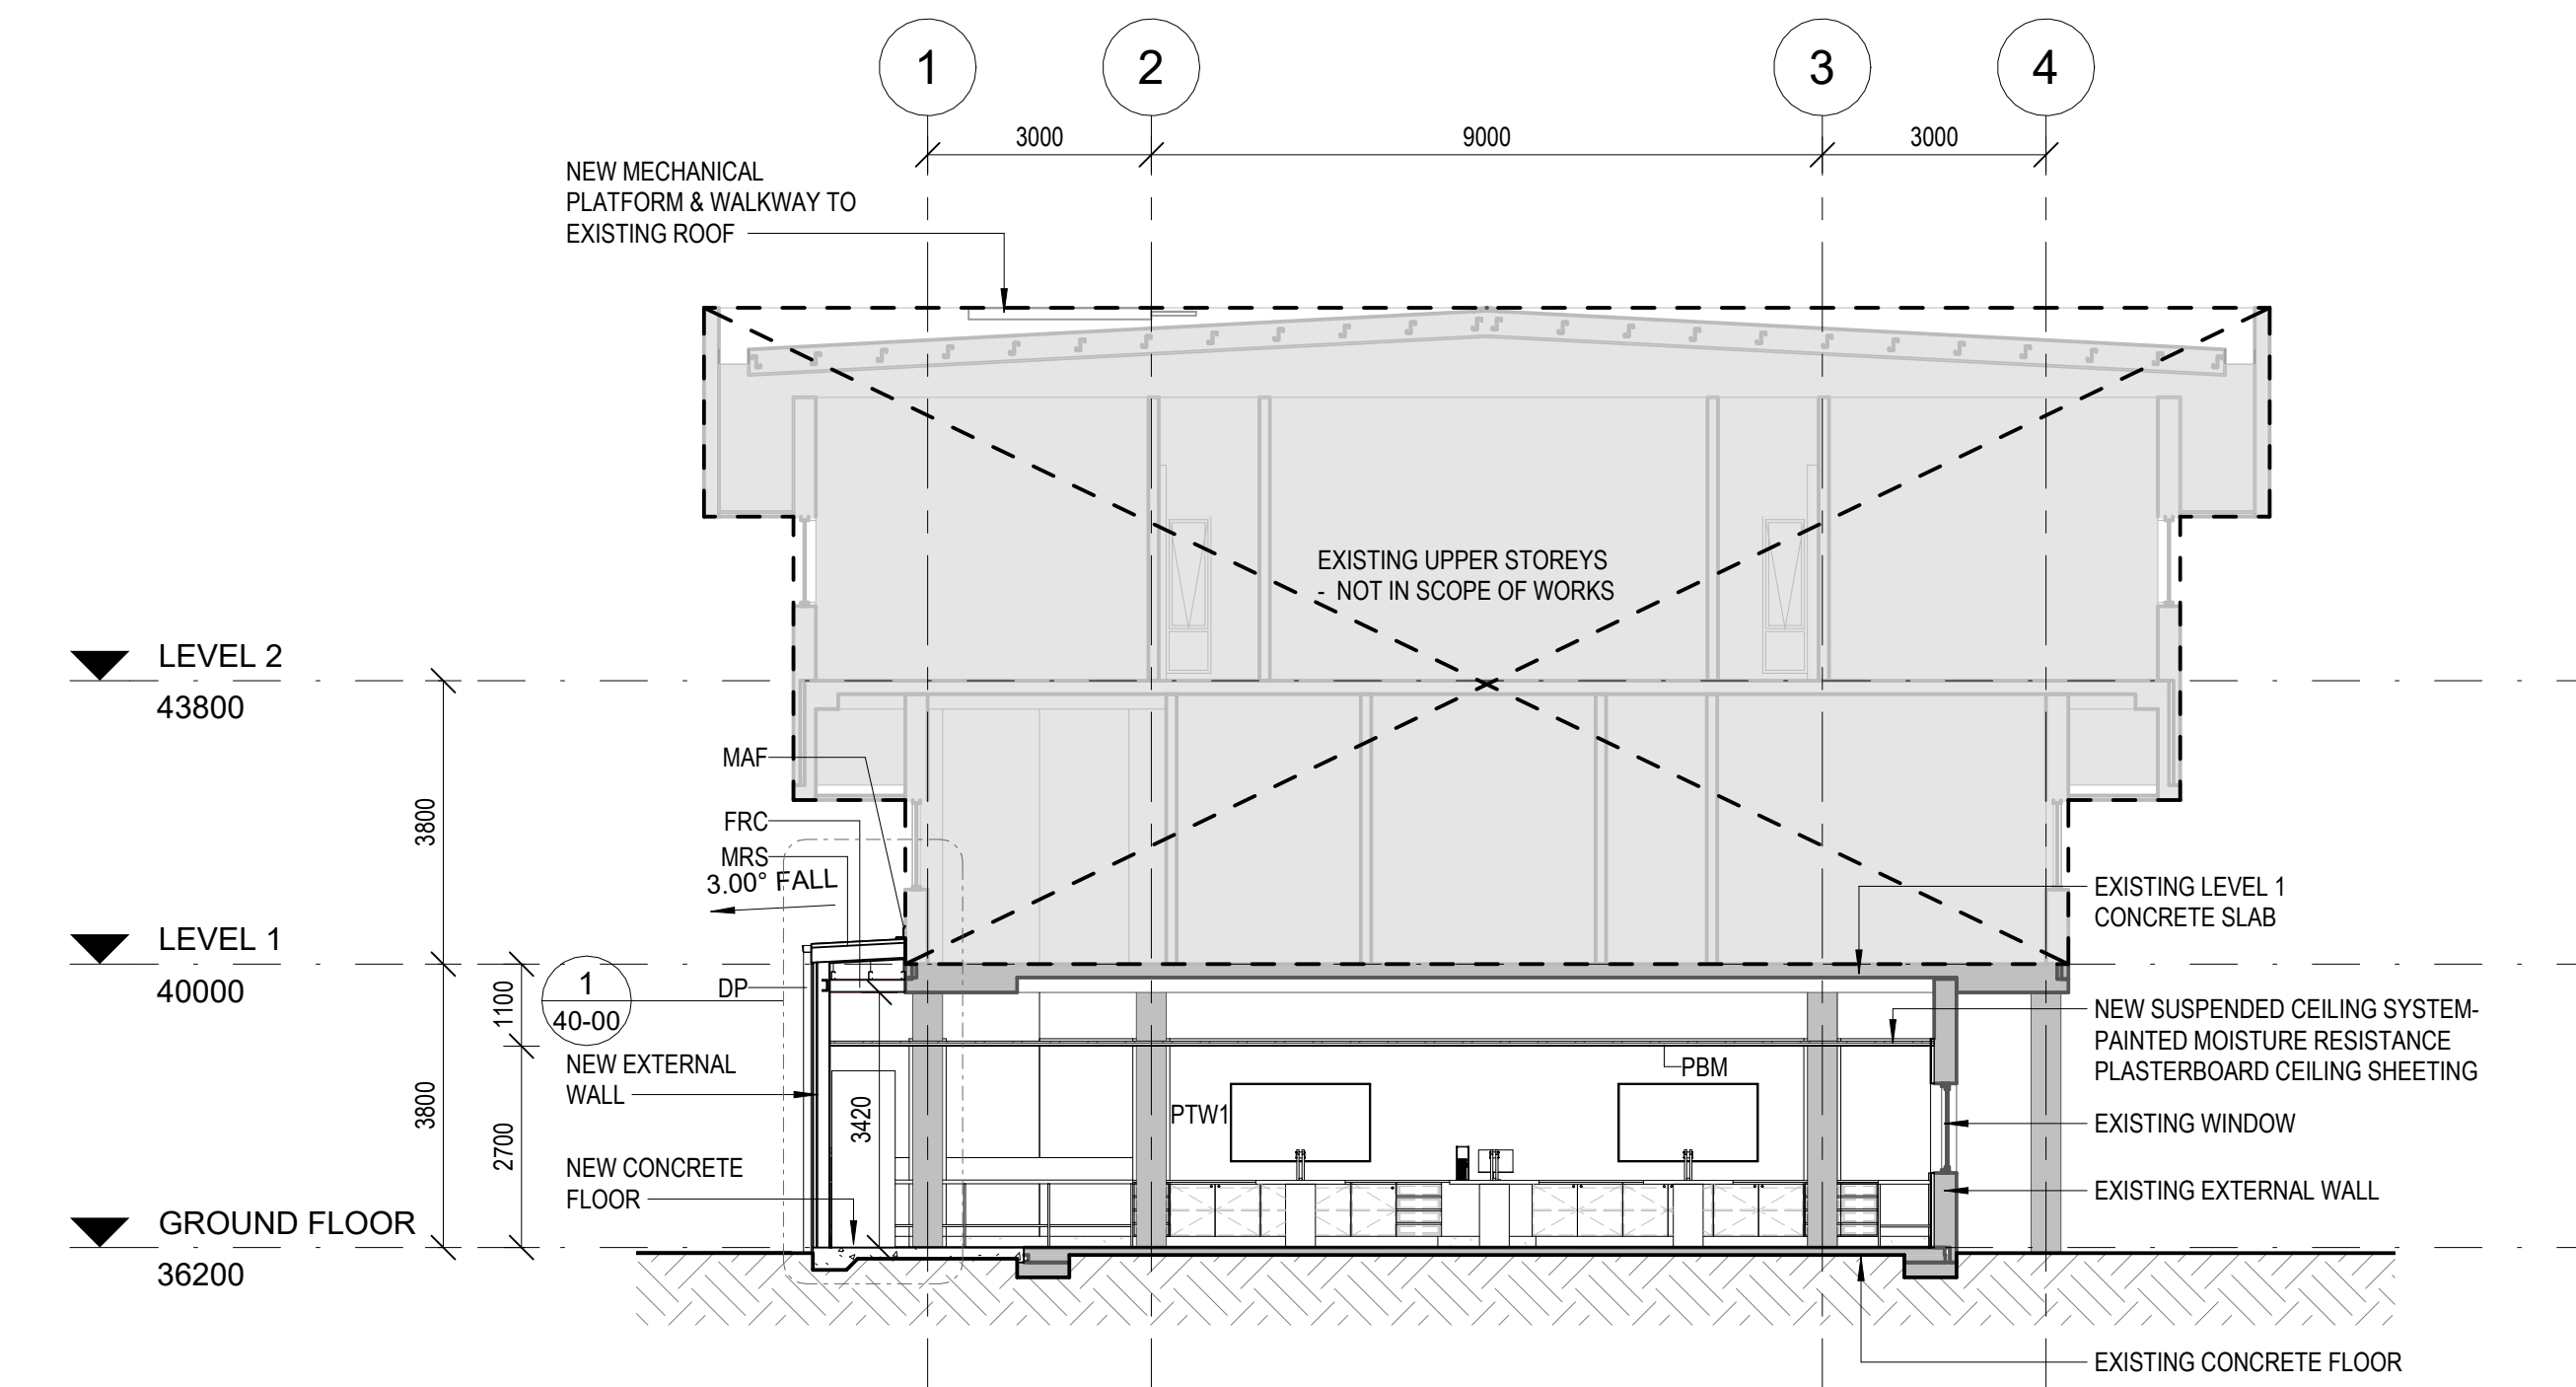

2 CROSS SECTION
1 : 100

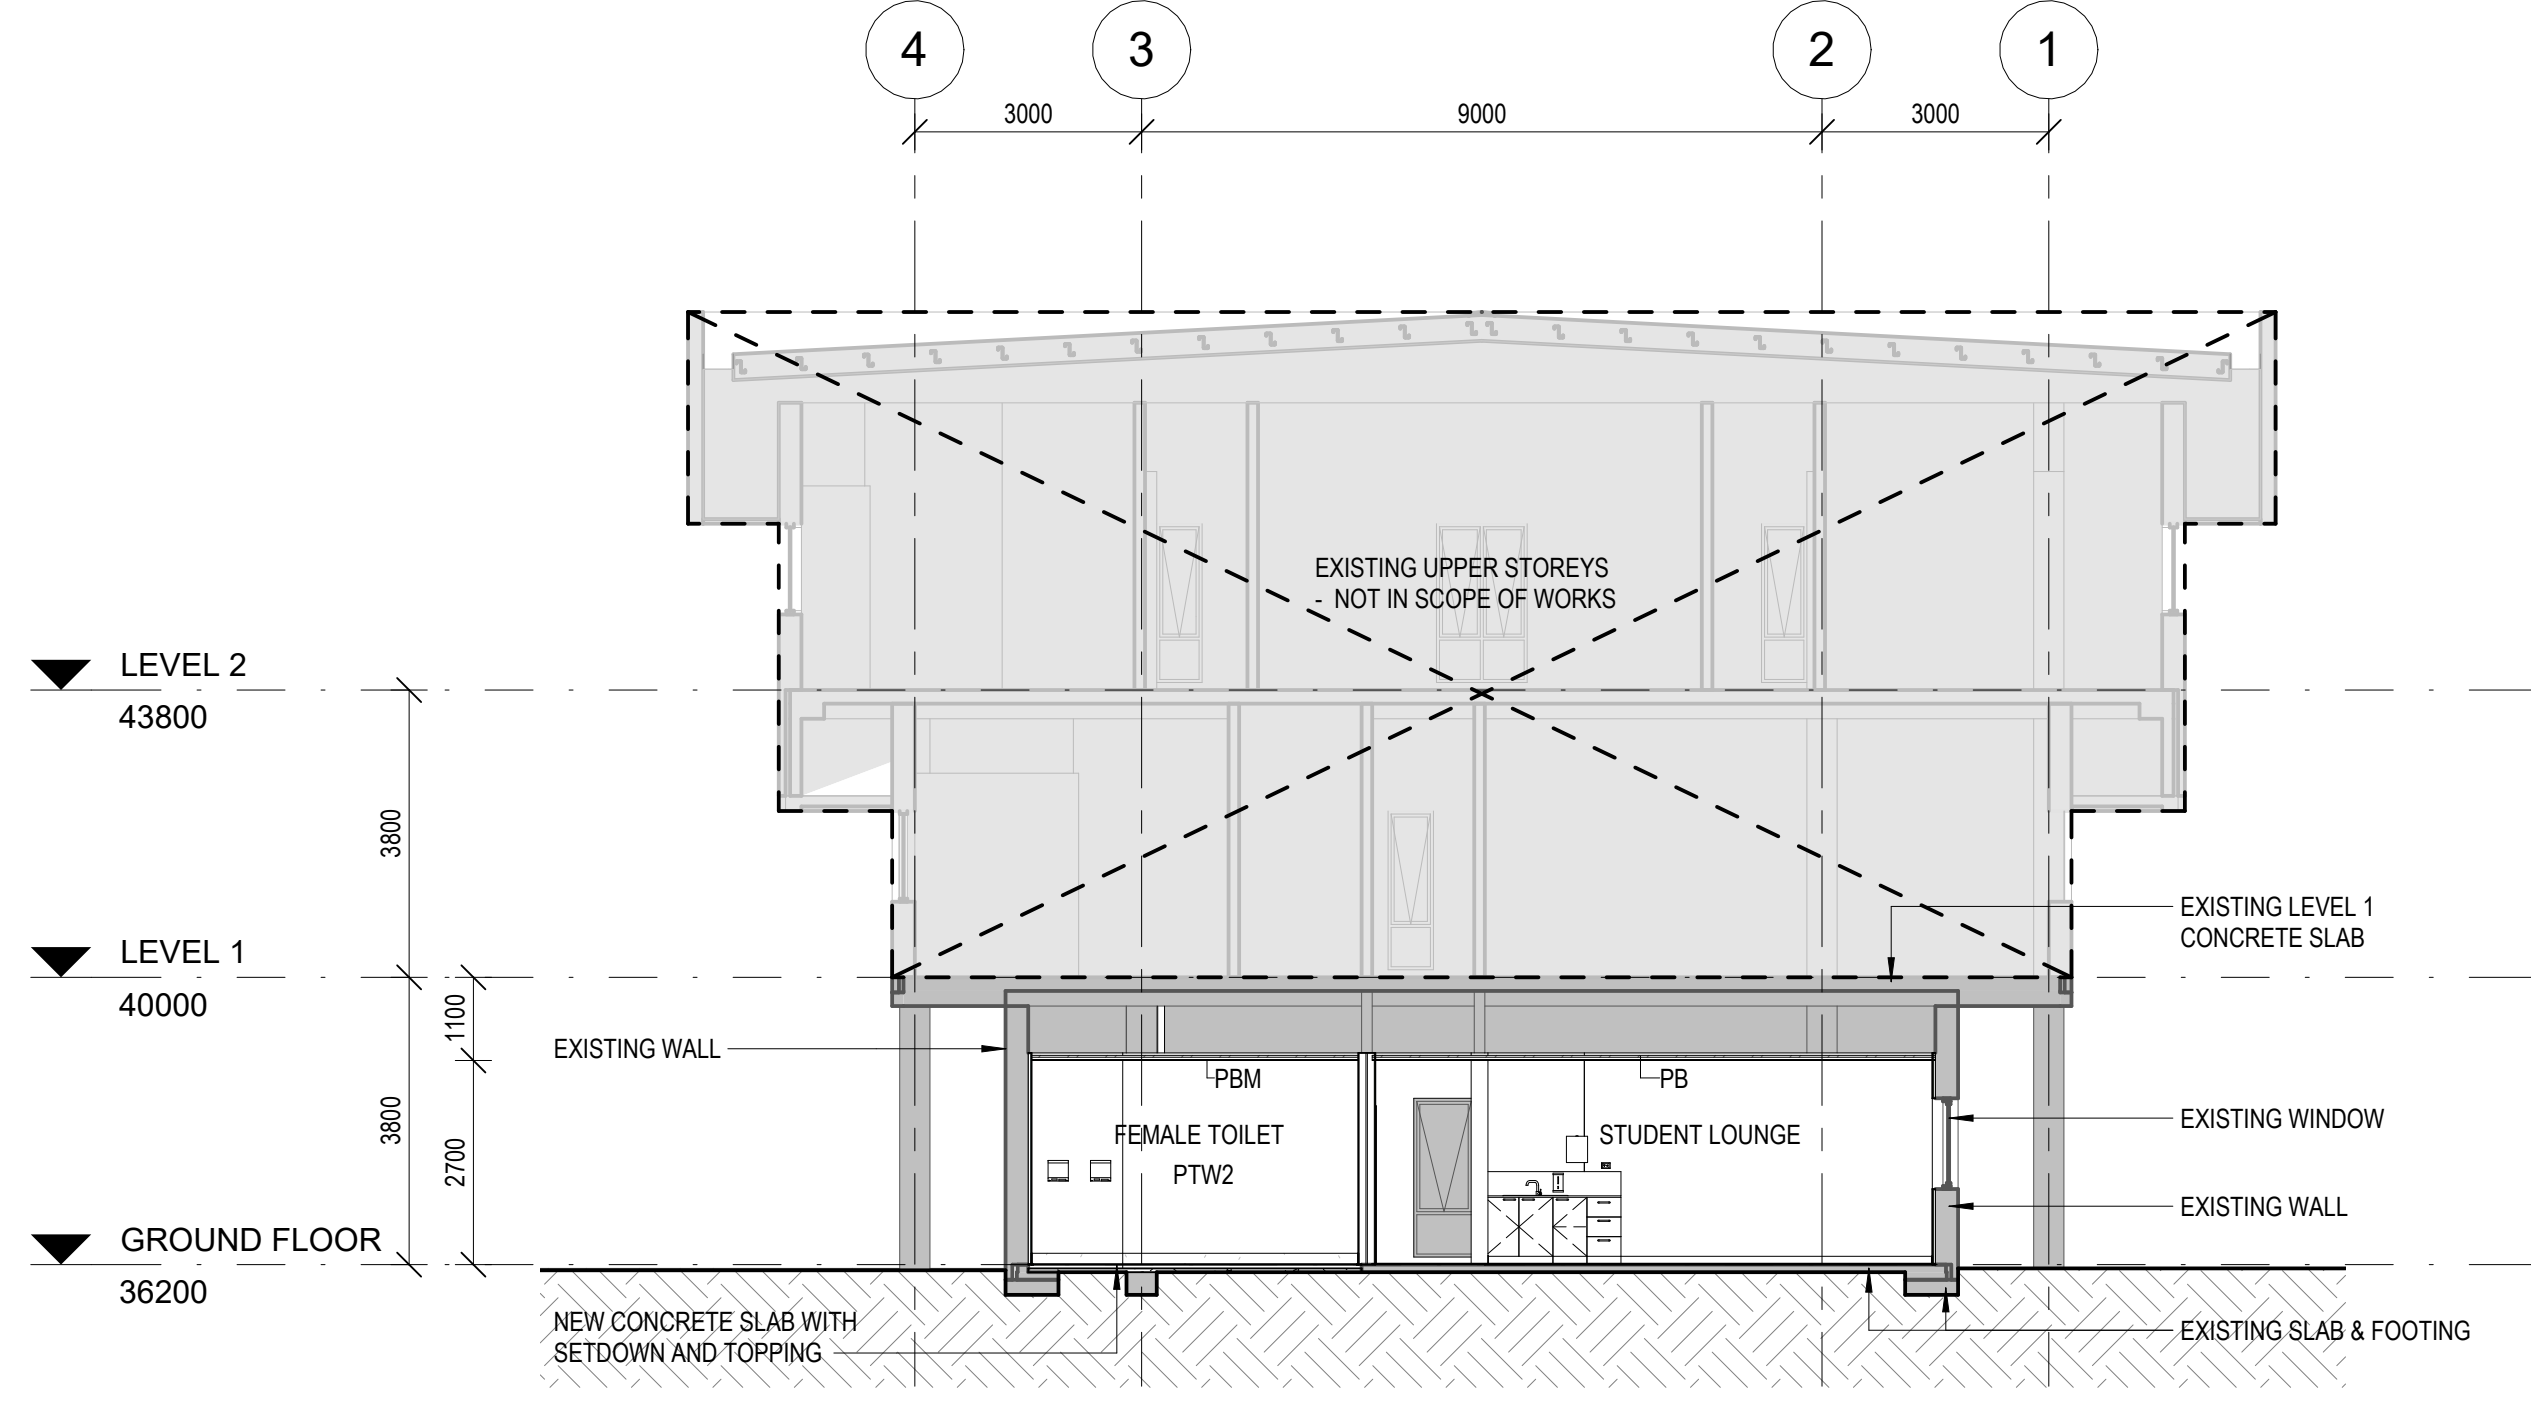

3 CROSS SECTION 2
1 : 100

AS CONSTRUCTED

BUILDING 33
REDEVELOPMENT

554/700 YAAMBA ROAD,
NORMAN GARDENS QLD 4701

for
CQUUniversity
NORTH ROCKHAMPTON CAMPUS
& GIRVAN



B	25/06/2024	AS CONSTRUCTED	PB
A	02/02/2024	IFC	PB
1	20/09/2023	ISSUE FOR INFORMATION	WL
rev/	date	details	init

drawn	date
WL	SEP 2023
checked	date
NC	SEP 2023
verified	date
GK	DEC 2023




CONSTRUCTION DETAILS -
SHEET 1


scale project no.
1 : 20 @ A1 23.0078.17

sheet no.
CQU-ROK-033-GN-ARC-40-00

revision
B

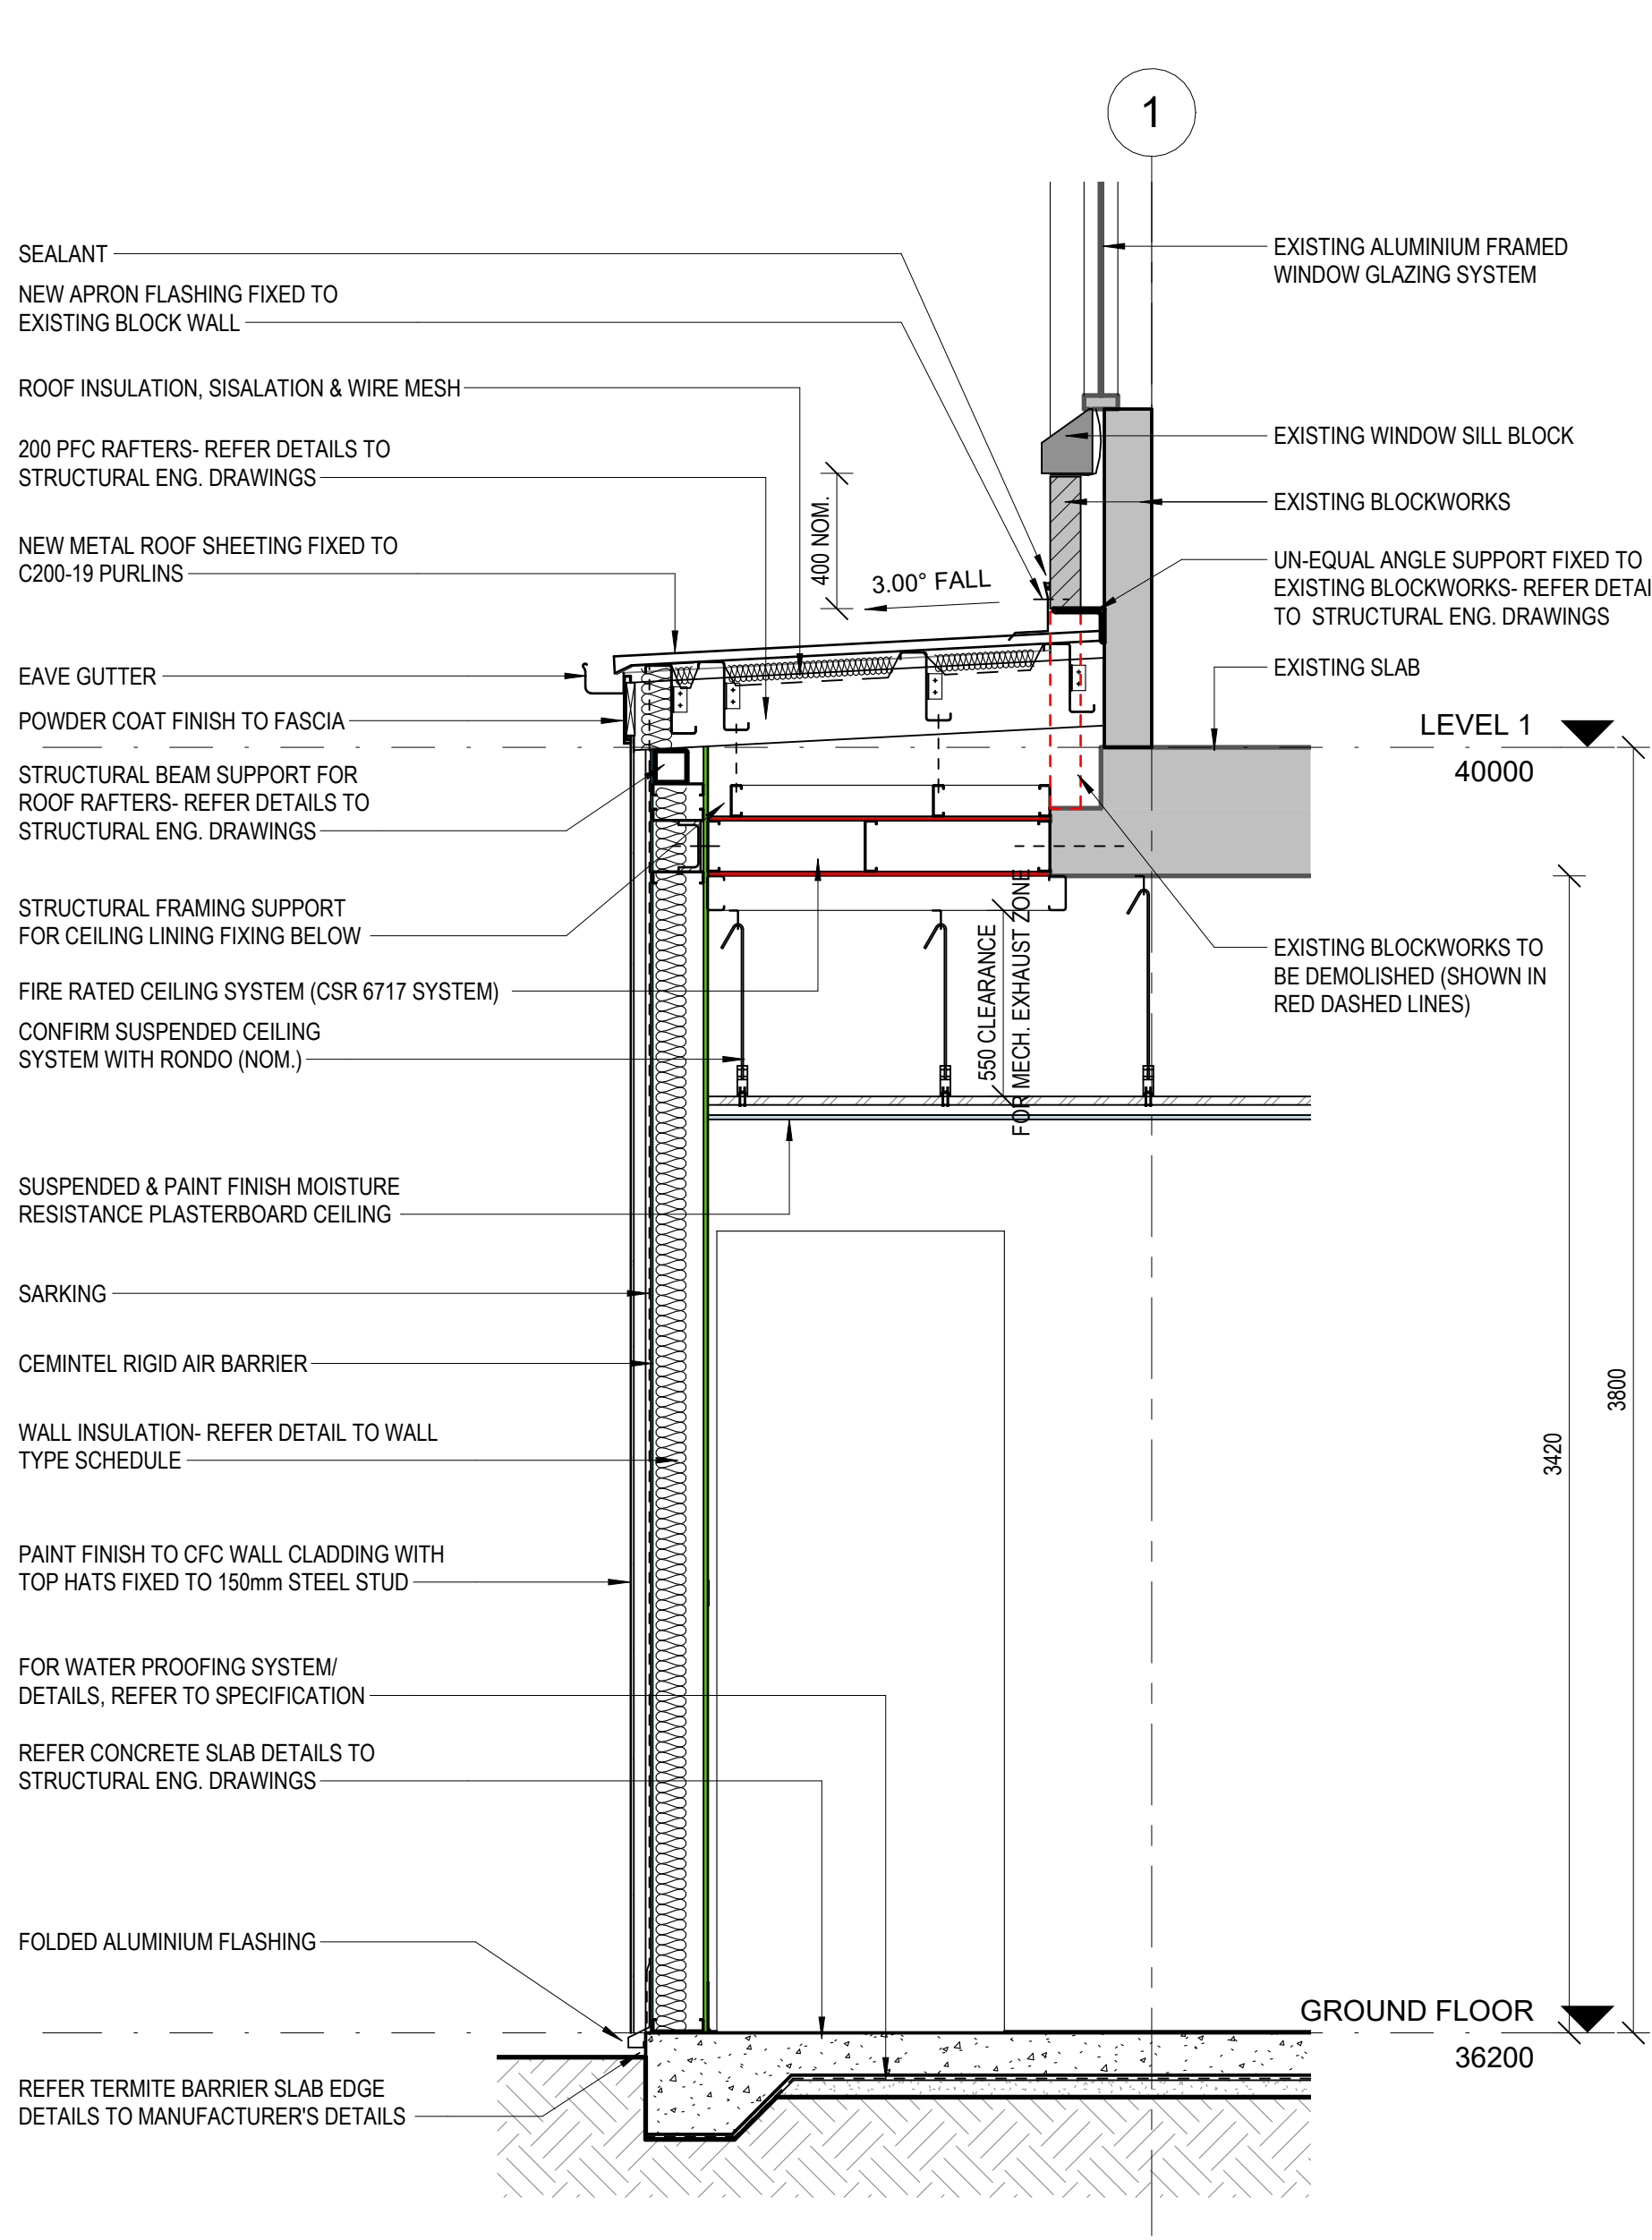


1 WALL & ROOF SECTION DETAIL 1
1 : 20

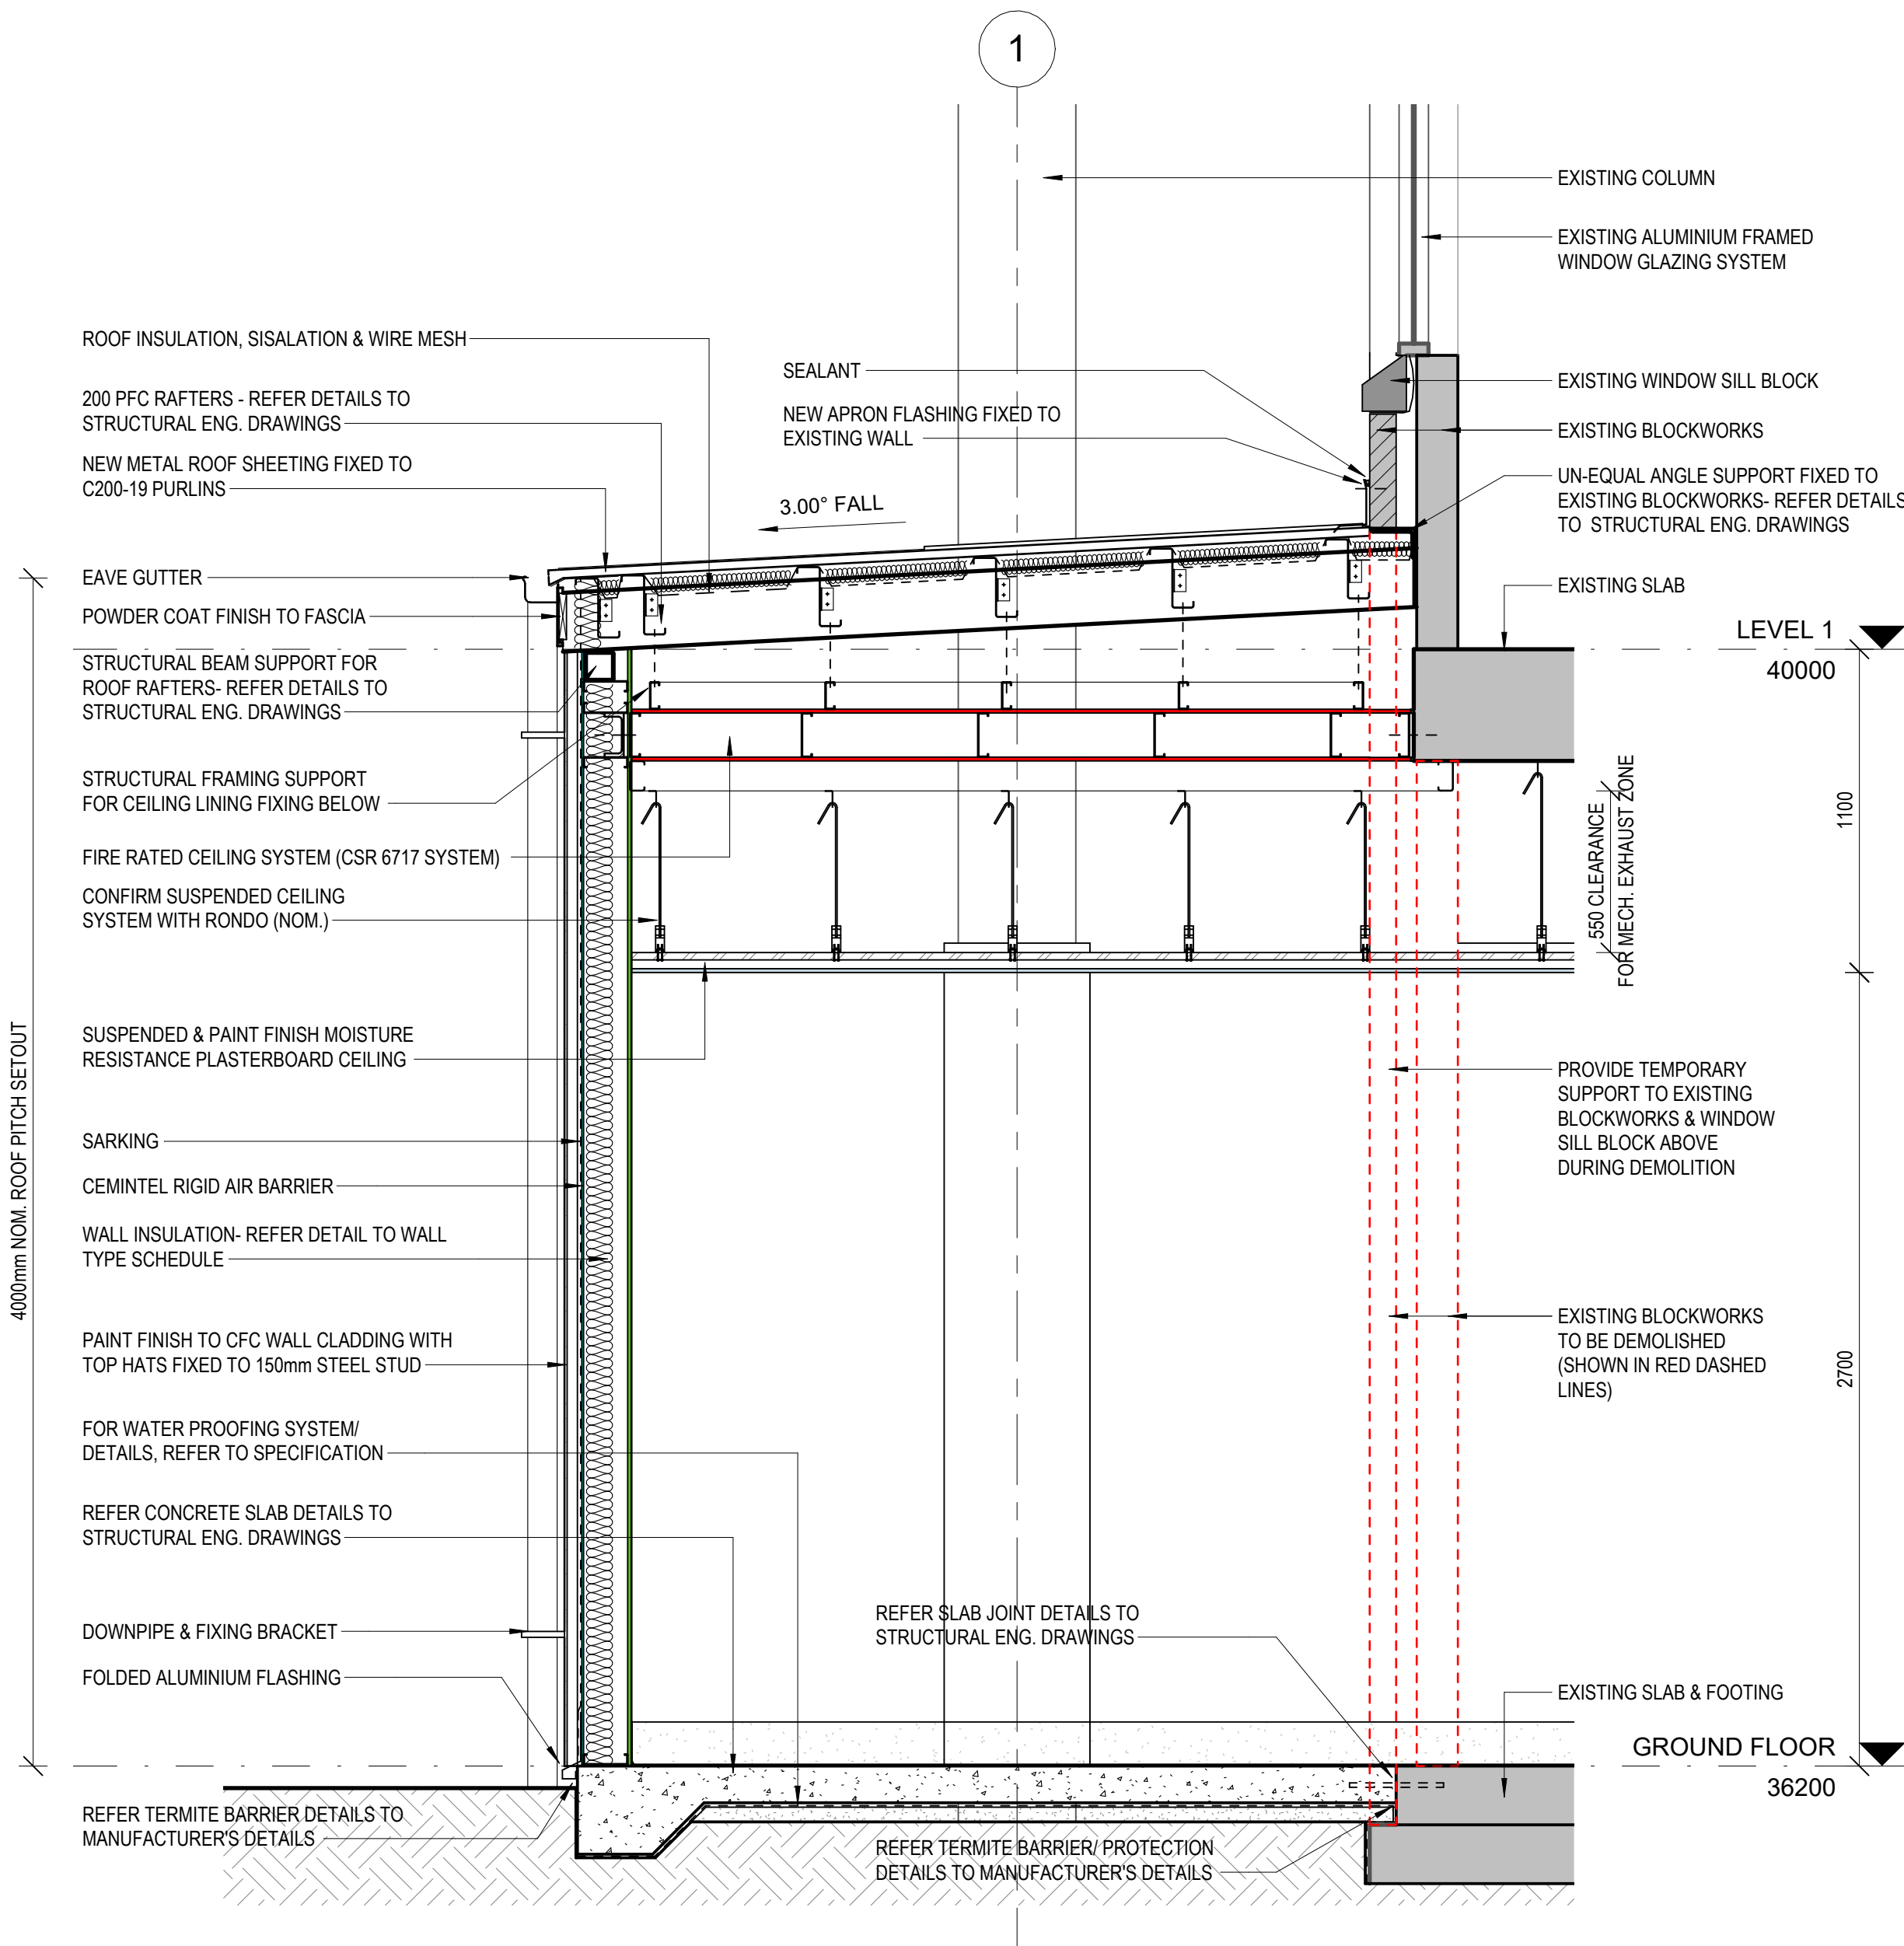


2 WALL & ROOF SECTION DETAIL 2
1 : 20


AS CONSTRUCTED

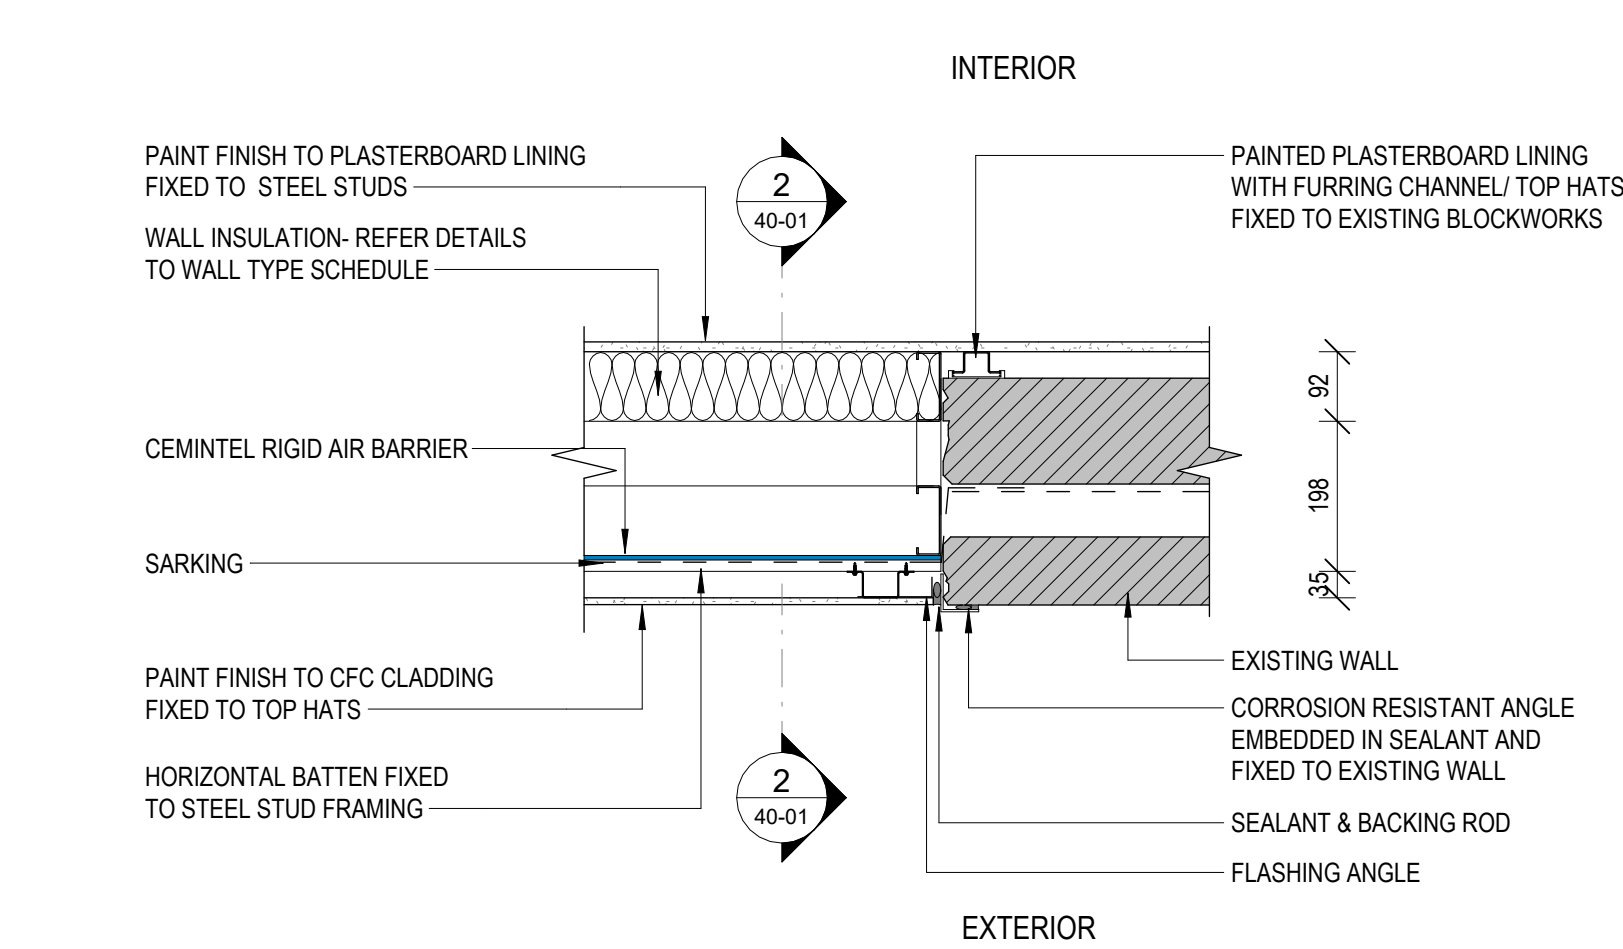


1
21-10
TYPICAL EXTERNAL WALL DETAIL PLAN
1 : 10

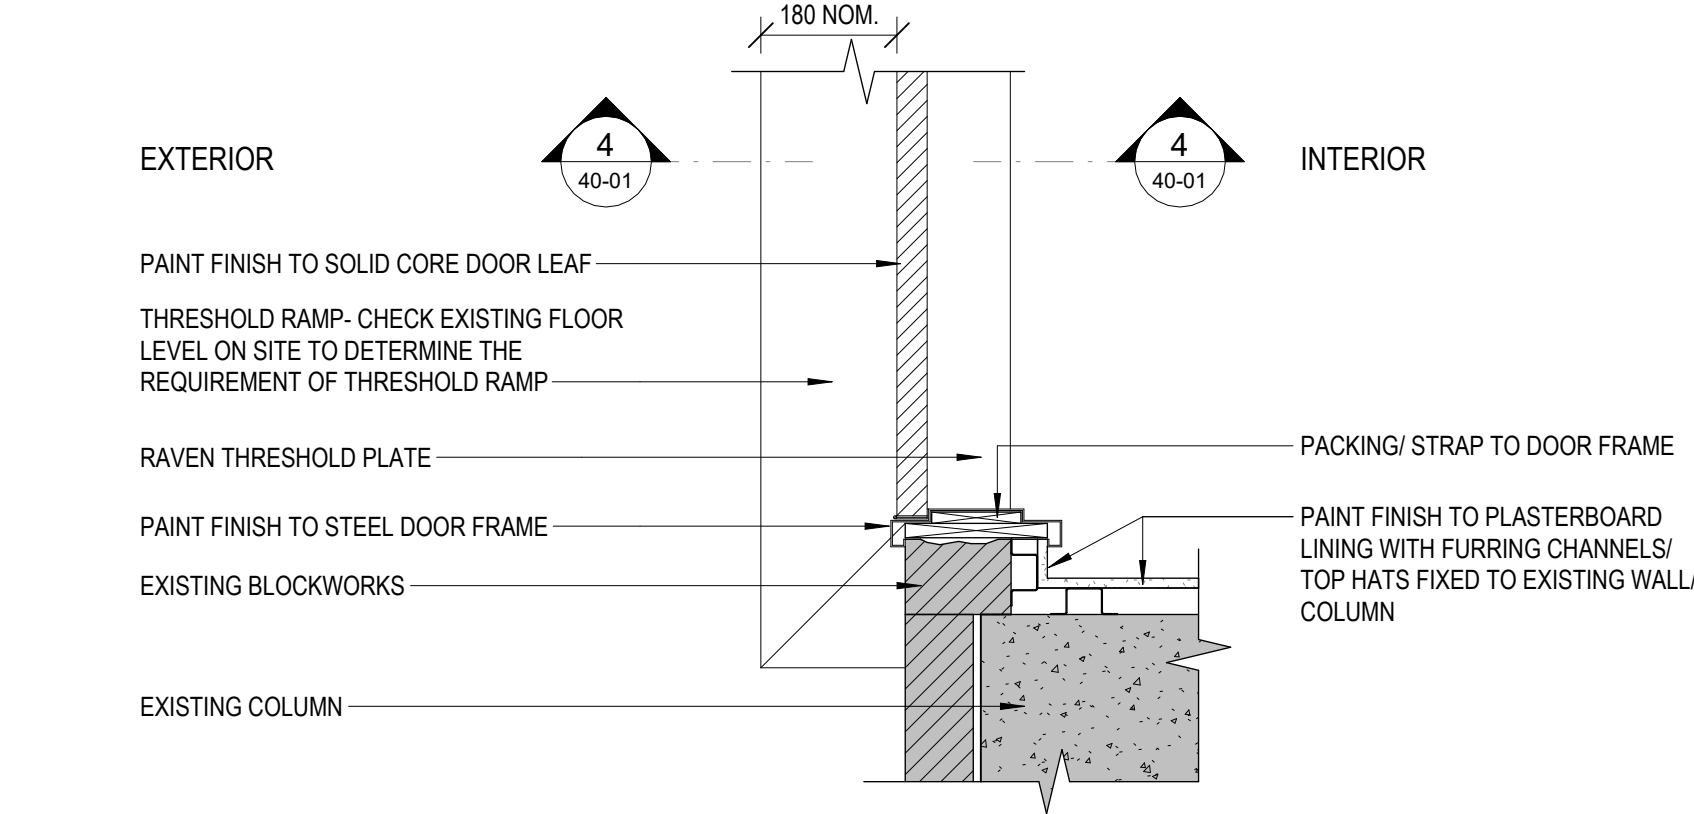


3
EXTERNAL BLOCKWORK WALL DETAIL PLAN
1 : 10

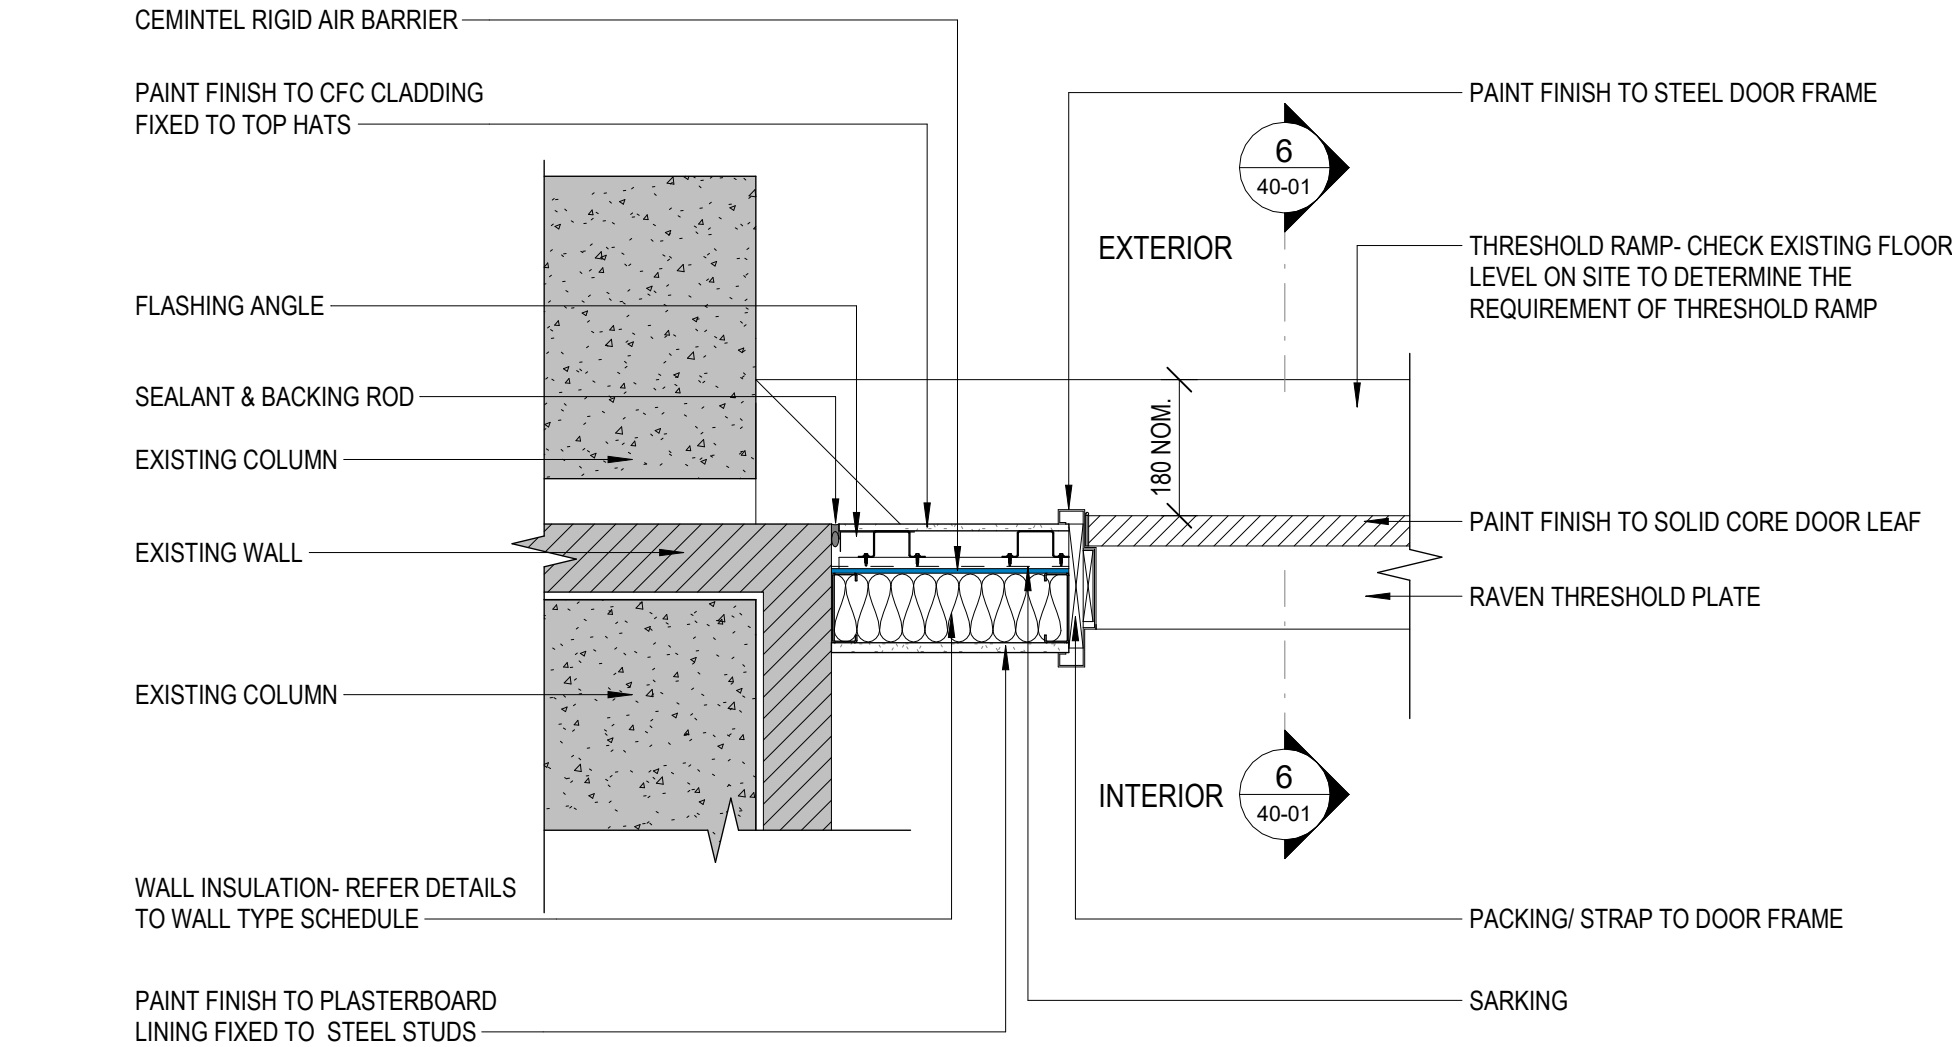


5
21-10
EXTERNAL LIGHT WEIGHT WALL DETAIL PLAN
1 : 10

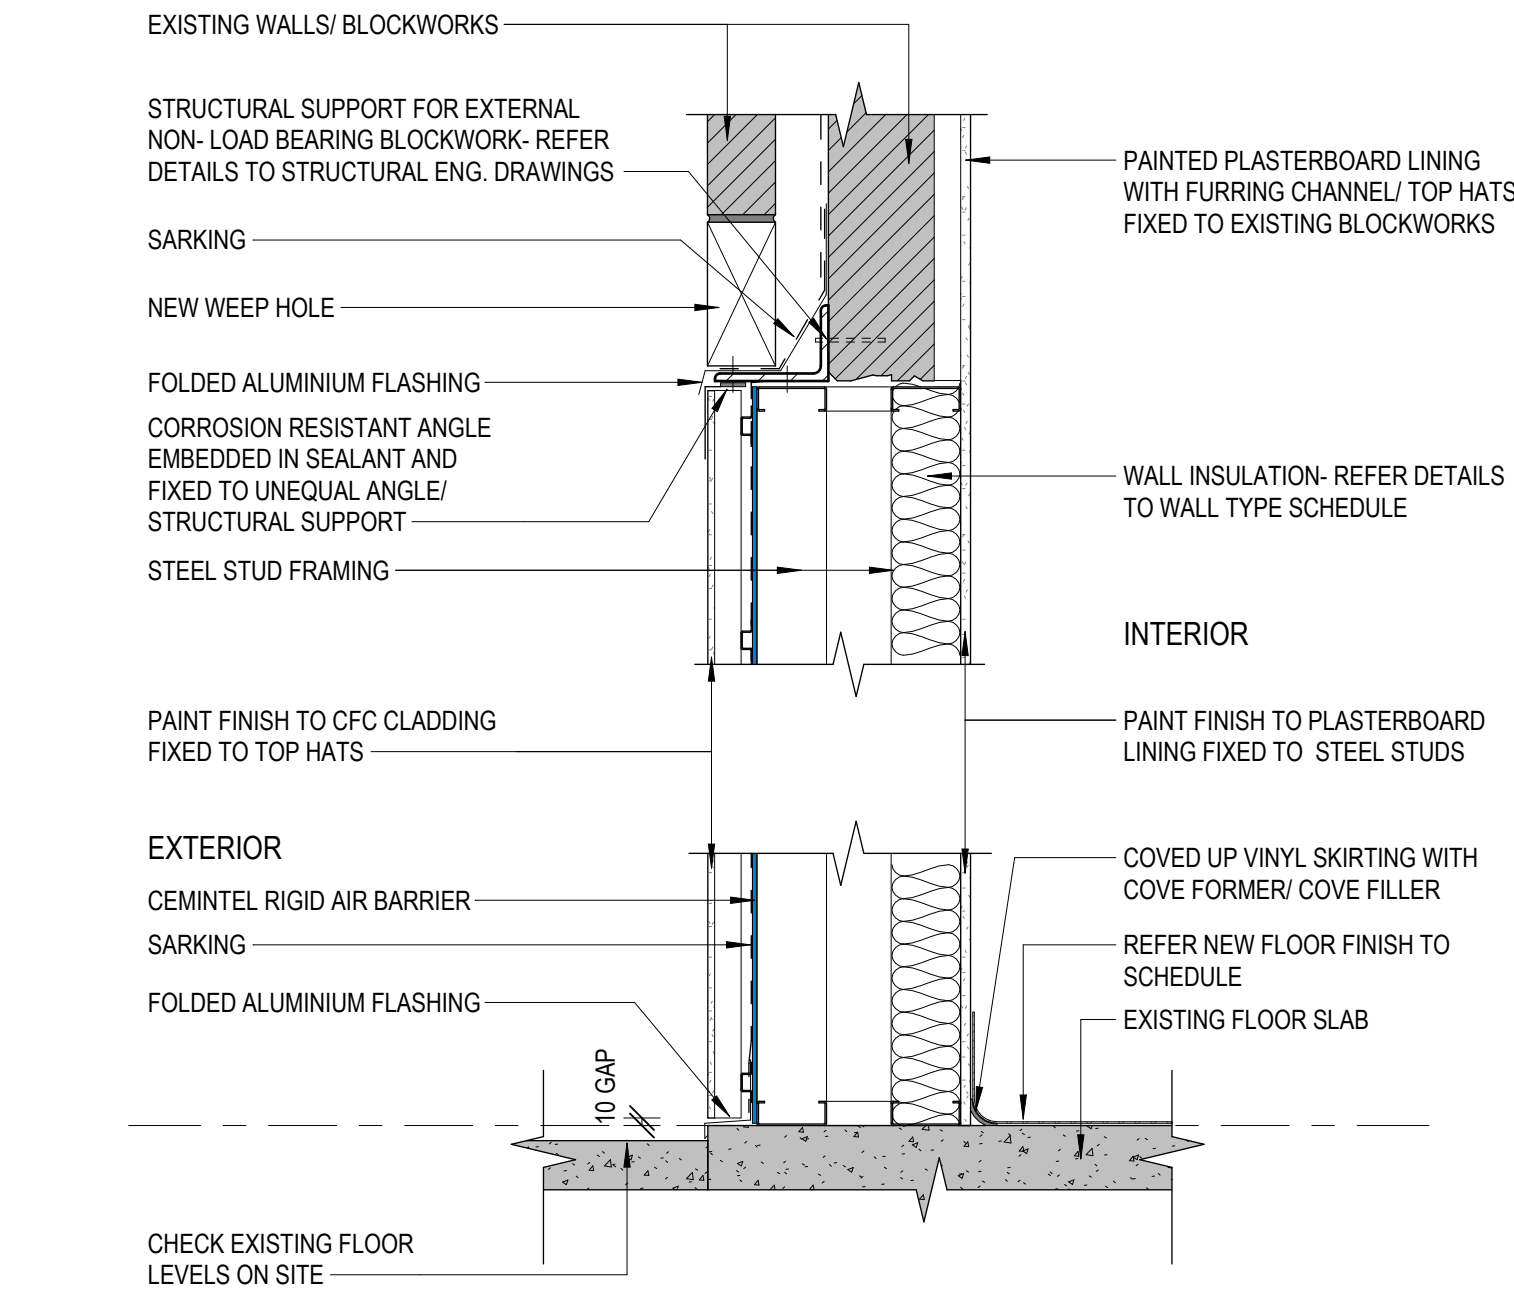

2
40-01
TYPICAL EXTERNAL WALL DETAIL SECTION
1 : 10

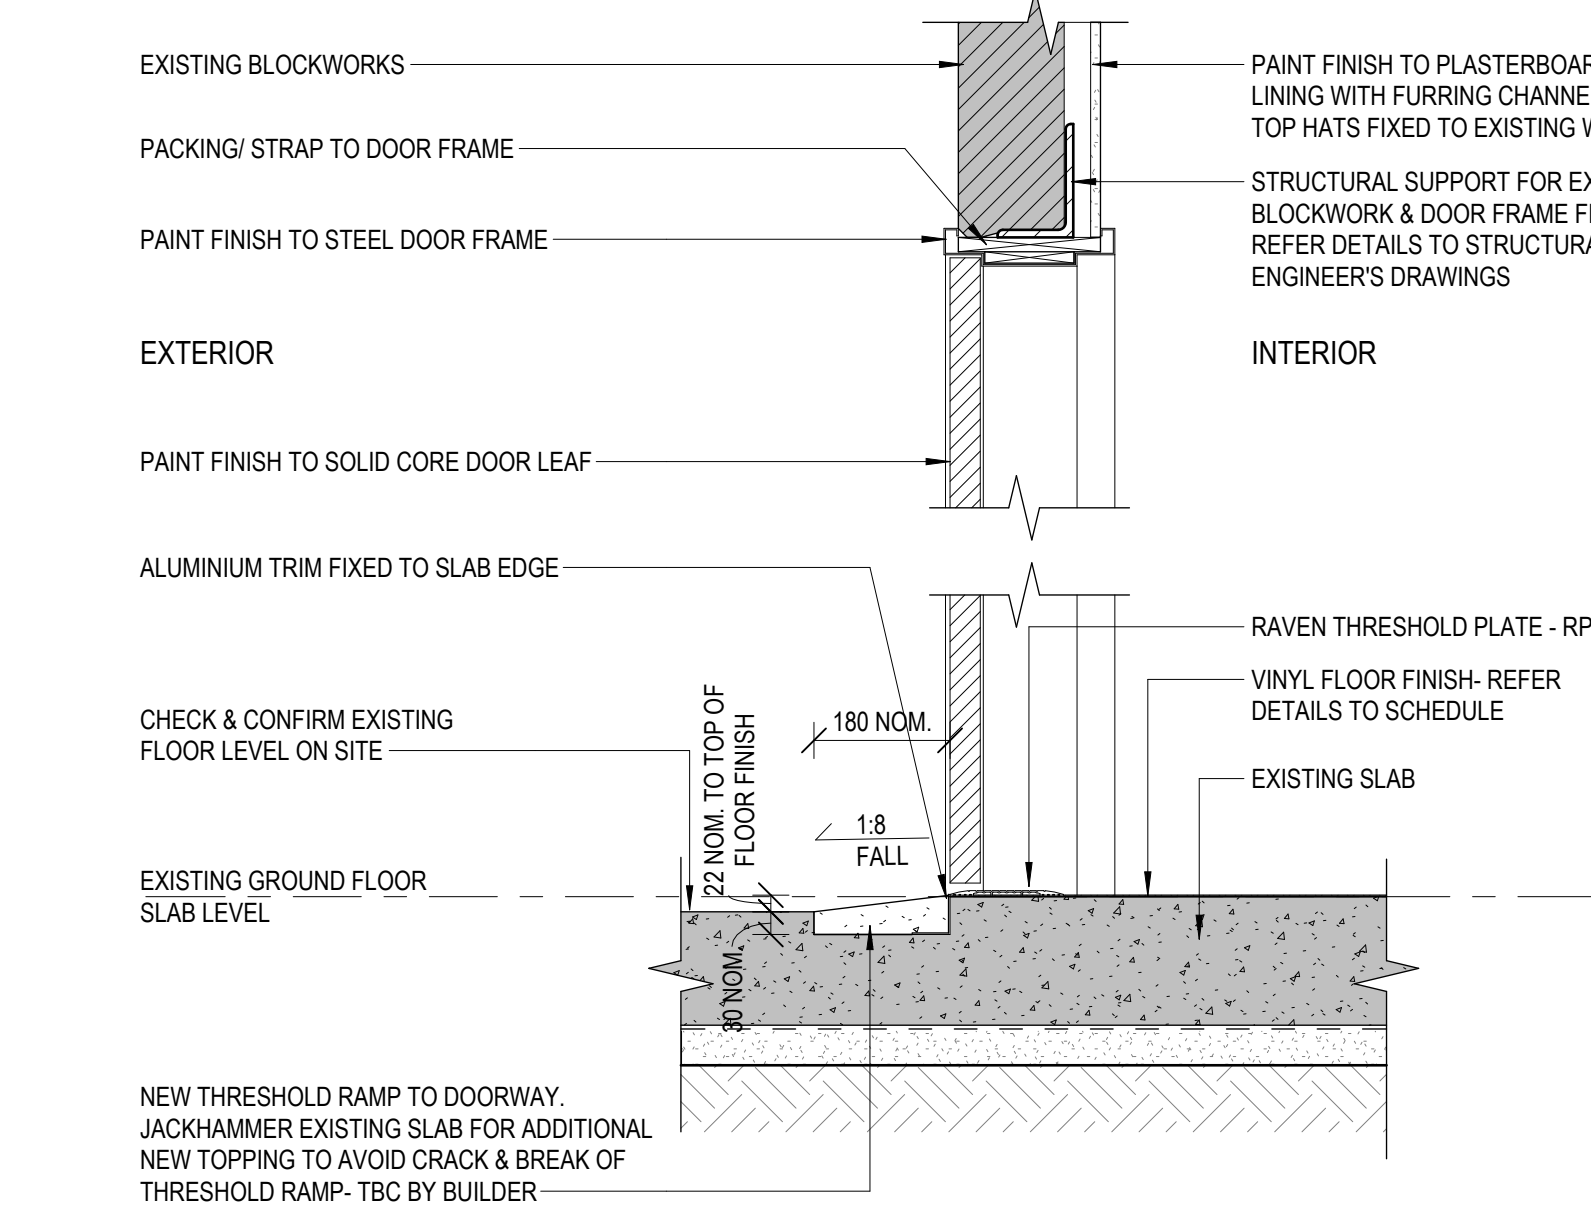

4
40-01
EXTERNAL BLOCKWORK WALL DETAIL SECTION
1 : 10

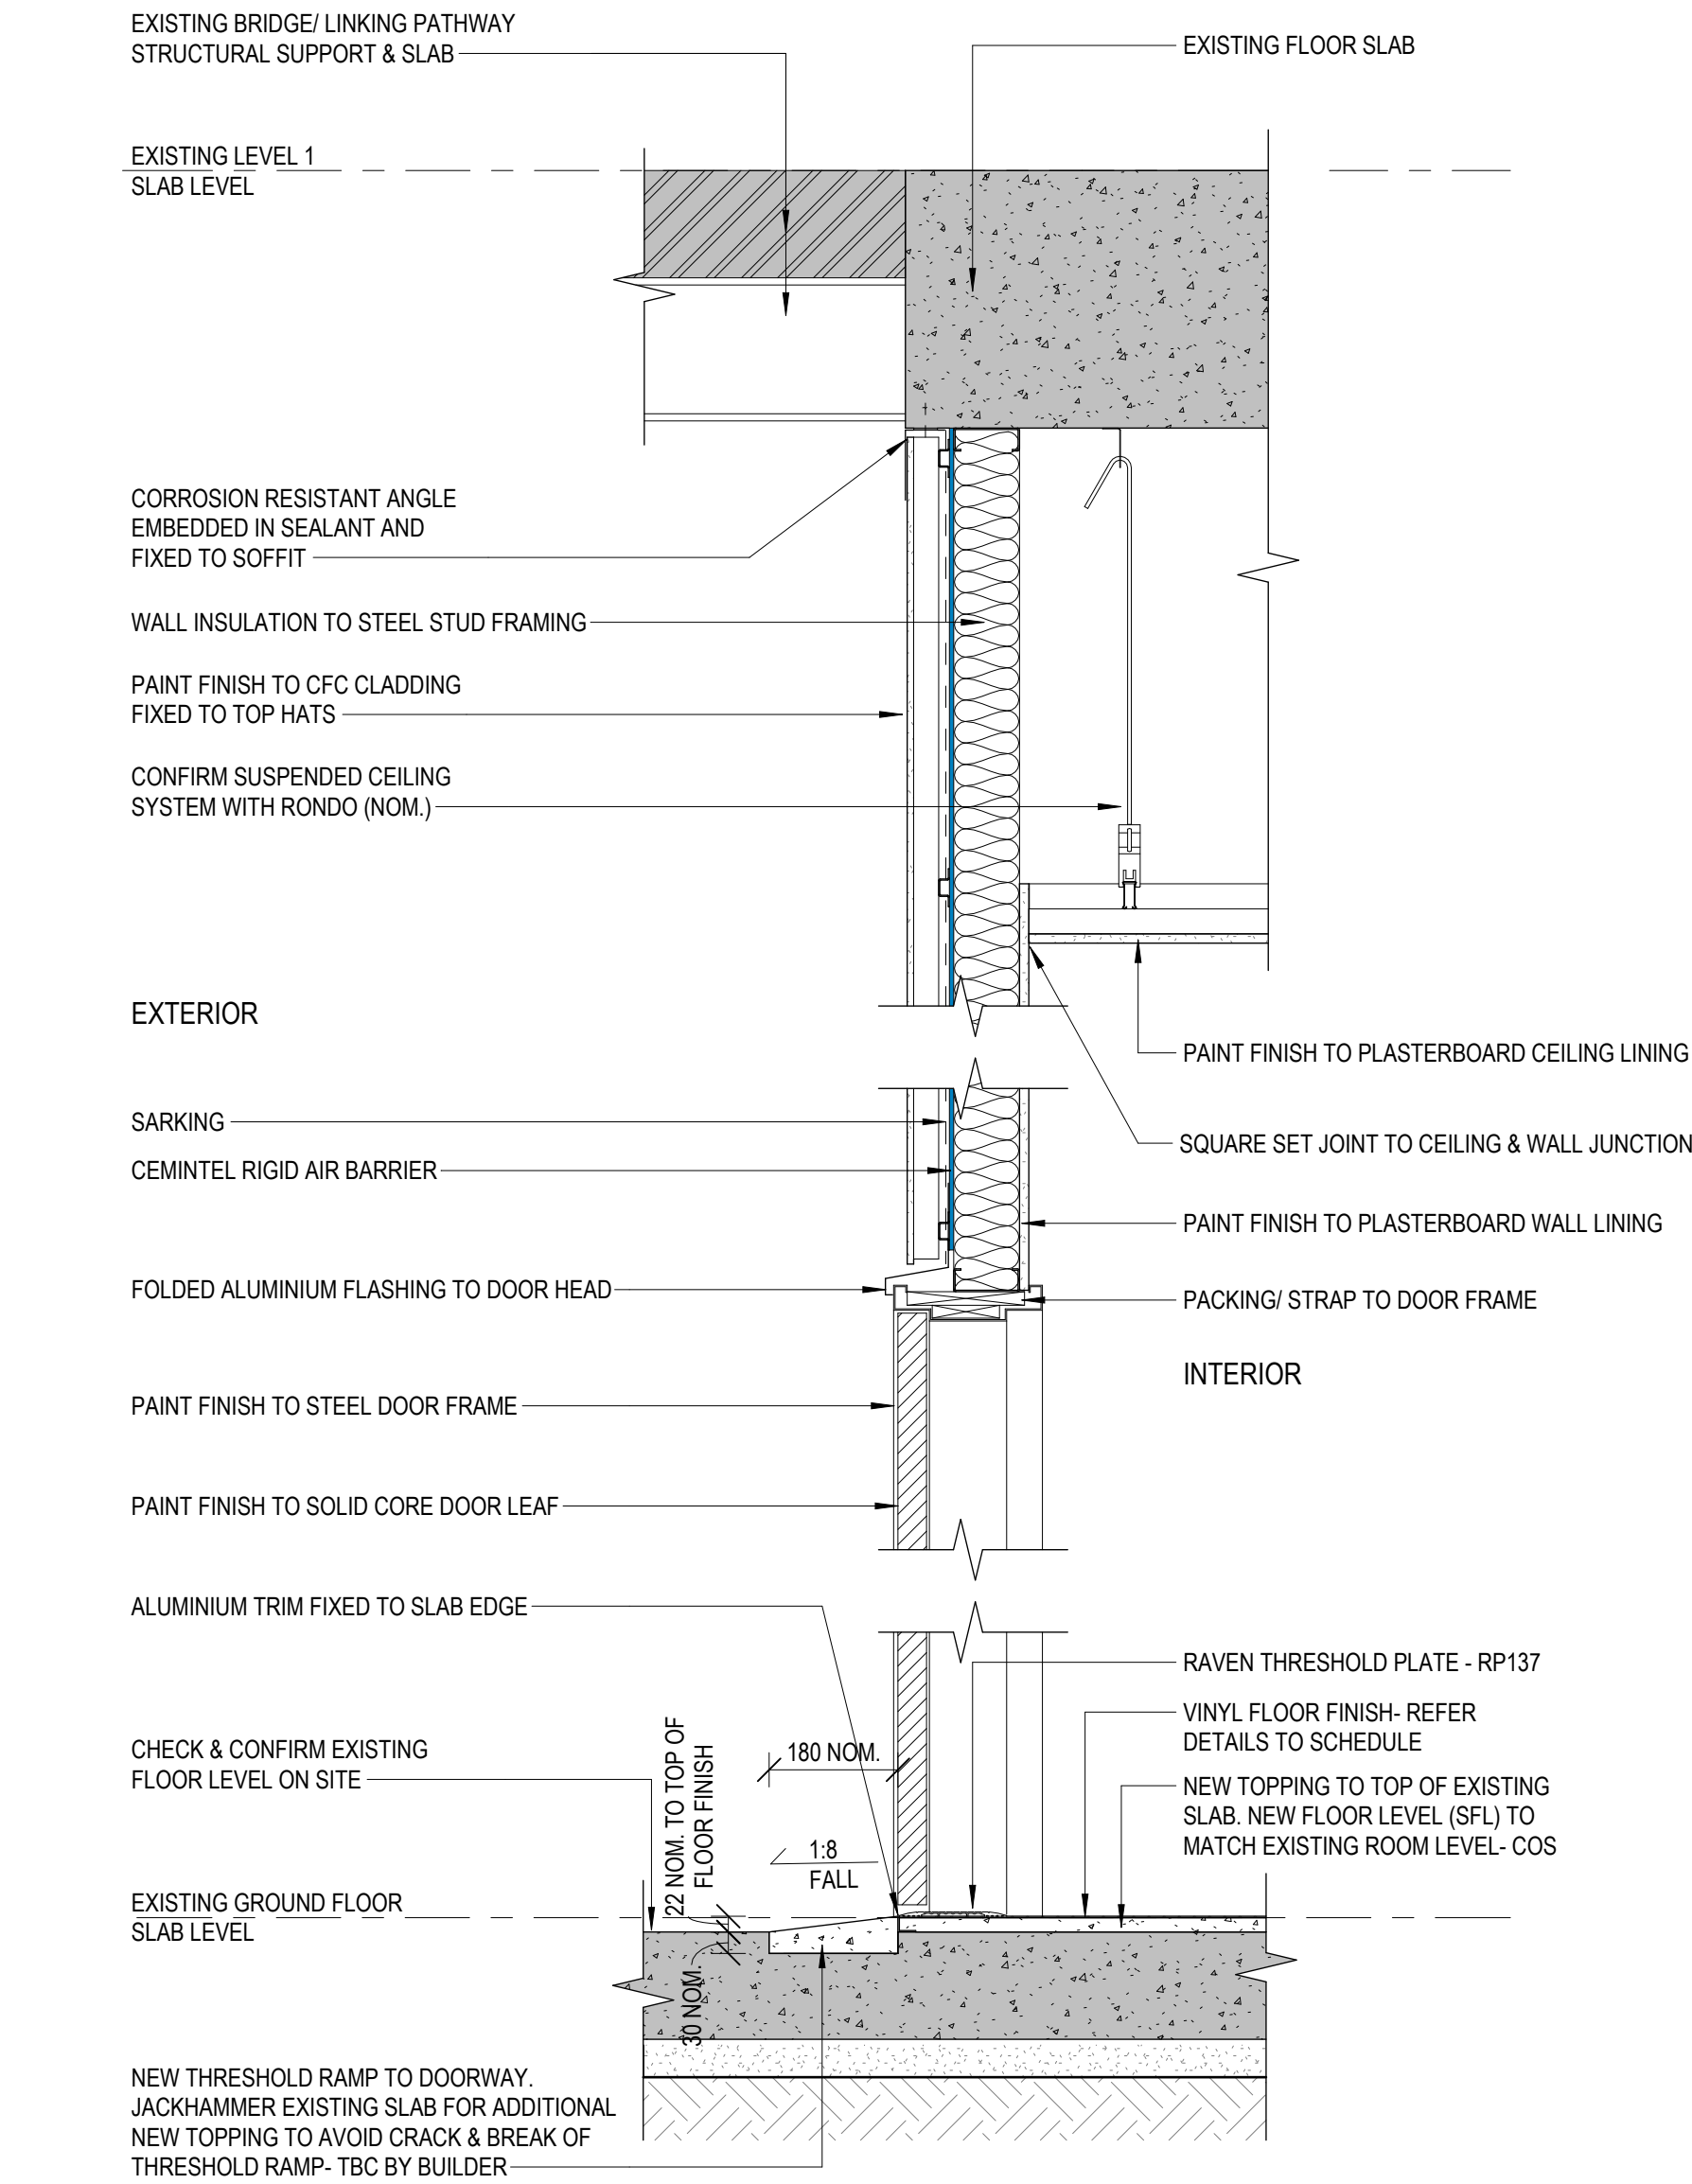

6
40-01
EXTERNAL LIGHT WEIGHT WALL DETAIL SECTION
1 : 10

thomson
adsett

Telephone +61 7 3840 9999
bne@thomsonadsett.com
Level 9, 470 St Pauls Terrace
Fortitude Valley
Qld 4006 Australia
thomsonadsett.com

© Copyright
These drawings and designs and the copyright thereof are the property of Thomson Adsett Pty Ltd and must not be used, retained or copied without written permission of Thomson Adsett Pty Ltd. ABN 76 105 314 654 Trading as ThomsonAdsett. Dimensions take precedence over scaling. Do not measure off drawings as print sizes may vary

BUILDING 33 REDEVELOPMENT

554/700 YAAMBA ROAD,
NORMAN GARDENS QLD 4701

for
CQUUniversity
NORTH ROCKHAMPTON CAMPUS
& GIRVAN



GIRVAN

B	25/06/2024	AS CONSTRUCTED	PB
A	02/02/2024	IFC	PB
1	20/09/2023	ISSUE FOR INFORMATION	WL
rev/	date	details	init

drawn	date
WL	SEP 2023
checked	date
NC	SEP 2023
verified	date
GK	DEC 2023

scale

CONSTRUCTION DETAILS - SHEET 2

scale project no.
1 : 10 @ A1 23.0078.17


sheet no.
CQU-ROK-033-GN-ARC-40-01

revision
B


AS CONSTRUCTED

original sheet size - A1 (594mm x 841mm)


C:\REVIT\LOCALFILES\23.0078.17_CQU Building 33 Redevelopment_2023_Philip Bugden.nt

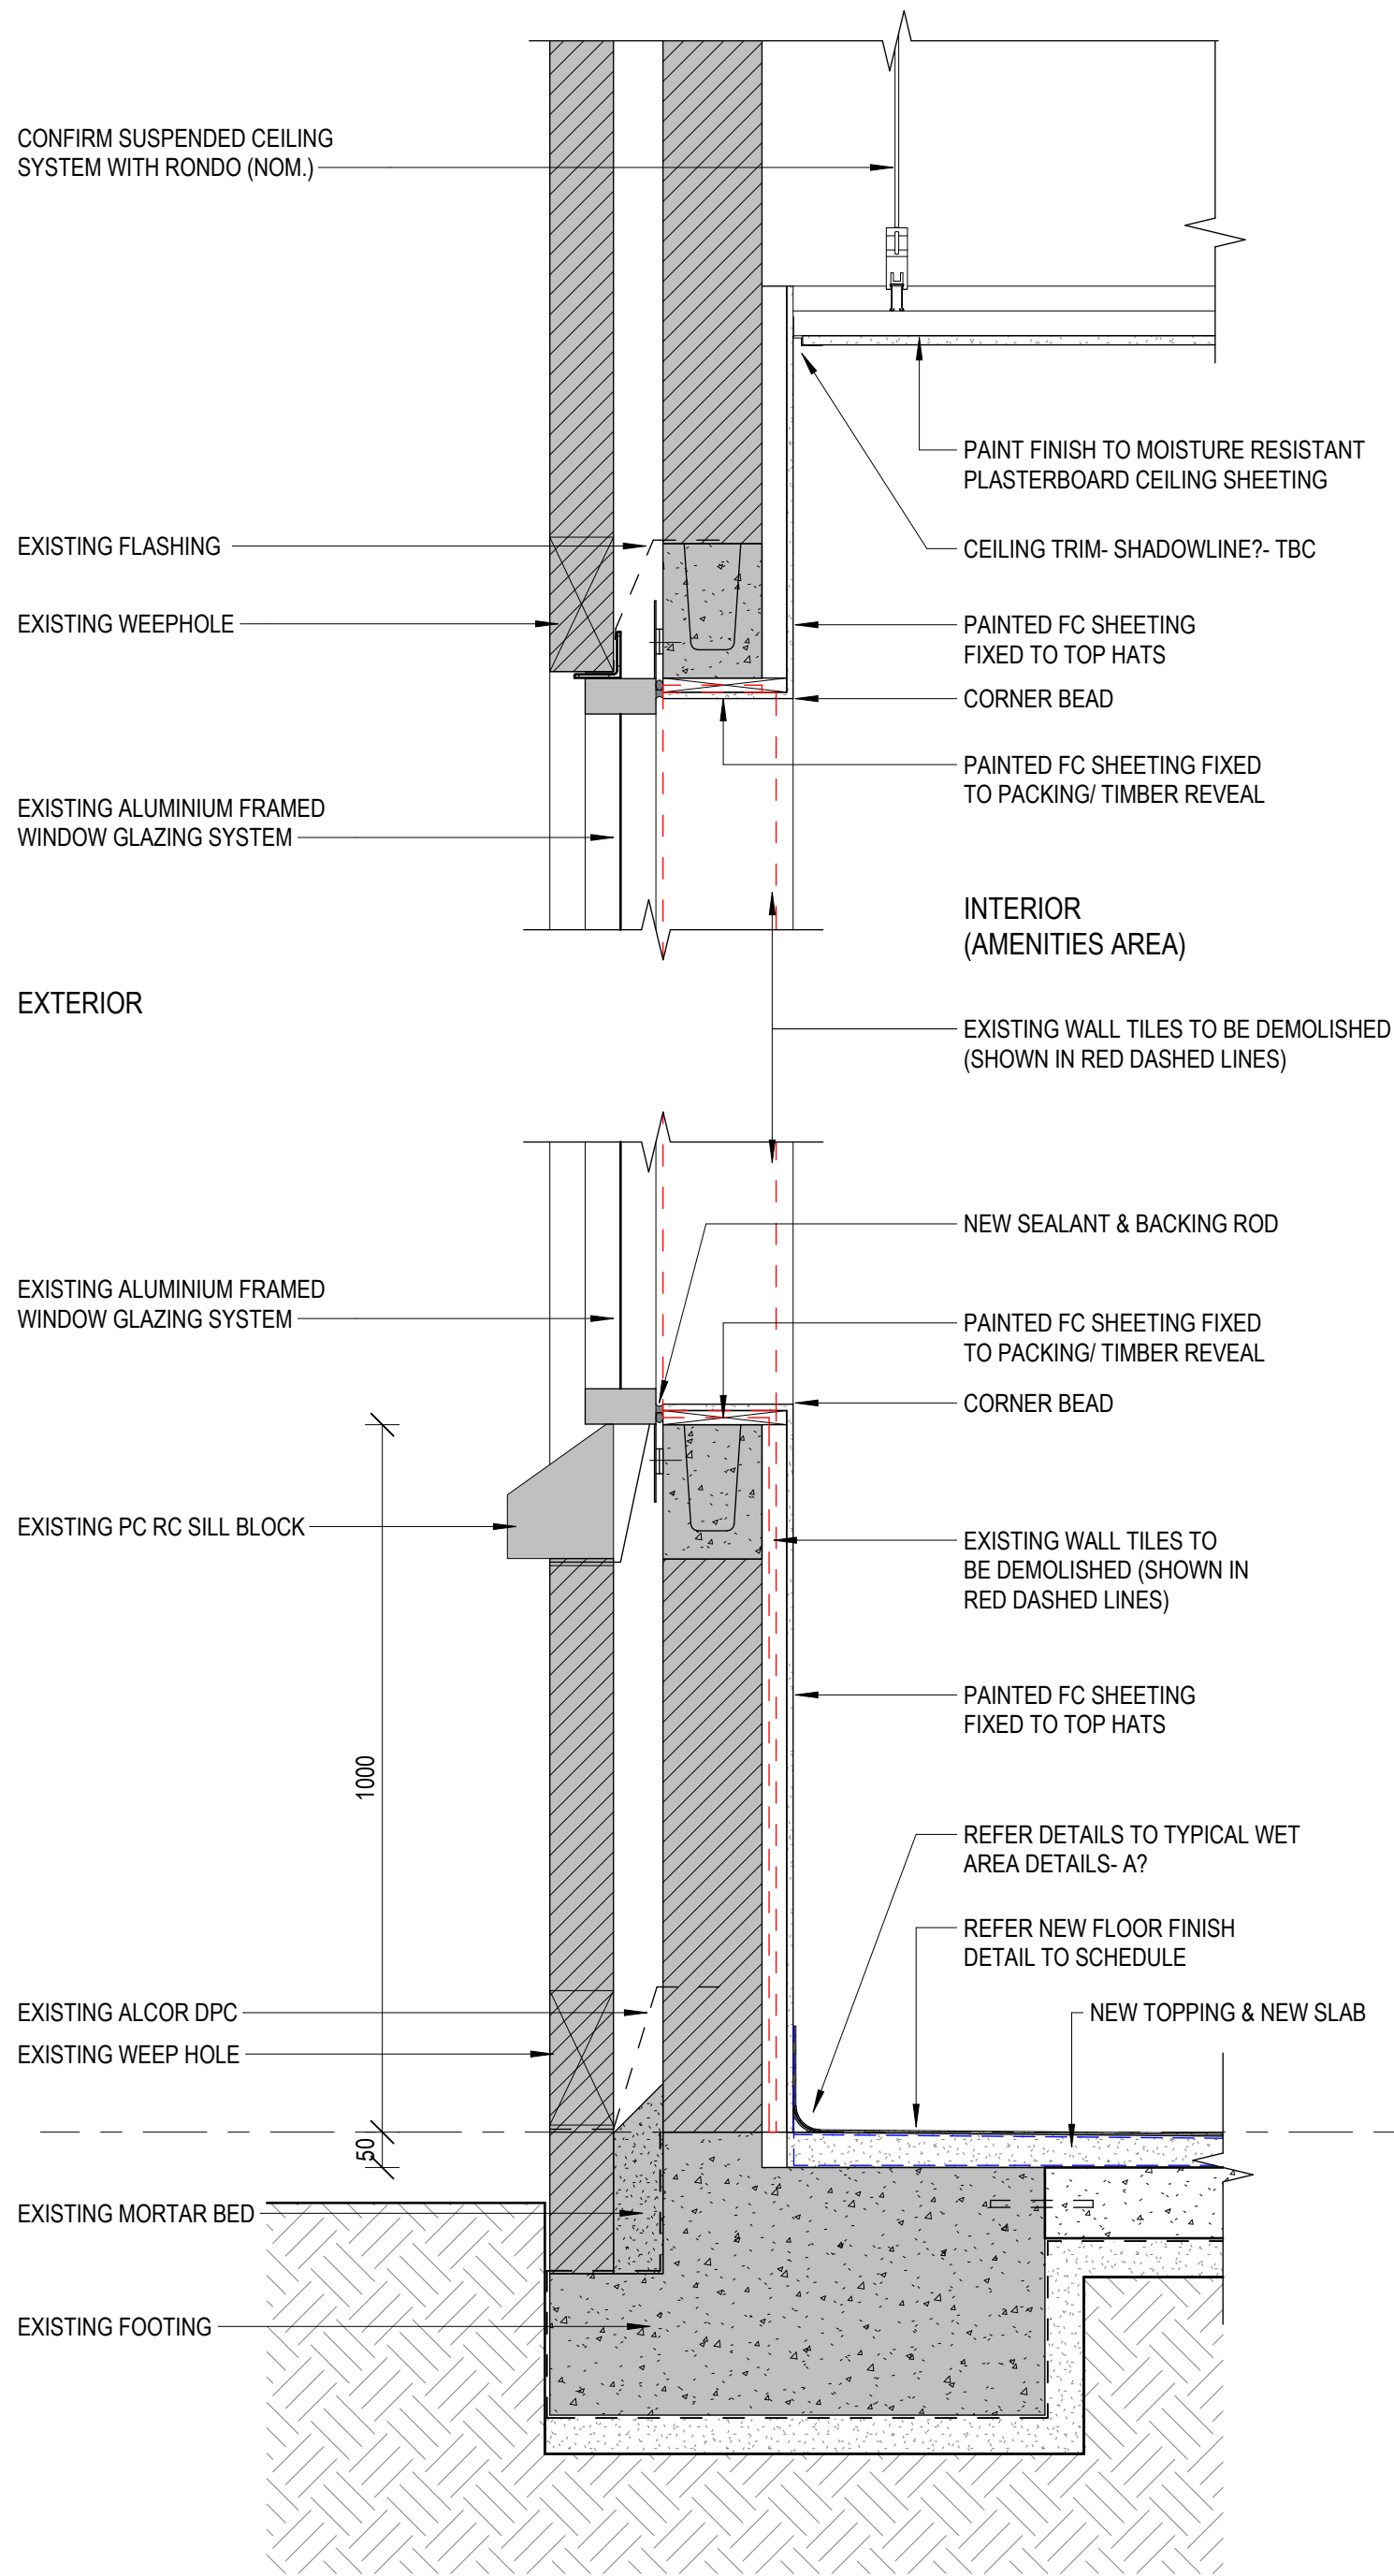


1 EXTERNAL WINDOW DETAIL SECTION 1
1 : 10

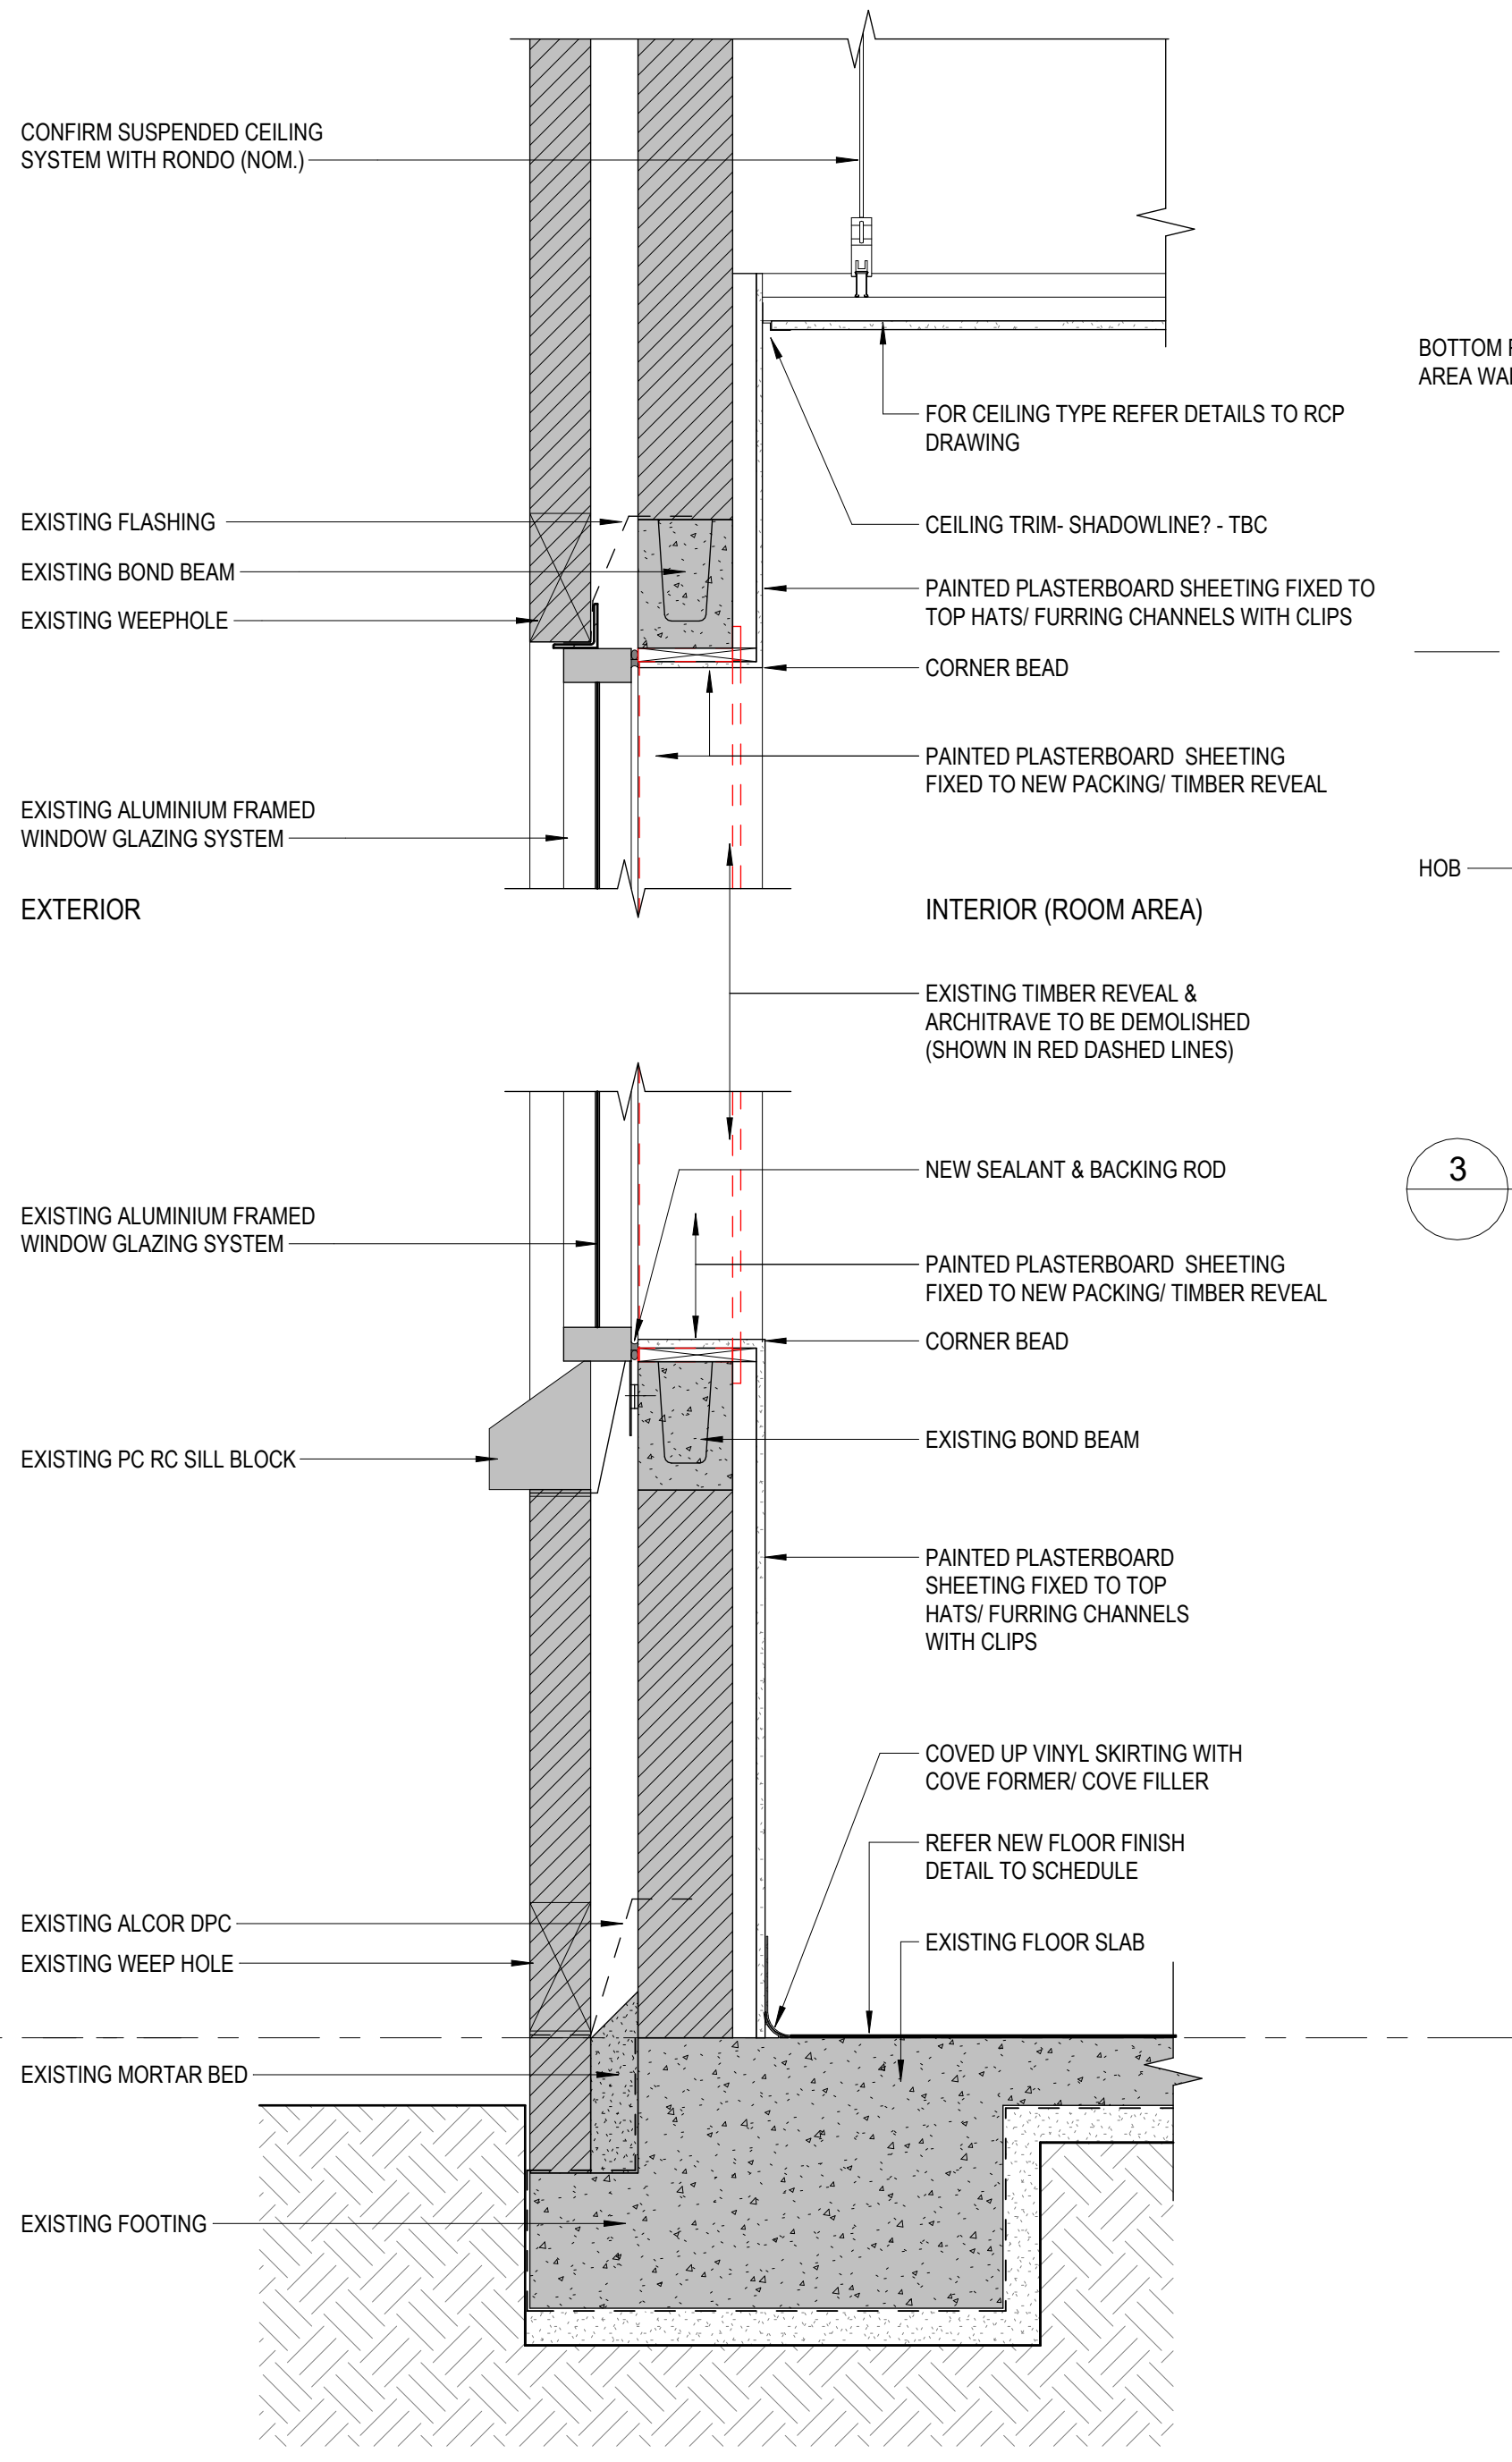

2 EXTERNAL WINDOW DETAIL SECTION 2
1 : 10

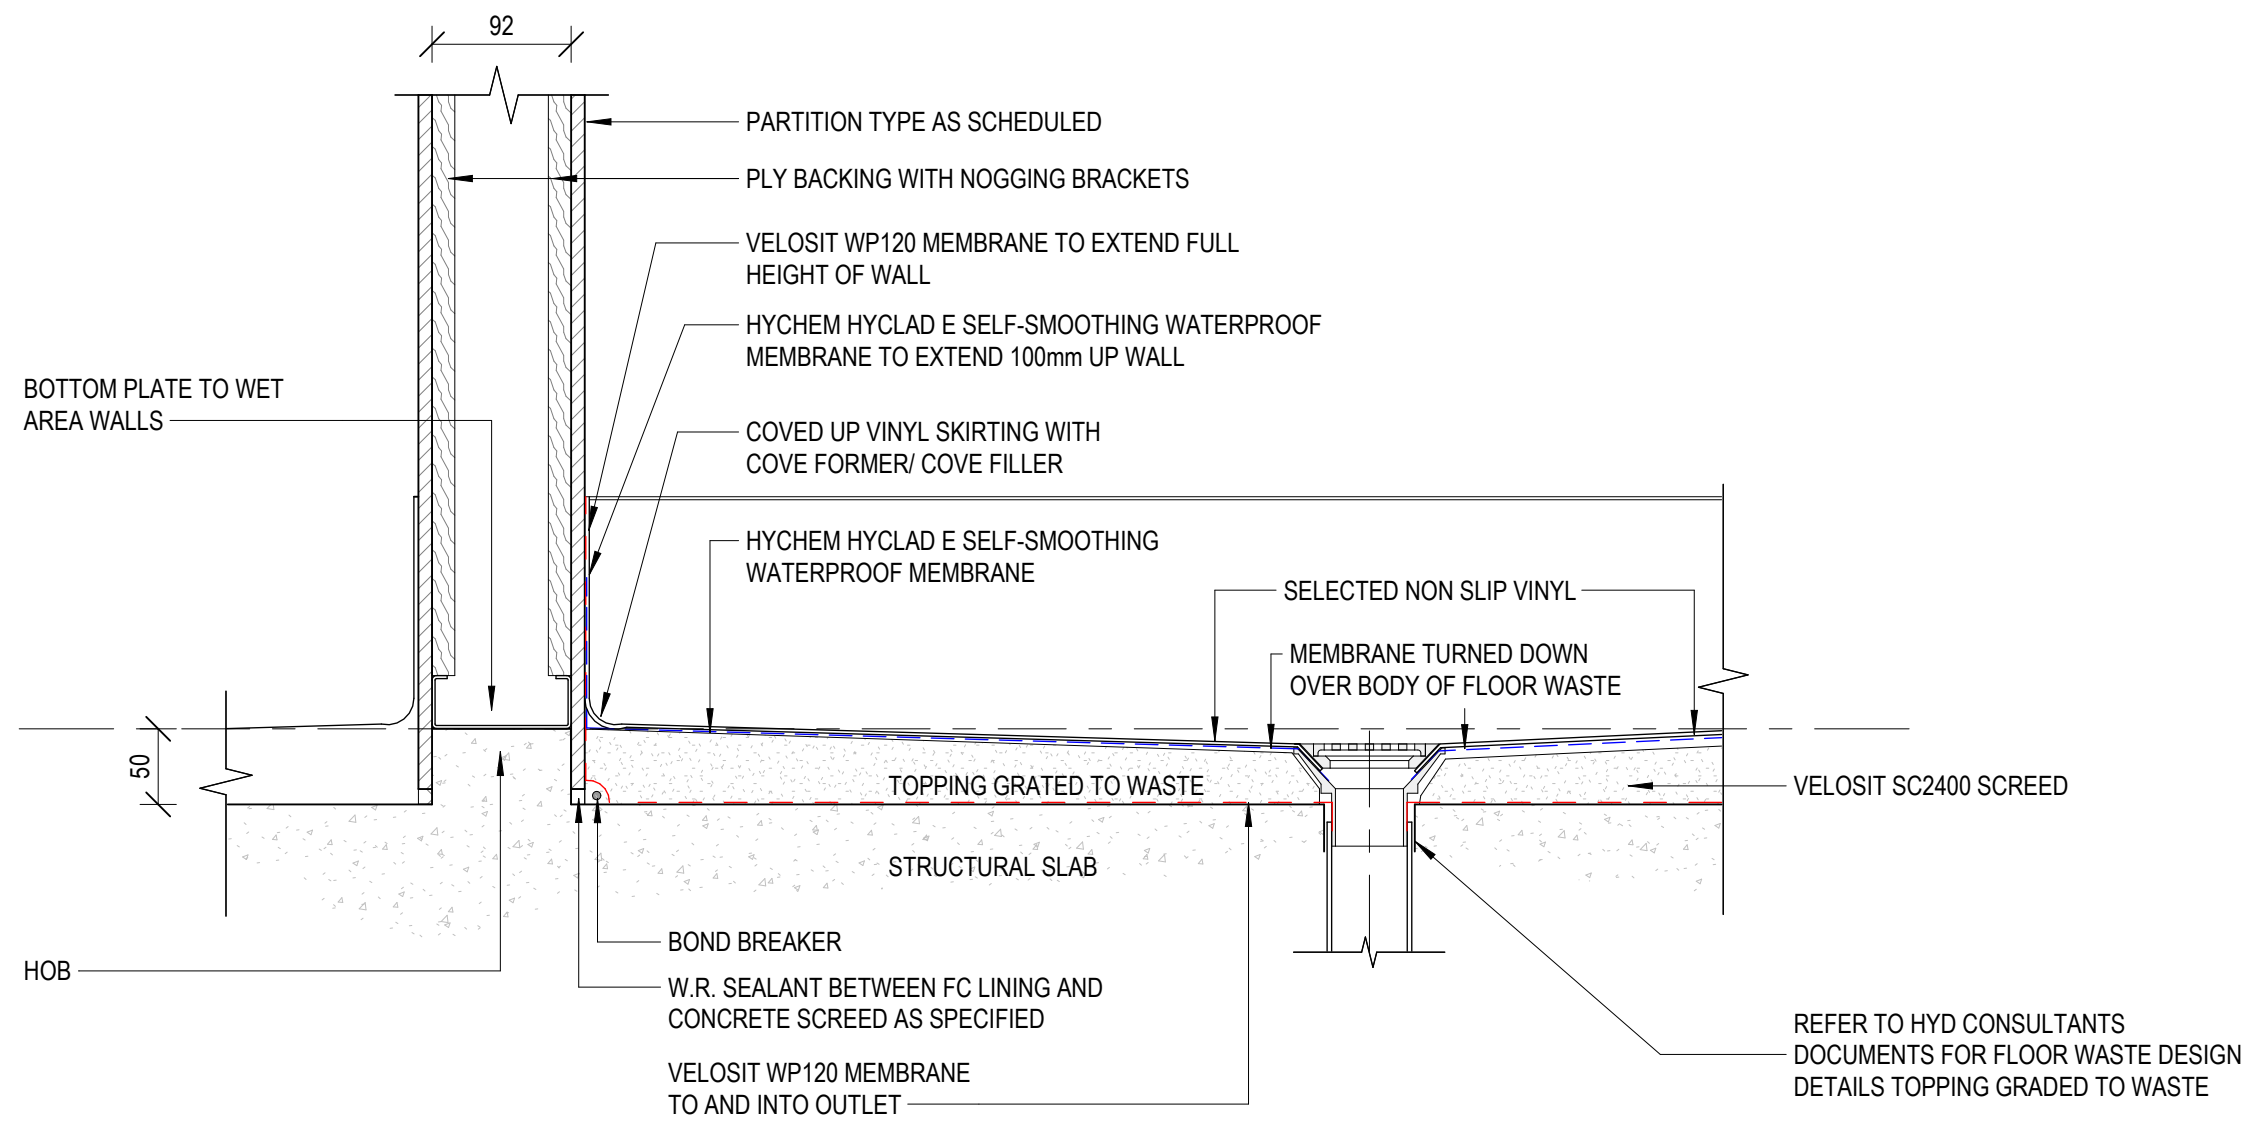

3 TYPICAL WET AREA DETAIL
1 : 5

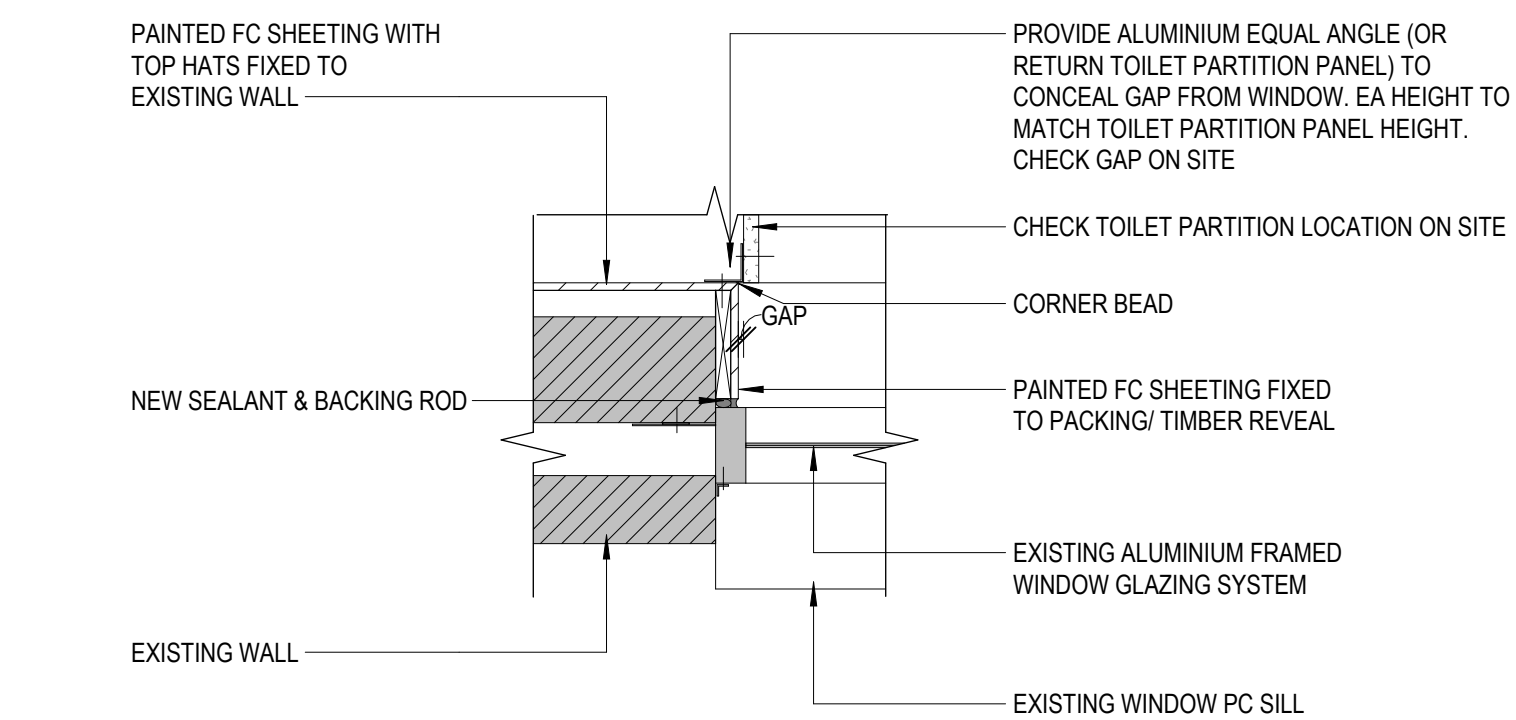

4 EXTERNAL WINDOW & TOILET PARTITION DETAIL PLAN
1 : 10

thomson
adsett

Telephone +61 7 3840 9999
bne@thomsonadsett.com
Level 9, 470 St Pauls Terrace
Fortitude Valley
Qld 4006 Australia
thomsonadsett.com

© Copyright
These drawings and designs and the copyright thereof are the property of Thomson Adsett Pty Ltd and must not be used, retained or copied without written permission of Thomson Adsett Pty Ltd. ABN 76 105 314 654 Trading as ThomsonAdsett. Dimensions take precedence over scaling. Do not measure off drawings as print sizes may vary

BUILDING 33 REDEVELOPMENT

554/700 YAAMBA ROAD,
NORMAN GARDENS QLD 4701

for
CQUniversity
NORTH ROCKHAMPTON CAMPUS
& GIRVAN




GIRVAN

B	25/06/2024	AS CONSTRUCTED	PB
A	02/02/2024	IFC	PB
1	20/09/2023	ISSUE FOR INFORMATION	WL
rev/	date	details	init

drawn	date
WL	SEP 2023
checked	date
NC	SEP 2023
verified	date
GK	DEC 2023

scale

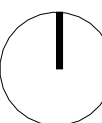

CONSTRUCTION DETAILS- SHEET 3

scale project no.
As indicated @ A1 23.0078.17

sheet no.
CQU-ROK-033-GN-ARC-40-02

revision
B

original sheet size - A1 (594mm x 841mm)

AS CONSTRUCTED

C:\REVIT\LOCALFILES\23.0078.17_CQU Building 33 Redevelopment_2023_Philip Bugden.nt



NOTES:
• WHERE NO ARCHITECTURAL SETOUT IS NOMINATED, THE CONTRACTOR IS TO COORDINATE THE FRAME REBATE, HANDLE AND SEALS TO ESTABLISH THE REQUIRED HARDWARE BACKSET.
• REFER TYPICAL SETOUTS ON DRAWING A-50-11
• FOR SIGNAGE TYPES & DETAILS REFER TO SIGNAGE SCHEDULE
• REFER DOOR HARDWARE SCHEDULE FOR ASSOCIATED HARDWARE

DOOR TYPE 1- SOLID CORE DOUBLE HINGED DOORS

LEAF SIZE		2040mm
• HEIGHT	EQ	
• WIDTH	EQ	
• THICKNESS	40mm	
DOOR FINISH		SOLID CORE DOORS
HINGE		PAIN, COLOUR AS PER FINISHES SCHEDULE
FRAME FINISH		STEEL
DOOR HARDWARE		PAINT, COLOUR AS PER FINISHES SCHEDULE
SIGNAGE		BUTT HINGE
		SELF CLOSING
		TBC

DOOR TYPE 2- SOLID CORE SINGLE HINGED DOOR

LEAF SIZE		2040mm
• HEIGHT	920mm	
• WIDTH	40mm	
• THICKNESS	40mm	
DOOR FINISH		SOLID CORE DOORS
HINGE		PAIN, COLOUR AS PER FINISHES SCHEDULE
FRAME FINISH		STEEL
DOOR HARDWARE		PAINT, COLOUR AS PER FINISHES SCHEDULE
SIGNAGE		BUTT HINGE
		SELF CLOSING
		TBC

DOOR TYPE 3- TOILET PARTITION DOOR

LEAF SIZE		REFER SCHEDULE
• HEIGHT	REFER SCHEDULE	
• WIDTH	REFER SCHEDULE	
• THICKNESS	20mm	
DOOR FINISH		COMPACT LAMINATE
HINGE		LAMINATE
FRAME FINISH		LIFT OFF SPRING HINGE
DOOR HARDWARE		
SIGNAGE		STATUTORY SIGN

DOOR TYPE 4- SOLID CORE DOUBLE HINGED DOORS WITH VIEWING PANELS

LEAF SIZE		2040mm
• HEIGHT	EQ	
• WIDTH	EQ	
• THICKNESS	40mm	
DOOR FINISH		SOLID CORE DOORS
HINGE		PAIN, COLOUR AS PER FINISHES SCHEDULE
GLAZING		BUTT HINGE
FRAME FINISH		FIXED CLEAR GLAZING AS VIEWING PANEL
DOOR HARDWARE		
SIGNAGE		STEEL
		PAINT, COLOUR AS PER FINISHES SCHEDULE
		SELF CLOSING
		TBC

DOOR LEGEND


ACD	ACCESS CONTROLLED DOOR (CARD READER)
MB	METAL BACKING (TO BACK OF DOOR)
SI-1	STATUTORY SIGN
SI-2	AMBULANT TOILET SIGNAGE
SI-3	PC2 SIGN & BIO-HAZARD SYMBOL
SMS	SMOKE SEAL
THP	THRESHOLD PLATE (TO COMPLY AS1428.1-2009)
U/C	30mm UNDERCUT TO DOOR

D01					
DOOR NUMBER	To Room: Name	DOOR LEAF HEIGHT	DOOR LEAF WIDTH		COMMENTS
			LEAF 1	LEAF 2	
G11	STORE ROOM	2040	920	920	ACD
G12	STORE ROOM	2040	920	920	ACD, THP
G14	DB1	2040	870	870	SMS, MB
G18	DB2	2040	870	870	SMS, MB

D02				
DOOR NUMBER	ROOM NAME	DOOR LEAF HEIGHT	DOOR LEAF WIDTH	COMMENTS
G02	MALE TOILET	2040	920	
G03	FEMALE TOILET	2040	920	
G04	UNISEX PWD	2040	920	SI-1
G05	CLEANERS	2040	920	U/C


D03				
DOOR NUMBER	ROOM NAME	DOOR LEAF HEIGHT	DOOR LEAF WIDTH	COMMENTS
G02A	MALE TOILET	1901	720	SI-2
G02B	MALE TOILET	1901	600	
G02C	MALE TOILET	1901	600	
G03A	FEMALE TOILET	1901	720	SI-2
G03B	FEMALE TOILET	1901	600	
G03C	FEMALE TOILET	1901	600	
G03D	FEMALE TOILET	1901	600	

D04					
DOOR NUMBER	ROOM NAME	DOOR LEAF HEIGHT	DOOR LEAF WIDTH		COMMENTS
			LEAF 1	LEAF 2	
G06		2040	920	920	ACD, SI-3, THP
G07	PC2 LAB 1- 48 SEAT	2040	920	920	ACD
G08	PC2 LAB 1- 48 SEAT	2040	920	920	ACD
G10	PC2 LAB 2 48 SEAT	2040	920	920	ACD, SI-3, THP

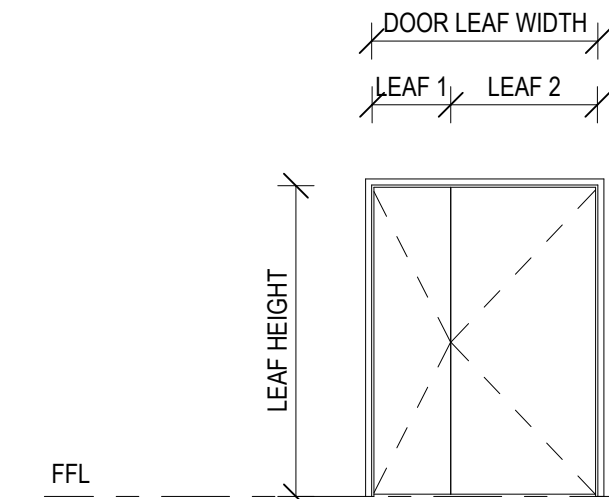


DOOR TYPE 5- SOLID CORE DOUBLE HINGED DOORS

LEAF SIZE		2040mm
• HEIGHT	REFER SCHEDULE	
• WIDTH	EQ	
• THICKNESS	40mm	
DOOR FINISH		SOLID CORE DOORS
HINGE		PAIN, COLOUR AS PER FINISHES SCHEDULE
FRAME FINISH		STEEL
DOOR HARDWARE		PAINT, COLOUR AS PER FINISHES SCHEDULE
SIGNAGE		BUTT HINGE
		SELF CLOSING
		TBC

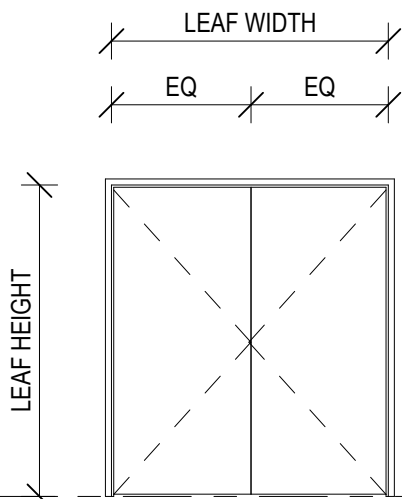


DOOR TYPE 6- SOLID CORE FIRE RATED DOUBLE HINGED DOORS

LEAF SIZE		2040mm
• HEIGHT	EQ	
• WIDTH	45mm	
• THICKNESS	45mm	
DOOR FINISH		SOLID CORE DOORS
HINGE		PAIN, COLOUR AS PER FINISHES SCHEDULE
FRAME FINISH		STEEL
DOOR HARDWARE		PAINT, COLOUR AS PER FINISHES SCHEDULE
SIGNAGE		BUTT HINGE
		SELF CLOSING
		TBC

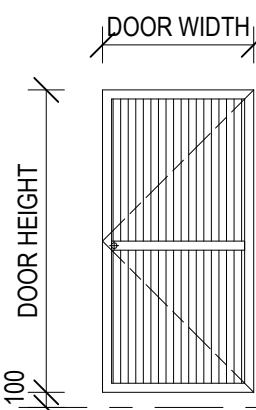


GATE TYPE 1- ALUMINIUM FRAMED LOUVRE SINGLE SWING DOOR

LEAF SIZE		REFER SCHEDULE
• HEIGHT	REFER SCHEDULE	
• WIDTH	REFER SCHEDULE	
• THICKNESS	50mm	
DOOR FINISH		ALUMINIUM LOUVRE
HINGE		POWDERCOAT FINISH
FRAME FINISH		ALUMINIUM
DOOR HARDWARE		POWDERCOAT FINISH

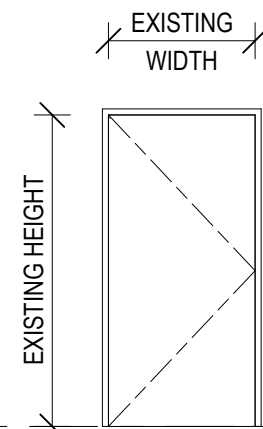

DOOR TYPE EX1- EXISTING DOOR WITH NEW DOOR HARDWARE

EX1		
DOOR NUMBER	ROOM NAME	COMMENTS
G15	PC2 LAB 1- 48 SEAT	ACD

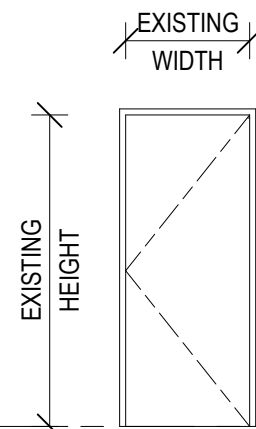


DOOR TYPE EX2- EXISTING DOOR TO BE RE-HINGED TO OPEN AGAINST NEW WALL

EX2		
DOOR NUMBER	ROOM NAME	COMMENTS
G16		

D05					
DOOR NUMBER	ROOM NAME	DOOR LEAF HEIGHT	DOOR LEAF WIDTH		COMMENTS
			LEAF 1	LEAF 2	
G01	STUDENT LOUNGE	2040	520	970	ACD, THP
G26	STORE ROOM	2040	520	970	ACD

D06					
DOOR NUMBER	ROOM NAME	DOOR LEAF HEIGHT	DOOR LEAF WIDTH		COMMENTS
			LEAF 1	LEAF 2	
G13	NEW COMMS ROOM	2040	920	920	ACD

G01				
DOOR NUMBER	DOOR LEAF HEIGHT	DOOR LEAF WIDTH		COMMENTS
G21	2000	1000		
G22	2000	1000		

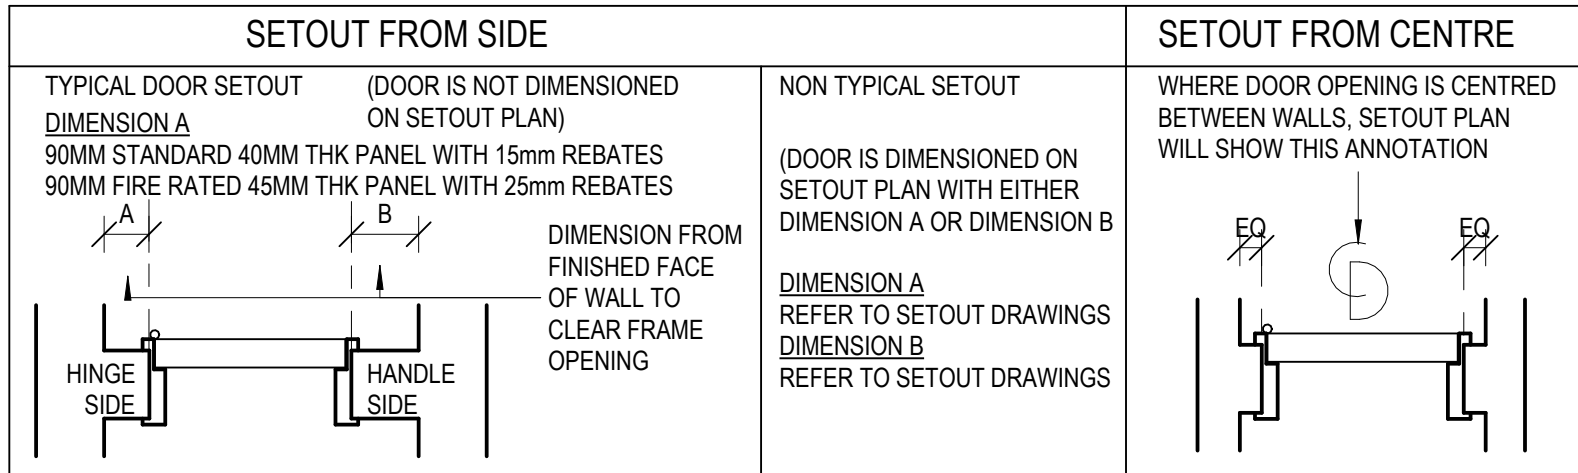

REFER TO 1428.1 FOR DIMENSIONAL TOLERANCE REQUIREMENTS

thomson
adsett

Telephone +61 7 3840 9999
bne@thomsonadsett.com
Level 9, 470 St Pauls Terrace
Fortitude Valley
Qld 4006 Australia
thomsonadsett.com

© Copyright
These drawings and designs and the copyright thereof are the property of Thomson Adsett Pty Ltd and must not be used, retained or copied without written permission of Thomson Adsett Pty Ltd. ABN 76 105 314 654 Trading as ThomsonAdsett. Dimensions take precedence over scaling. Do not measure off drawings as print sizes may vary

**BUILDING 33
REDEVELOPMENT**

554/700 YAAMBA ROAD,
NORMAN GARDENS QLD 4701

for
CQUniversity
NORTH ROCKHAMPTON CAMPUS
& GIRVAN



GIRVAN

B	25/06/2024	AS CONSTRUCTED	PB
A	02/02/2024	IFC	PB
3	20/09/2023	ISSUE FOR INFORMATION	WL
2	11/09/2023	AMENDED 60% DD ISSUE	PB
1	28/08/2023	60% DD ISSUE	WL

rev	date	details	init
-----	------	---------	------

drawn	date
WL	AUG 2023
checked	date
NC	AUG 2023
verified	date
GK	DEC 2023

scale	

DOOR SCHEDULE

scale	project no.
1 : 50 @ A1	23.0078.17

sheet no.
CQU-ROK-033-GN-ARC-50-11

revision
B

original sheet size - A1 (594mm x 841mm)

AS CONSTRUCTED


C:\REVIT\LOCAL FILES\23.0078.17_CQU Building 33 Redevelopment_2023_Philip Bugden.nt

HOW TO READ THIS DRAWING


1. REFER TO FF&E PLANS OR ROOM LAYOUT SHEETS TO LOCATE WHERE SETOUT IS REFERING TO THIS SHEET (TYPICALLY THIS WILL BE SHOWN AS GREY ELEMENTS ON THE PLAN AND ELEVATIONS.)
2. CROSS REFERENCE THE CODE ON THE FF&E PLAN OR ROOM LAYOUT SHEET WITH THE CODES SHOWN HERE
3. TYPICALLY CENTRELINE OF MAJOR FIXER WILL BE ALLOCATED FIRST WITH ALL OTHER FITTINGS SETOUT FROM THE CENTRE LINE.

NOTES:


- WHERE THE FF&E OR ROOM LAYOUT SHEET NOMINATE A DIMENSION THAT TAKES PRECEDENCE TO THESE DETAILS.
- DIMENSION STRING NOMINATE THE 1428.1 TOLLERANCE UNDER THE SETOUT VALUE.

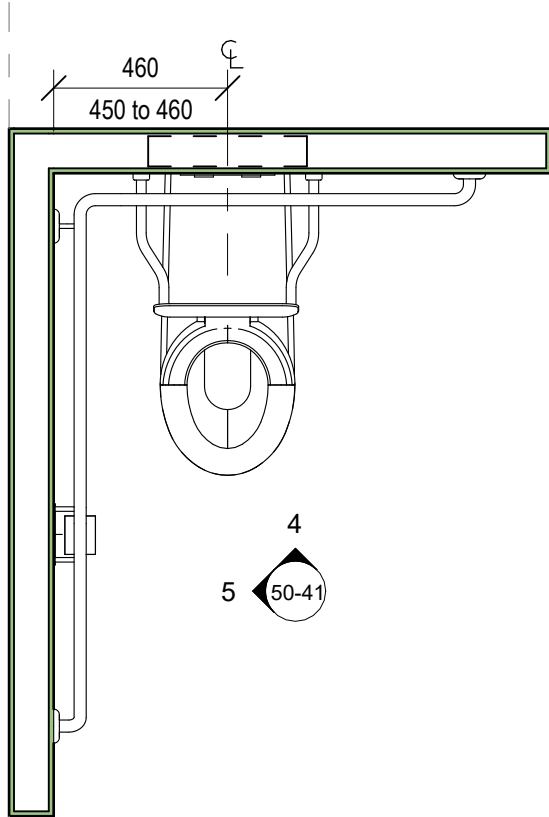


TYPICAL ACCESSIBLE TOILET

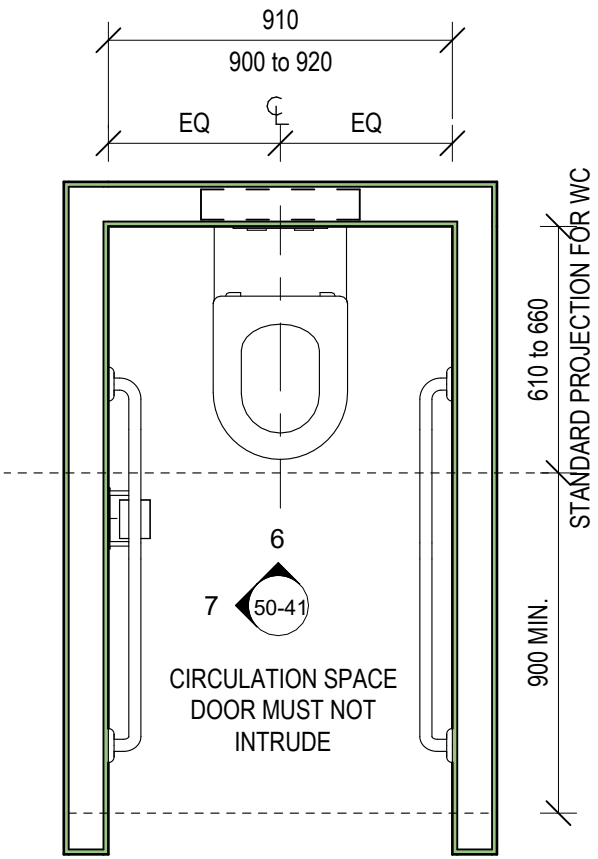


TYPICAL AMBULANT TOILET

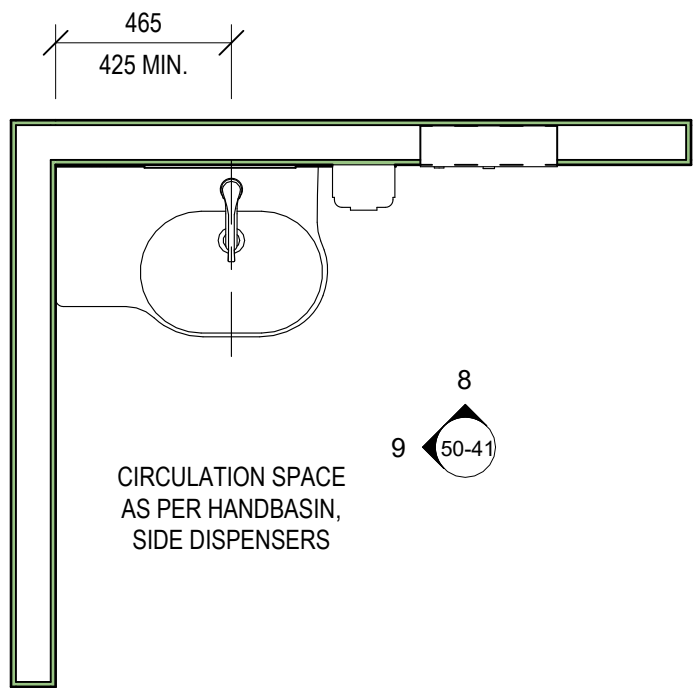


TYPICAL HANDBASIN

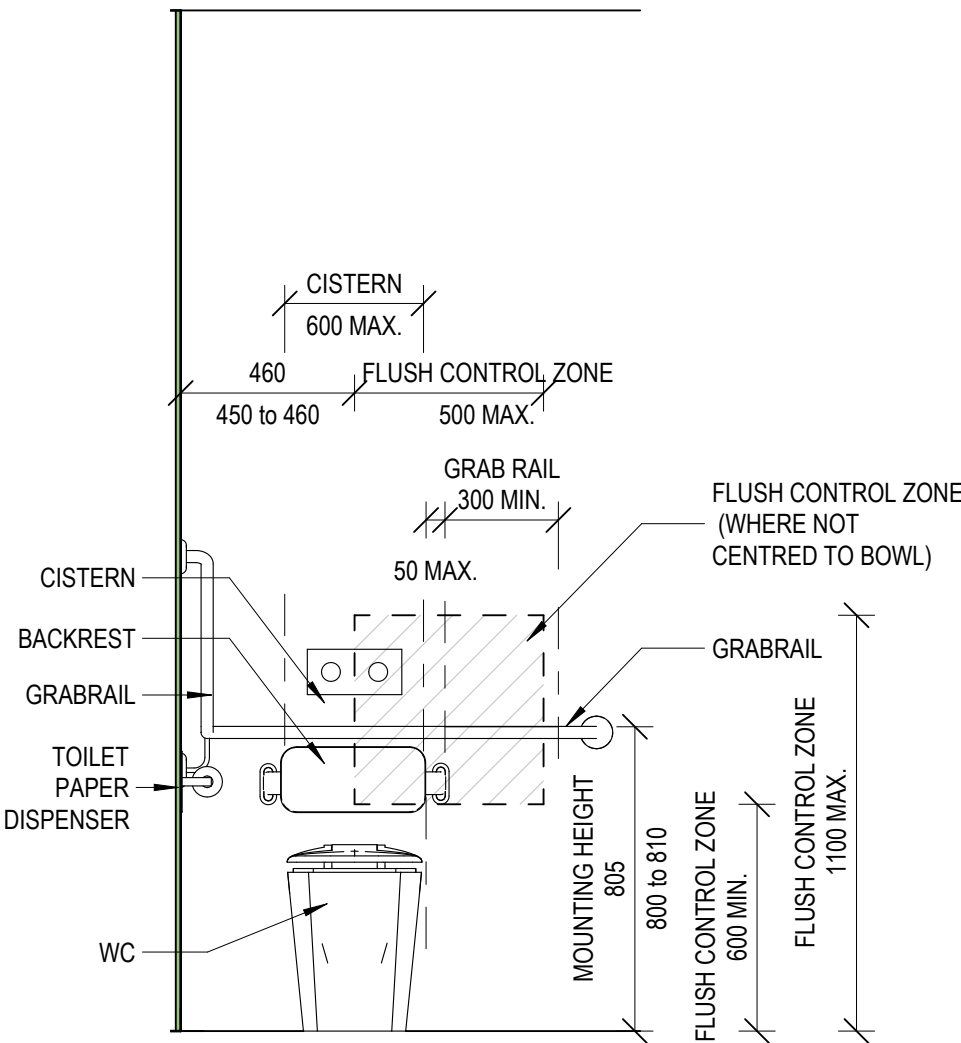


ELEVATION 4

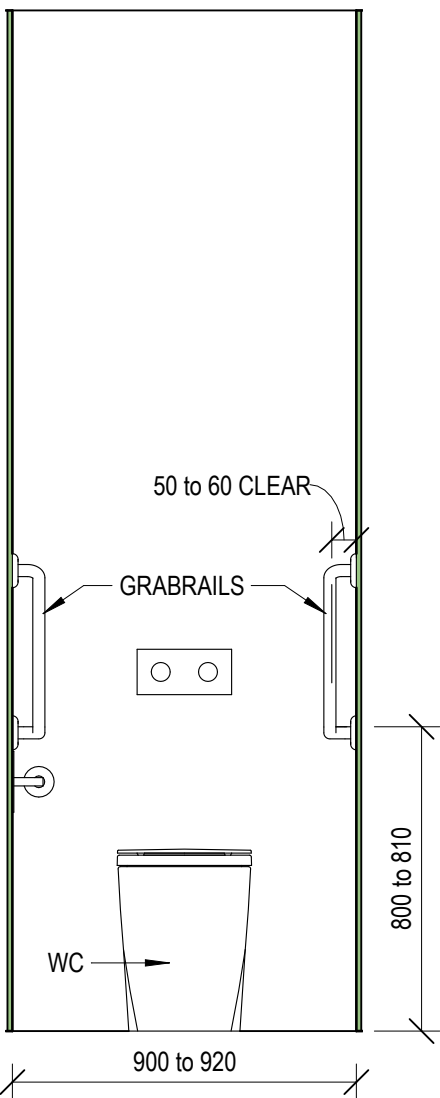


ELEVATION 6

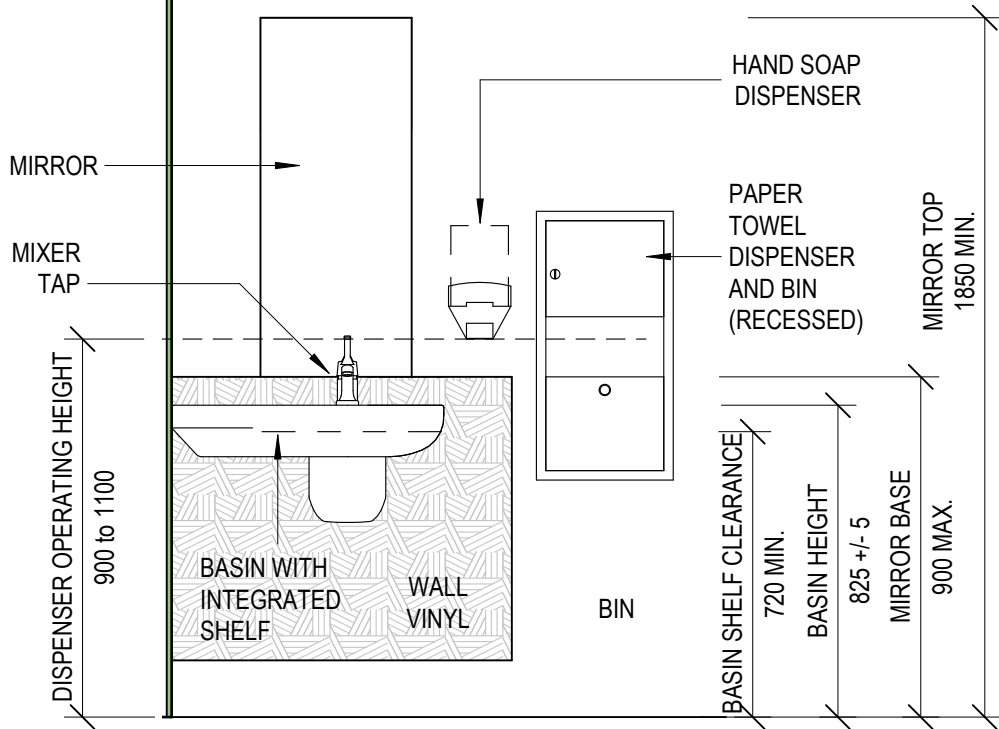


ELEVATION 8

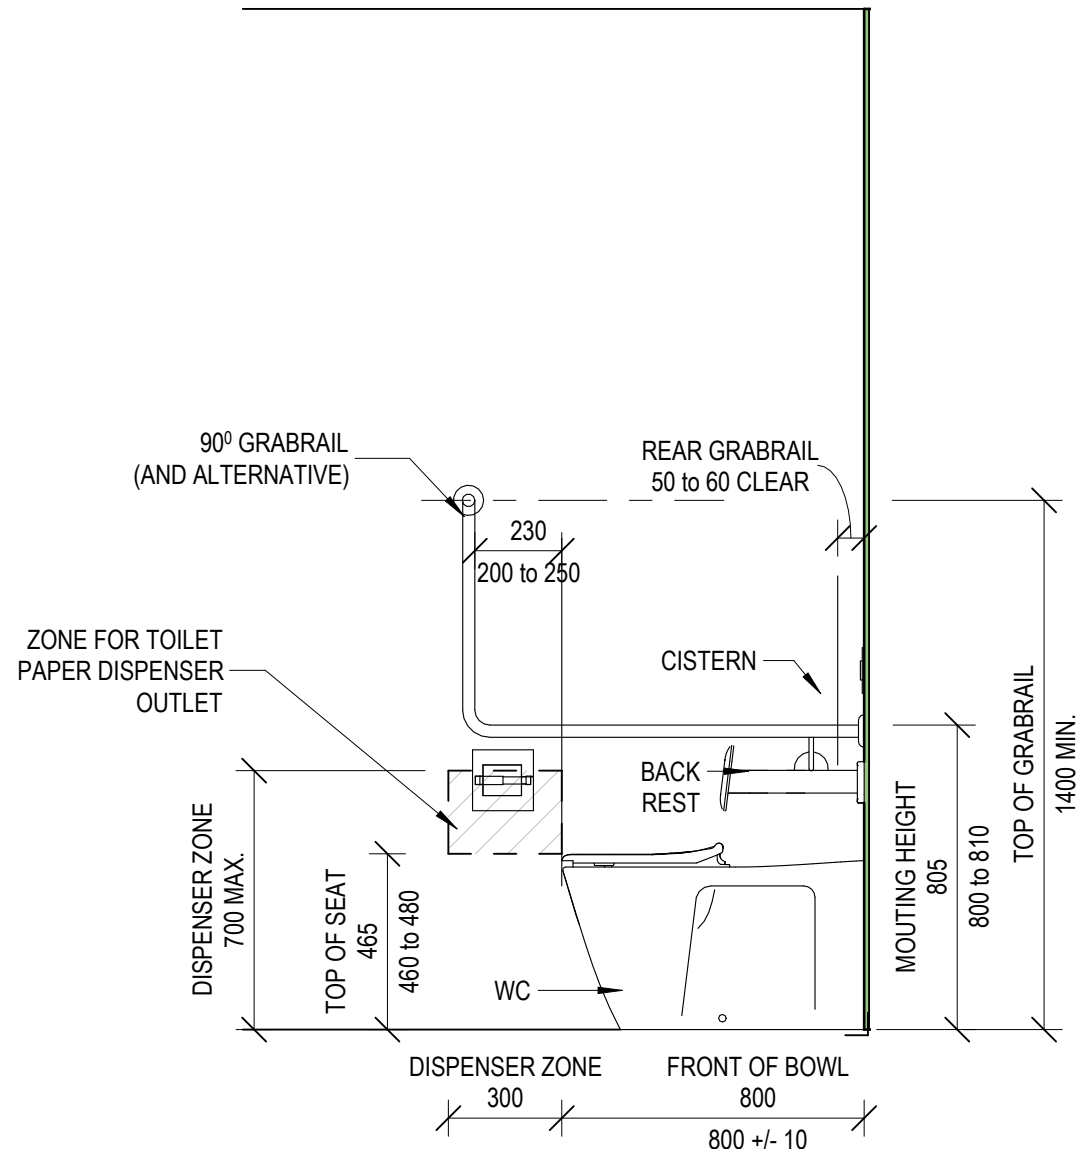

ELEVATION 5

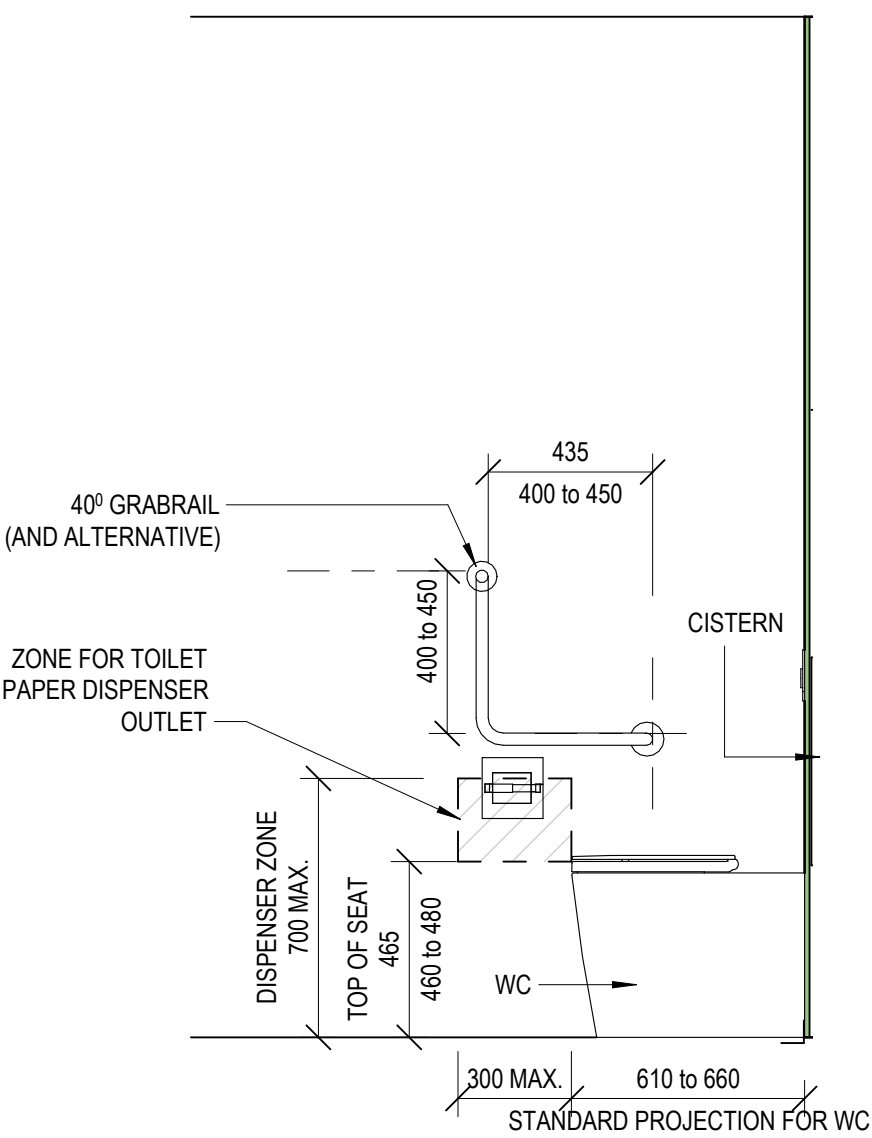

ELEVATION 7

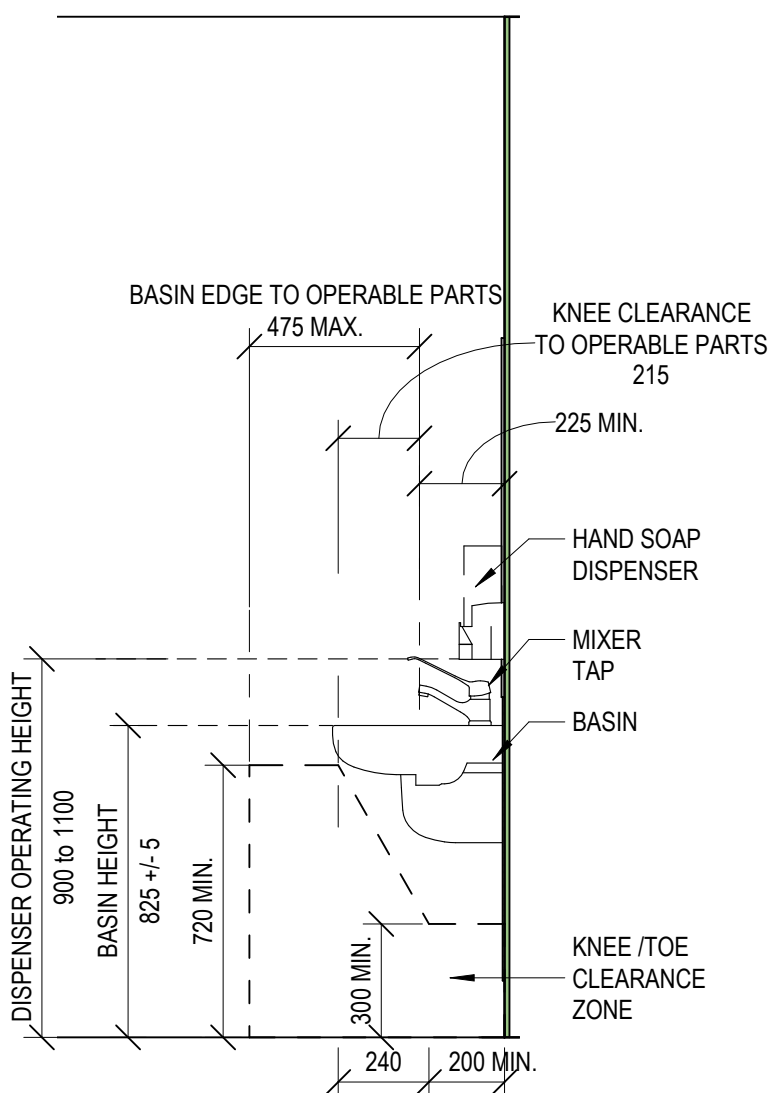

ELEVATION 9

AS CONSTRUCTED

thomson
adsett

Telephone +61 7 3840 9999
bne@thomsonadsett.com
Level 9, 470 St Pauls Terrace
Fortitude Valley
Qld 4006 Australia
thomsonadsett.com

© Copyright
These drawings and designs and the copyright thereof are the property of Thomson Adsett Pty Ltd and must not be used, retained or copied without written permission of Thomson Adsett Pty Ltd. ABN 76 105 314 654 Trading as ThomsonAdsett. Dimensions take precedence over scaling. Do not measure off drawings as print sizes may vary

BUILDING 33
REDEVELOPMENT

554/700 YAAMBA ROAD,
NORMAN GARDENS QLD 4701

for
CQUniversity
NORTH ROCKHAMPTON CAMPUS
& GIRVAN



B	25/06/2024	AS CONSTRUCTED	PB
A	02/02/2024	IFC	PB
rev	date	details	init

drawn	date
TA	DEC 2023
checked	date
PB	DEC 2023
verified	date
GK	DEC 2023



TYPICAL UNISEX
ACCESSIBLE WET AREA
SETOUTS

scale project no.
1 : 20 @ A1 23.0078.17

sheet no.
CQU-ROK-033-GN-ARC-50-41

revision
B

Telephone +61 7 3840 9999
bne@thomsonadsett.com
Level 9, 470 St Pauls Terrace
Fortitude Valley
Qld 4006 Australia
thomsonadsett.com

© Copyright
These drawings and designs and the copyright thereof are the property of Thomson Adsett Pty Ltd and must not be used, retained or copied without written permission of Thomson Adsett Pty Ltd. ABN 76 105 314 654 Trading as ThomsonAdsett. Dimensions take precedence over scaling. Do not measure off drawings as print sizes may vary

BUILDING 33
REDEVELOPMENT

554/700 YAAMBA ROAD,
NORMAN GARDENS QLD 4701

for
CQUUniversity
NORTH ROCKHAMPTON CAMPUS
& GIRVAN



GIRVAN

B	25/06/2024	AS CONSTRUCTED	PB
A	02/02/2024	IFC	PB
6	20/12/2023	REVISED ISSUE	PB
5	19/12/2023	REVISED ISSUE	PB
4	20/09/2023	ISSUE FOR INFORMATION	WL
3	11/09/2023	AMENDED 60% DD ISSUE	PB
2	28/08/2023	60% DD ISSUE	WL
1	04/08/2023	PRELIMINARY ISSUE	WL
rev/	date	details	init

drawn	date
WL	JUL 2023
checked	date
NC	JUL 2023
verified	date
GK	DEC 2023




INTERNAL ELEVATIONS -
SHEET 1


scale	project no.
1 : 50 @ A1	23.0078.17

sheet no.
CQU-ROK-033-GN-ARC-60-01


revision
B

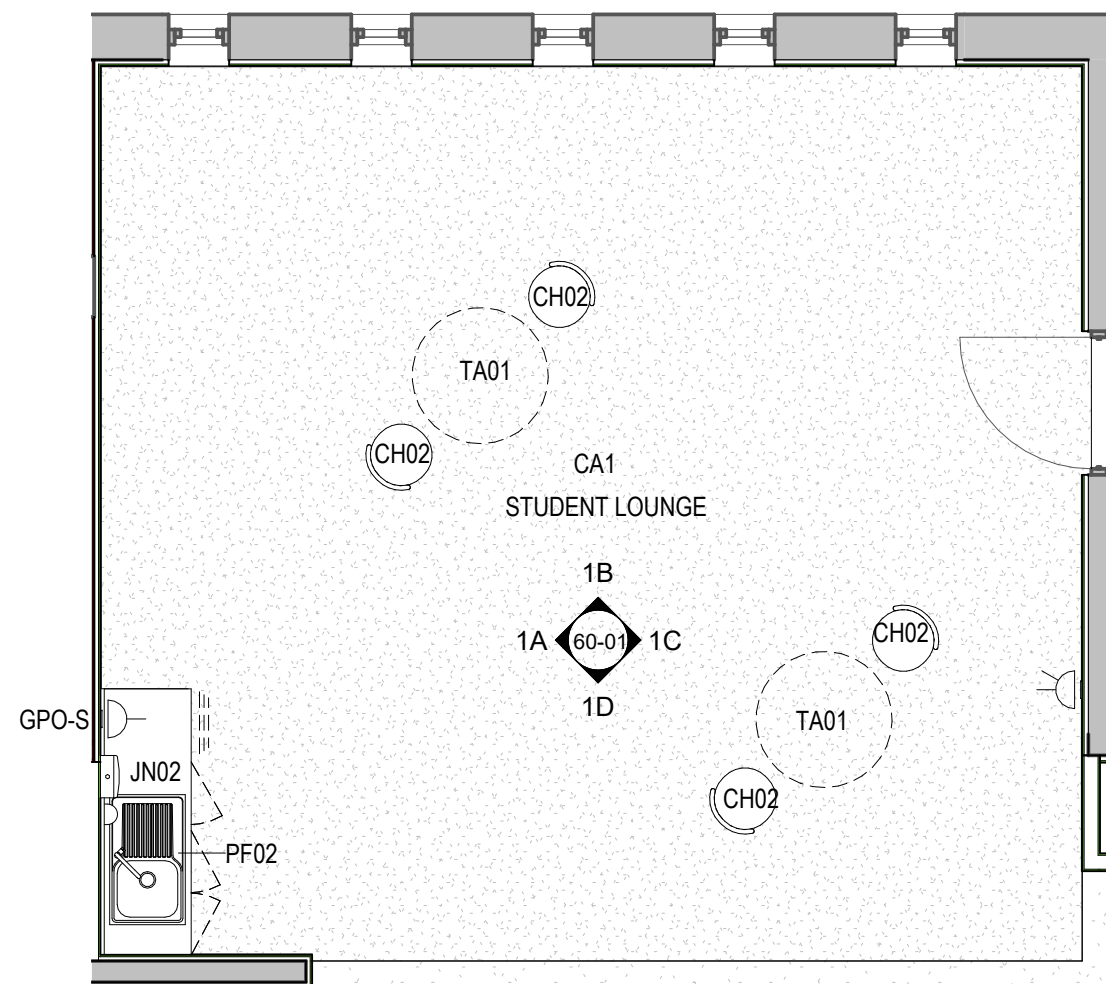


1 STUDENT LOUNGE PLAN
21-10 1 : 50

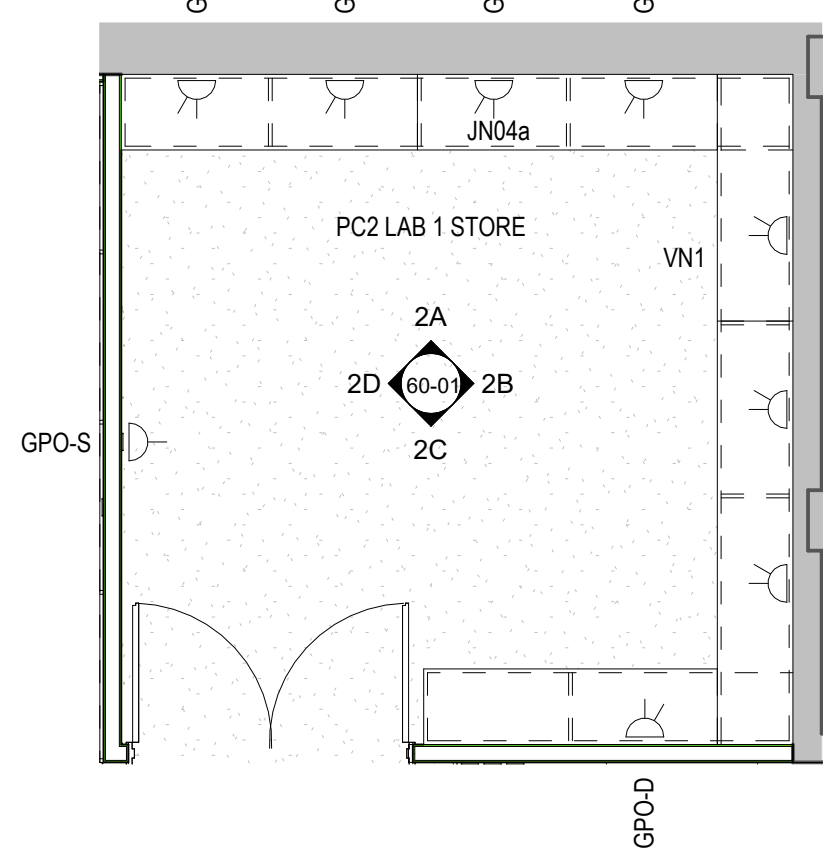

2 PC2 LAB 1 STORE PLAN
21-10 1 : 50

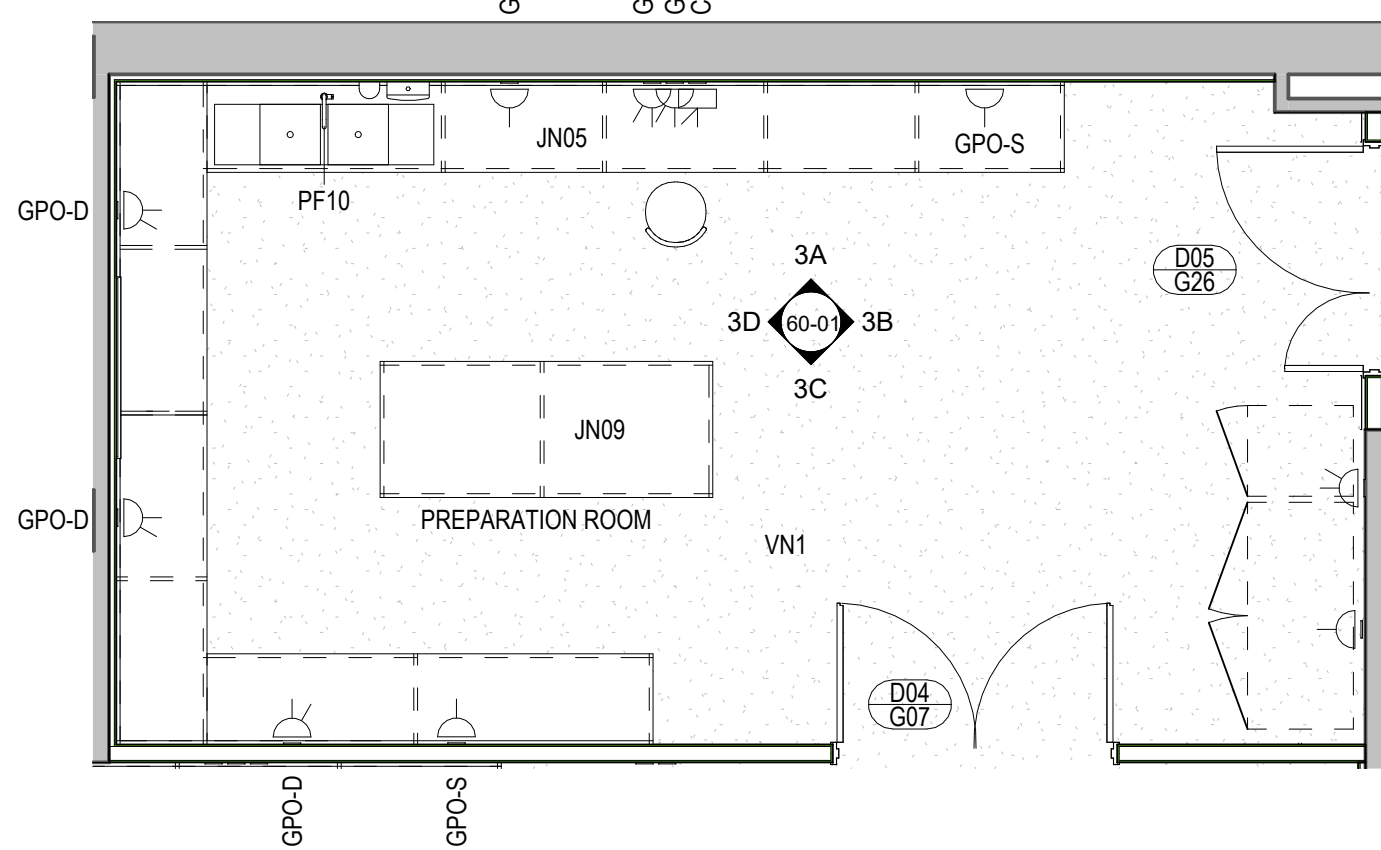


3 PREPARATION ROOM PLAN
21-10 1 : 50

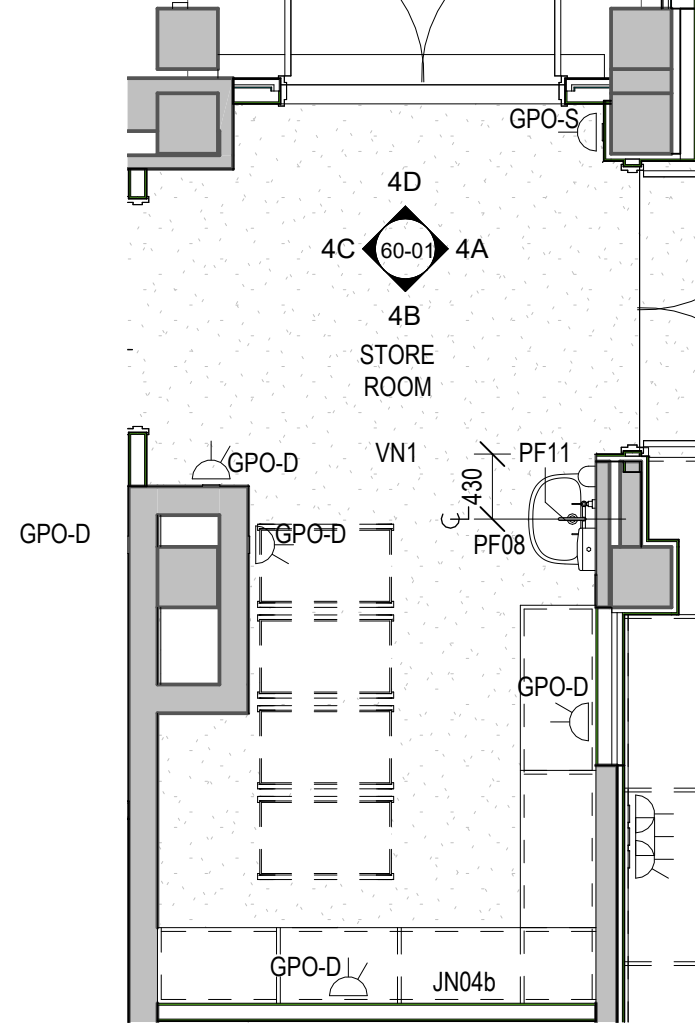


4 STORE ROOM
21-10 1 : 50


LEGEND	
AC11	SOAP DISPENSER- PWD
AC12	PAPER TOWEL DISPENSER- SURFACE MOUNTED
CA1	CARPET- TYPE 1
CH02	MEETING CHAIR
CO-D	COMMUNICATIONS OUTLET DOUBLE
GPO-D	DOUBLE GPO
GPO-S	SINGLE GPO
JN04a	JOINERY - REFER TO JOINERY DETAIL DRAWINGS
JN04b	JOINERY - REFER TO JOINERY DETAIL DRAWINGS
JN05	JOINERY - REFER TO JOINERY DETAIL DRAWINGS
JN09	JOINERY - REFER TO JOINERY DETAIL DRAWINGS
PF02	KITCHENETTE SINK
PF08	
PF10	LABORATORY TAP
PF11	LABORATORY TAP (WALL MOUNTED)
PTD2	DOOR PAINT FINISH TYPE 2
SKT1	SKIRTING TYPE 1
SKT2	SKIRTING TYPE 2
TA01	MEETING TABLES
VN1	VINYL FINISH- TYPE 1
WV1	WALL VINYL- TYPE 1

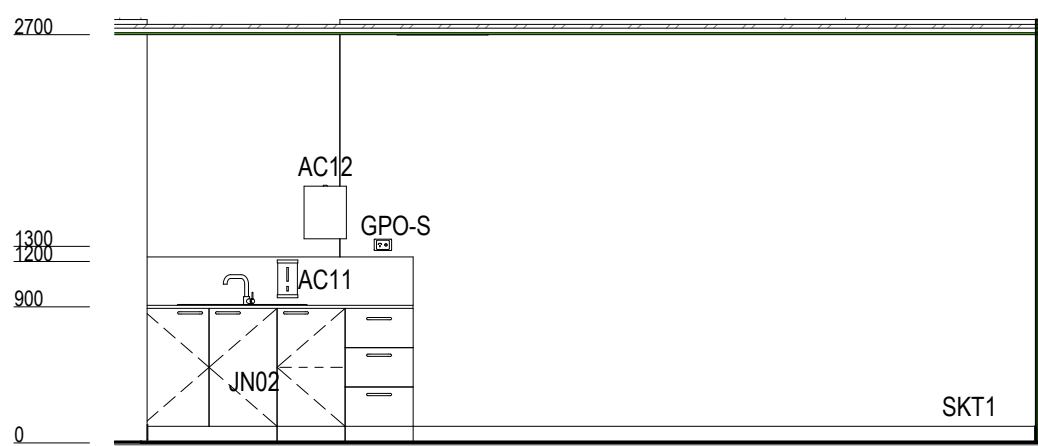


1A ELEVATION
1 : 50

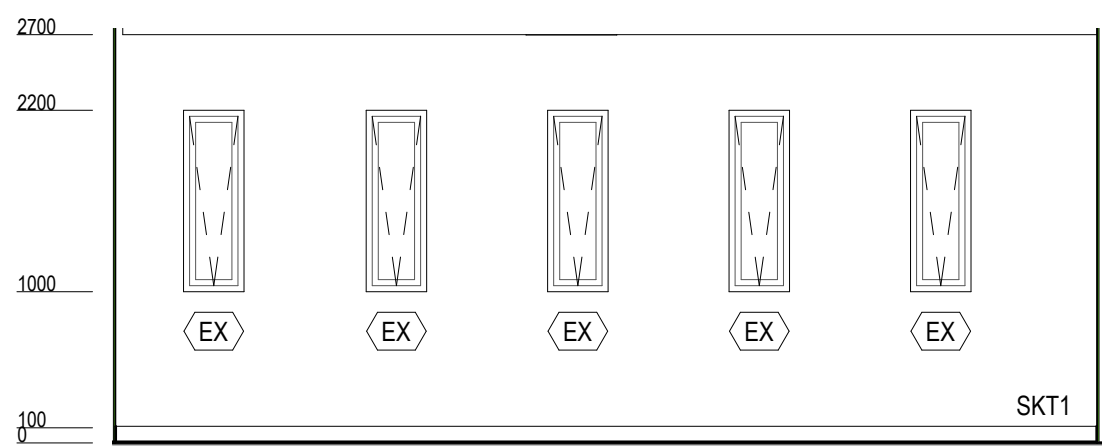


1B ELEVATION
1 : 50

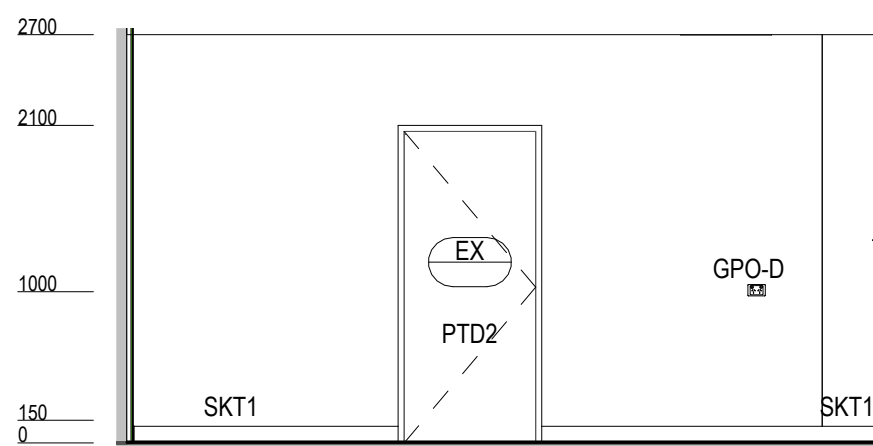


1C ELEVATION
1 : 50

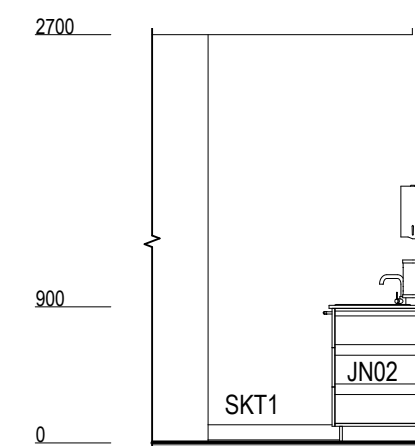


1D ELEVATION
1 : 50

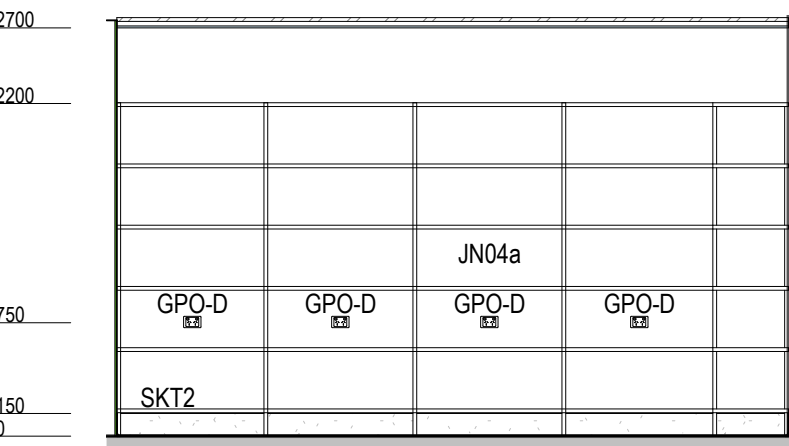


2A ELEVATION
1 : 50

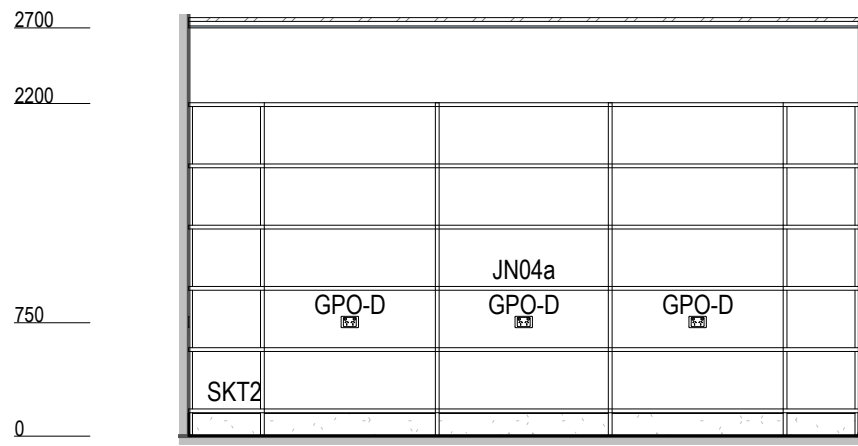


2B ELEVATION
1 : 50

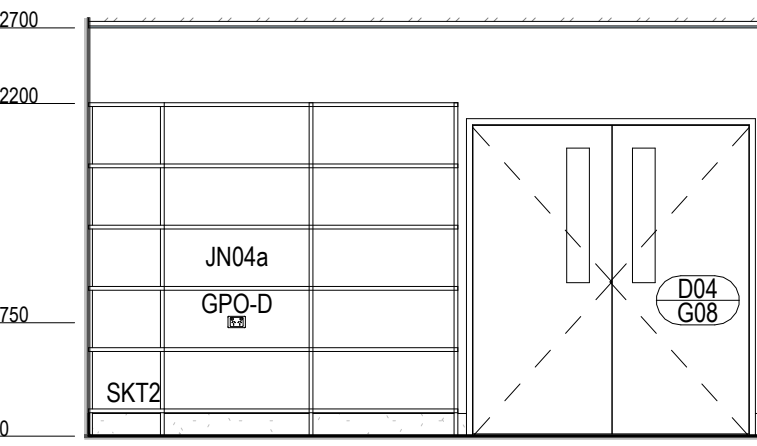


2C ELEVATION
1 : 50

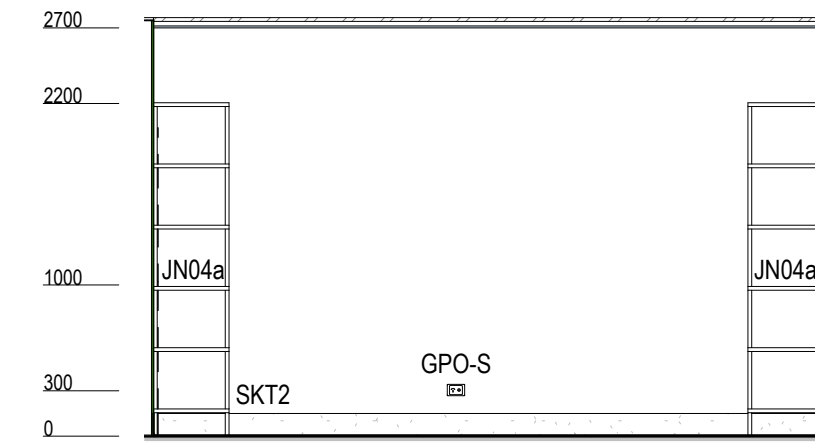


2D ELEVATION
1 : 50

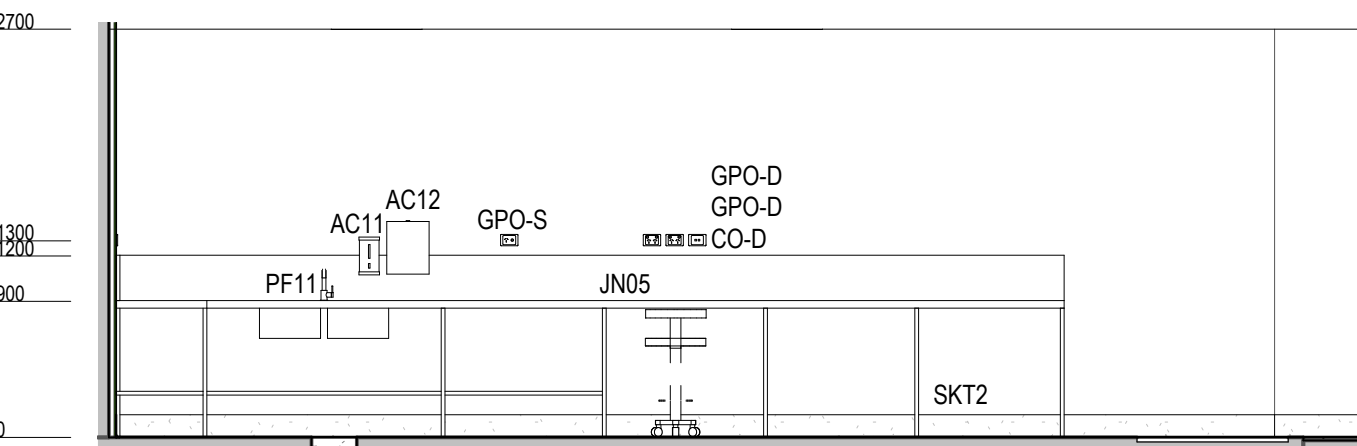


3A ELEVATION
1 : 50

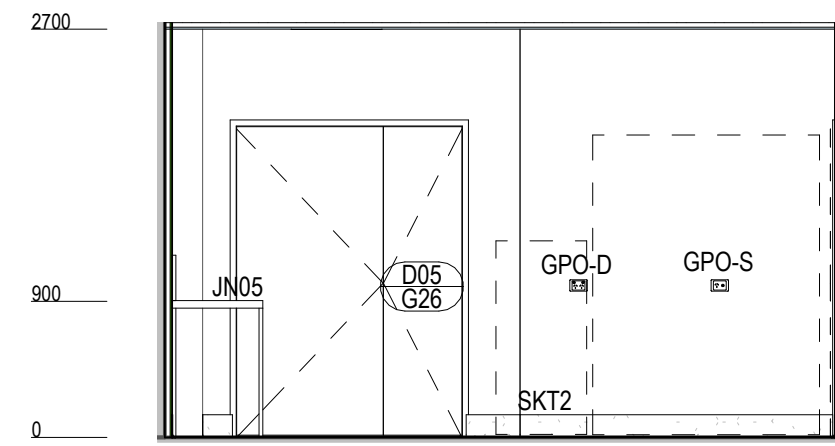


3B ELEVATION
1 : 50

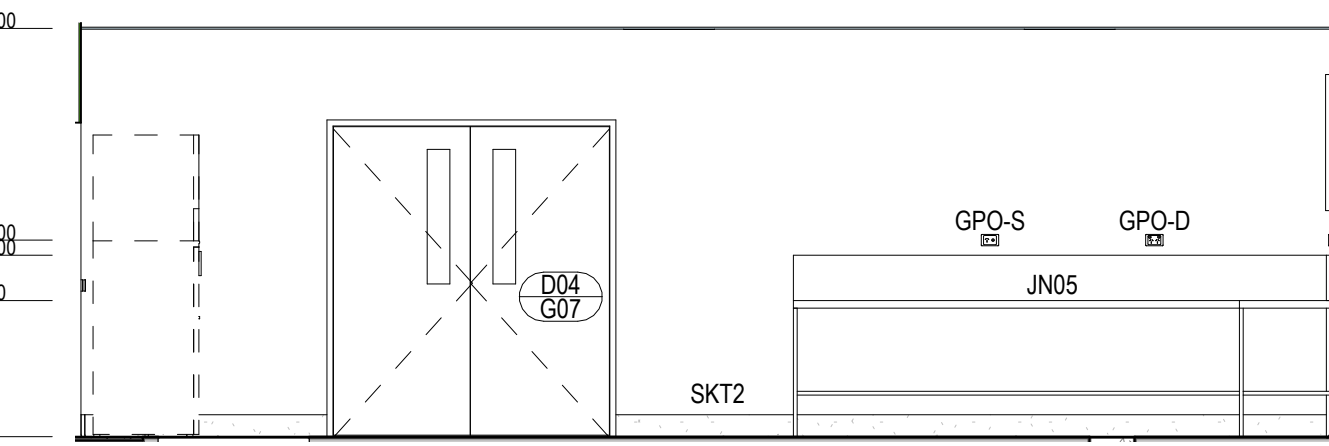


3C ELEVATION
1 : 50

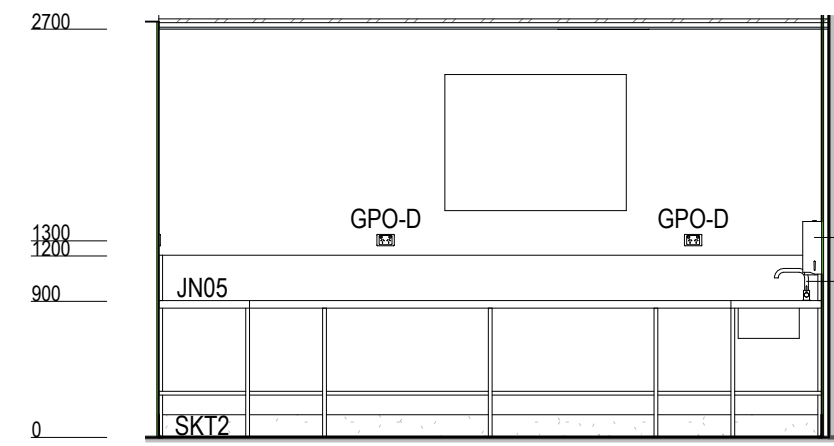


3D ELEVATION
1 : 50

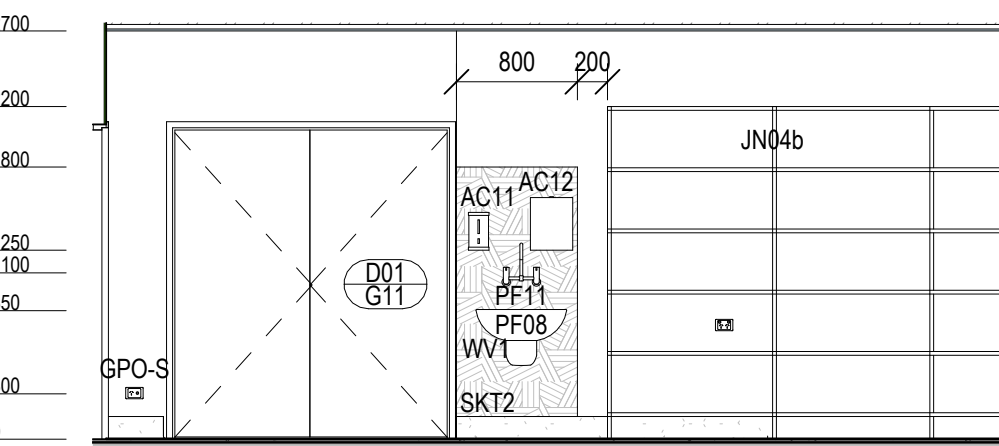


4A ELEVATION
1 : 50

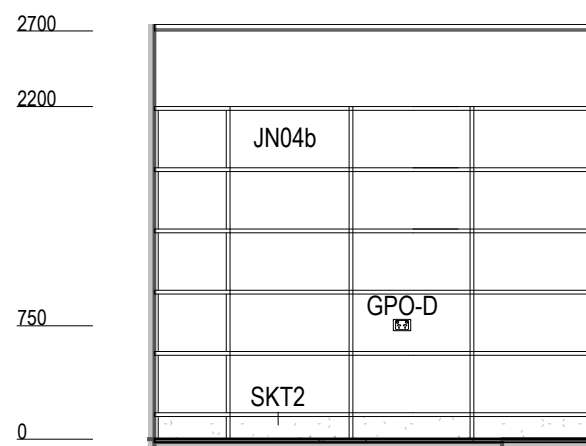

4B ELEVATION
1 : 50

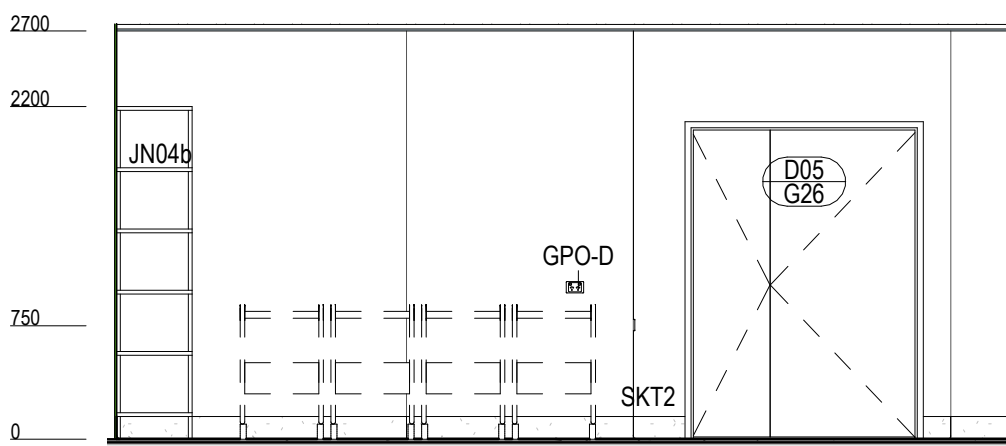

4C ELEVATION
1 : 50

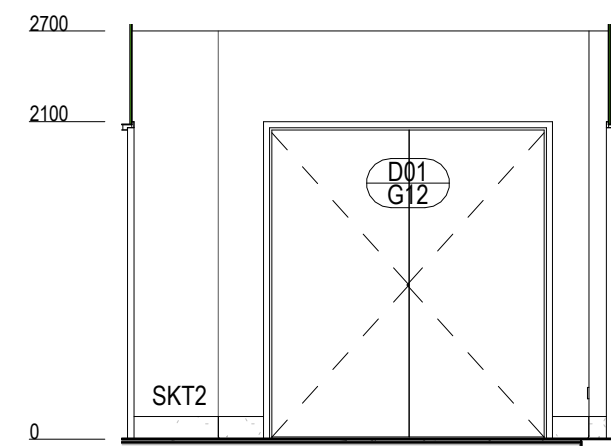

4D ELEVATION
1 : 50

AS CONSTRUCTED



© Copyright
These drawings and designs and the copyright thereof are the property of Thomson Adsett Pty Ltd and must not be used, retained or copied without written permission of Thomson Adsett Pty Ltd. ABN 76 105 314 654 Trading as ThomsonAdsett. Dimensions take precedence over scaling. Do not measure off drawings as print sizes may vary

554/700 YAAMBA ROAD,
NORMAN GARDENS QLD 4701

for
CQUniversity
NORTH ROCKHAMPTON CAMPUS
& GIRVAN



GIRVAN

B	25/06/2024	AS CONSTRUCTED	PB
A	02/02/2024	IFC	PB
	25/01/2024	AMENDED FUME CUPBOARD SIZING	PB
8	20/12/2023	REVISED ISSUE	PB
7	19/12/2023	REVISED ISSUE	PB
6	24/11/2023	REVISED ISSUE	PB
5	06/11/2023	REVISED ISSUE	AP
4	20/09/2023	ISSUE FOR INFORMATION	WL
3	11/09/2023	AMENDED 60% DD ISSUE	PB
2	28/08/2023	60% DD ISSUE	WL
1	04/08/2023	PRELIMINARY ISSUE	WL
rev	date	details	in

drawn	date
WL	JUL 2023
checked	date
NC	JUL 2023
verified	date
IGK	DEC 2023

scale 







INTERNAL ELEVATIONS - SHEET 2

scale project no.
1 : 50 @ A1 23.0078.17

sheet no. **CQU-ROK-033-GN-ARC-60-02**


B

original sheet size - A1 (594mm x 841mm)

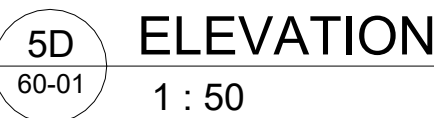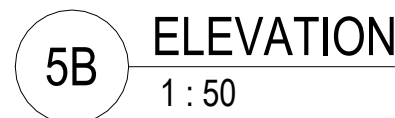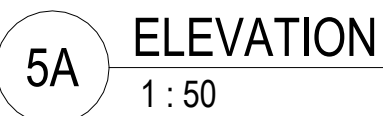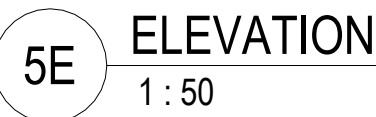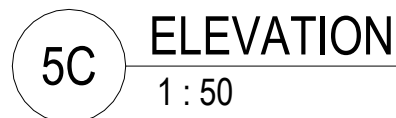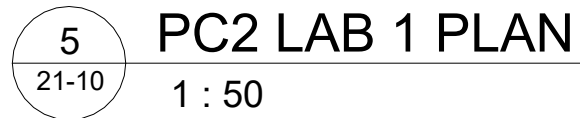


AS CONSTRUCTED

C:\REVIT\LOCALFILES\23.0078.17_CQU Building 33 Redevelopment_2023_Philip.Bugden.rvt

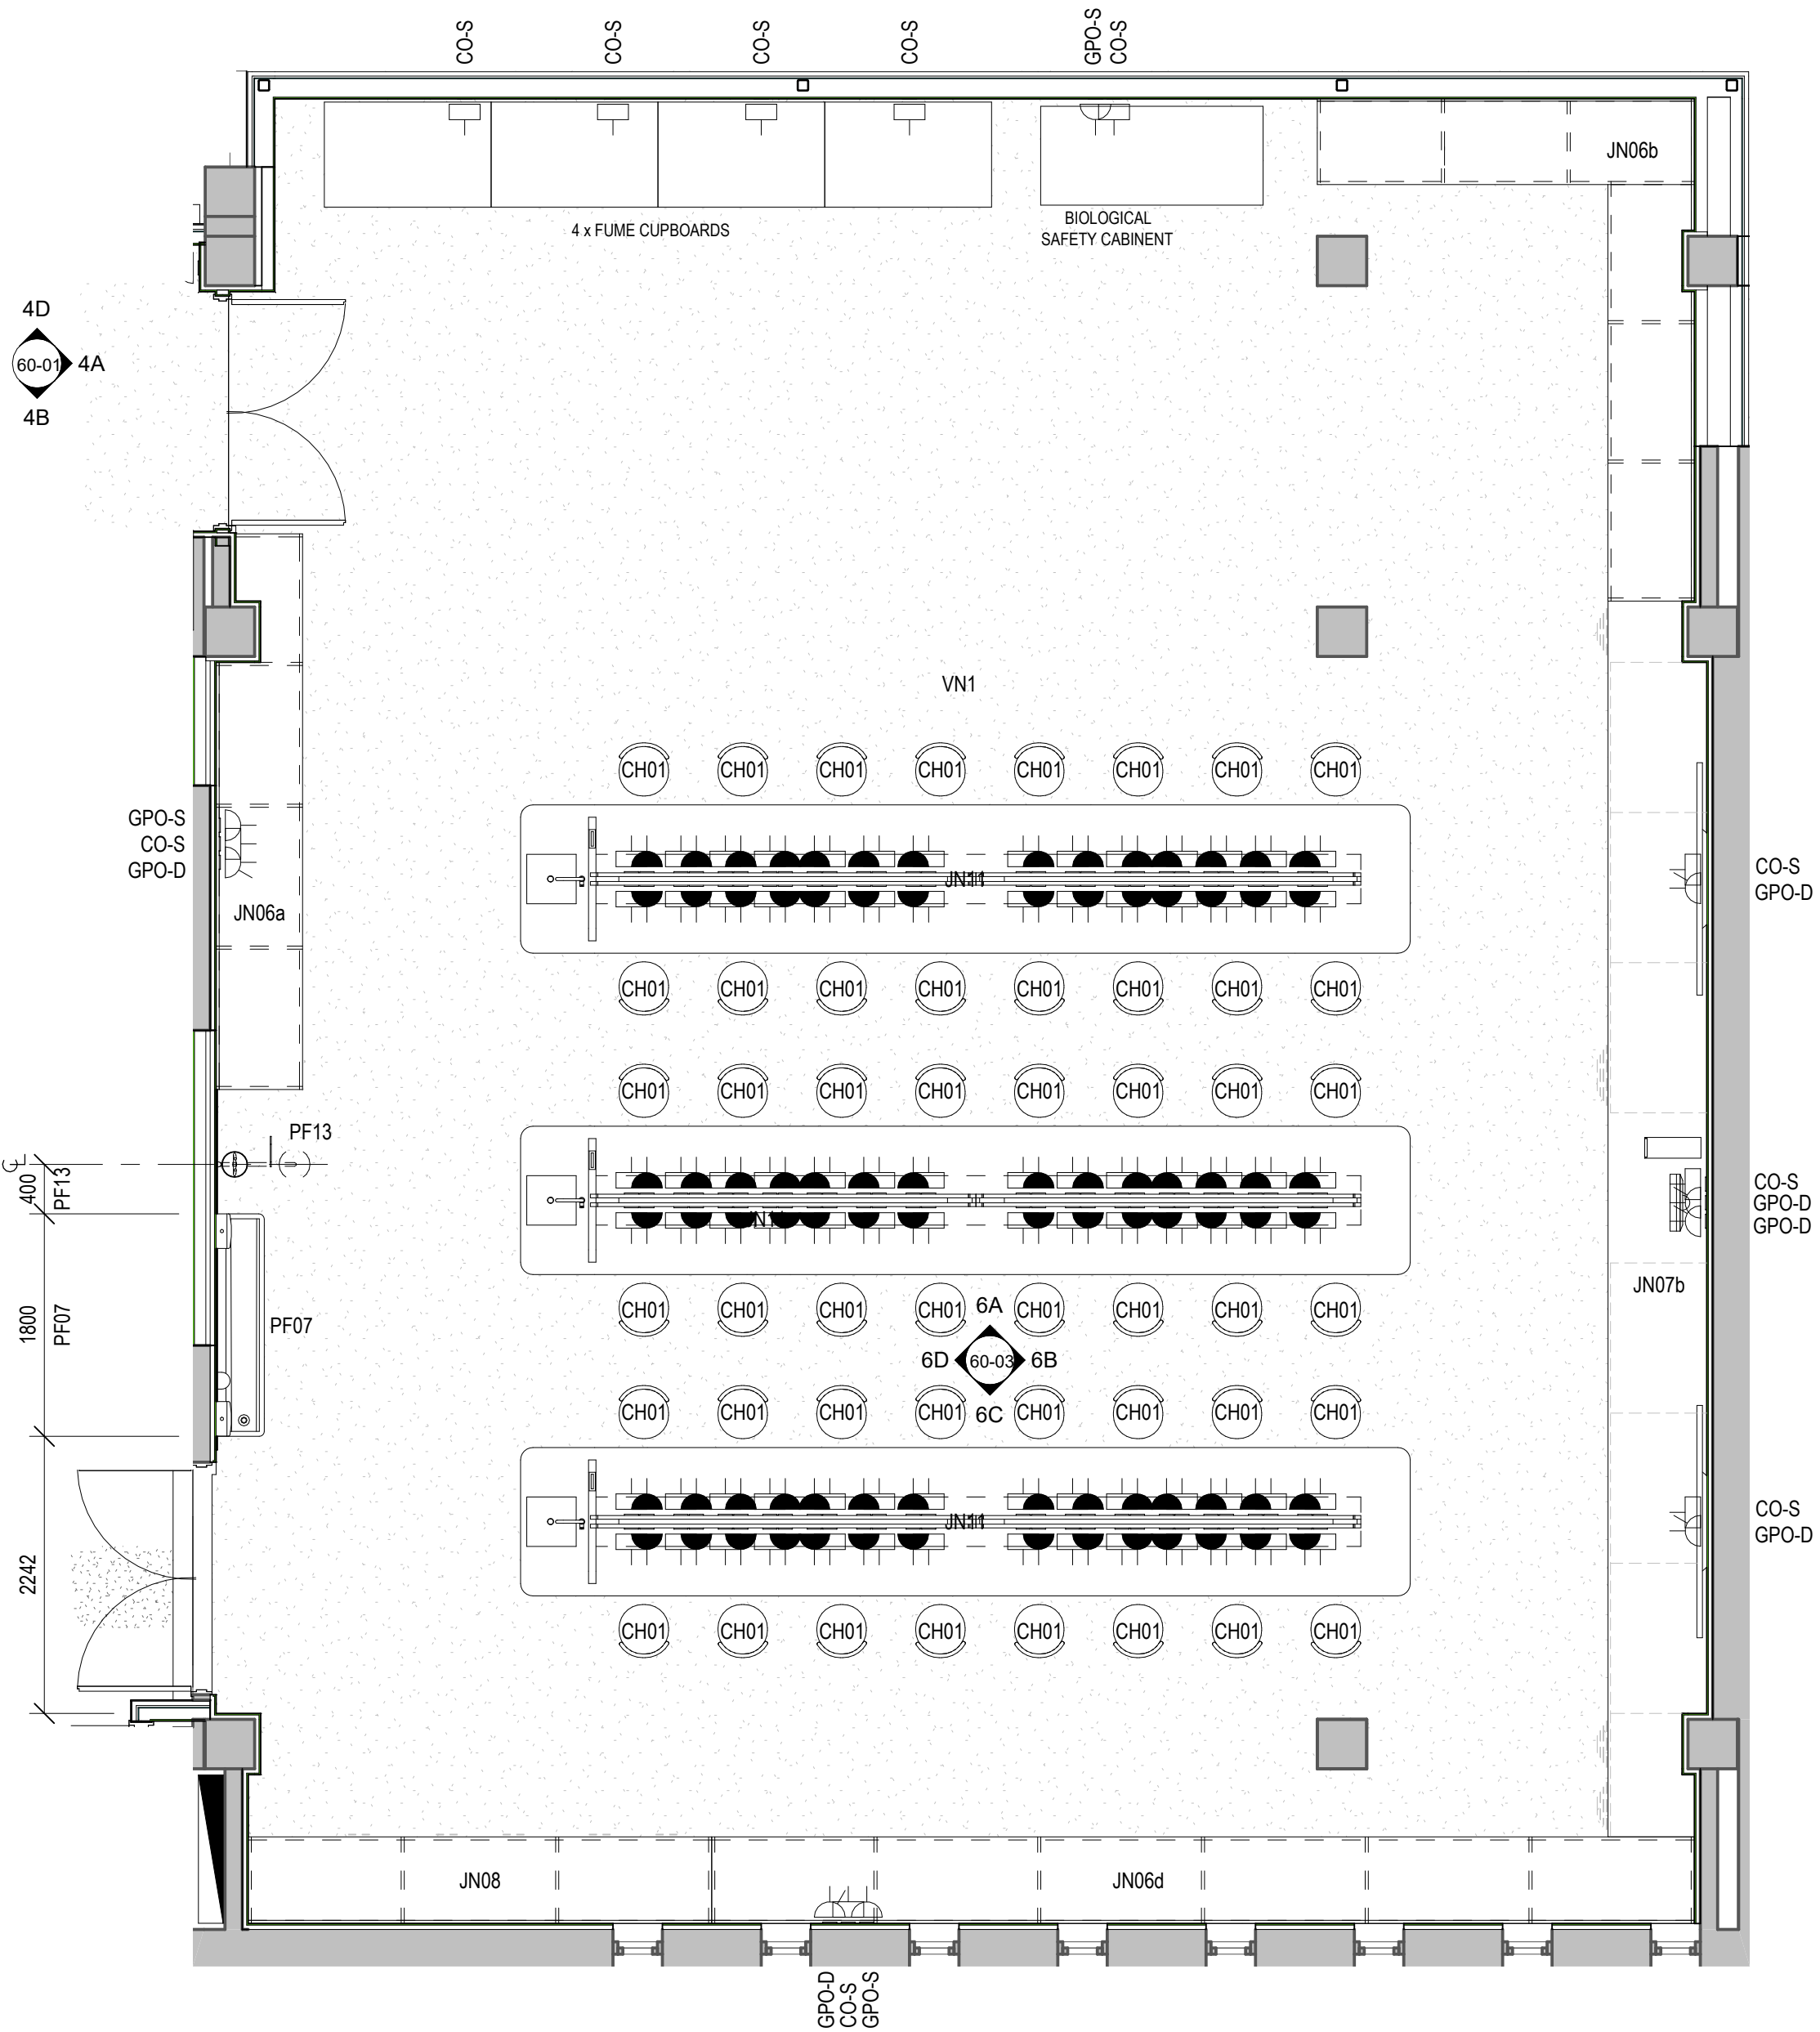


6 PC2 LAB 2 PLAN
1 : 50


LEGEND	
AC11	SOAP DISPENSER- PWD
AC12	PAPER TOWEL DISPENSER- SURFACE MOUNTED
CH01	STOOL- GAS LIFT
CO-S	COMMUNICATIONS OUTLET SINGLE
GPO-D	DOUBLE GPO
GPO-S	SINGLE GPO
JN06a	JOINERY - REFER TO JOINERY DETAIL DRAWINGS
JN06b	JOINERY - REFER TO JOINERY DETAIL DRAWINGS
JN06d	JOINERY - REFER TO JOINERY DETAIL DRAWINGS
JN07b	JOINERY - REFER TO JOINERY DETAIL DRAWINGS
JN08	JOINERY - REFER TO JOINERY DETAIL DRAWINGS
JN11	JOINERY - REFER TO JOINERY DETAIL DRAWINGS
JN12	JOINERY - REFER TO JOINERY DETAIL DRAWINGS
PF07	HAND WASH TROUGH
PF13	EMERGENCY SHOWER/ EYE WASH STATION
SKT2	SKIRTING TYPE 2
TV	TELEVISION BY CLIENT
VN1	VINYL FINISH- TYPE 1
WV1	WALL VINYL-TYPE 1

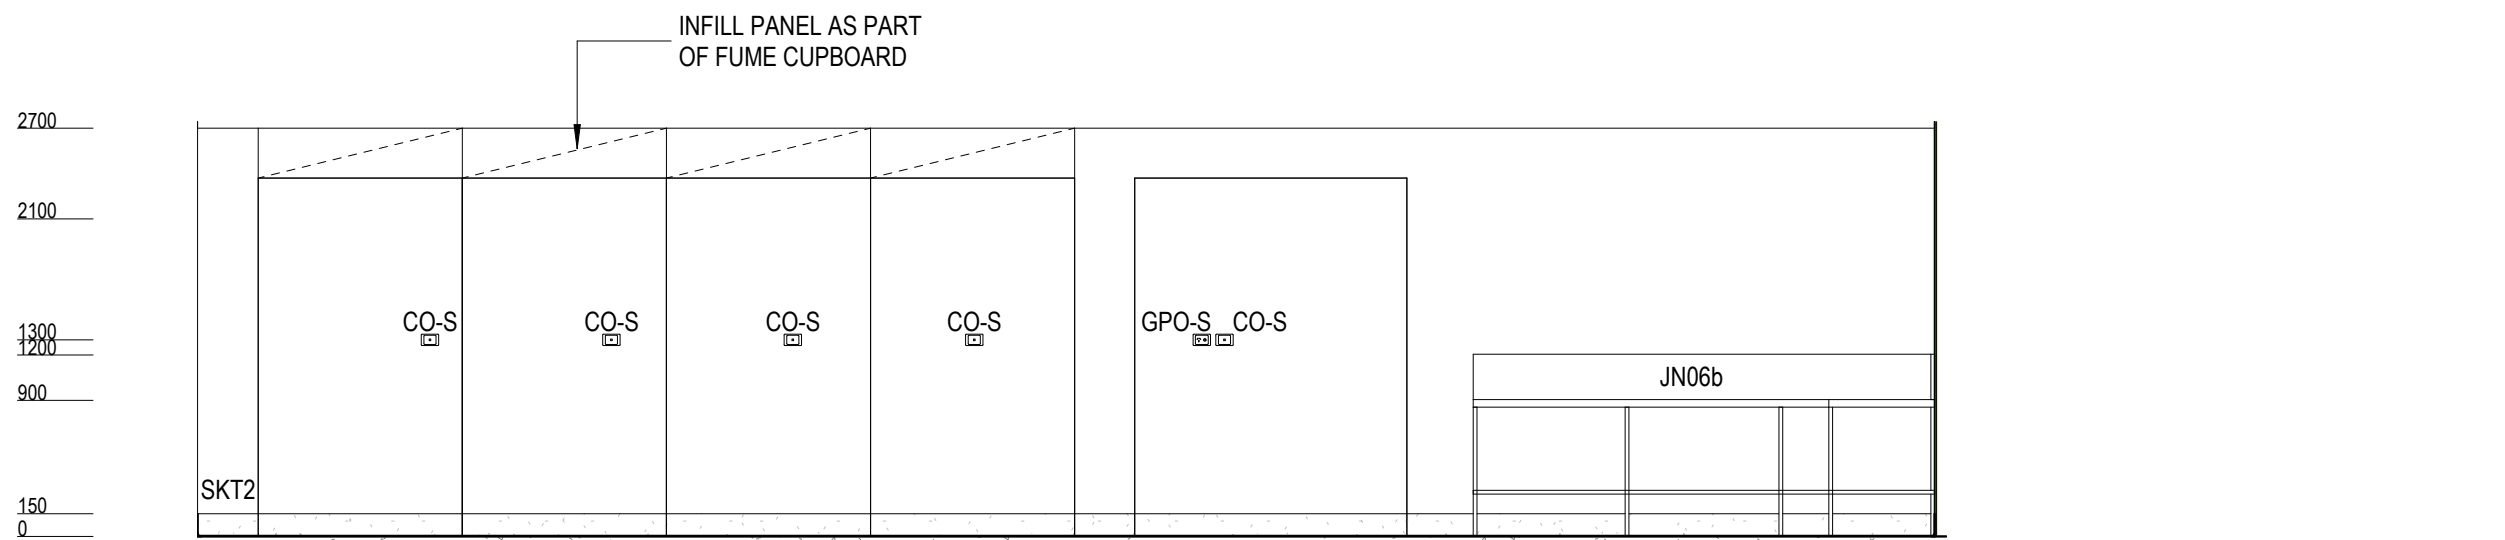


6A ELEVATION
1 : 50

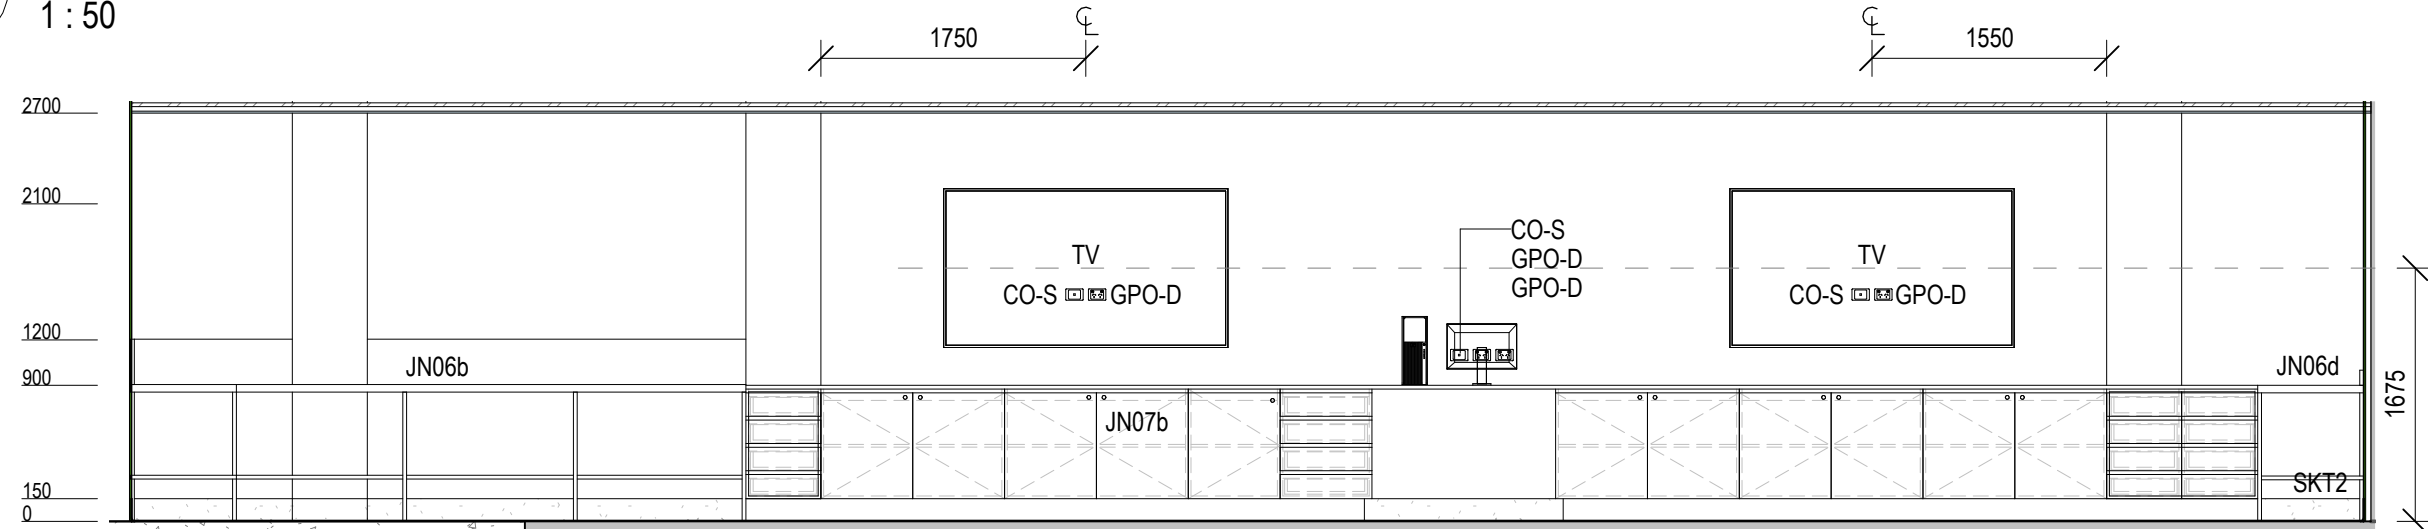

6B ELEVATION
1 : 50

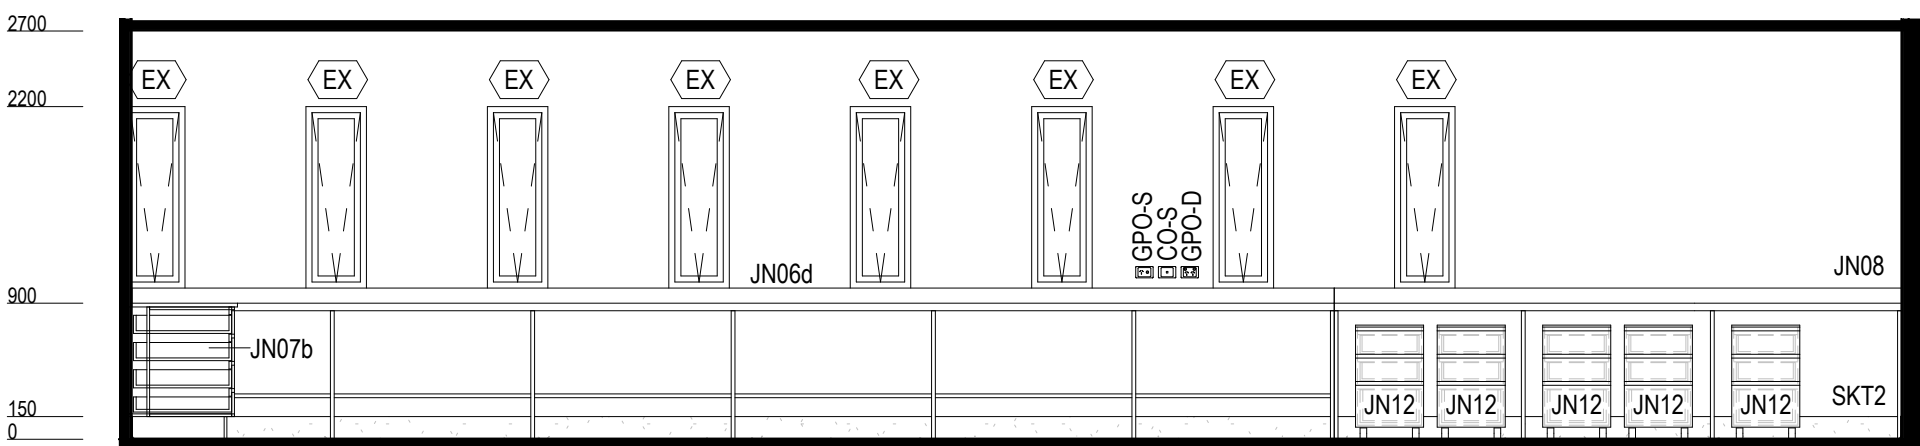

6C ELEVATION
1 : 50

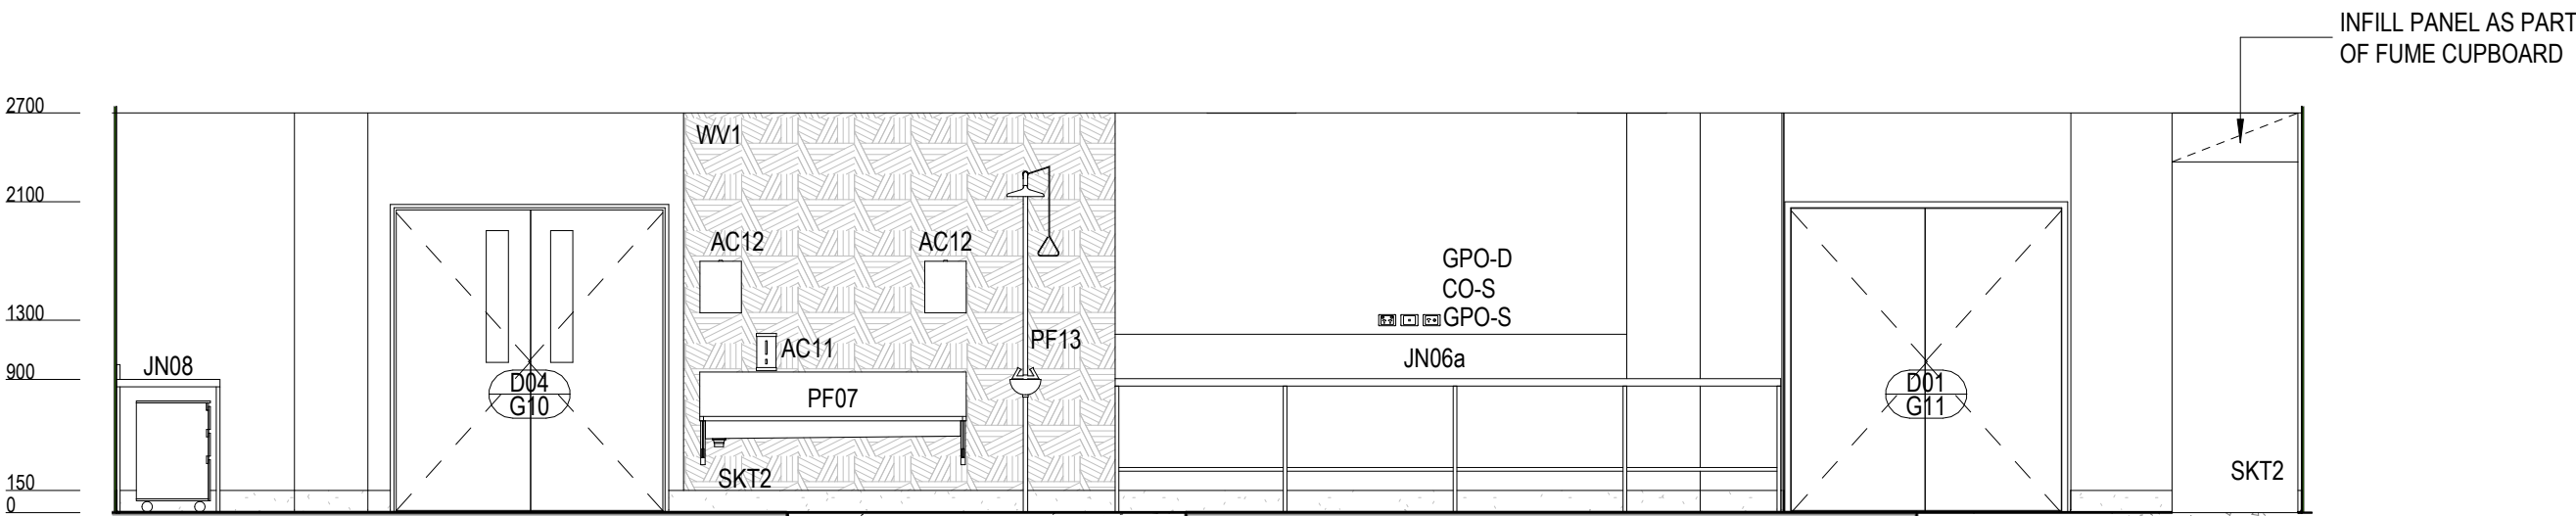

6D ELEVATION
1 : 50

BUILDING 33 REDEVELOPMENT

554/700 YAAMBA ROAD,
NORMAN GARDENS QLD 4701

for
CQUUniversity
NORTH ROCKHAMPTON CAMPUS
& GIRVAN



GIRVAN

B	25/06/2024	AS CONSTRUCTED	PB
A	02/02/2024	IFC	PB
8	25/01/2024	AMENDED FUME CUPBOARD SIZEING	PB
7	19/12/2023	REVISED ISSUE	PB
6	24/11/2023	REVISED ISSUE	PB
5	06/11/2023	REVISED ISSUE	AP
4	20/09/2023	ISSUE FOR INFORMATION	WL
3	11/09/2023	AMENDED 60% DD ISSUE	PB
2	28/08/2023	60% DD ISSUE	WL
1	04/08/2023	PRELIMINARY ISSUE	WL

rev/	date	details	init.
drawn	date		
WL	JUL 2023		
checked	date		
NC	JUL 2023		
verified	date		
GK	DEC 2023		

scale


INTERNAL ELEVATIONS - SHEET 3

scale project no.
1 : 50 @ A1 23.0078.17


sheet no.
CQU-ROK-033-GN-ARC-60-03

revision
B

AS CONSTRUCTED

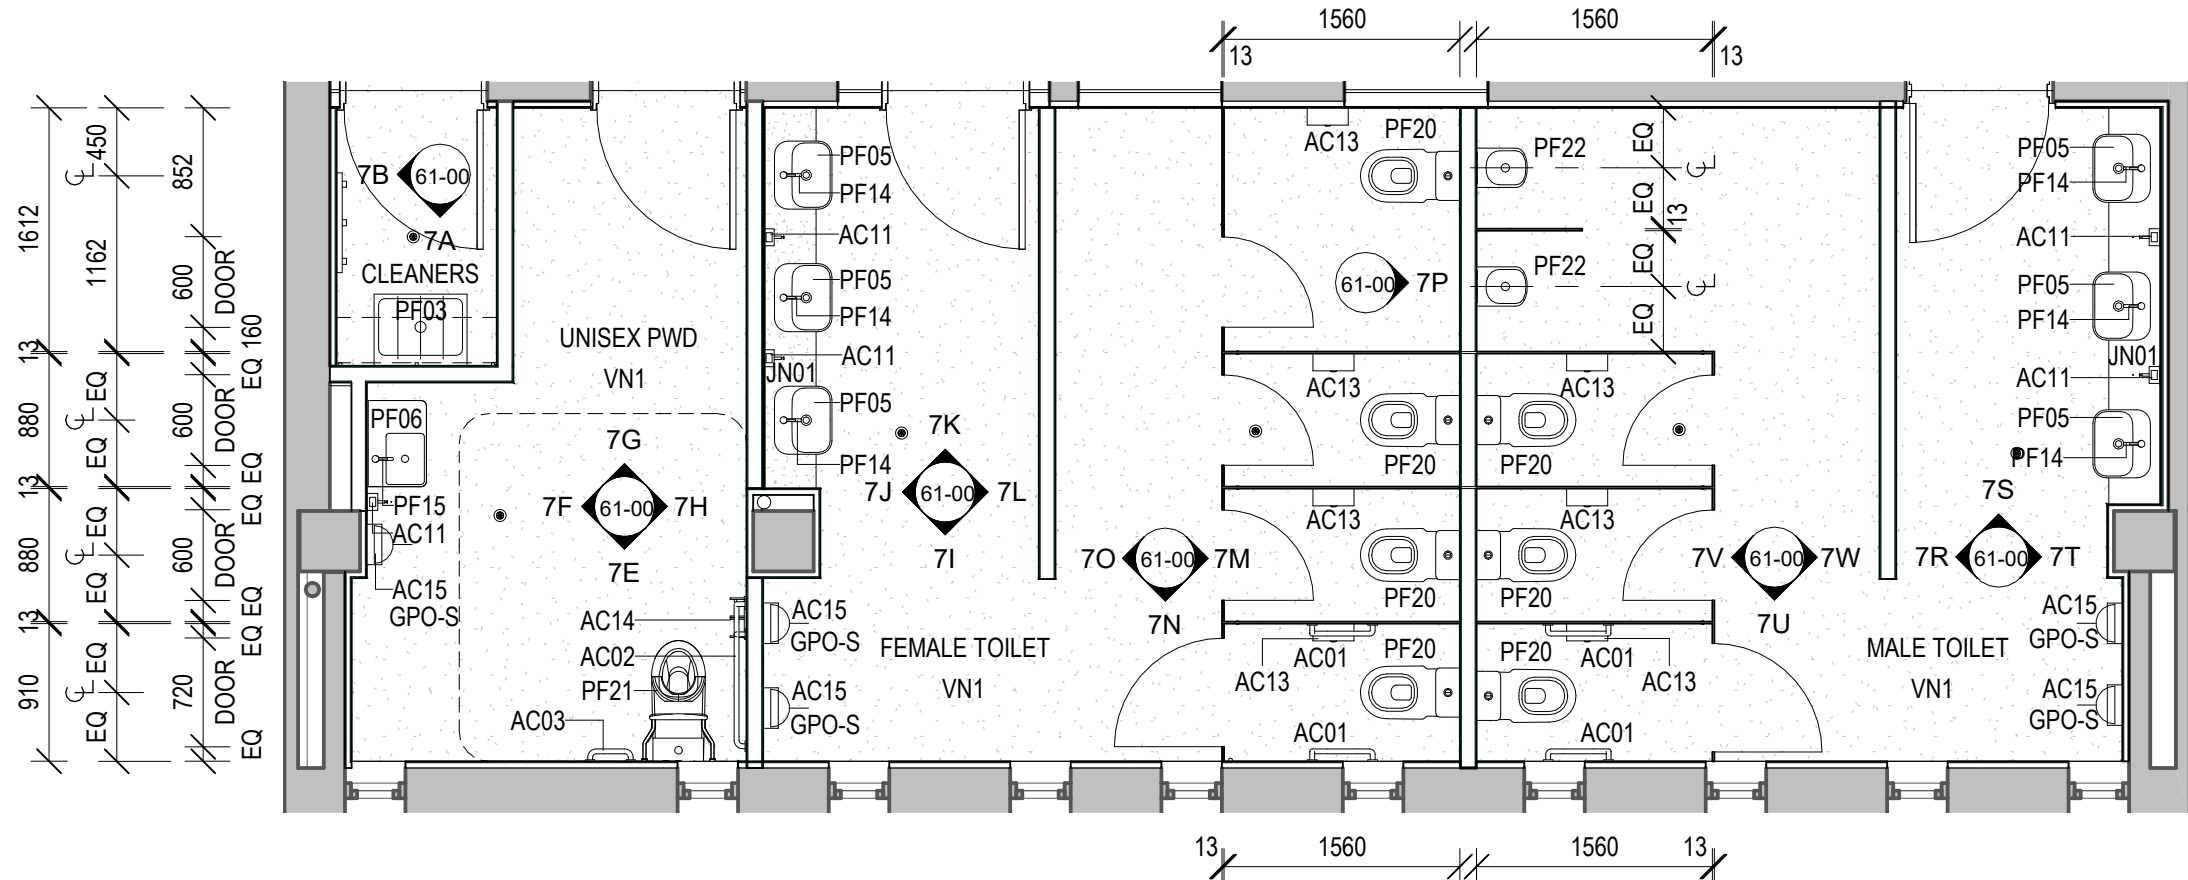


7 AMENITIES PLAN
21-10
1:50

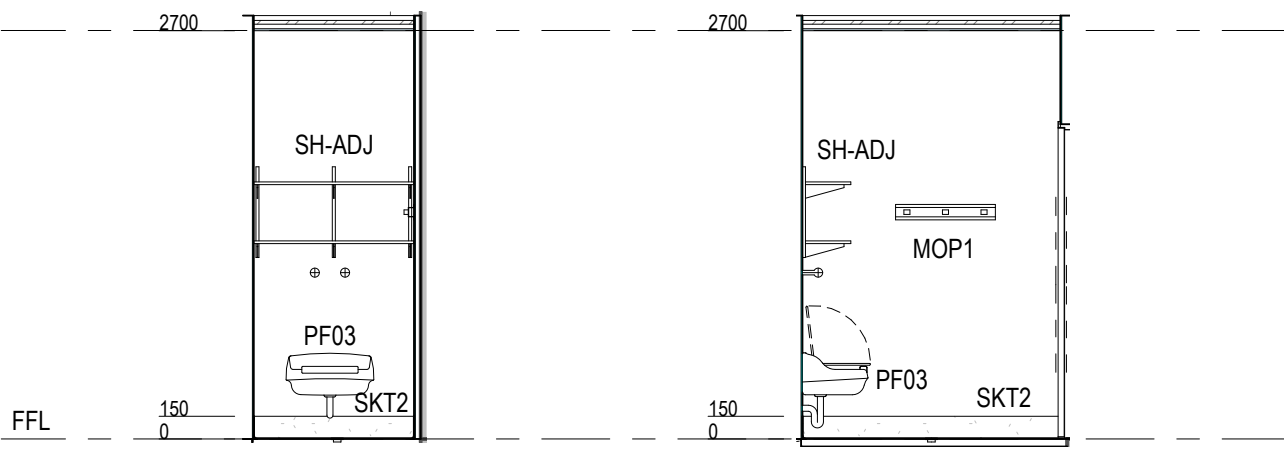


7A ELEVATION
1:50


7B ELEVATION
1:50

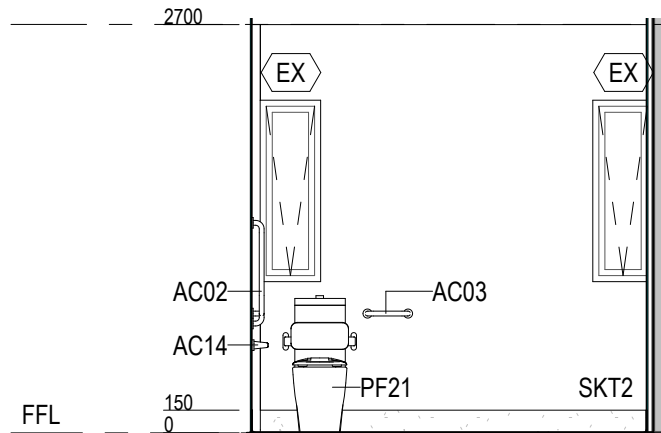


7E ELEVATION
1:50

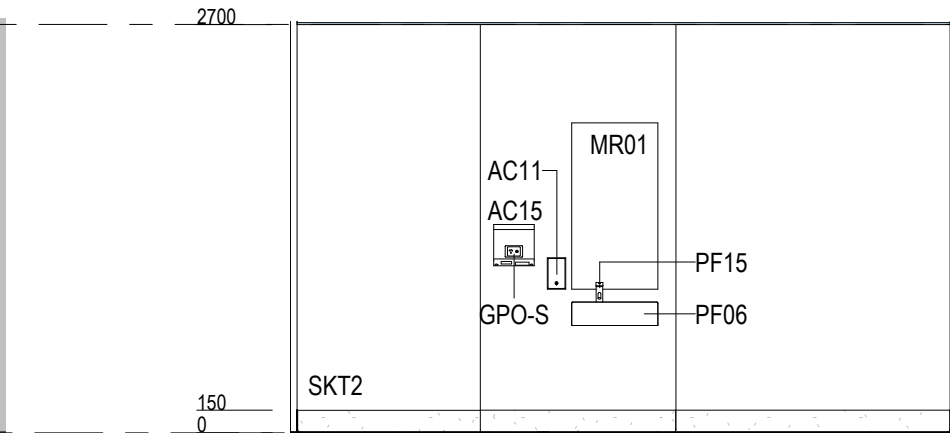


7F ELEVATION
1:50

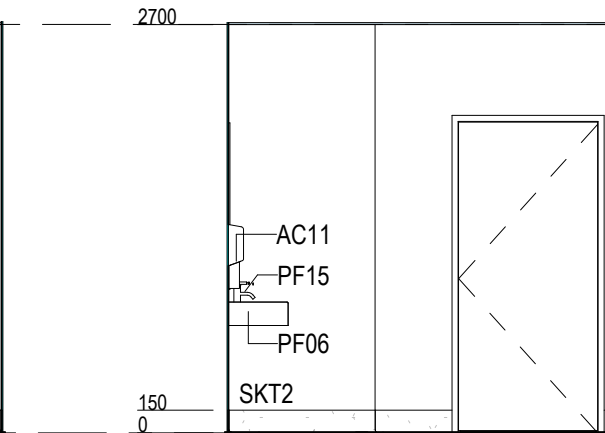


7G ELEVATION
1:50

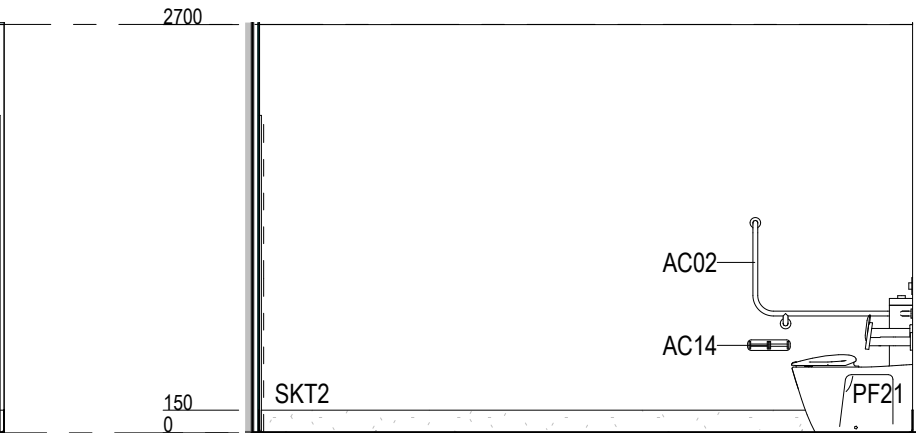


7H ELEVATION
1:50

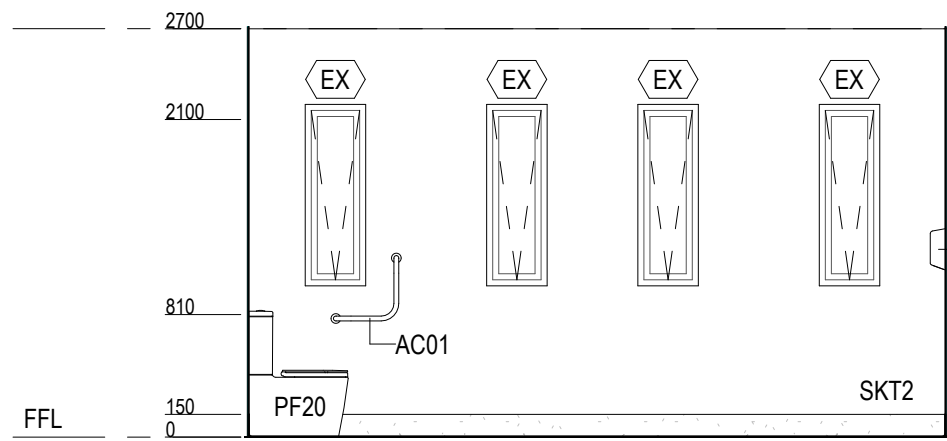


7I ELEVATION
1:50

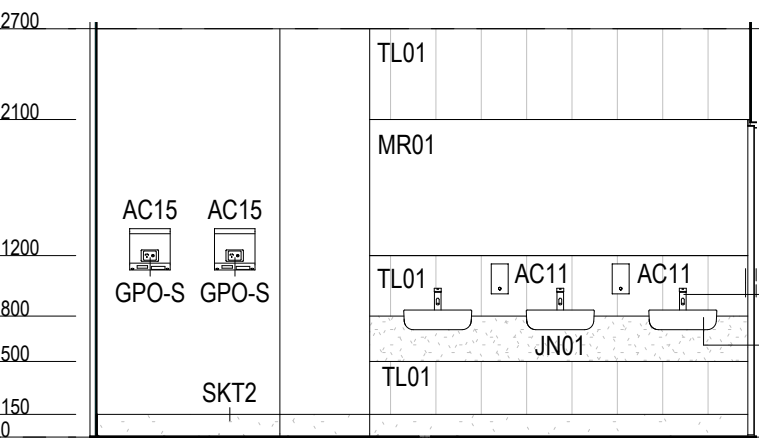


7J ELEVATION
1:50

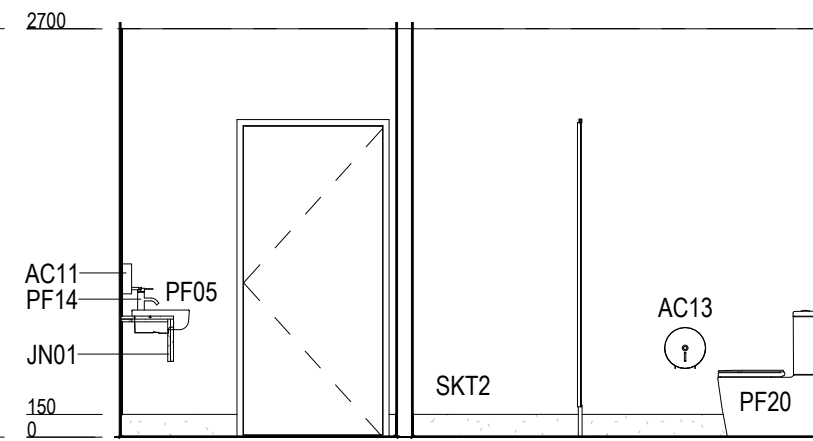


7K ELEVATION
1:50

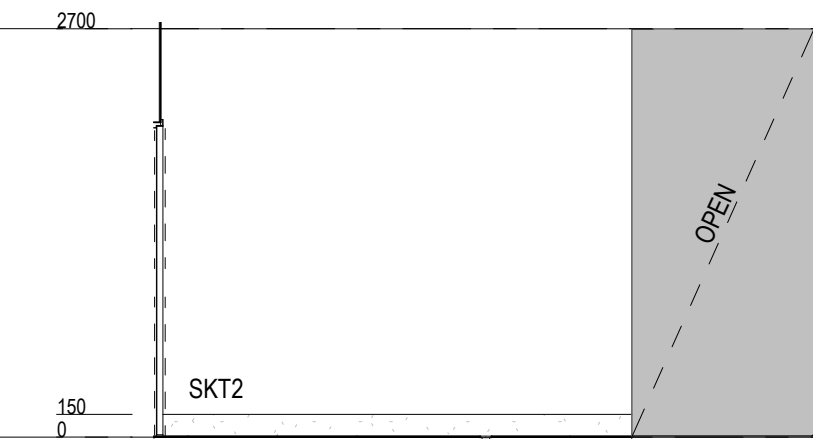


7L ELEVATION
1:50

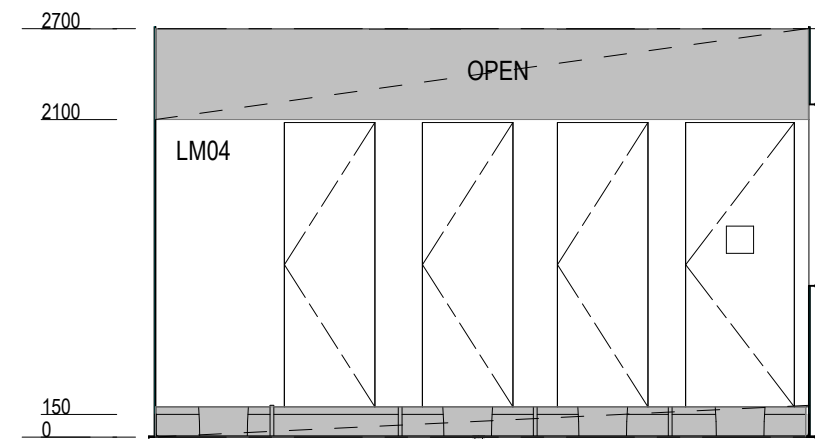


7M ELEVATION
1:50

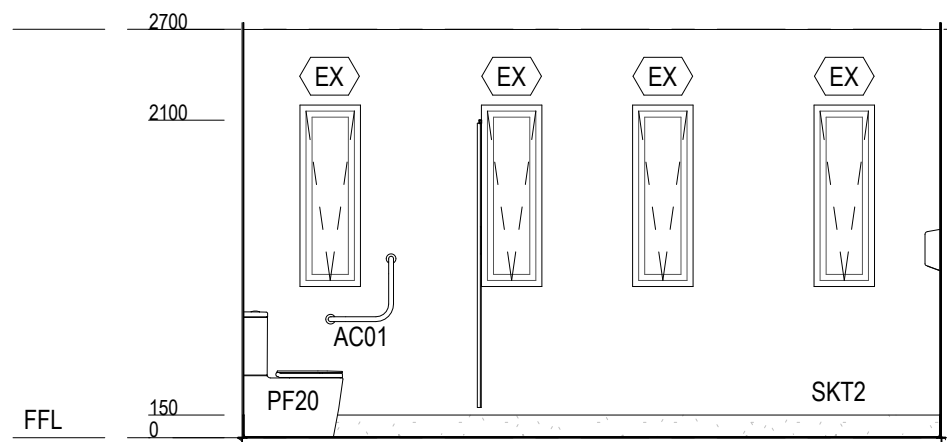


7N ELEVATION
1:50

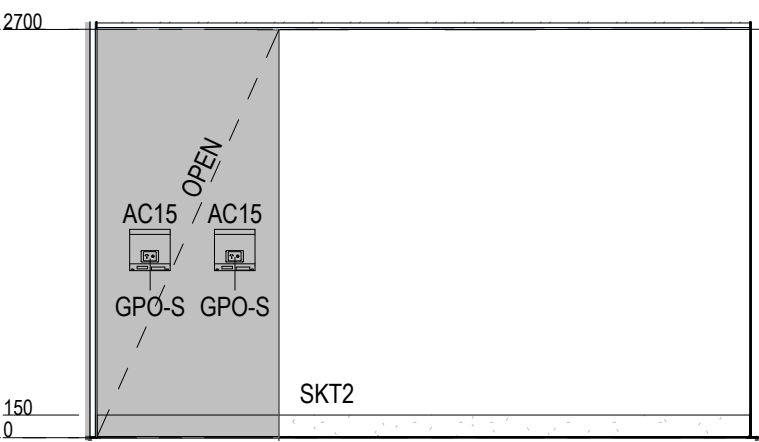


7O ELEVATION
1:50

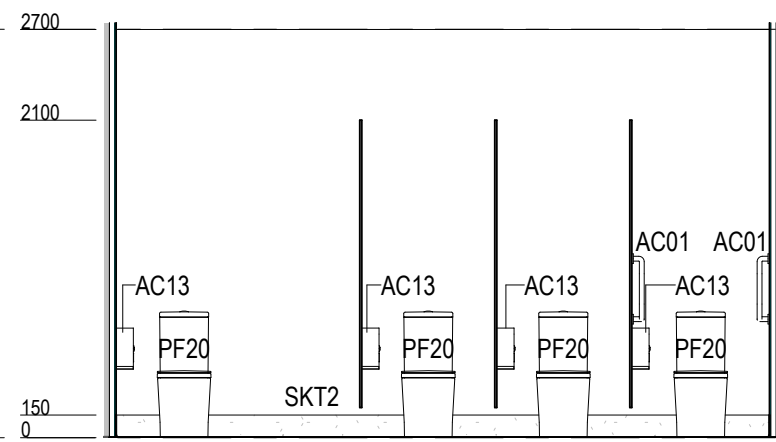


7P ELEVATION
1:50

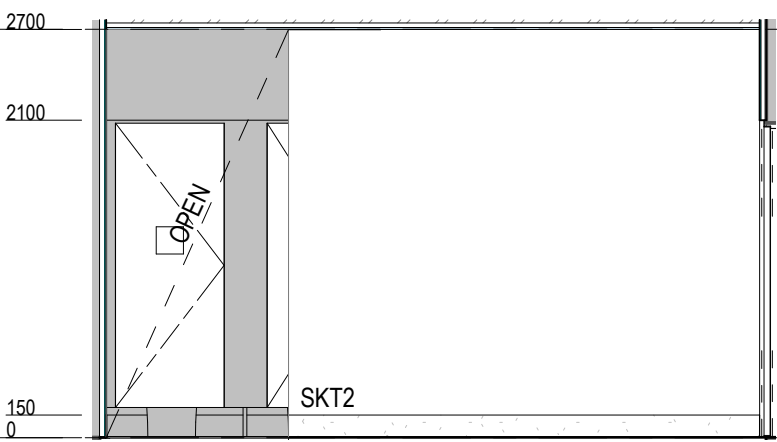


7R ELEVATION
1:50

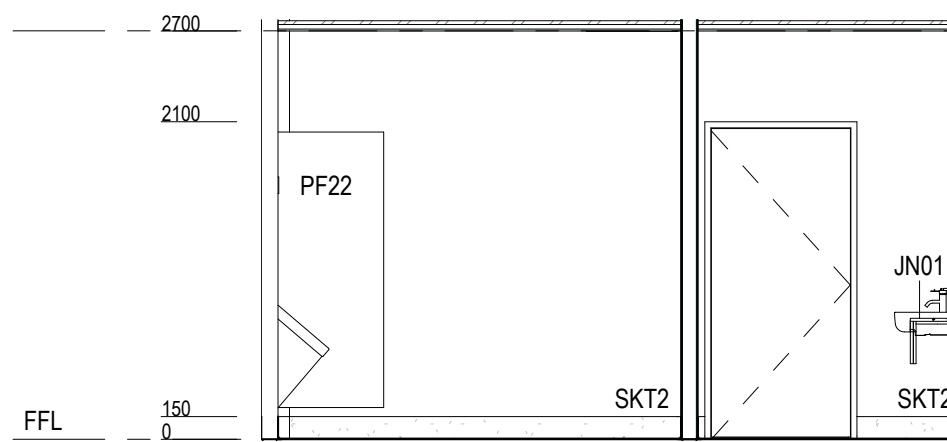


7S ELEVATION
1:50

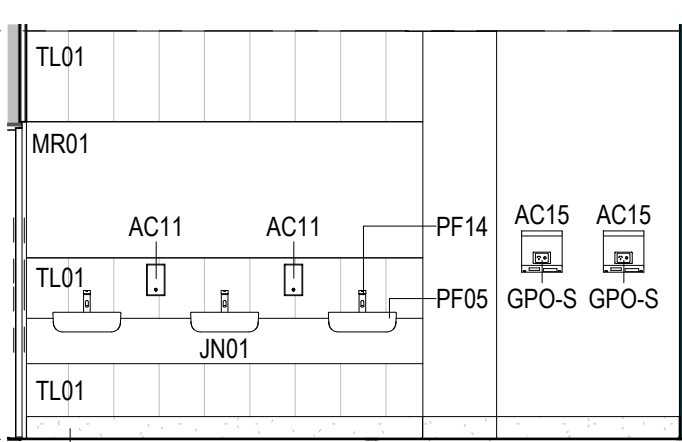


7T ELEVATION
1:50

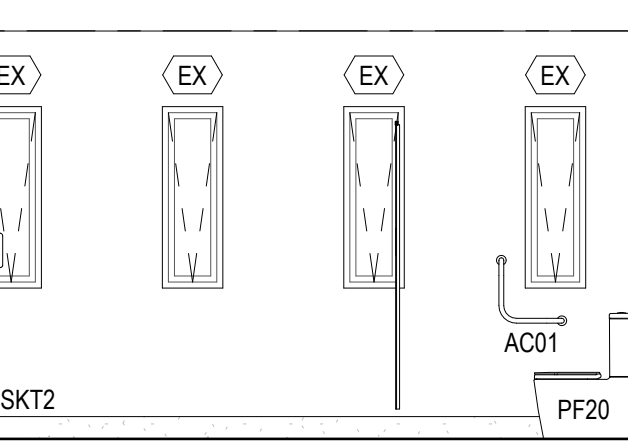

7U ELEVATION
1:50

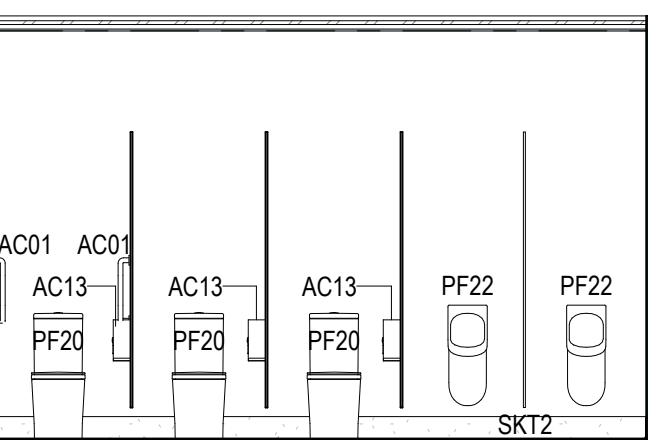

7V ELEVATION
1:50

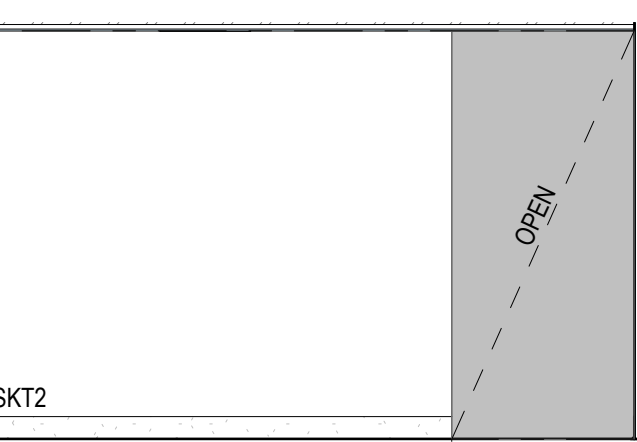

7W ELEVATION
1:50

LEGEND	
AC01	GRAB RAIL- TYPE 1
AC02	GRAB RAIL- TYPE 2
AC03	GRAB RAIL- TYPE 3
AC11	SOAP DISPENSER- PWD
AC13	TOILET ROLL HOLDER
AC14	TOILET ROLL HOLDER
AC15	HAND DRYER
GPO-S	SINGLE GPO
JN01	JOINERY - REFER TO JOINERY
LM04	DETAIL DRAWINGS
LM04	LAMINATE FINISH AS SCHEDULED
MOP1	MIRROR TYPE 1
MR01	MIRROR TYPE 1
PF03	CLEANER SINK
PF05	SEMI RECESSED BASIN
PF06	DISABLED COMPLAINT BASIN
PF14	BASIN SELF-CLOSING TAP
PF15	PWD BASIN TAP
PF20	WC
PF21	PWD/WC
PF22	URINALS
SH-ADJ	
SKT2	SKIRTING TYPE 2
TL01	WALL TILE- TYPE 1
VN1	VINYL FINISH- TYPE 1

Telephone +61 7 3840 9999
bne@thomsonadsett.com
Level 9, 470 St Pauls Terrace
Fortitude Valley
Qld 4006 Australia
thomsonadsett.com

© Copyright
These drawings and designs and the copyright thereof are the property of Thomson Adsett Pty Ltd and must not be used, retained or copied without written permission of Thomson Adsett Pty Ltd. ABN 76 105 314 654 Trading as ThomsonAdsett. Dimensions take precedence over scaling. Do not measure off drawings as print sizes may vary

BUILDING 33 REDEVELOPMENT

554/700 YAAMBA ROAD,
NORMAN GARDENS QLD 4701

for
CQUUniversity
NORTH ROCKHAMPTON CAMPUS
& GIRVAN



GIRVAN

B	25/06/2024	AS CONSTRUCTED	PB
A	02/02/2024	IFC	PB
5	24/11/2023	REVISED ISSUE	PB
4	20/09/2023	ISSUE FOR INFORMATION	WL
3	11/09/2023	AMENDED 60% DD ISSUE	PB
2	28/08/2023	60% DD ISSUE	WL
1	04/08/2023	PRELIMINARY ISSUE	WL

rev/	date	details	init.
------	------	---------	-------

drawn	date
WL	JUL 2023
checked	date
NC	JUL 2023
verified	date
GK	DEC 2023

scale

AMENITIES - SHEET 1

scale
1:50 @ A1

project no.
23.0078.17

sheet no.
CQU-ROK-033-GN-ARC-61-00

revision
B

AS CONSTRUCTED

original sheet size - A1 (594mm x 841mm)

BUILDING 33
REDEVELOPMENT

554/700 YAAMBA ROAD,
NORMAN GARDENS QLD 4701

for
CQUniversity
NORTH ROCKHAMPTON CAMPUS
& GIRVAN



B	25/06/2024	AS CONSTRUCTED	PB
A	02/02/2024	IFC	PB
rev\	date	details	init.

drawn	date
TA	DEC 2023
checked	date
PB	DEC 2023
verified	date
GK	DEC 2023




INTERIOR DETAILS

scale
1 : 2 @ A1


project no.
23.0078.17

sheet no.
CQU-ROK-033-GN-ARC-64-00


revision
B

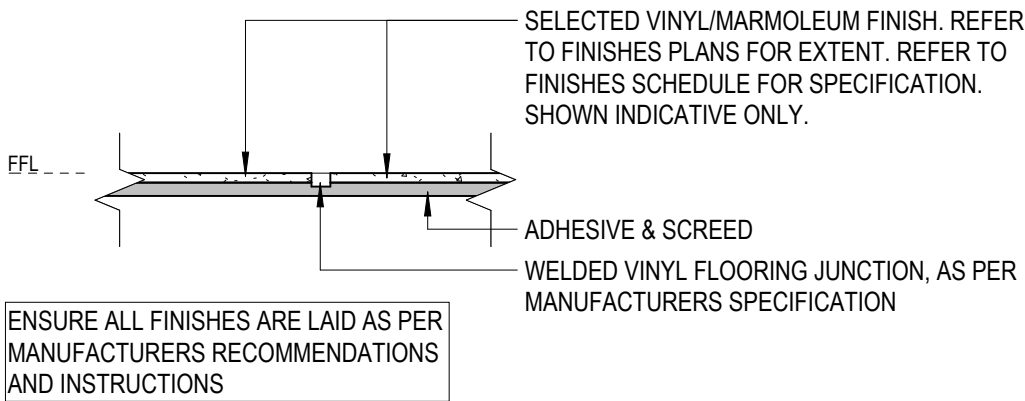

1
1 : 2
DETAIL SECTION - VINYL / VINYL JUNCTION

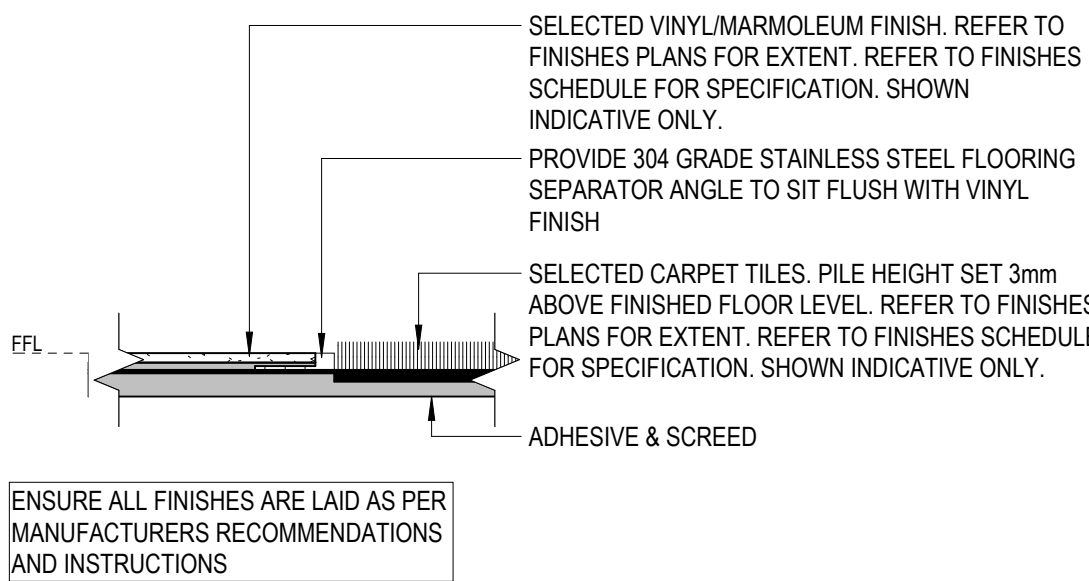

2
1 : 2
DETAIL SECTION - CARPET / VINYL JUNCTION

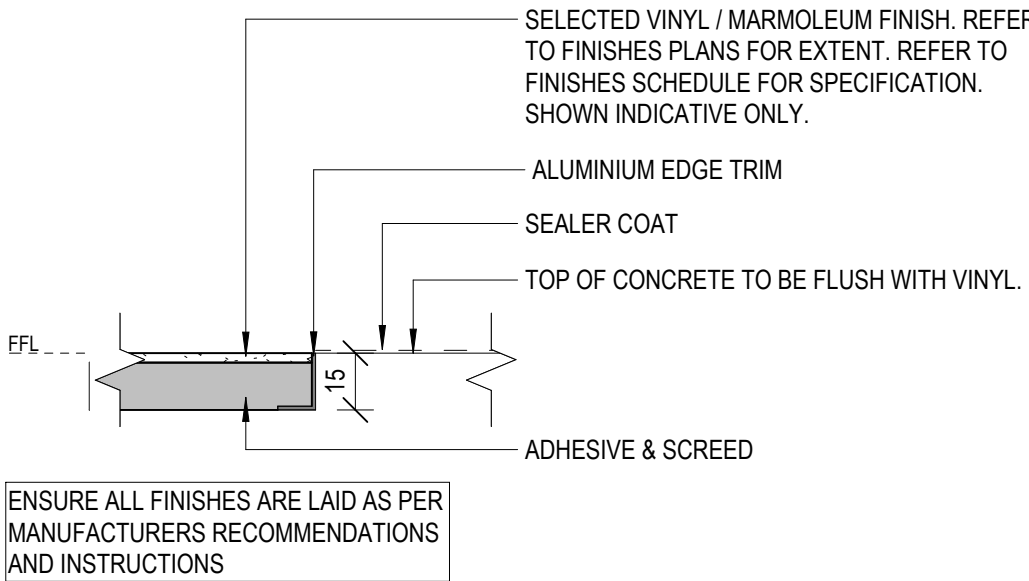

3
1 : 2
DETAIL SECTION - CONCRETE / VINYL JUNCTION

AS CONSTRUCTED

BUILDING 33
REDEVELOPMENT

554/700 YAAMBA ROAD,
NORMAN GARDENS QLD 4701

for
CQUniversity
NORTH ROCKHAMPTON CAMPUS
& GIRVAN



GIRVAN

B	25/06/2024	AS CONSTRUCTED	PB
A	02/02/2024	IFC	PB
4	20/09/2023	ISSUE FOR INFORMATION	WL
3	11/09/2023	AMENDED 60% DD ISSUE	PB
2	28/08/2023	60% DD ISSUE	WL
1	04/08/2023	PRELIMINARY ISSUE	WL

rev	date	details	init
-----	------	---------	------

drawn	date
WL	JUL 2023
checked	date
NC	JUL 2023
verified	date
GK	DEC 2023

scale


1

JOINERY DETAILS


scale project no.
As indicated @ A1 23.0078.17

sheet no.
CQU-ROK-033-GN-ARC-70-01


revision
B

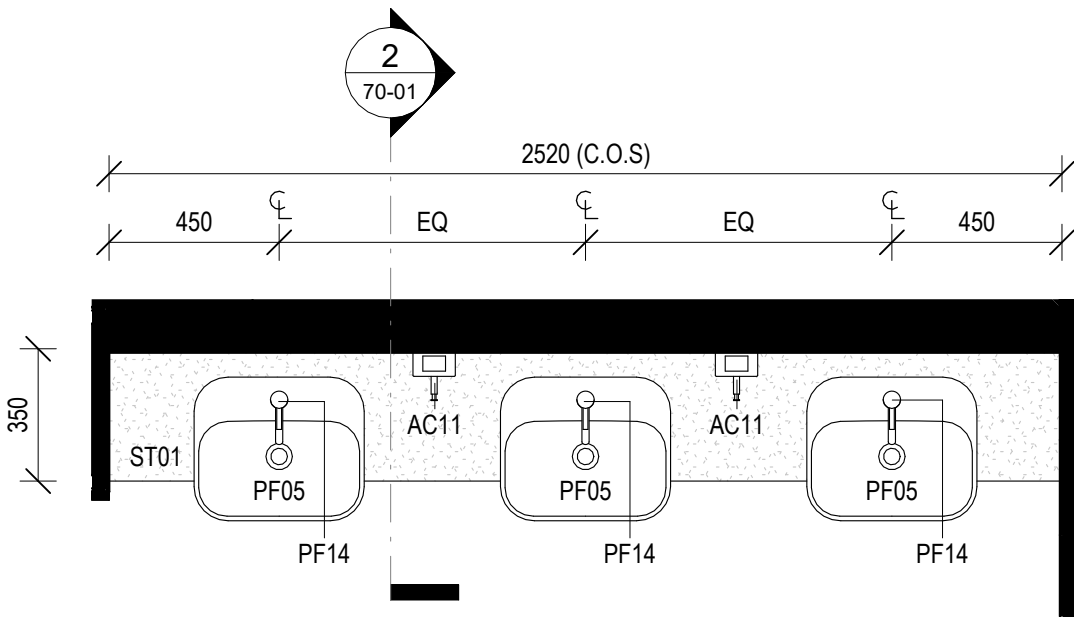


1 PLAN - JN01 - TYPICAL WASH BASIN JOINERY
30-00 1 : 20

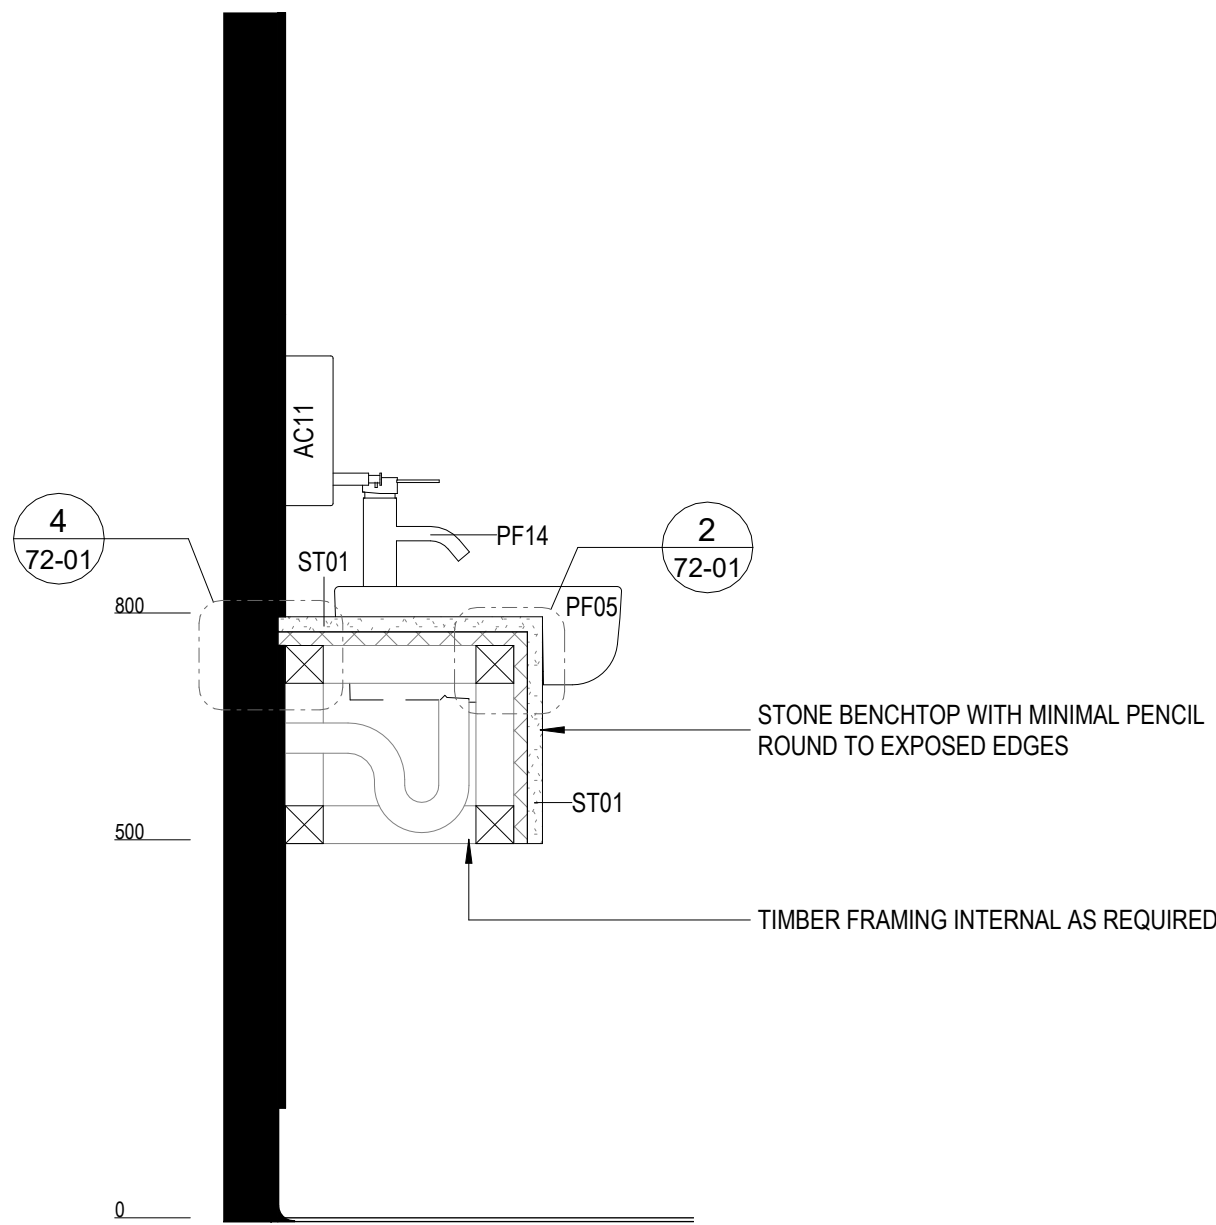


2 JN01 - SECTION DETAIL
70-01 1 : 10

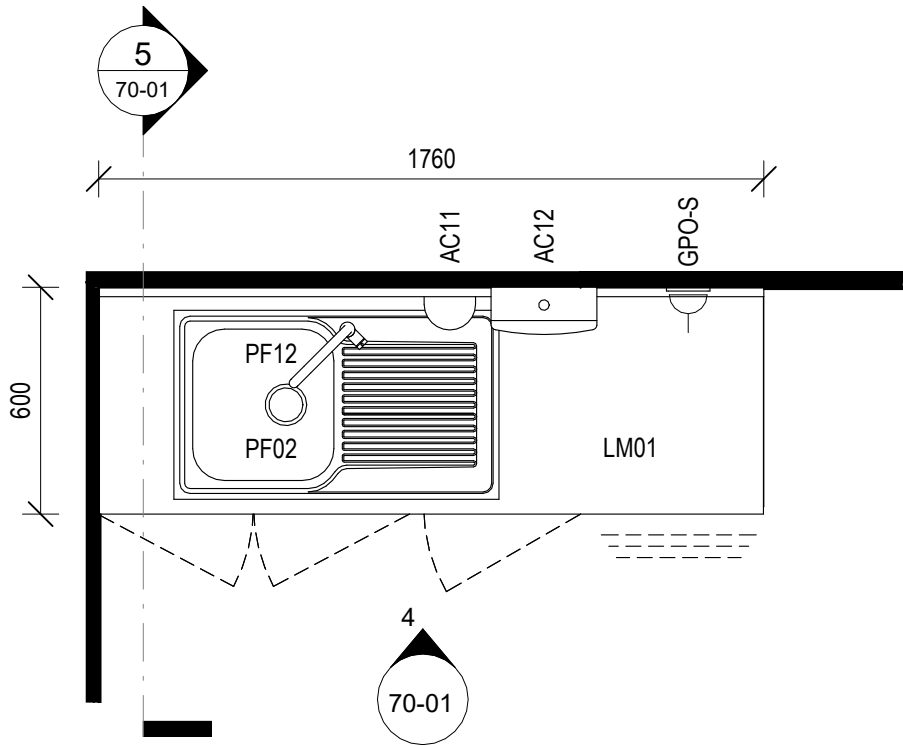

3 PLAN - JN02 - KITCHENETTE
30-00 1 : 20

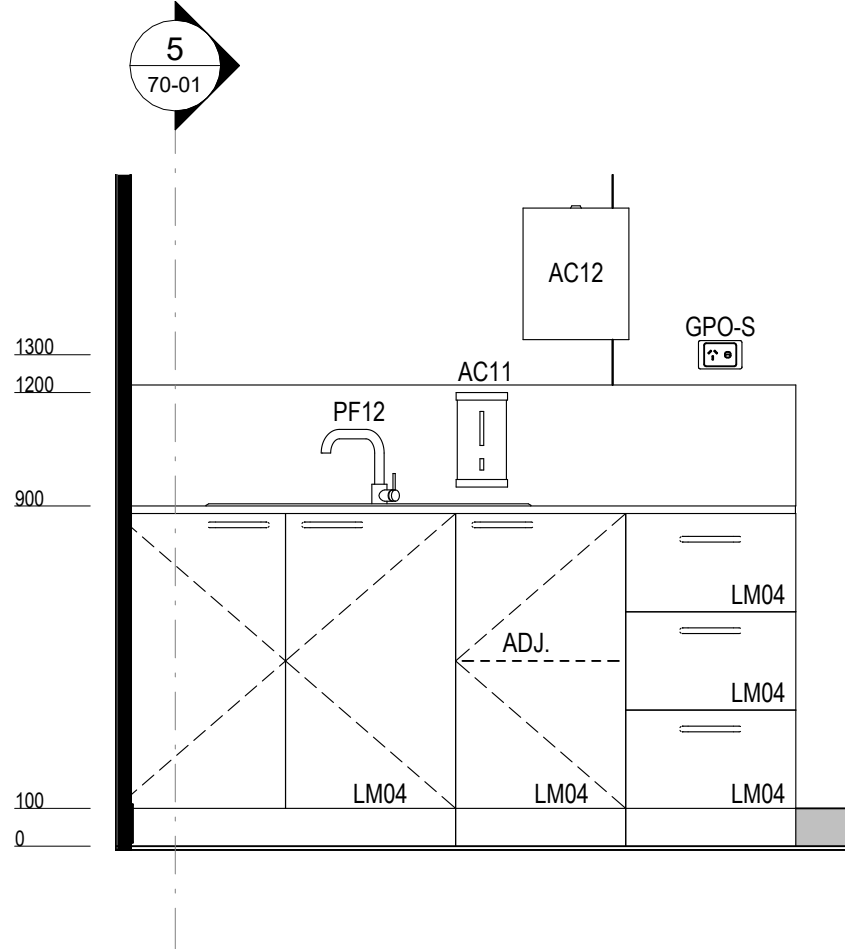


4 ELEVATION - JN02
70-01 1 : 20

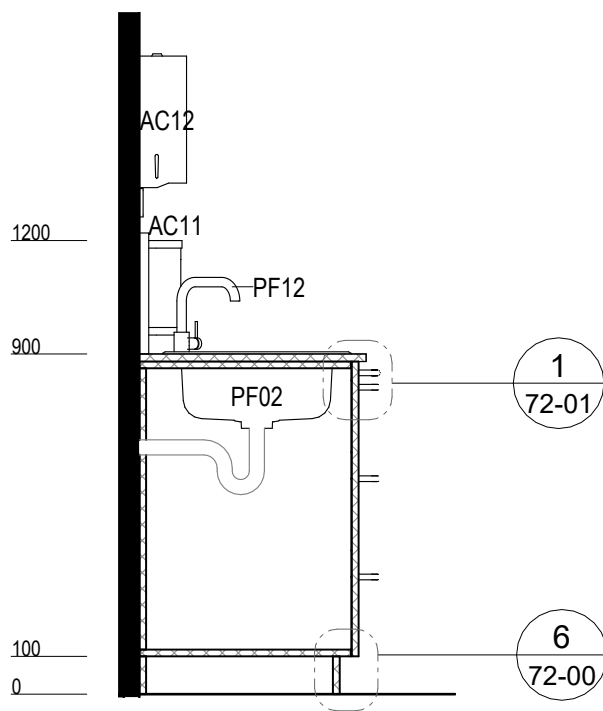

5 JN02 - SECTIONAL DETAIL
70-01 1 : 20

AS CONSTRUCTED

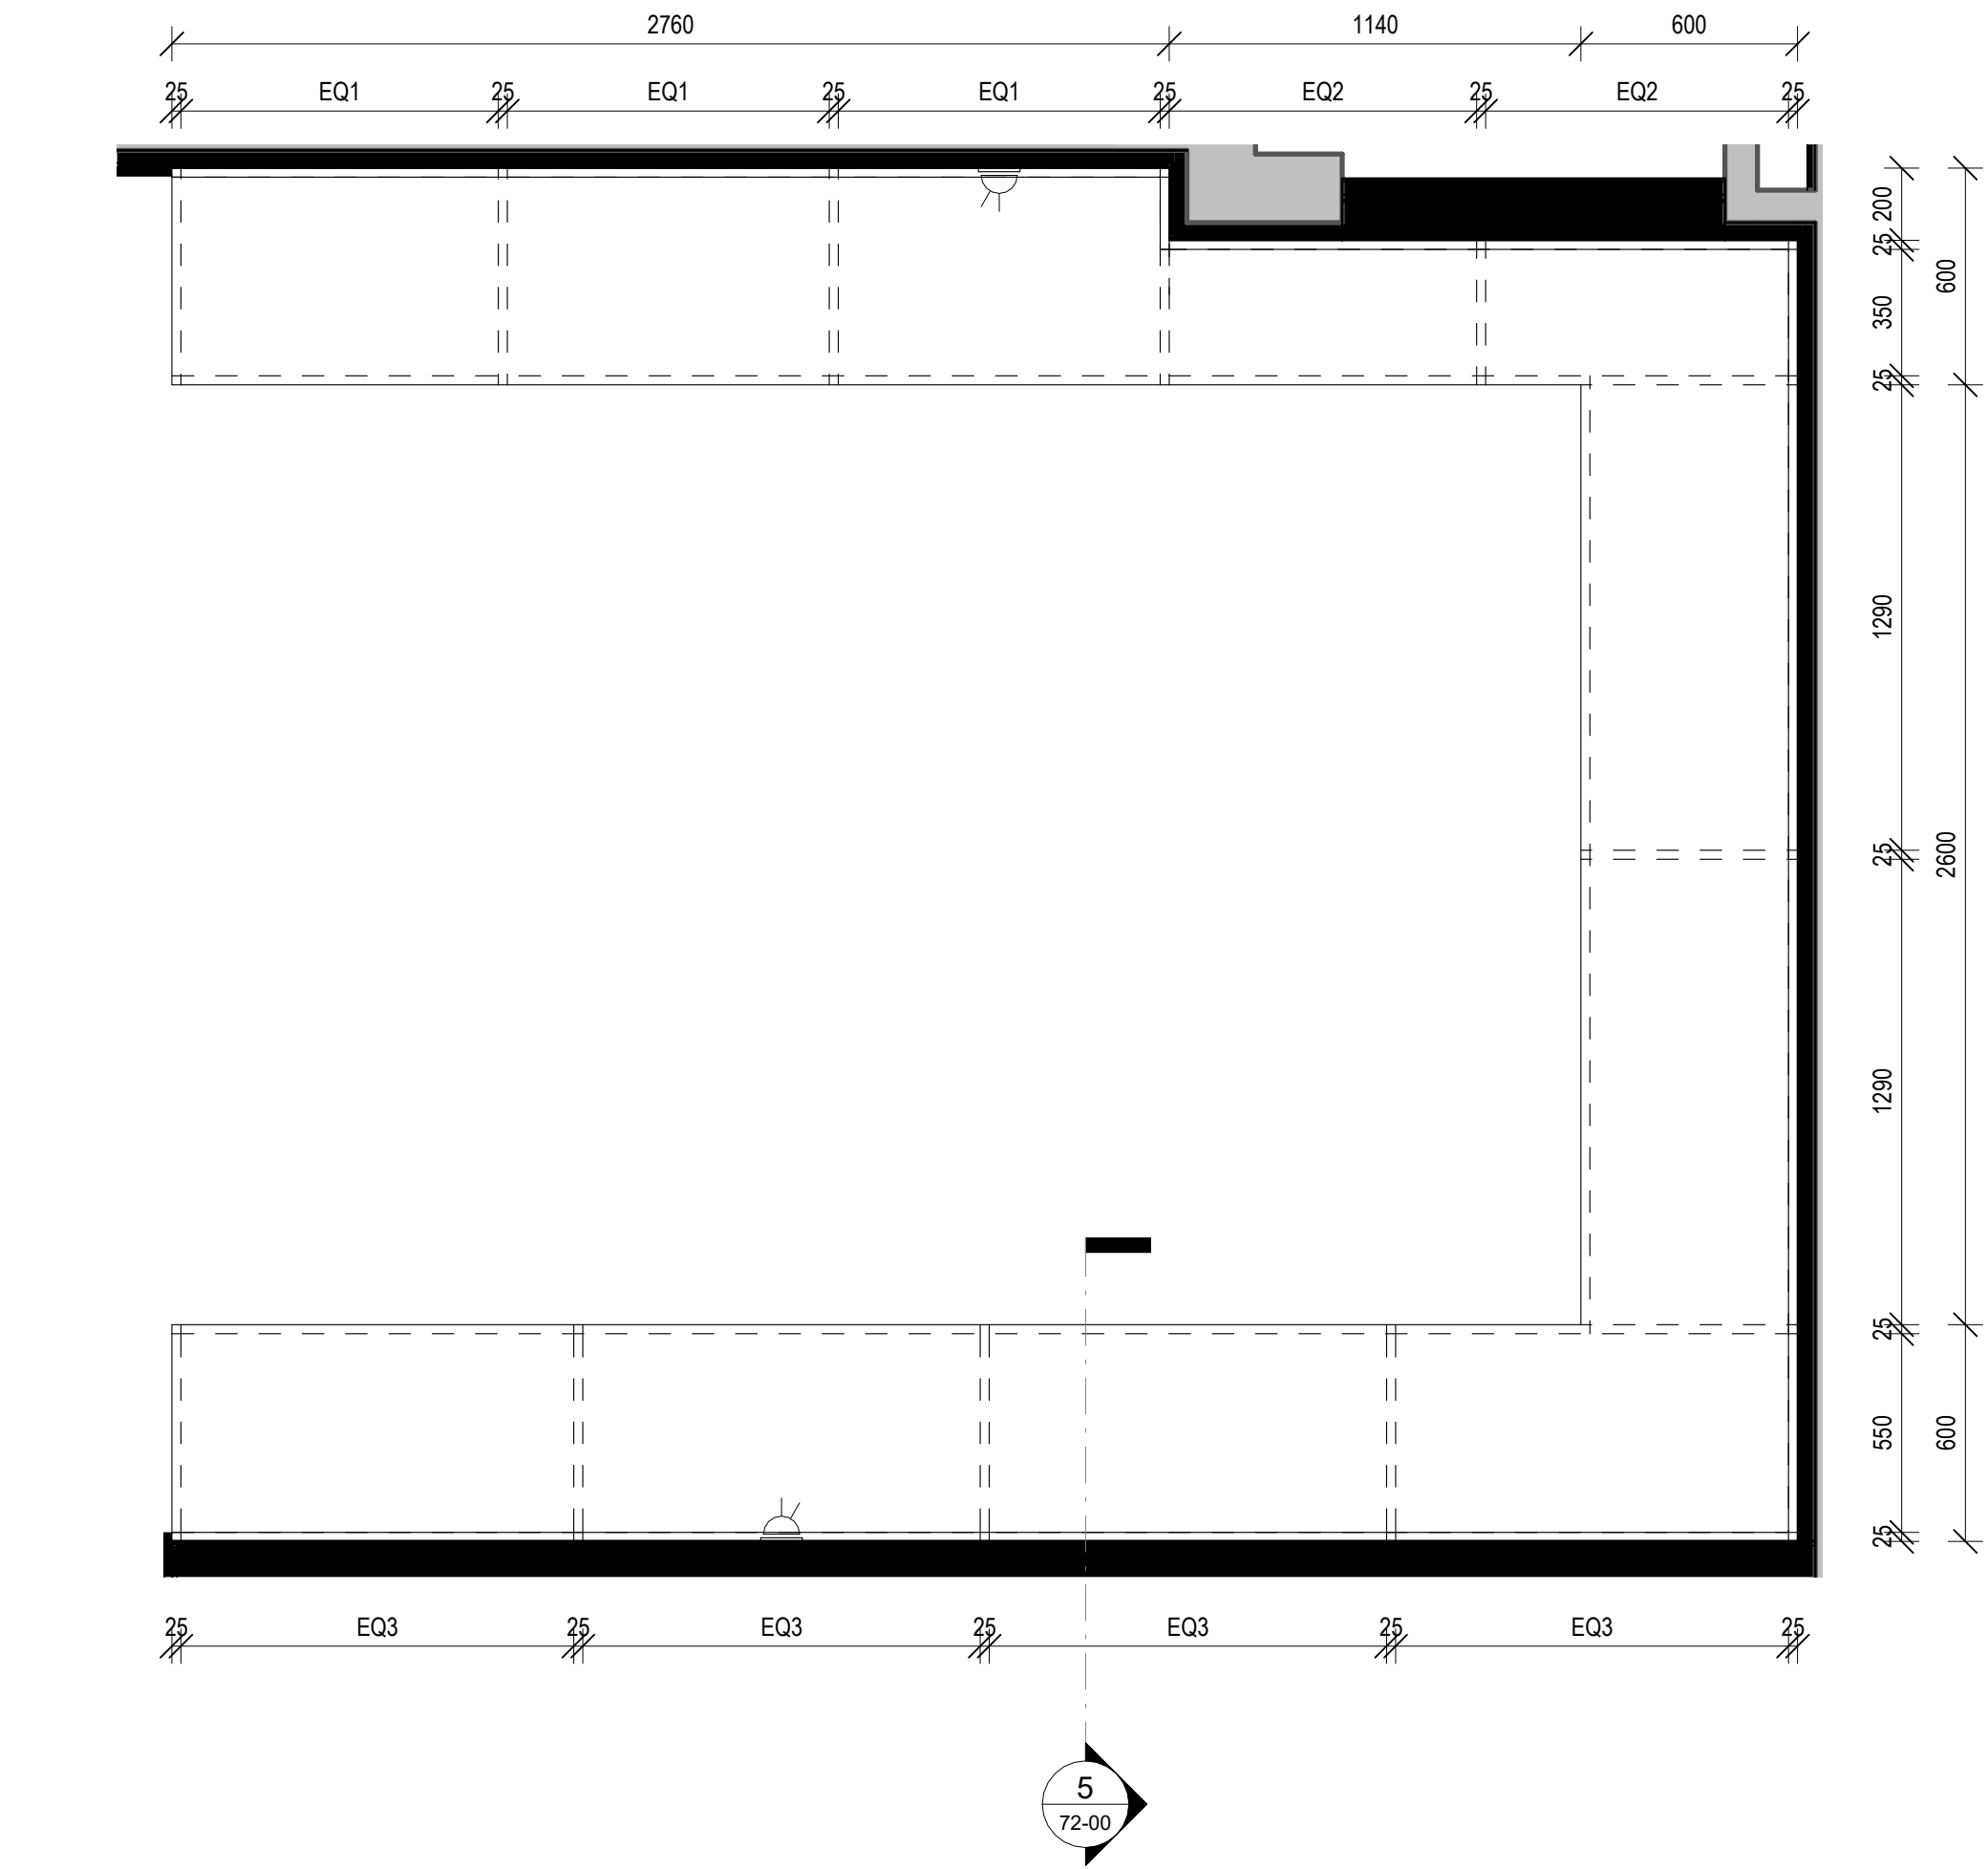

1 PLAN - JN03 - TYPICAL SS BENCH W/ O/H SHELVING
30-00 1 : 20

AS CONSTRUCTED

thomson
adsett

Telephone +61 7 3840 9999
bne@thomsonadsett.com
Level 9, 470 St Pauls Terrace
Fortitude Valley
Qld 4006 Australia
thomsonadsett.com

© Copyright
These drawings and designs and the copyright thereof are the property of Thomson Adsett Pty Ltd and must not be used, retained or copied without written permission of Thomson Adsett Pty Ltd. ABN 76 105 314 654 Trading as ThomsonAdsett. Dimensions take precedence over scaling. Do not measure off drawings as print sizes may vary

BUILDING 33
REDEVELOPMENT

554/700 YAAMBA ROAD,
NORMAN GARDENS QLD 4701

for
CQUniversity
NORTH ROCKHAMPTON CAMPUS
& GIRVAN



GIRVAN

B	25/06/2024	AS CONSTRUCTED	PB
A	02/02/2024	IFC	PB
3	20/09/2023	ISSUE FOR INFORMATION	WL
2	11/09/2023	AMENDED 60% DD ISSUE	PB
1	28/08/2023	60% DD ISSUE	WL

rev	date	details	init
-----	------	---------	------

drawn	date
WL	JUL 2023
checked	date
NC	JUL 2023
verified	date
GK	DEC 2023



JOINERY DETAILS




scale	project no.
1 : 20 @ A1	23.0078.17

sheet no.
CQU-ROK-033-GN-ARC-70-02

revision
B

original sheet size - A1 (594mm x 841mm)

C:\REV\LOCAL\FILES\23.0078.17_CQU Building 33 Redevelopment_2023_Philip Bugden.nt 2/07/2024 4:53:06 PM

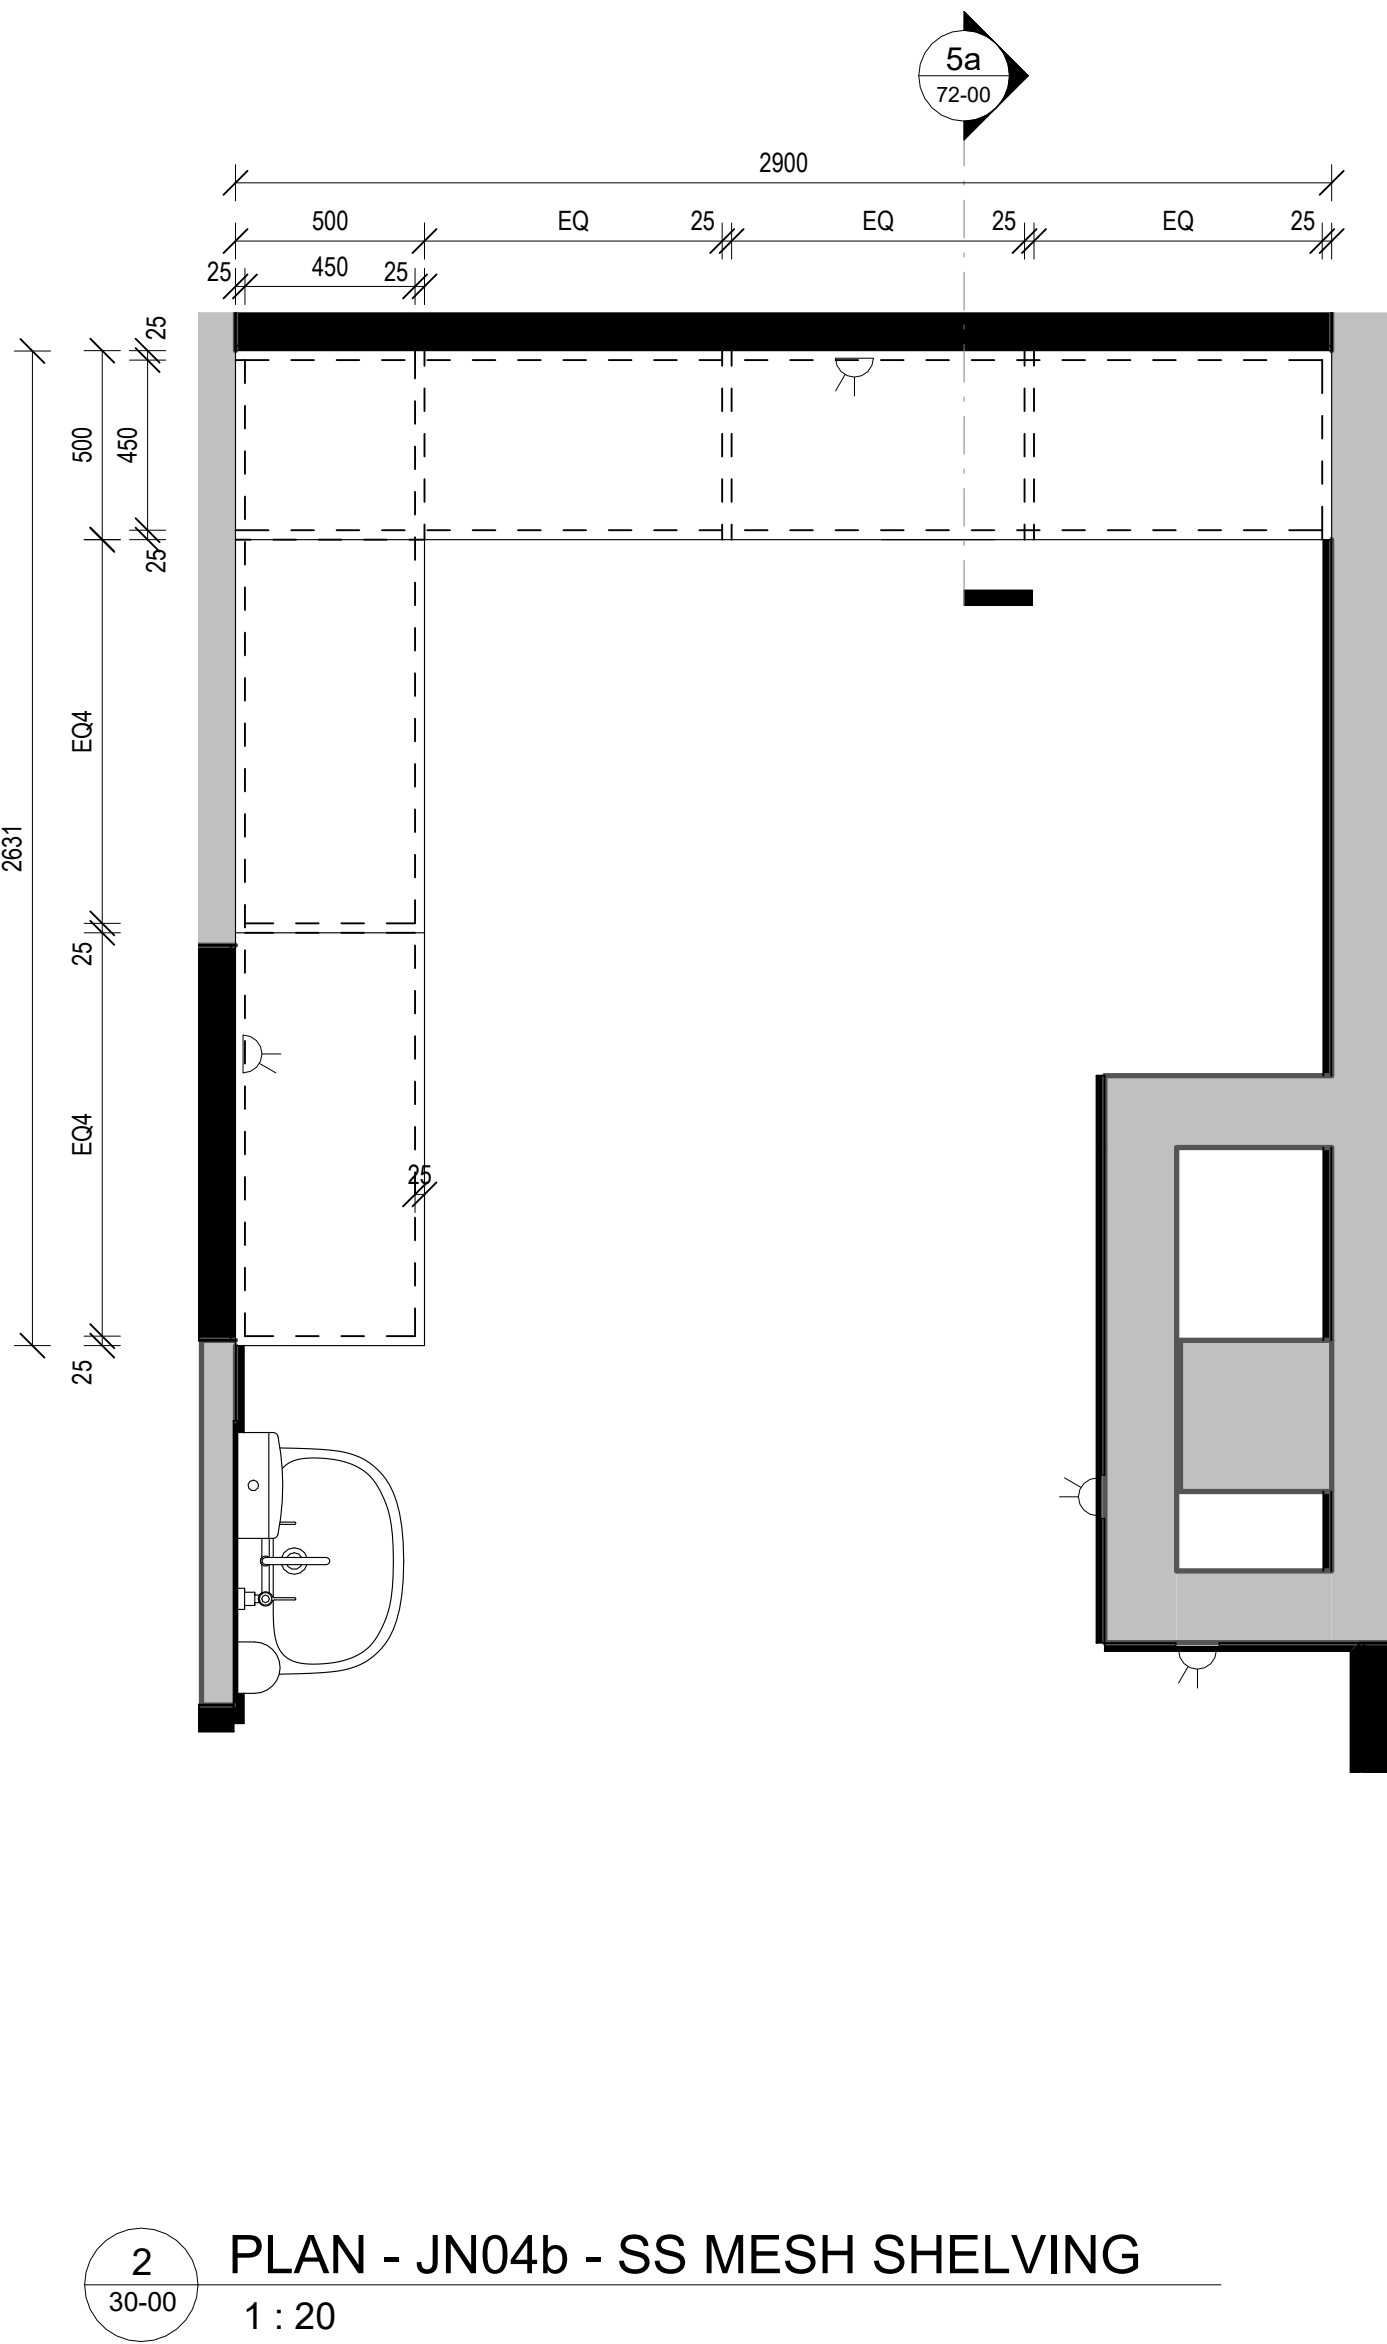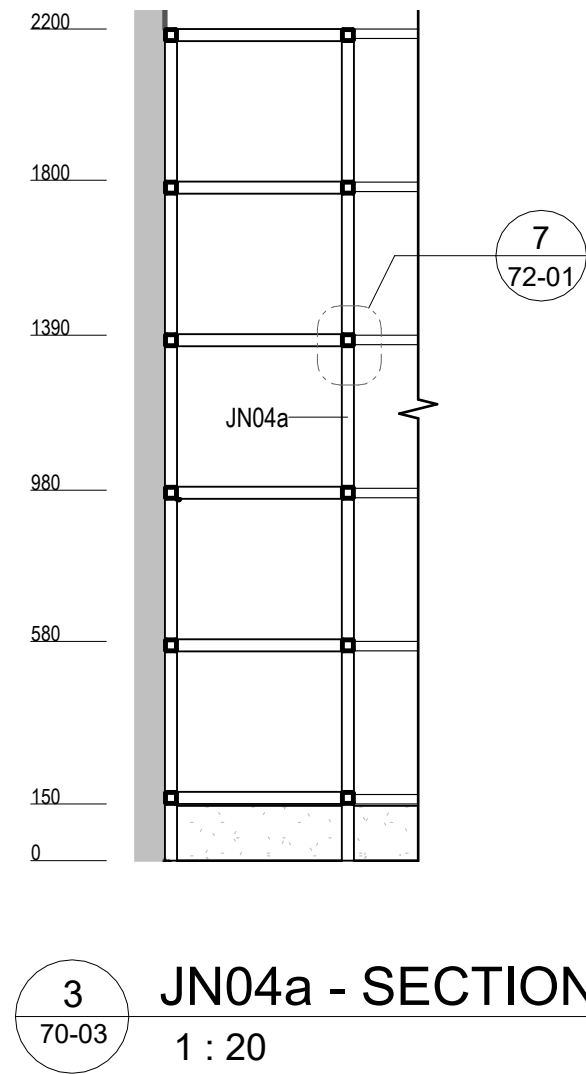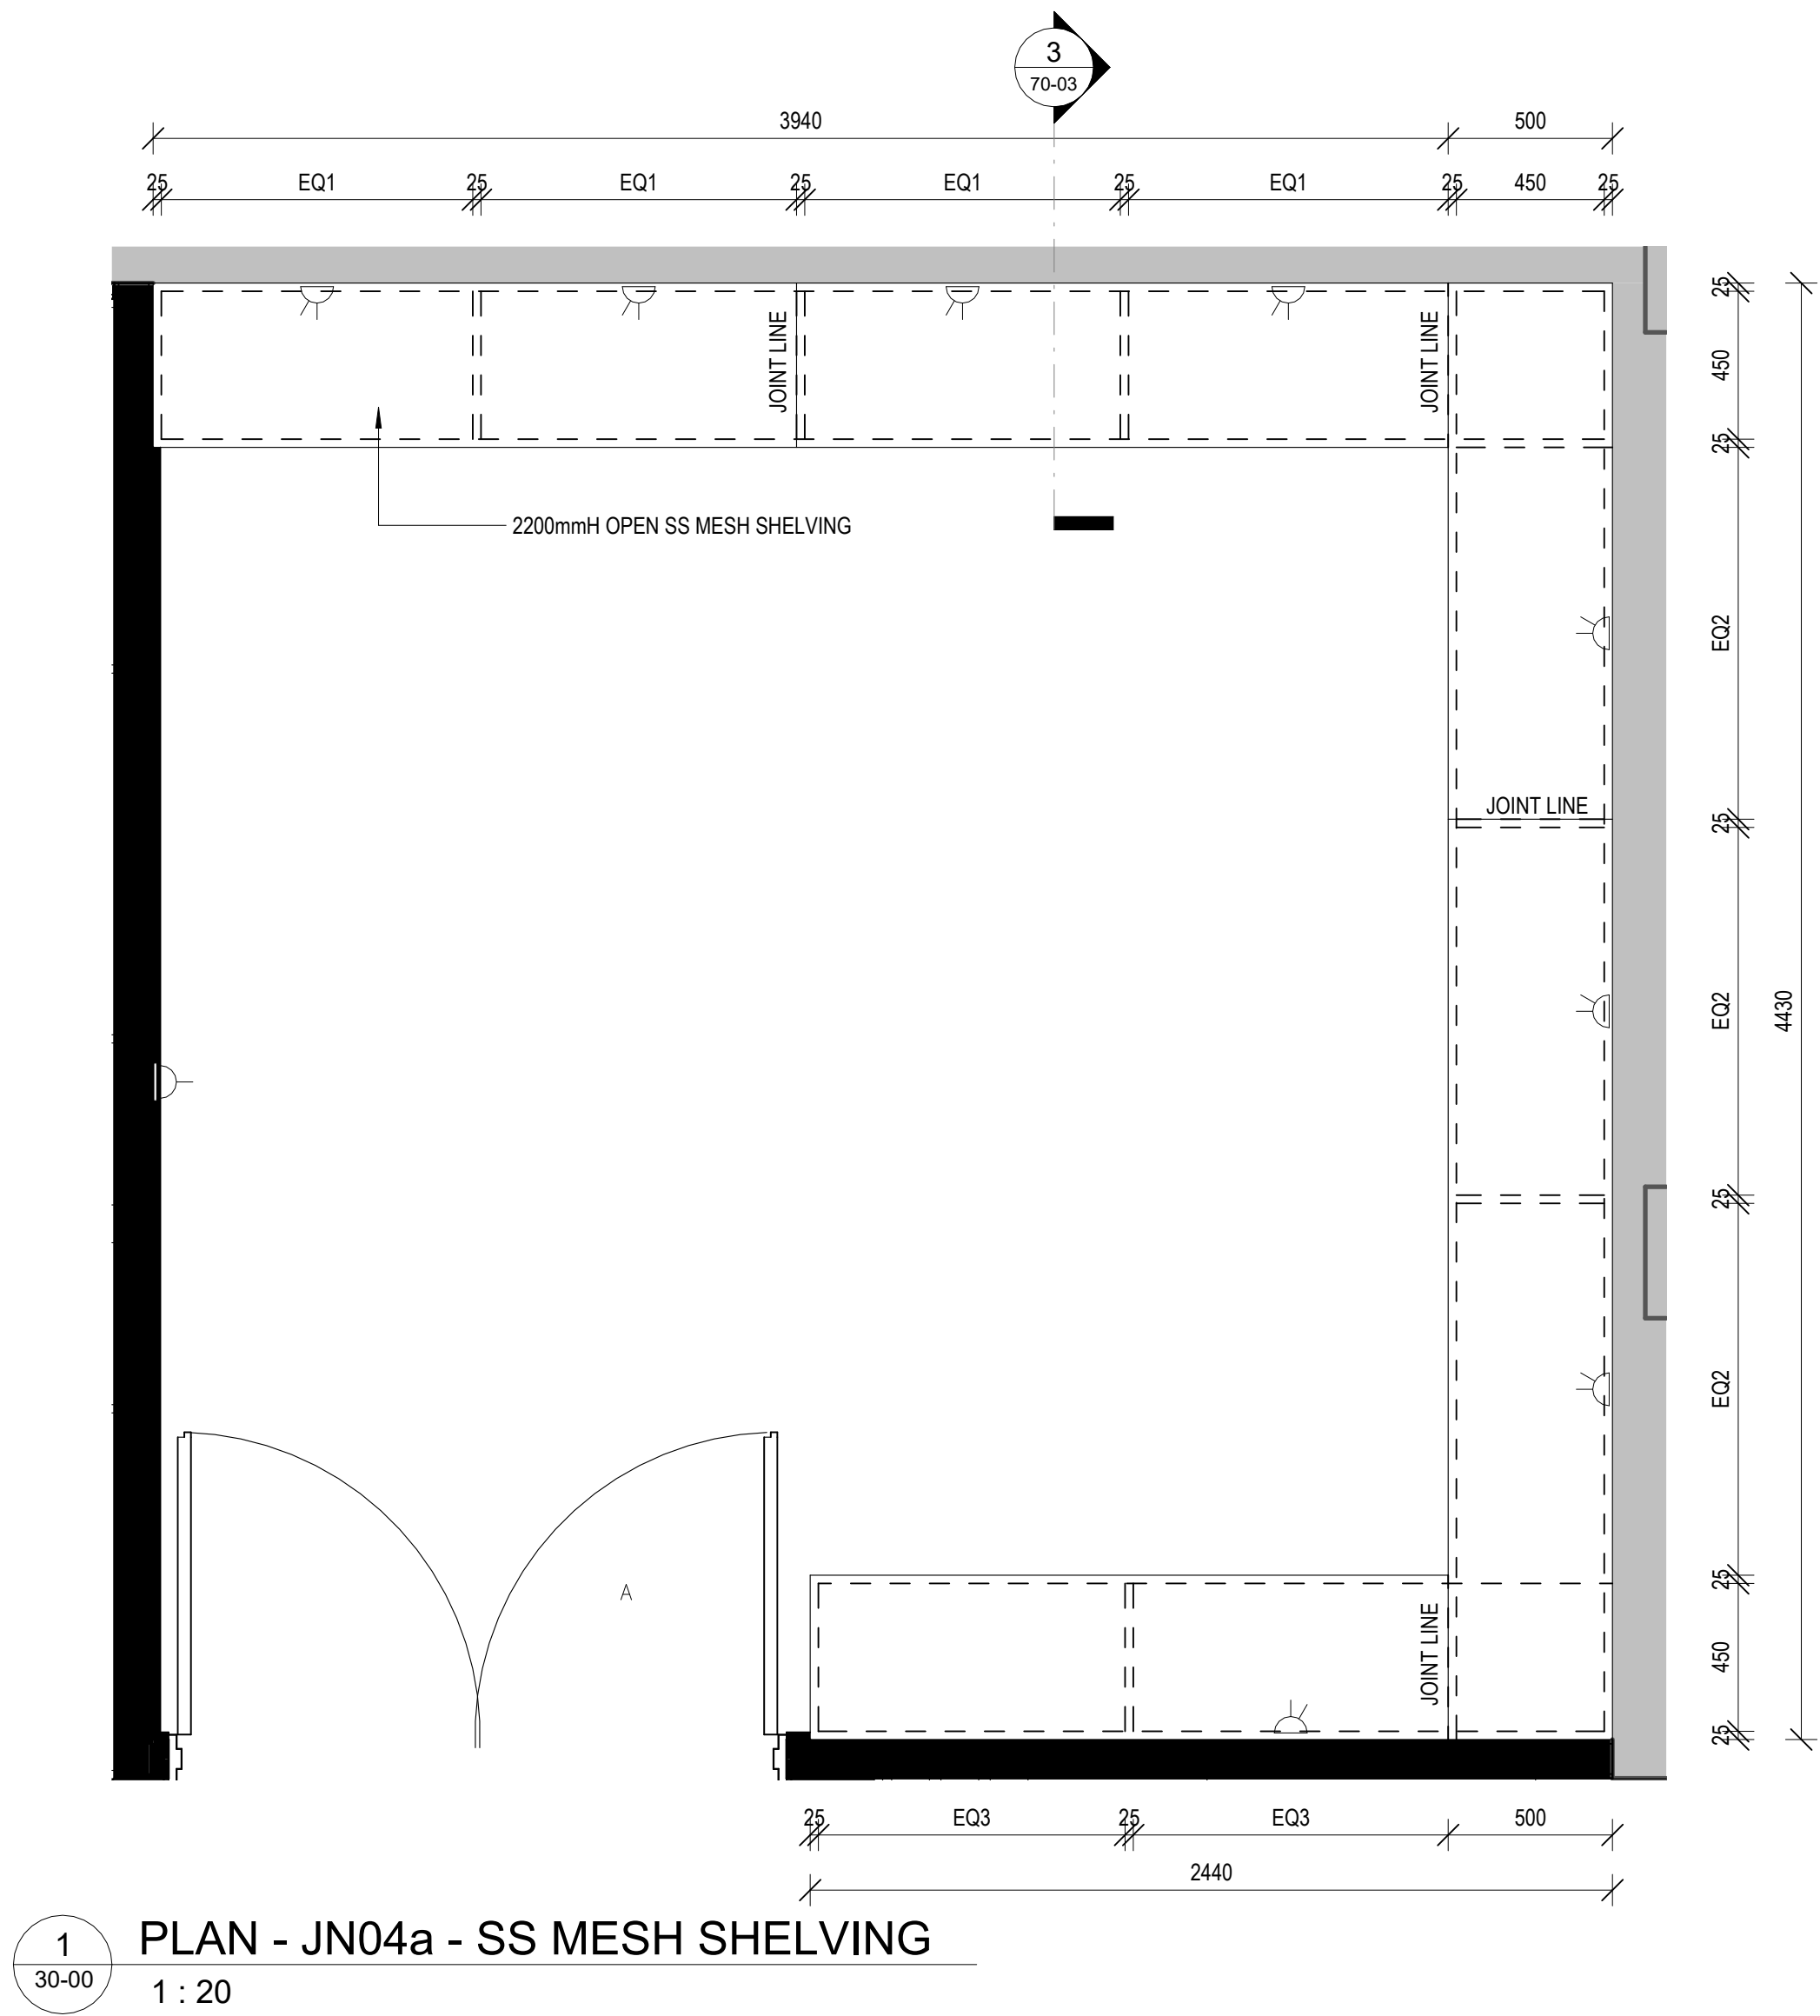

AS CONSTRUCTED

thomson
adsett

Telephone +61 7 3840 9999
bne@thomsonadsett.com
Level 9, 470 St Pauls Terrace
Fortitude Valley
Qld 4006 Australia
thomsonadsett.com

© Copyright
These drawings and designs and the copyright thereof are the property of Thomson Adsett Pty Ltd and must not be used, retained or copied without written permission of Thomson Adsett Pty Ltd. ABN 76 105 314 654 Trading as ThomsonAdsett. Dimensions take precedence over scaling. Do not measure off drawings as print sizes may vary

BUILDING 33 REDEVELOPMENT

554/700 YAAMBA ROAD,
NORMAN GARDENS QLD 4701

for
CQUniversity
NORTH ROCKHAMPTON CAMPUS
& GIRVAN



GIRVAN

B	25/06/2024	AS CONSTRUCTED	PB
A	02/02/2024	IFC	PB
5	20/12/2023	REVISED ISSUE	PB
4	19/12/2023	REVISED ISSUE	PB
3	20/09/2023	ISSUE FOR INFORMATION	WL
2	11/09/2023	AMENDED 60% DD ISSUE	PB
1	28/08/2023	60% DD ISSUE	WL

rev\	date	details	init.
------	------	---------	-------

drawn	date
WL	JUL 2023
checked	date
NC	JUL 2023
verified	date
GK	DEC 2023

scale	
-------	--

JOINERY DETAILS


scale	project no.
1 : 20 @ A1	23.0078.17

sheet no.
CQU-ROK-033-GN-ARC-70-03

revision
B

original sheet size - A1 (594mm x 841mm)

C:\REV\LOCAL\FILES\23.0078.17_CQU Building 33 Redevelopment_2023_Philip Bugden.nt

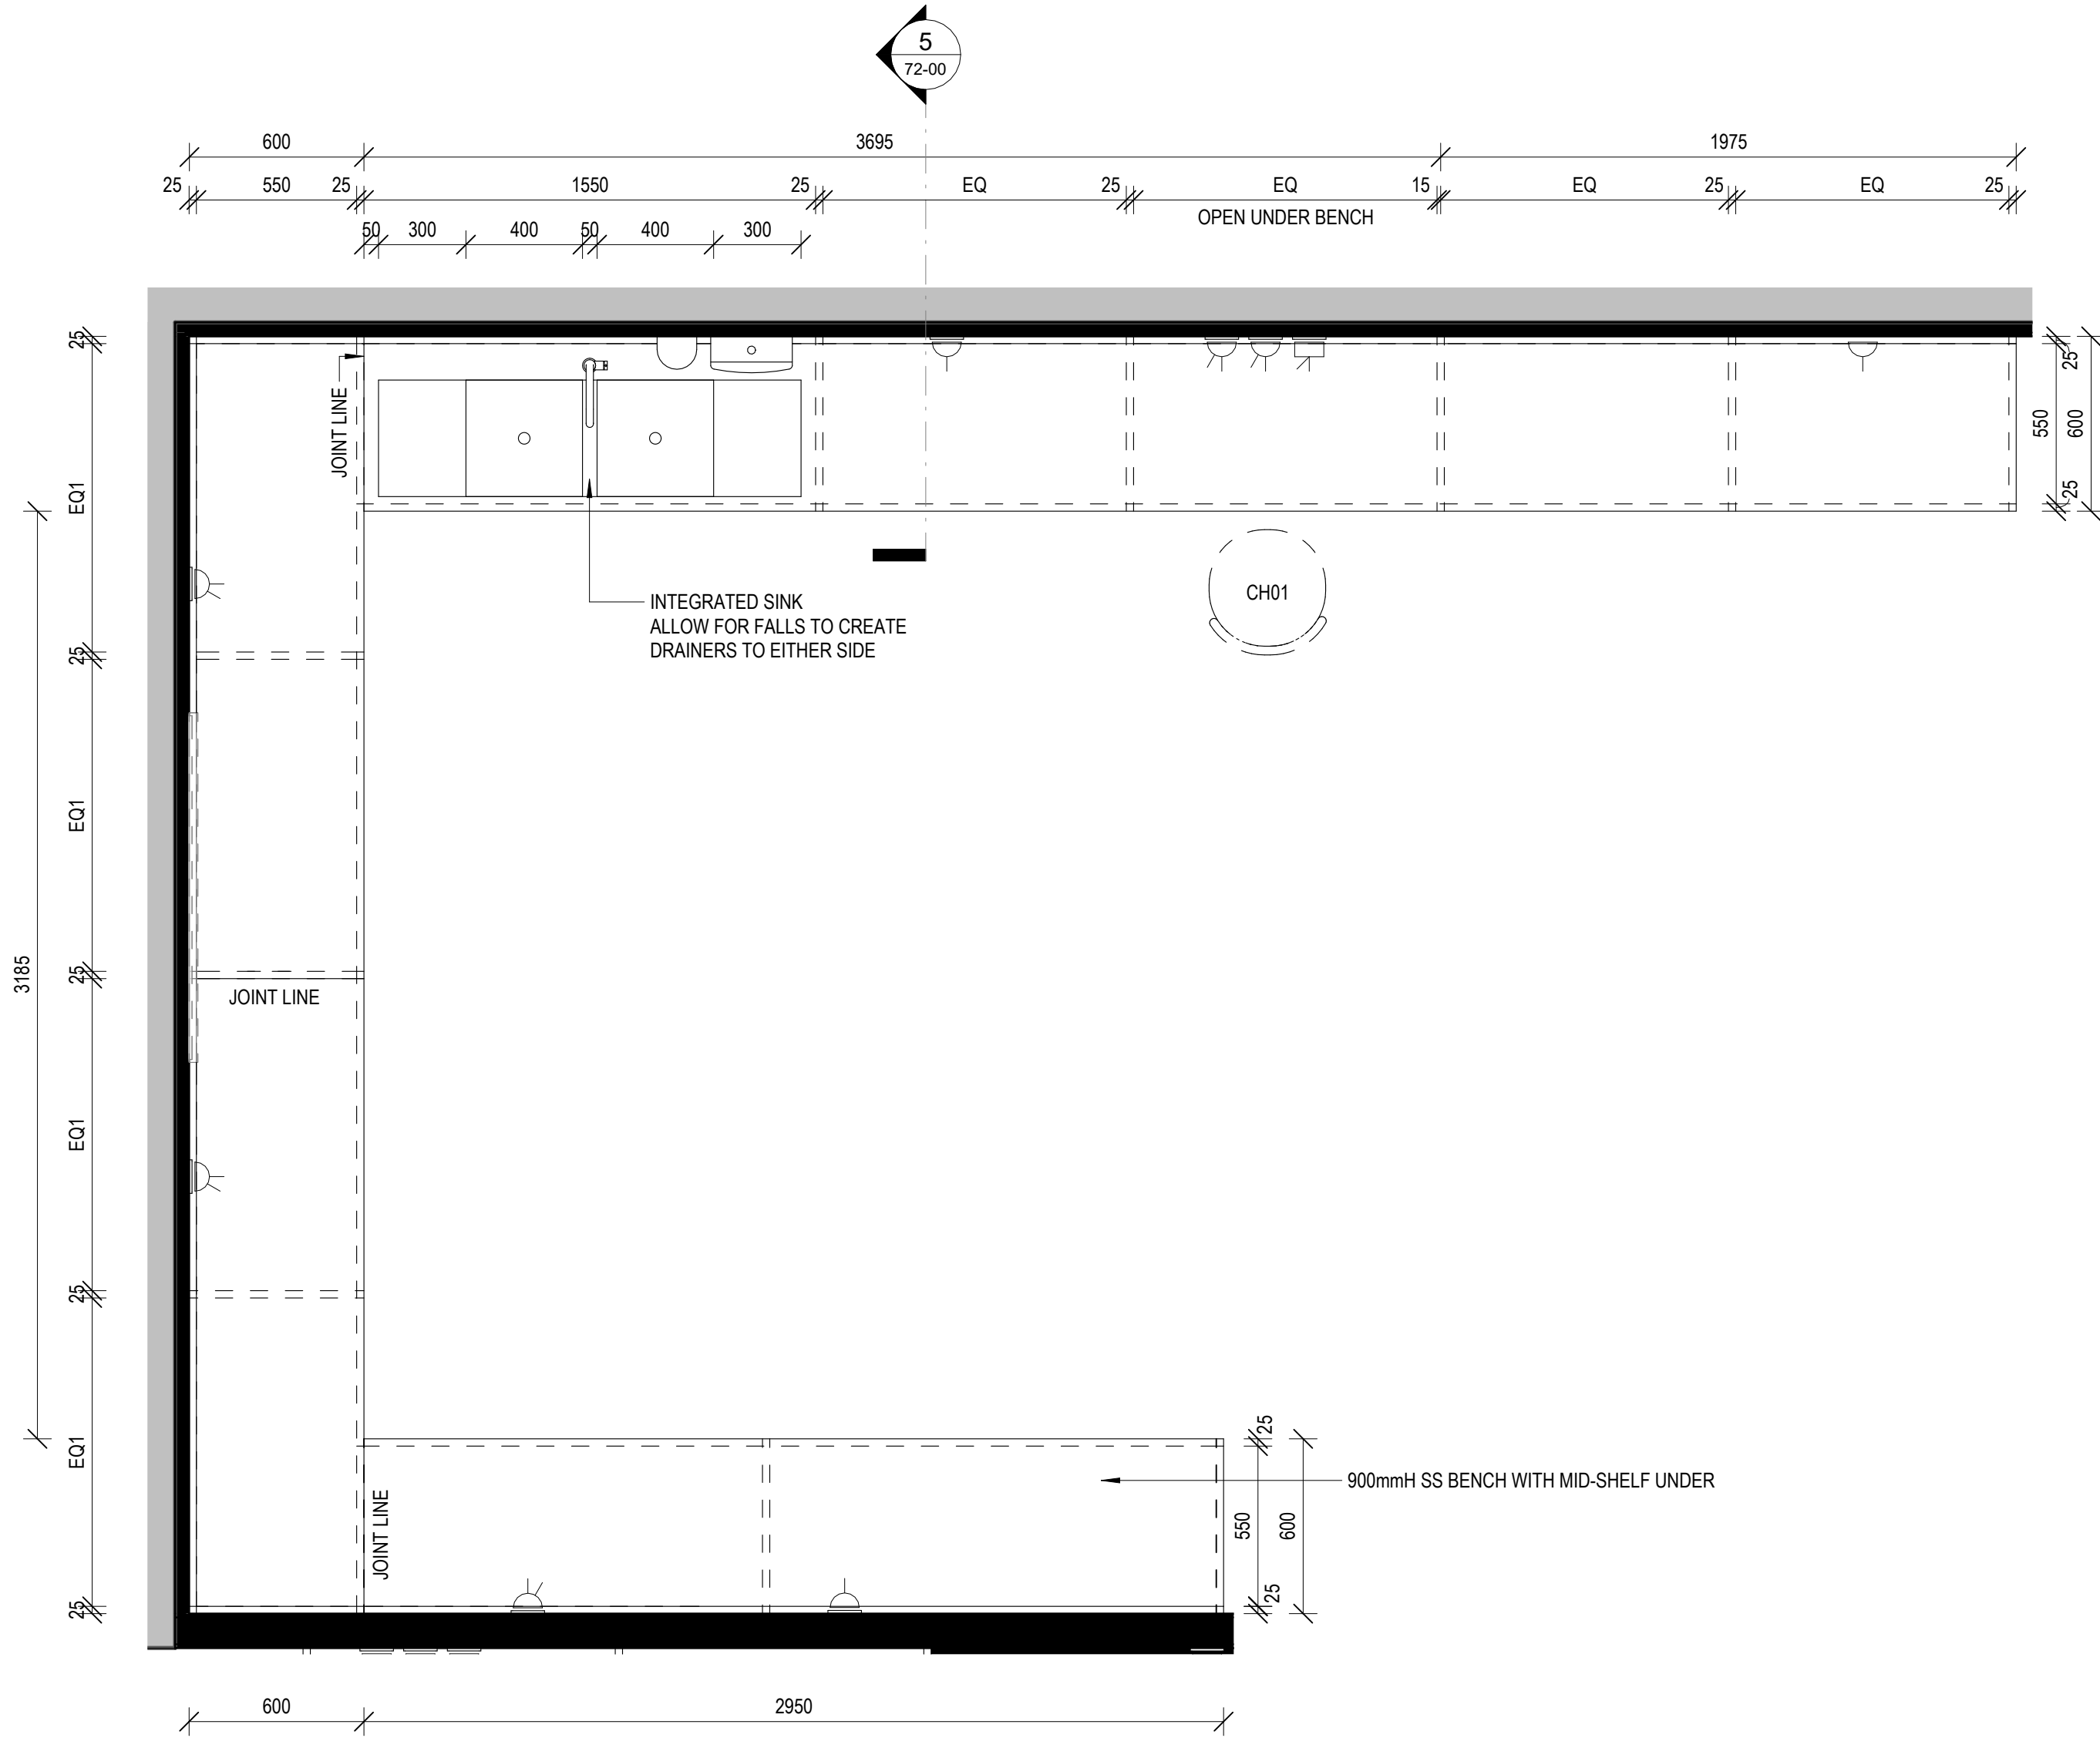

1 PLAN - JN05 - SS BENCH W/ INTEGRATED SINK & O/H SHELVING
30-00 1 : 20

thomson
adsett

Telephone +61 7 3840 9999
bne@thomsonadsett.com
Level 9, 470 St Pauls Terrace
Fortitude Valley
Qld 4006 Australia
thomsonadsett.com

© Copyright
These drawings and designs and the copyright thereof are the property of Thomson Adsett Pty Ltd and must not be used, retained or copied without written permission of Thomson Adsett Pty Ltd. ABN 76 105 314 654 Trading as ThomsonAdsett. Dimensions take precedence over scaling. Do not measure off drawings as print sizes may vary

BUILDING 33
REDEVELOPMENT

554/700 YAAMBA ROAD,
NORMAN GARDENS QLD 4701

for
CQUniversity
NORTH ROCKHAMPTON CAMPUS
& GIRVAN



B	25/06/2024	AS CONSTRUCTED	PB
A	02/02/2024	IFC	PB
4	19/12/2023	REVISED ISSUE	PB
3	20/09/2023	ISSUE FOR INFORMATION	WL
2	11/09/2023	AMENDED 60% DD ISSUE	PB
1	28/08/2023	60% DD ISSUE	WL

rev	date	details	init
-----	------	---------	------

drawn	date
WL	JUL 2023
checked	date
NC	JUL 2023
verified	date
GK	DEC 2023

scale

JOINERY DETAILS

scale 1 : 20 @ A1 project no. 23.0078.17


sheet no. CQU-ROK-033-GN-ARC-70-04

revision B


original sheet size - A1 (594mm x 841mm)

AS CONSTRUCTED


C:\REVIT\LOCAL\FILES\23.0078.17_CQU Building 33 Redevelopment_2023_Philip Bugden.nt 2/07/2024 4:53:18 PM

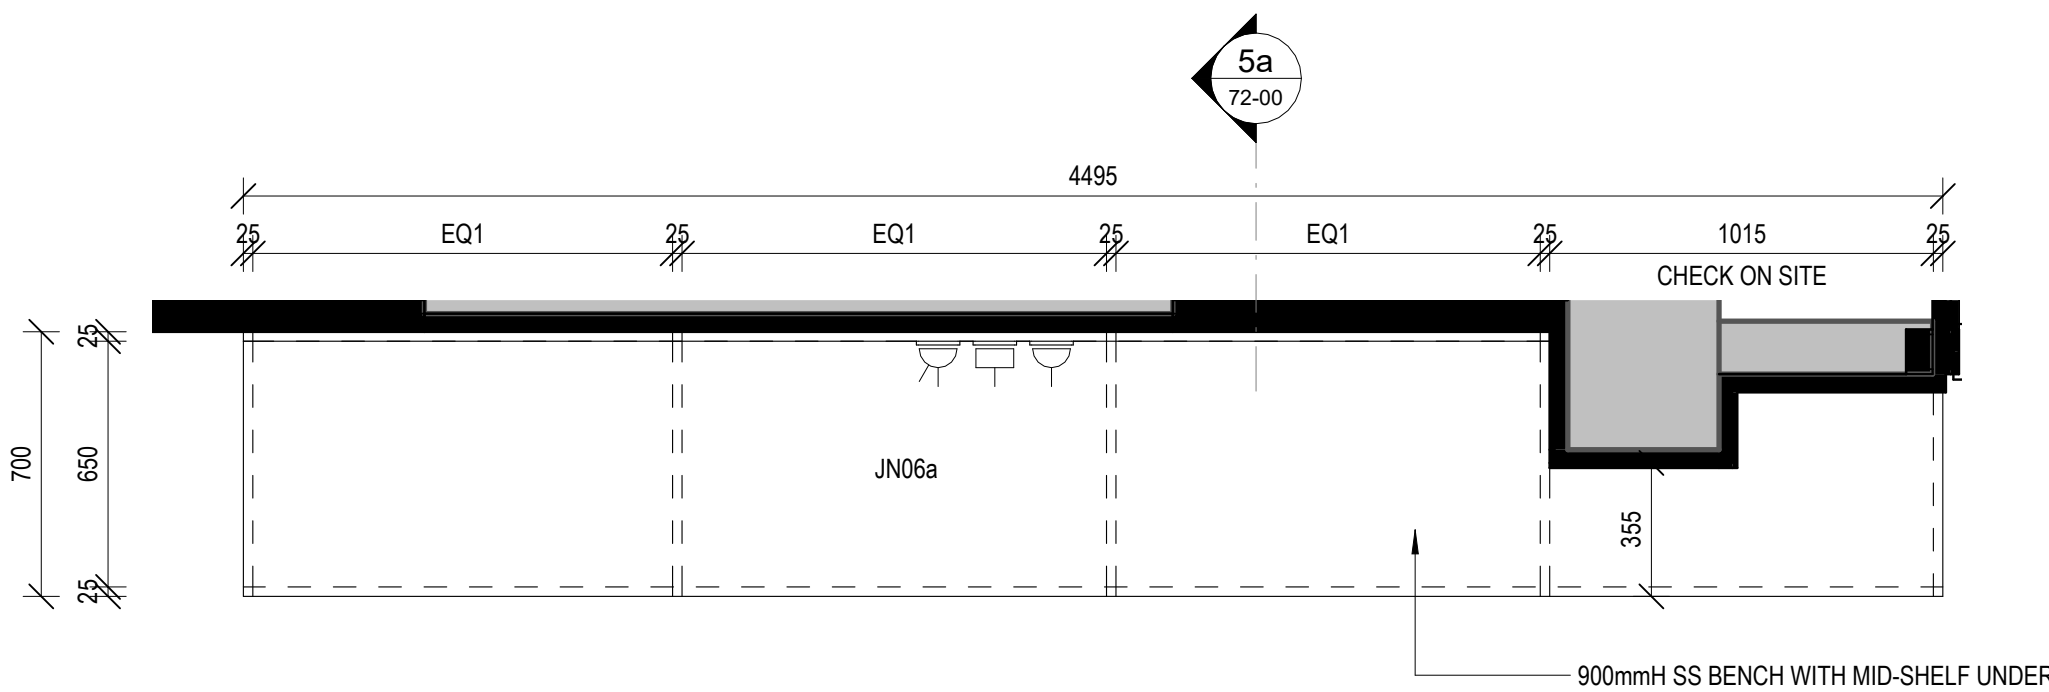


1
30-00
PLAN - JN06a - SS BENCH
1 : 20

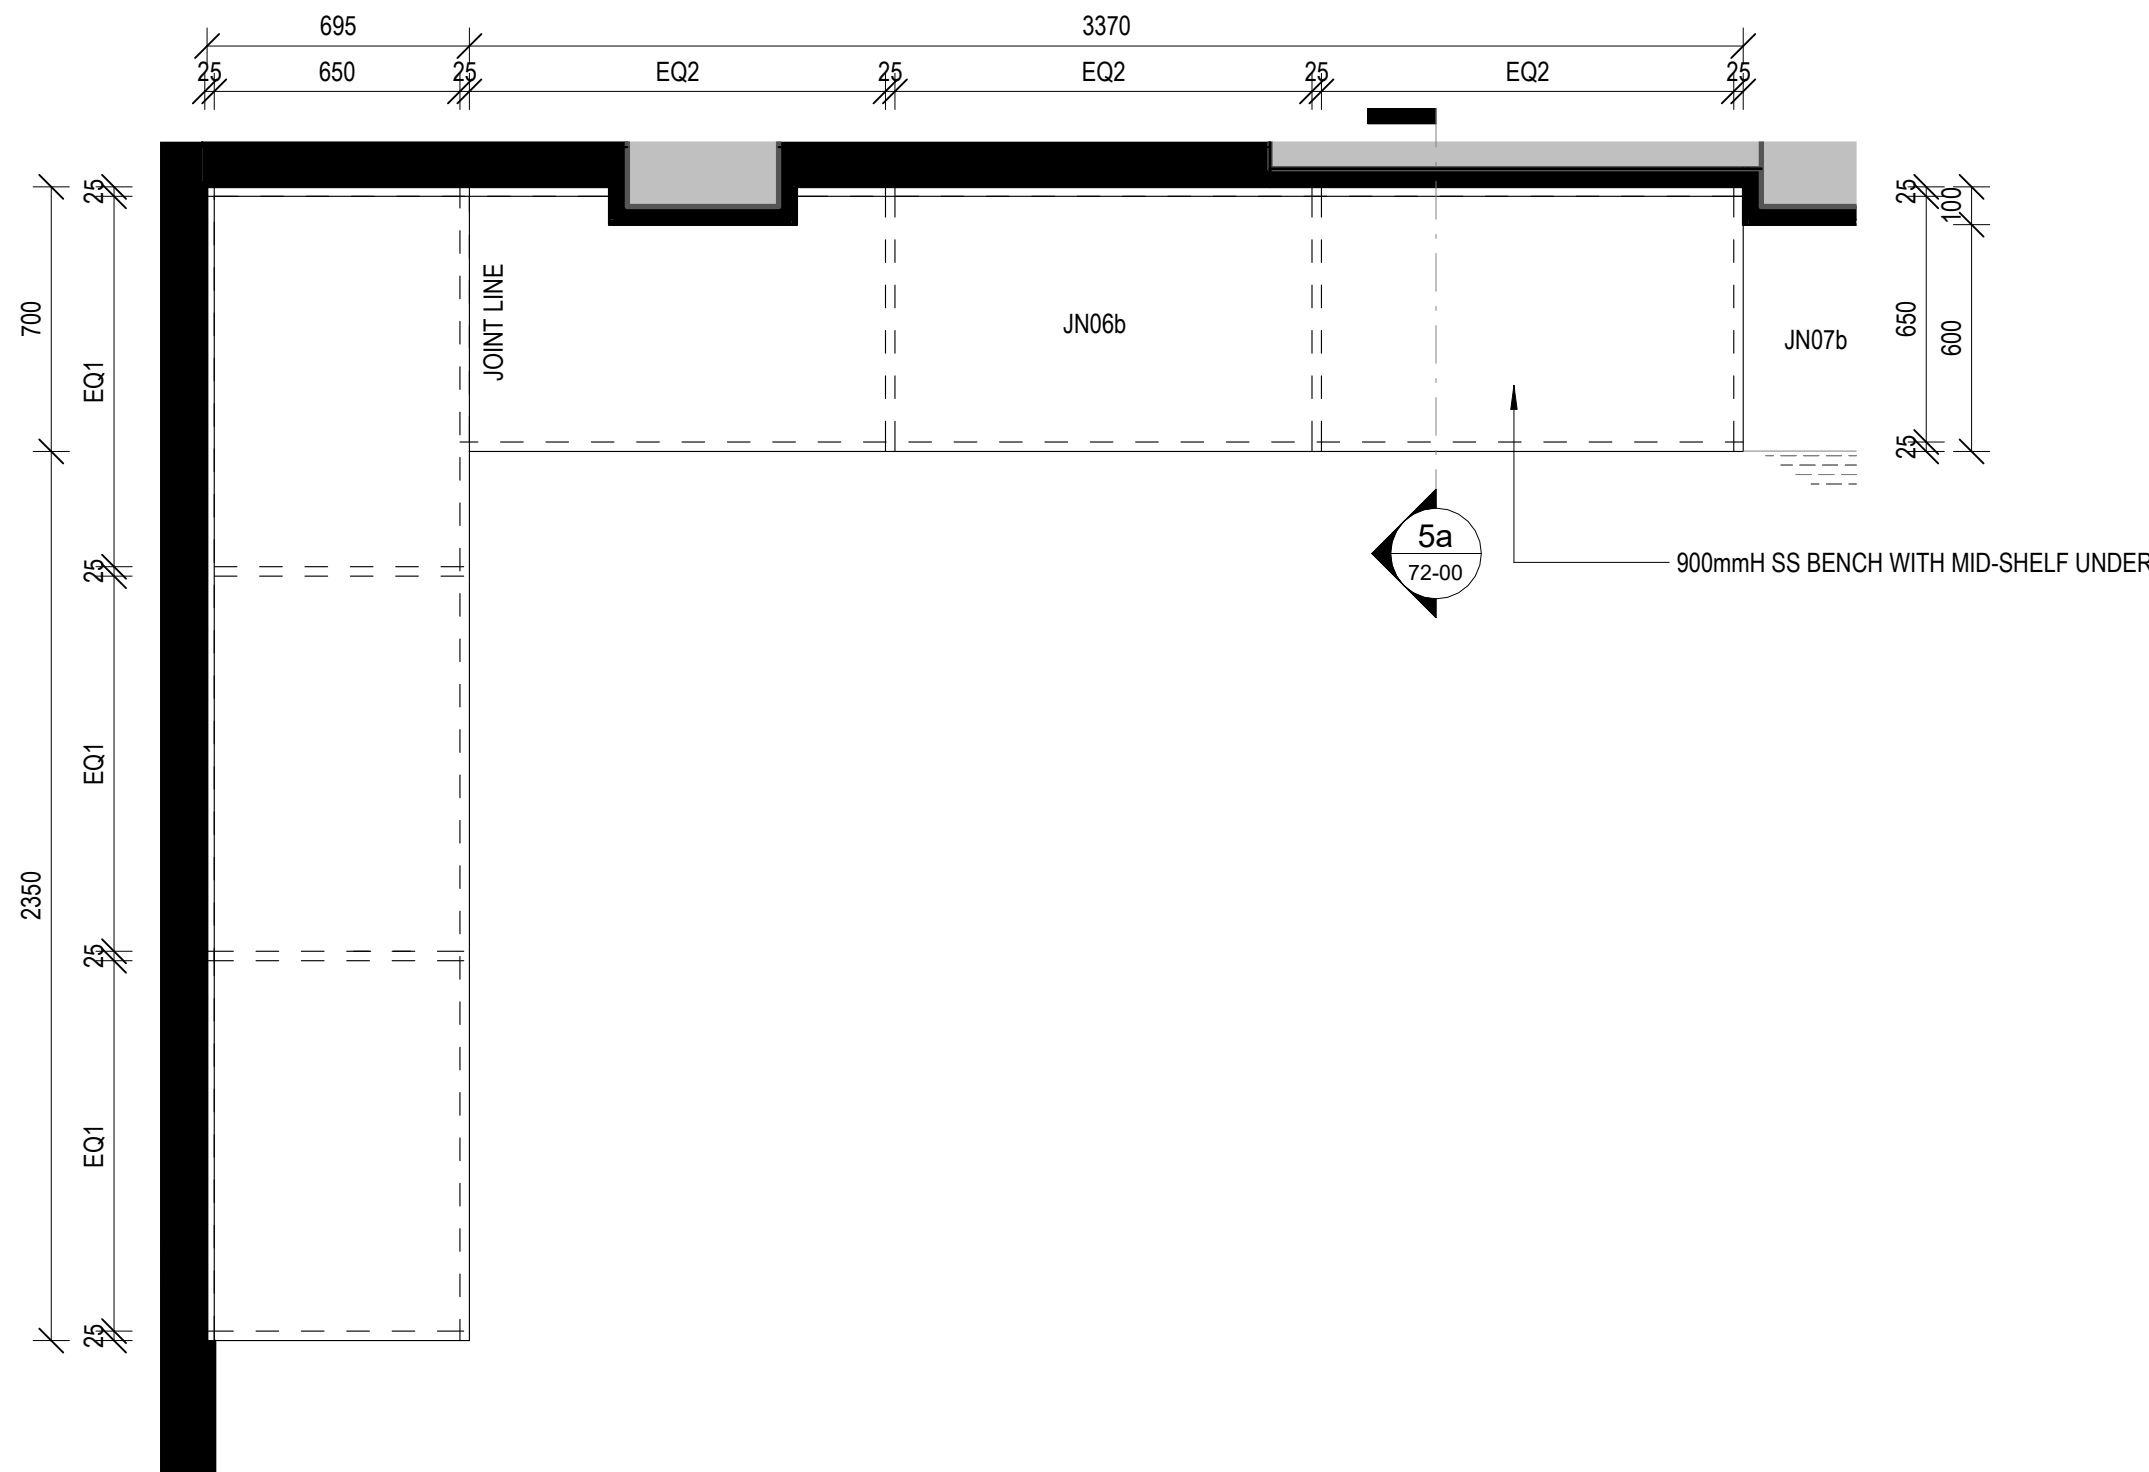

2
30-00
PLAN - JN06b - SS BENCH
1 : 20

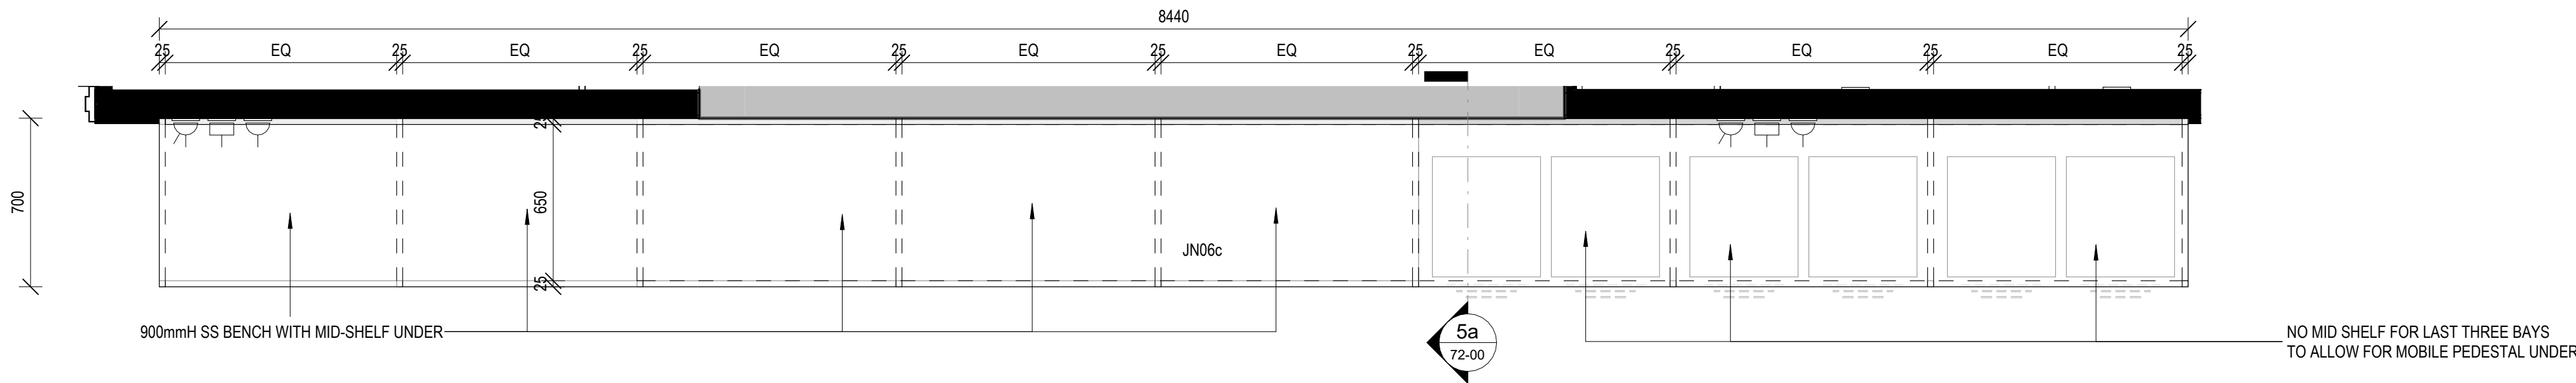

3
30-00
PLAN - JN06c - SS BENCH
1 : 20

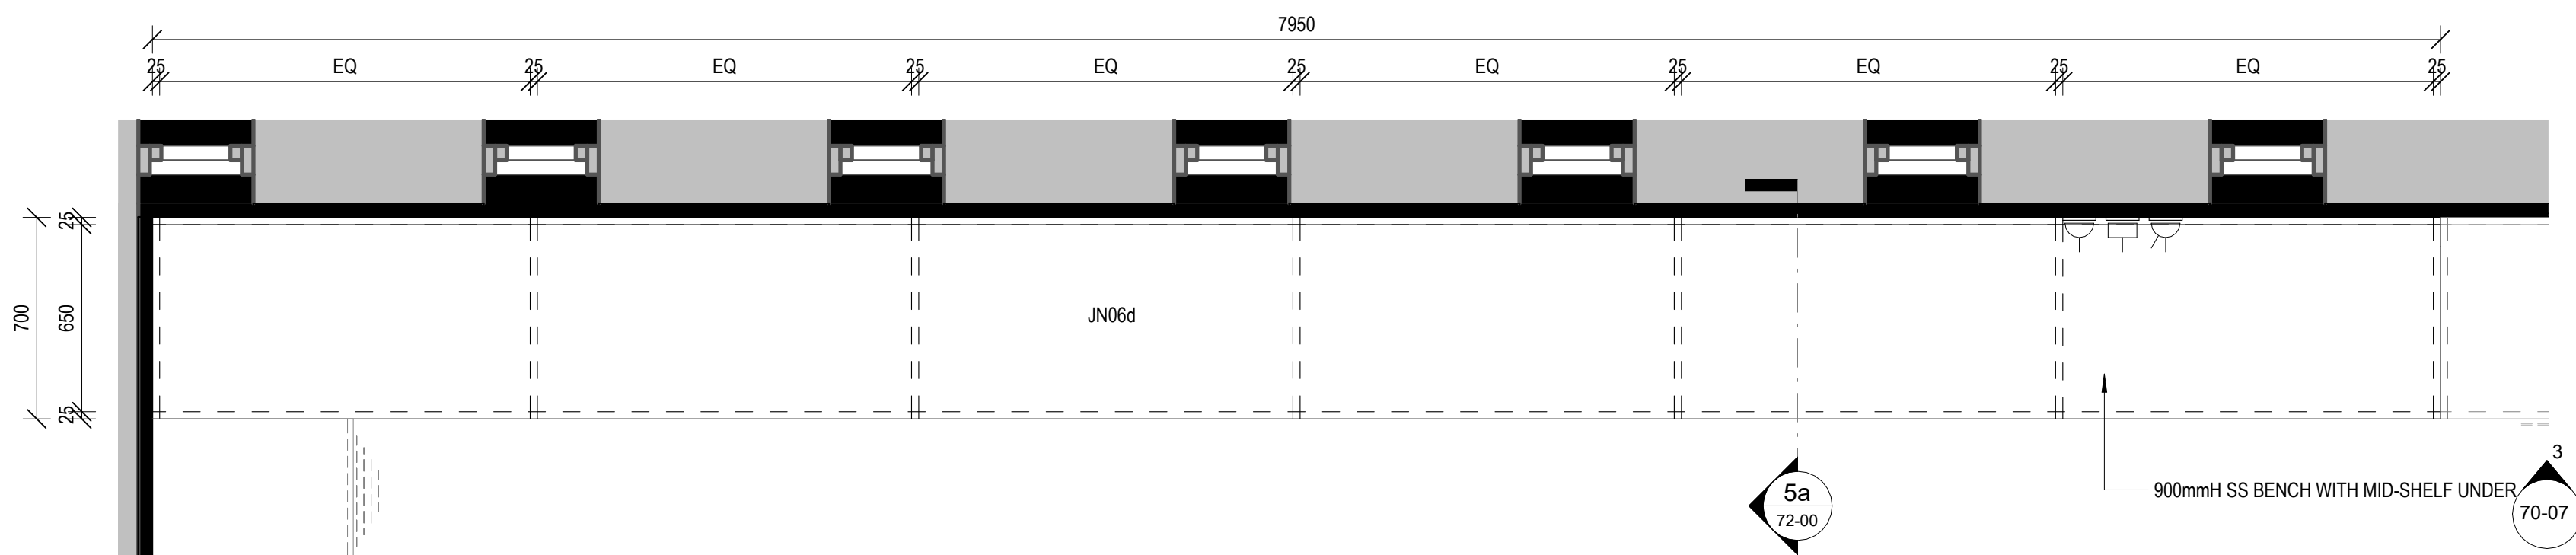

4
30-00
PLAN - JN06d - SS BENCH
1 : 20

AS CONSTRUCTED

thomson
adsett

Telephone +61 7 3840 9999
bne@thomsonadsett.com
Level 9, 470 St Pauls Terrace
Fortitude Valley
Qld 4006 Australia
thomsonadsett.com

© Copyright
These drawings and designs and the copyright thereof are the property of Thomson Adsett Pty Ltd and must not be used, retained or copied without written permission of Thomson Adsett Pty Ltd. ABN 76 105 314 654 Trading as ThomsonAdsett. Dimensions take precedence over scaling. Do not measure off drawings as print sizes may vary

BUILDING 33 REDEVELOPMENT

554/700 YAAMBA ROAD,
NORMAN GARDENS QLD 4701

for
CQUniversity
NORTH ROCKHAMPTON CAMPUS
& GIRVAN




GIRVAN

B	25/06/2024	AS CONSTRUCTED	PB
A	02/02/2024	IFC	PB
5	20/12/2023	REVISED ISSUE	PB
4	19/12/2023	REVISED ISSUE	PB
3	20/09/2023	ISSUE FOR INFORMATION	WL
2	11/09/2023	AMENDED 60% DD ISSUE	PB
1	28/08/2023	60% DD ISSUE	WL

rev	date	details	init
-----	------	---------	------

drawn	date
WL	JUL 2023
checked	date
NC	JUL 2023
verified	date
GK	DEC 2023

scale

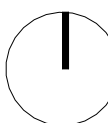

JOINERY DETAILS

scale	project no.
1 : 20 @ A1	23.0078.17

sheet no.
CQU-ROK-033-GN-ARC-70-05

revision
B

original sheet size - A1 (594mm x 841mm)

C:\REVIT\LOCAL\FILES\23.0078.17_CQU Building 33 Redevelopment_2023_Philip Bugden.nt 2/07/2024 4:53:19 PM

BUILDING 33
REDEVELOPMENT

554/700 YAAMBA ROAD,
NORMAN GARDENS QLD 4701

for
CQUUniversity
NORTH ROCKHAMPTON CAMPUS
& GIRVAN



GIRVAN

B	25/06/2024	AS CONSTRUCTED	PB
A	02/02/2024	IFC	PB
3	20/09/2023	ISSUE FOR INFORMATION	WL
2	11/09/2023	AMENDED 60% DD ISSUE	PB
1	28/08/2023	60% DD ISSUE	WL

rev	date	details	init
-----	------	---------	------

drawn	date
WL	JUL 2023
checked	date
NC	JUL 2023
verified	date
GK	DEC 2023

scale


JOINERY DETAILS

scale
1 : 20 @ A1


project no.
23.0078.17

sheet no.
CQU-ROK-033-GN-ARC-70-06


revision
B

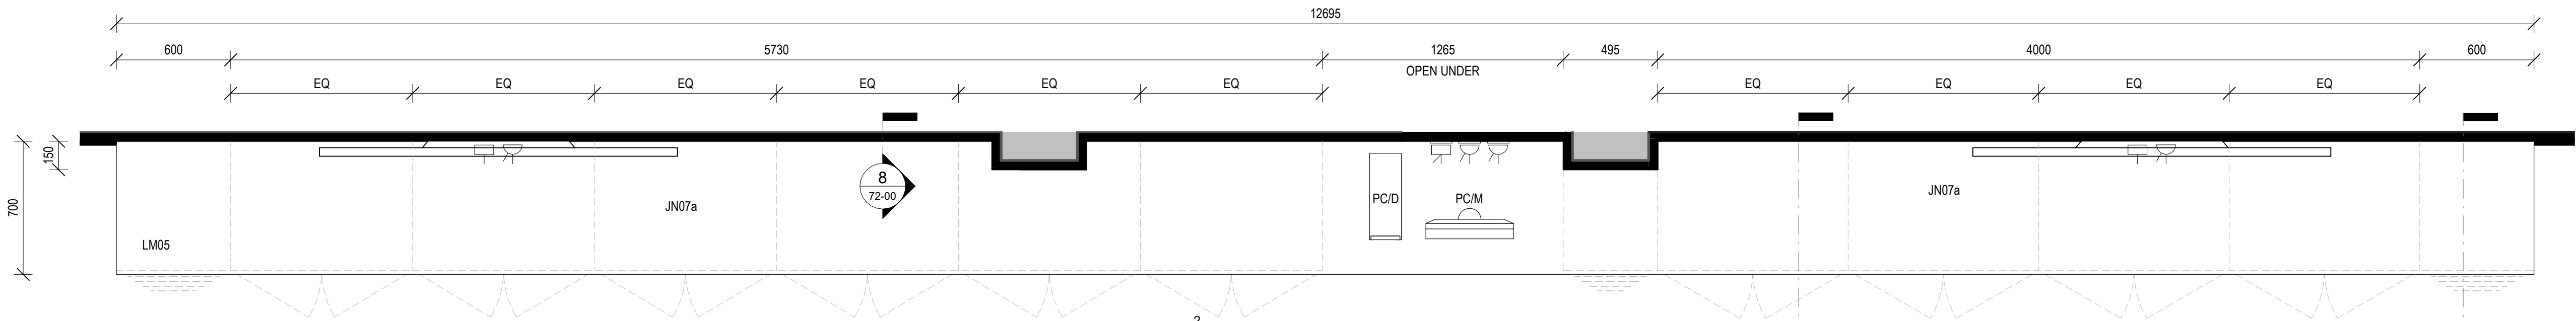


1
30-00
PLAN - JN07a - LAMINATE BENCH
1 : 20

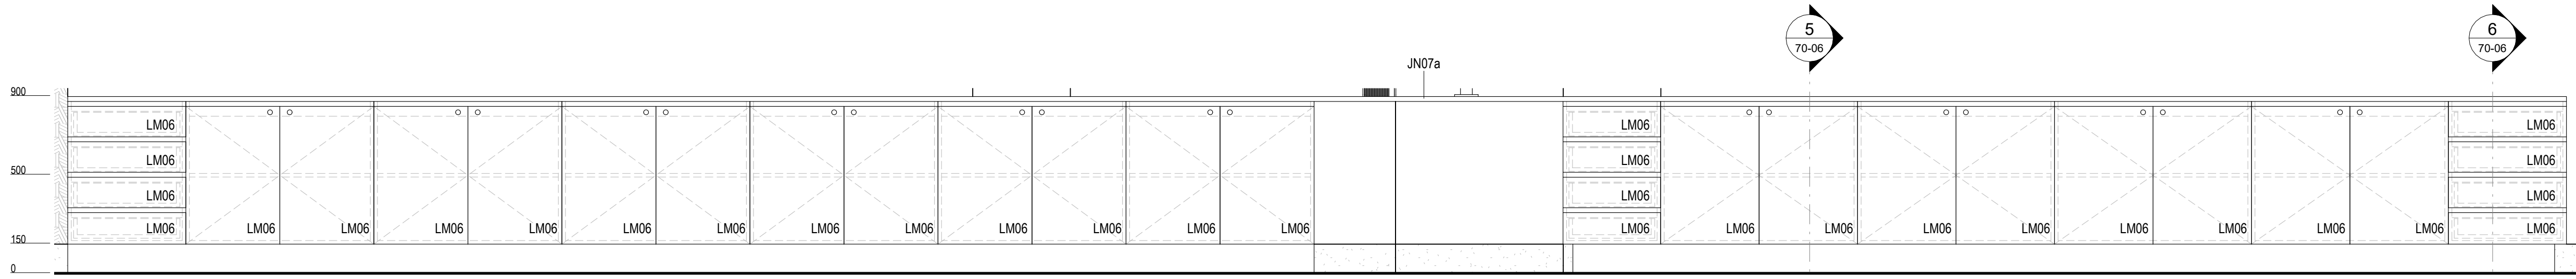


2
70-06
ELEVATION - JN07a
1 : 20

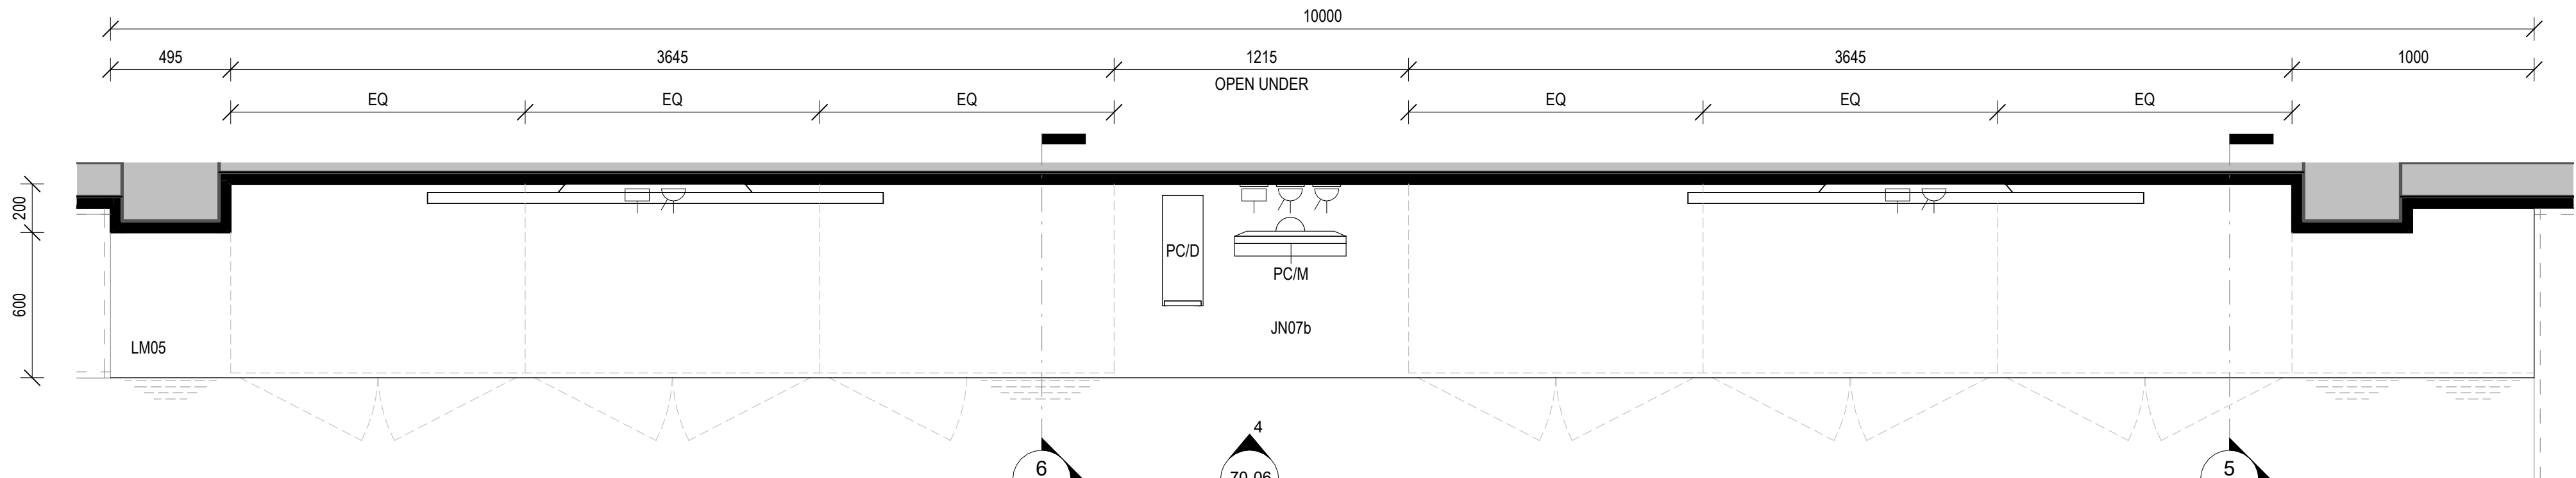


3
30-00
PLAN - JN07b - LAMINATE BENCH
1 : 20

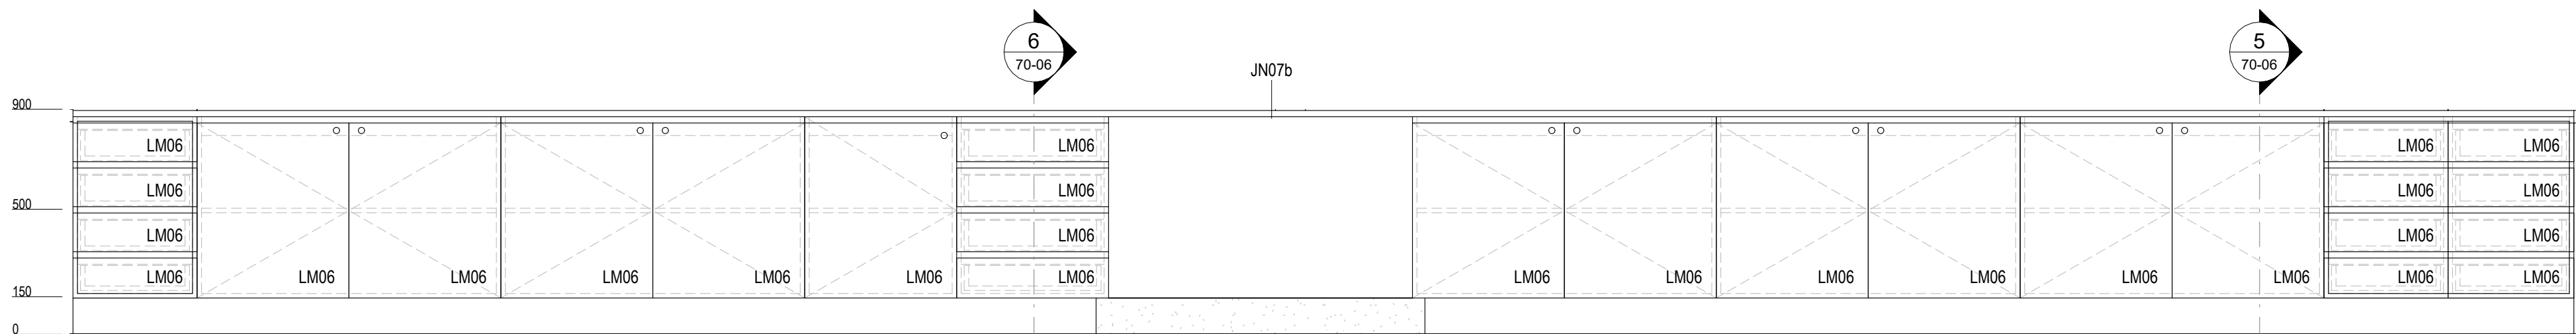

4
70-06
ELEVATION - JN07b
1 : 20

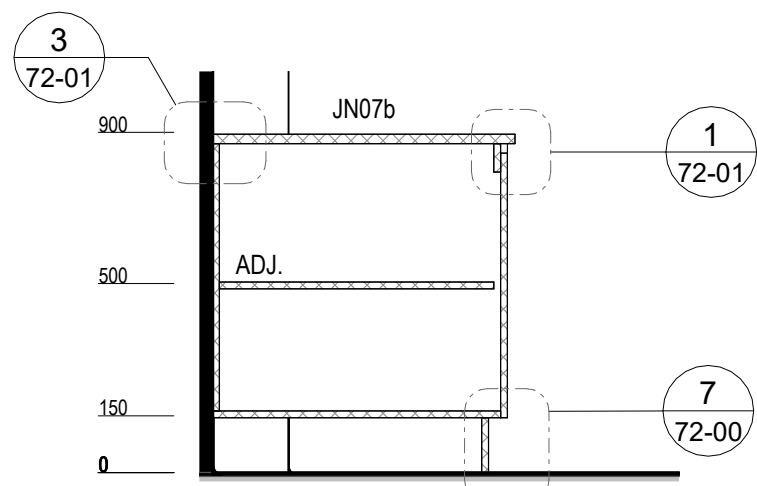


5
70-06
JN07b - SECTIONAL DETAIL
1 : 20

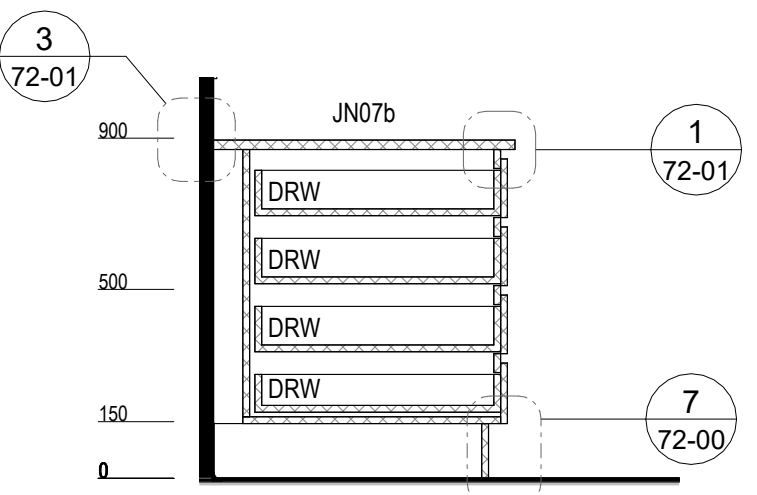


6
70-06
JN07b - SECTIONAL DETAIL1
1 : 20


AS CONSTRUCTED

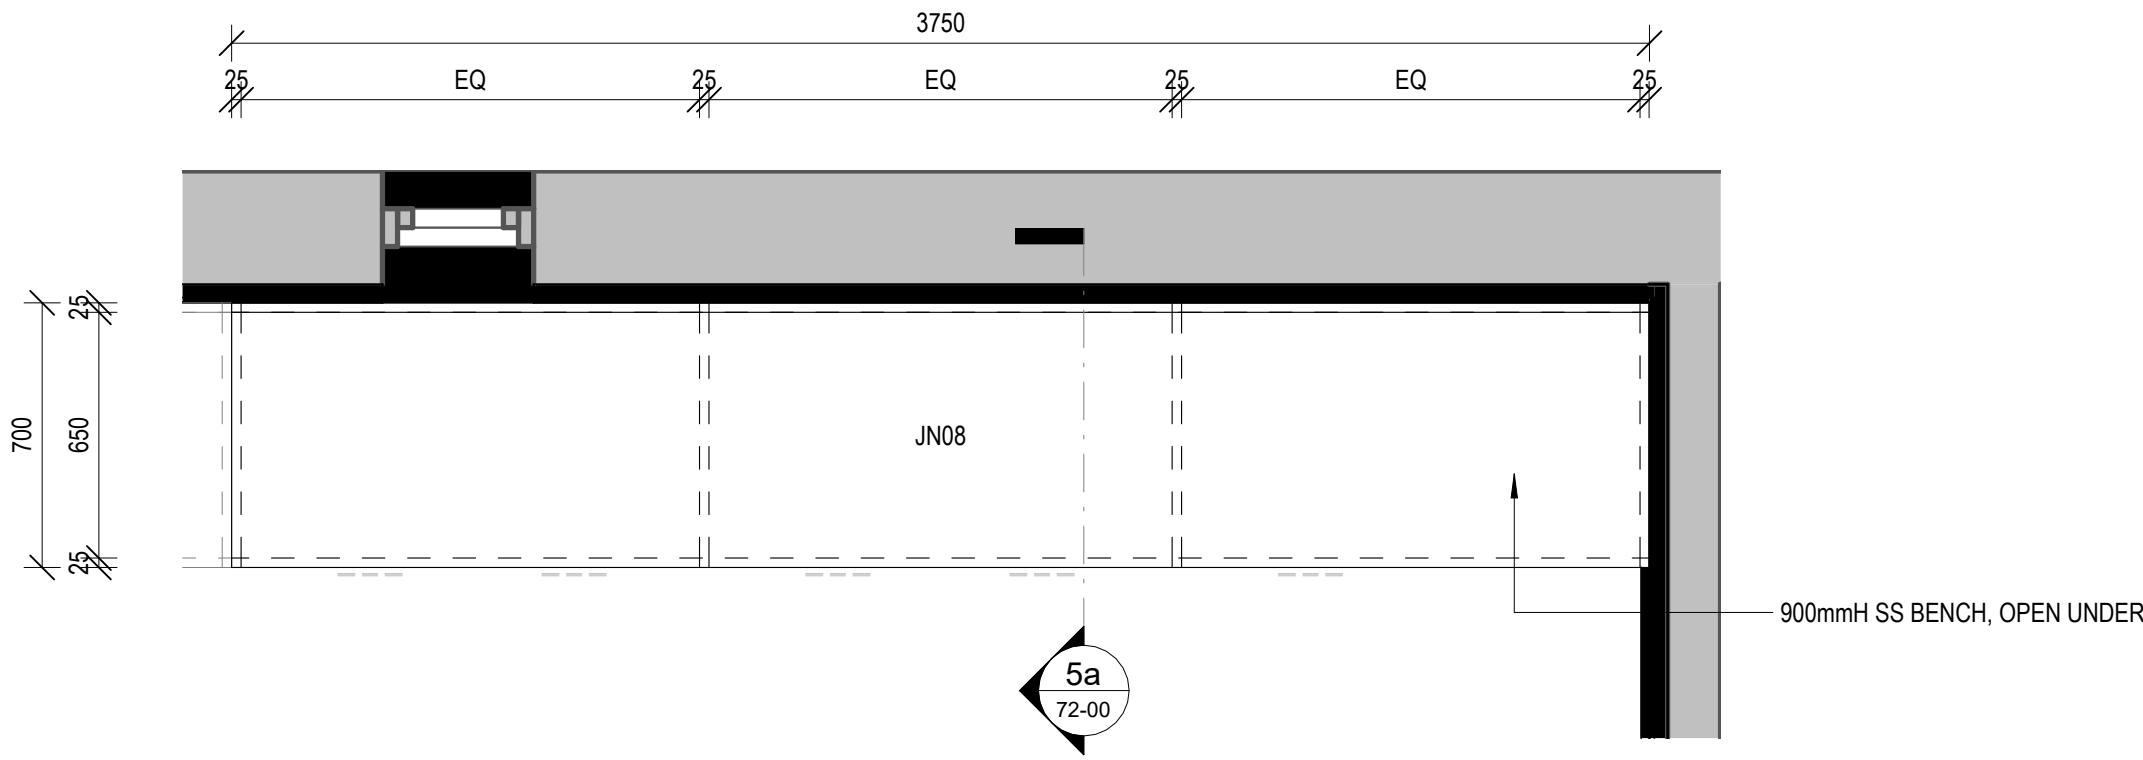


1 PLAN - JN08 - SS BENCH, OPEN UNDER
30-00 1 : 20

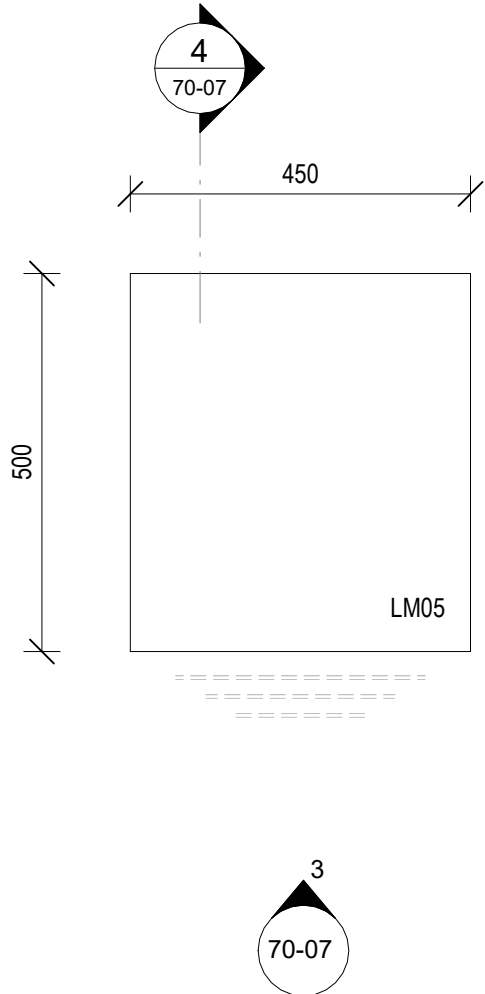

2 PLAN - JN12 - CABINET ON CASTORS
30-00 1 : 10

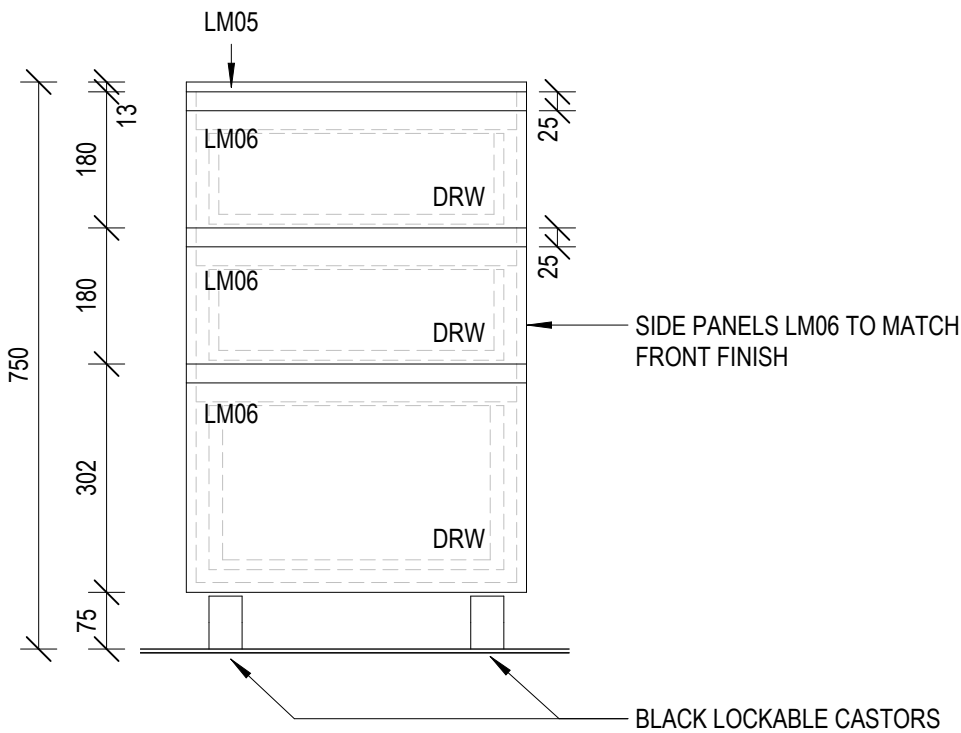

3 ELEVATION - JN12
70-05 1 : 10

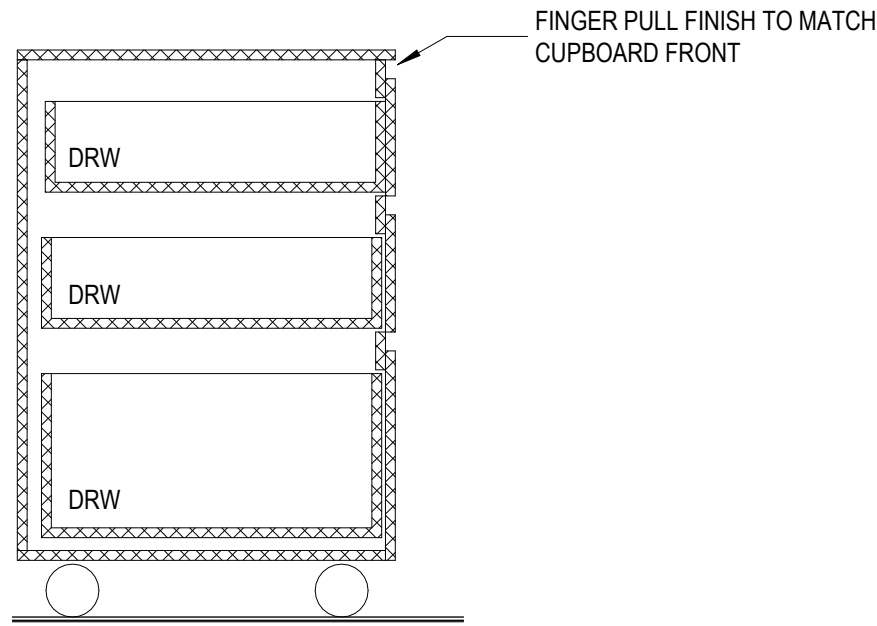

4 SECTION - JN12
70-07 1 : 10

thomson
adsett

Telephone +61 7 3840 9999
bne@thomsonadsett.com
Level 9, 470 St Pauls Terrace
Fortitude Valley
Qld 4006 Australia
thomsonadsett.com

© Copyright
These drawings and designs and the copyright thereof are the property of Thomson Adsett Pty Ltd and must not be used, retained or copied without written permission of Thomson Adsett Pty Ltd. ABN 76 105 314 654 Trading as ThomsonAdsett. Dimensions take precedence over scaling. Do not measure off drawings as print sizes may vary

BUILDING 33 REDEVELOPMENT

554/700 YAAMBA ROAD,
NORMAN GARDENS QLD 4701

for
CQUniversity
NORTH ROCKHAMPTON CAMPUS
& GIRVAN




GIRVAN

B	25/06/2024	AS CONSTRUCTED	PB
A	02/02/2024	IFC	PB
3	20/09/2023	ISSUE FOR INFORMATION	WL
2	11/09/2023	AMENDED 60% DD ISSUE	PB
1	28/08/2023	60% DD ISSUE	WL

rev	date	details	init
-----	------	---------	------

drawn	date
WL	JUL 2023
checked	date
NC	JUL 2023
verified	date
GK	DEC 2023

scale

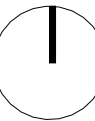

JOINERY DETAILS

scale project no.
As indicated @ A1 23.0078.17


sheet no.
CQU-ROK-033-GN-ARC-70-07

revision
B

original sheet size - A1 (594mm x 841mm)

AS CONSTRUCTED


C:\REVIT\LOCAL\FILES\23.0078.17_CQU Building 33 Redevelopment_2023_Philip Bugden.nt 21/07/2024 4:53:22 PM

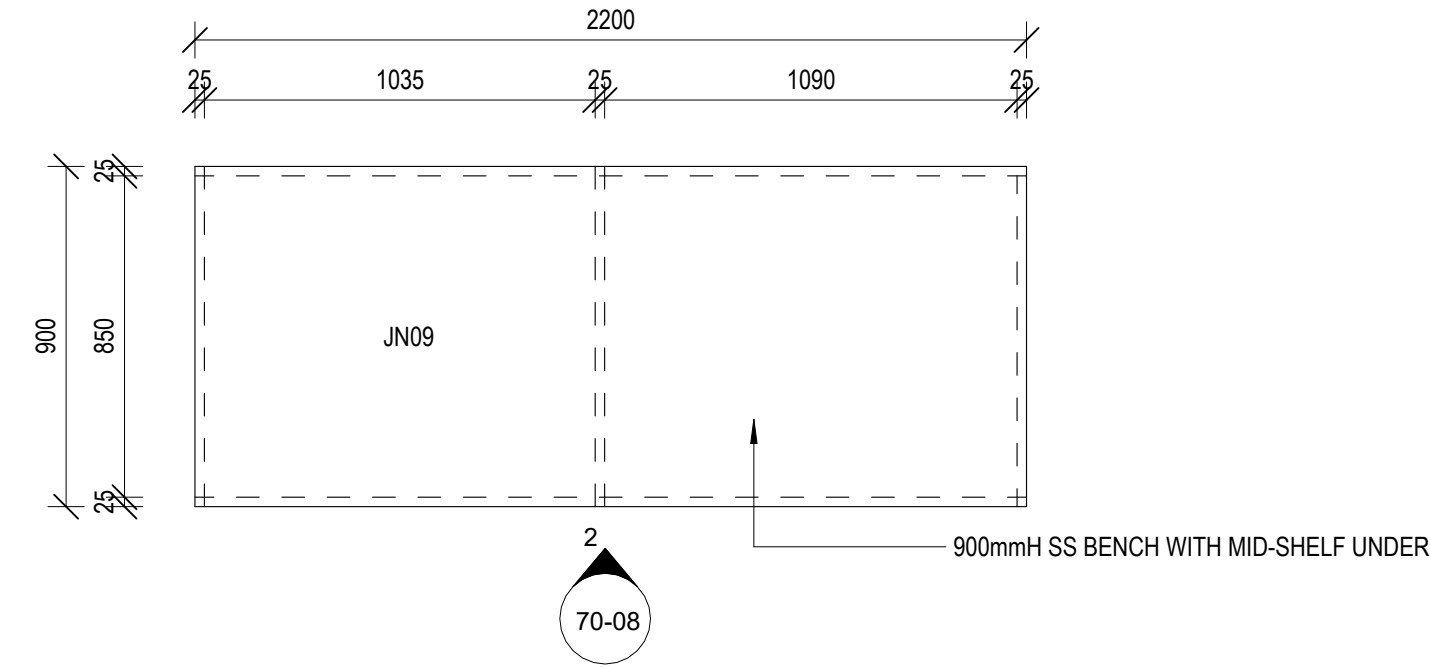

1
30-00

PLAN - JN09 - SS ISLAND BENCH

1 : 20

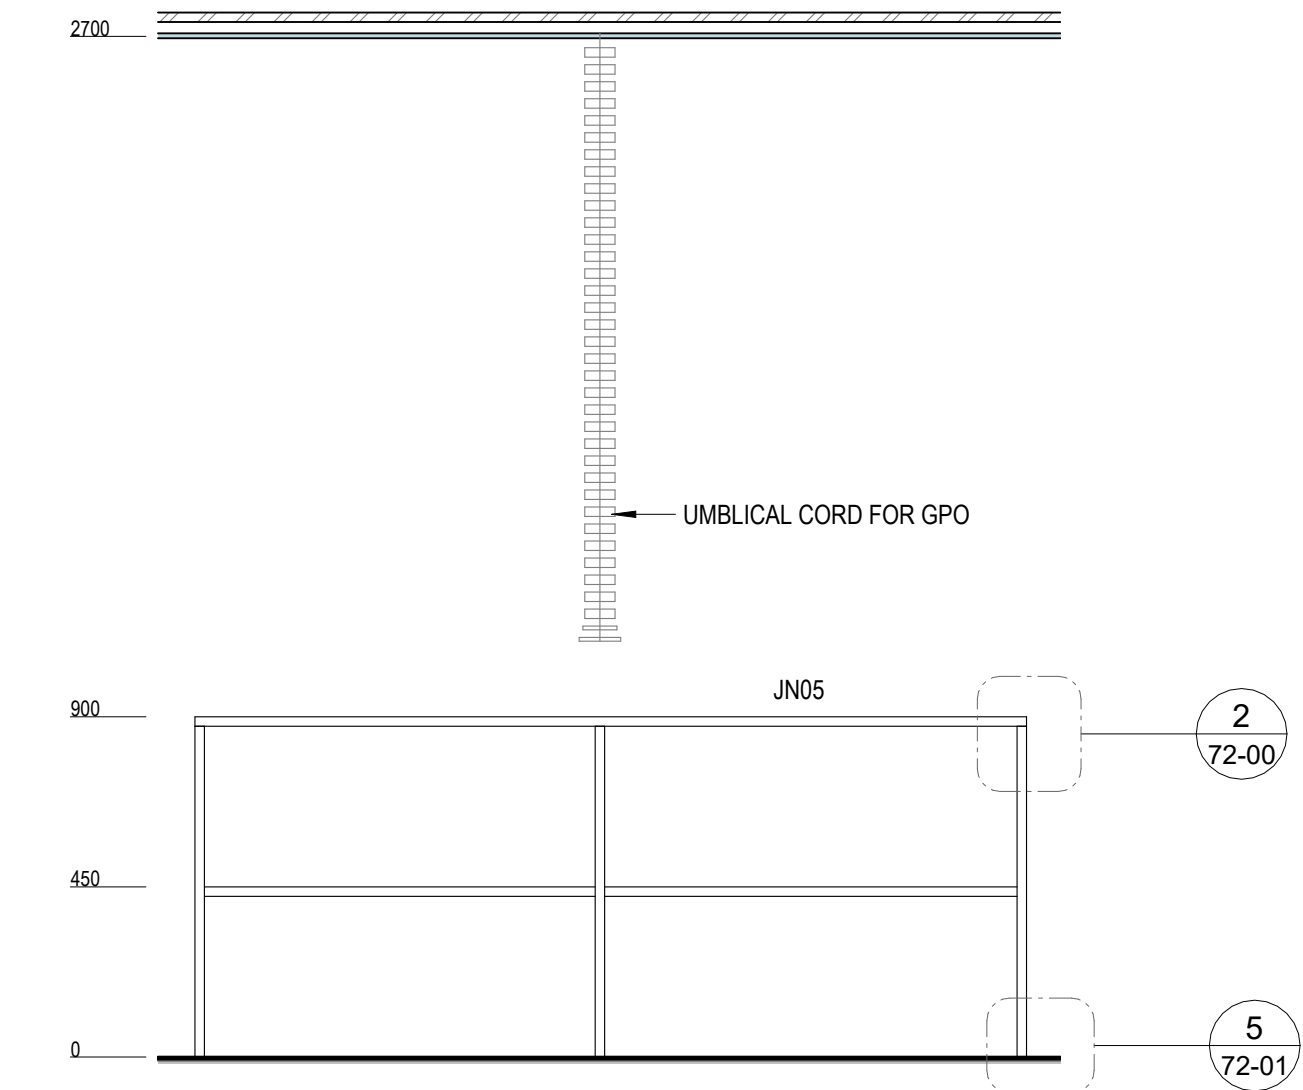

2
70-08

ELEVATION - JN09

1 : 20

AS CONSTRUCTED

thomson
adsett

Telephone +61 7 3840 9999
bne@thomsonadsett.com
Level 9, 470 St Pauls Terrace
Fortitude Valley
Qld 4006 Australia
thomsonadsett.com

© Copyright
These drawings and designs and the copyright thereof are the property of Thomson Adsett Pty Ltd and must not be used, retained or copied without written permission of Thomson Adsett Pty Ltd. ABN 76 105 314 654 Trading as ThomsonAdsett. Dimensions take precedence over scaling. Do not measure off drawings as print sizes may vary

BUILDING 33
REDEVELOPMENT

554/700 YAAMBA ROAD,
NORMAN GARDENS QLD 4701

for
CQUniversity
NORTH ROCKHAMPTON CAMPUS
& GIRVAN




GIRVAN

B	25/06/2024	AS CONSTRUCTED	PB
A	02/02/2024	IFC	PB
3	20/09/2023	ISSUE FOR INFORMATION	WL
2	11/09/2023	AMENDED 60% DD ISSUE	PB
1	28/08/2023	60% DD ISSUE	WL

rev	date	details	init
-----	------	---------	------

drawn	date
WL	JUL 2023
checked	date
NC	JUL 2023
verified	date
GK	DEC 2023

scale

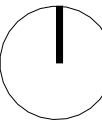

JOINERY DETAILS

scale
1 : 20 @ A1


project no.
23.0078.17

sheet no.
CQU-ROK-033-GN-ARC-70-08


revision
B

original sheet size - A1 (594mm x 841mm)


C:\REVIT\LOCAL\FILES\23.0078.17_CQU Building 33 Redevelopment_2023_Philip Bugden.nt 2/07/2024 4:53:22 PM

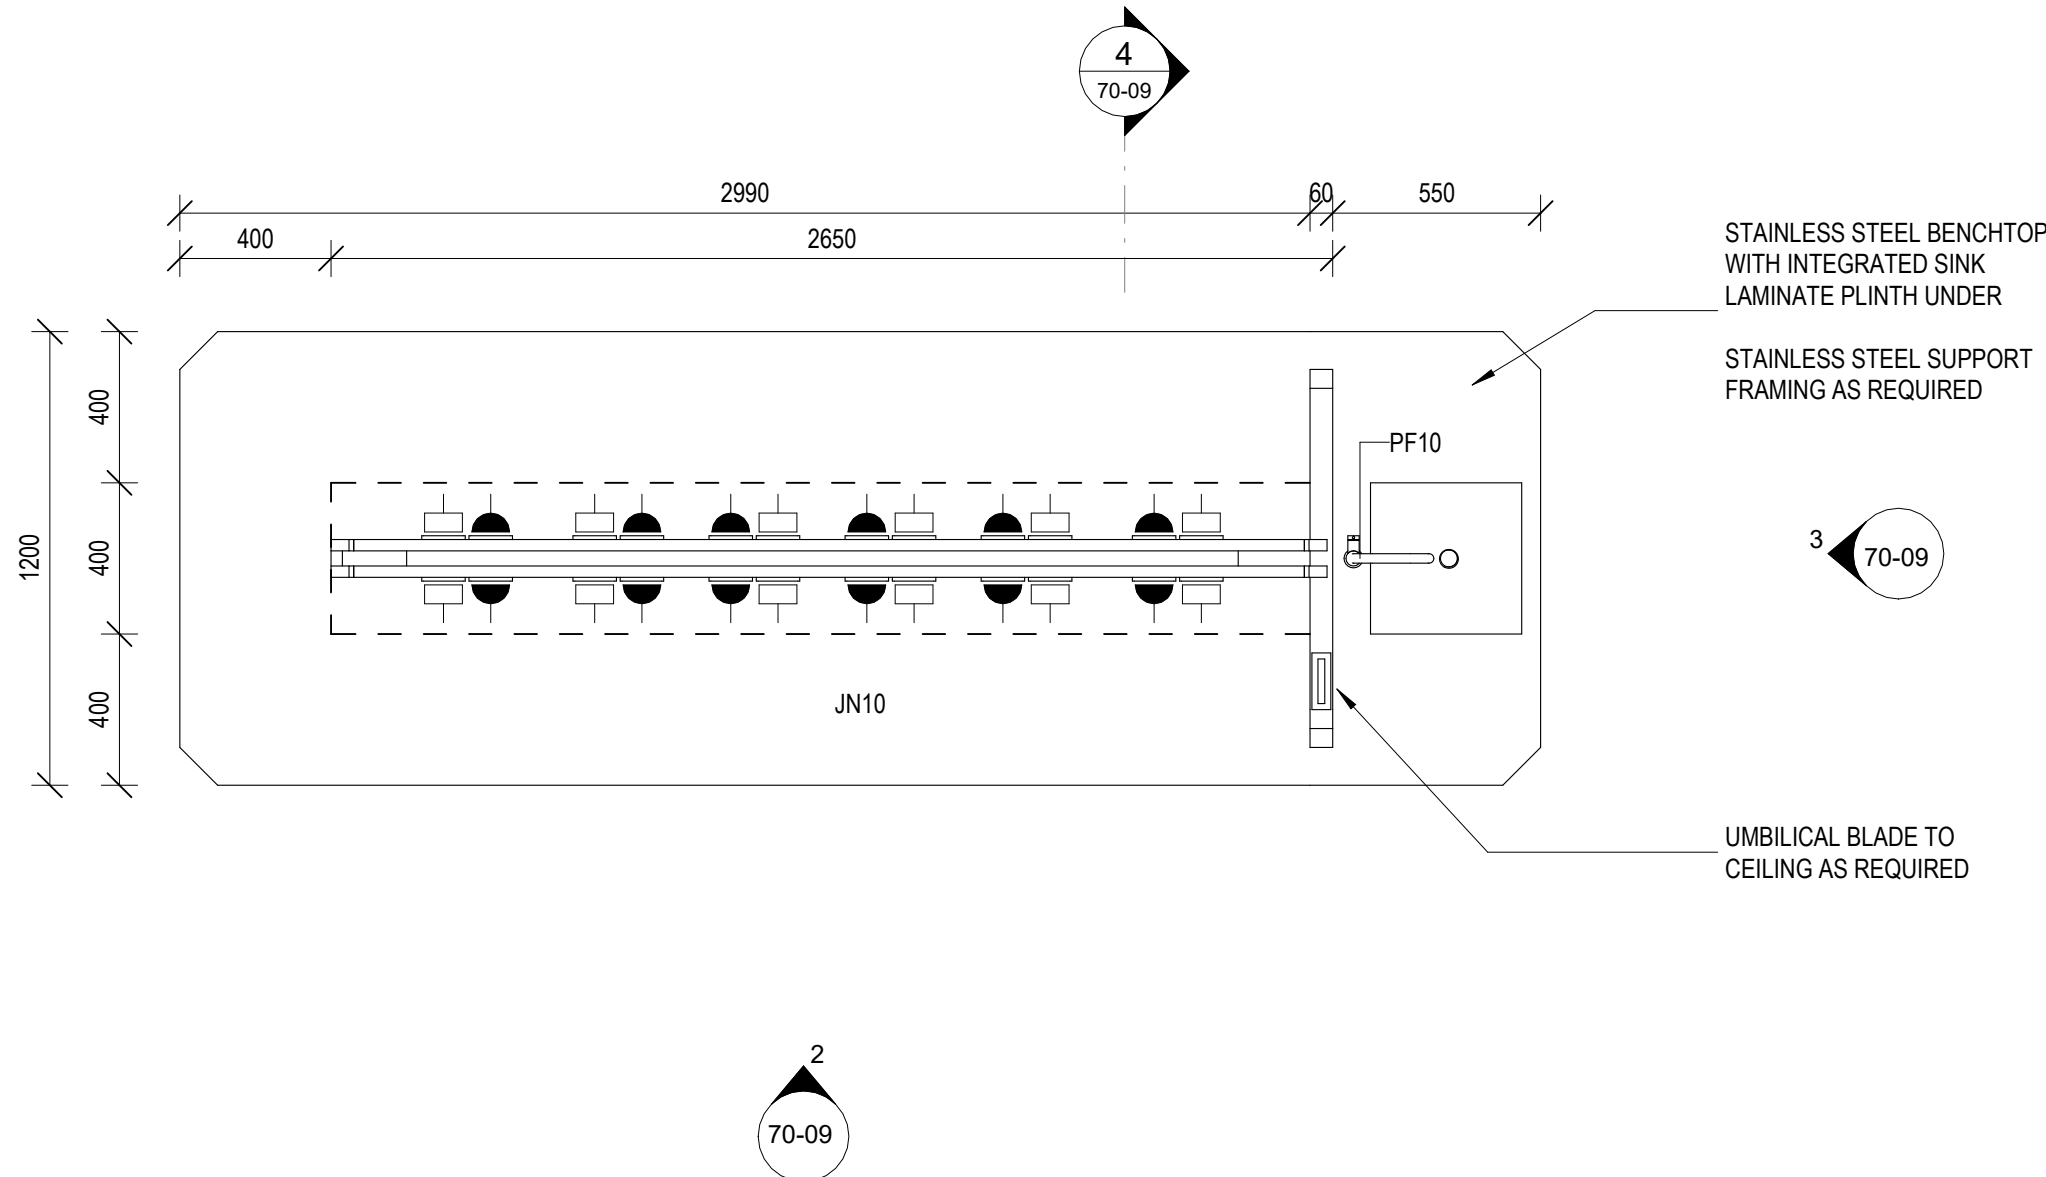


1A PLAN - JN10 - 8P LAB BENCH
1 : 20

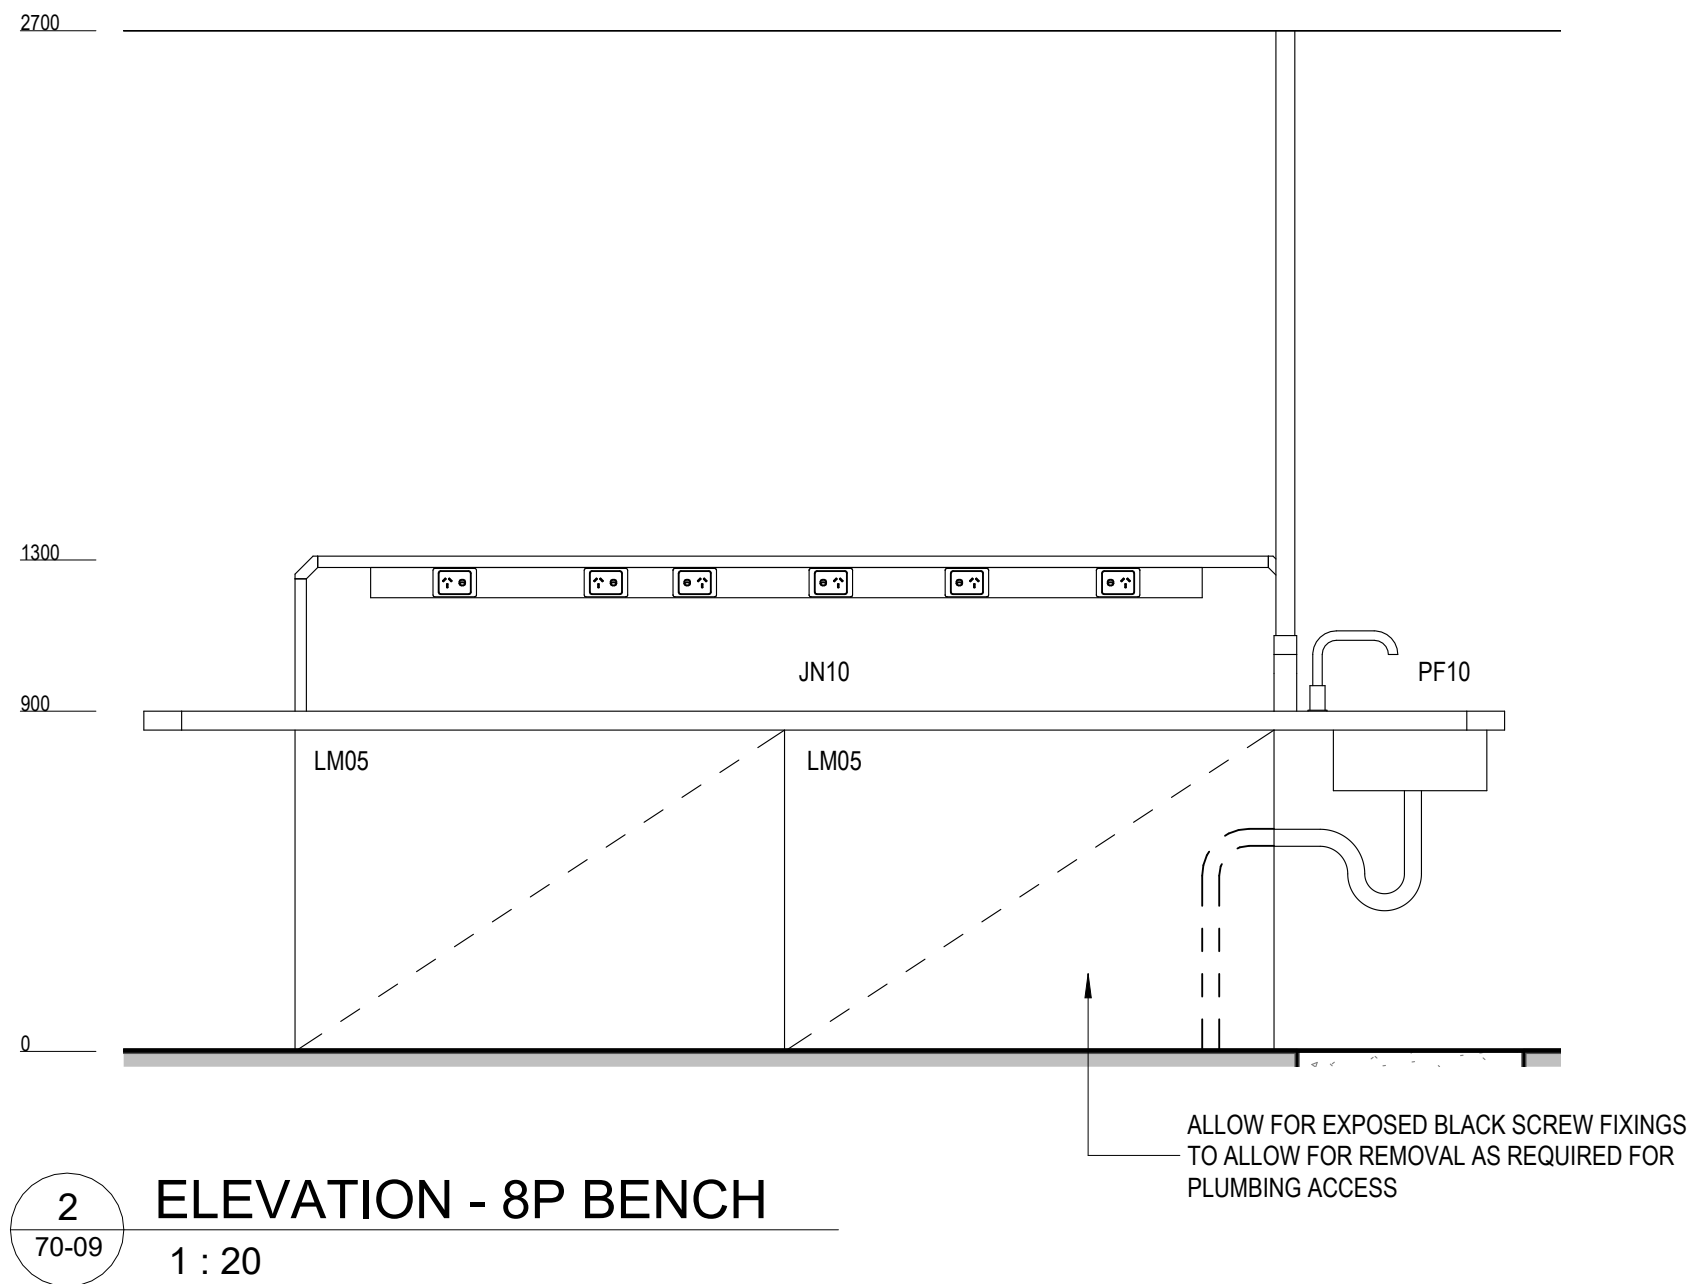


2 ELEVATION - 8P BENCH
1 : 20

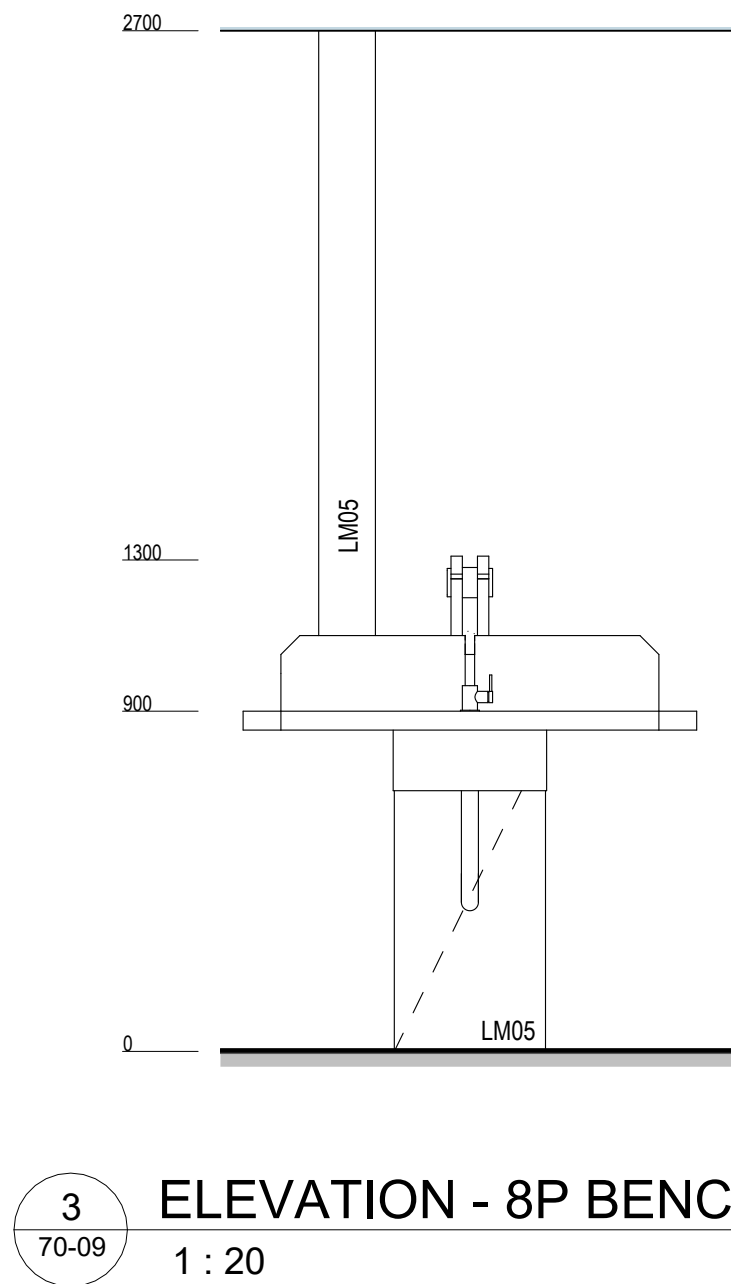

3 ELEVATION - 8P BENCH
1 : 20

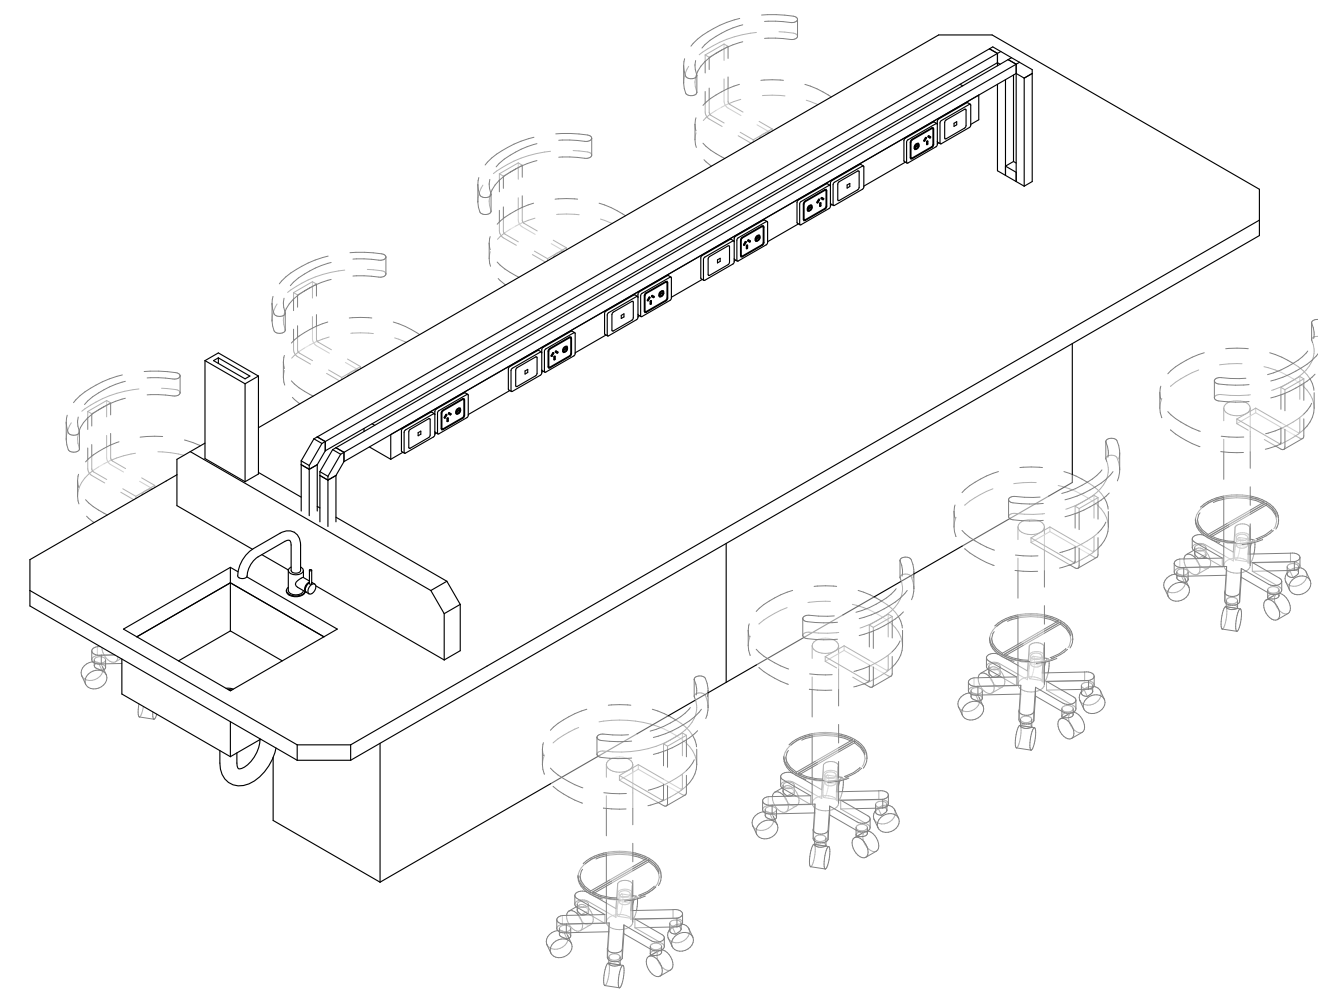

5 3D LAB 8P BENCH

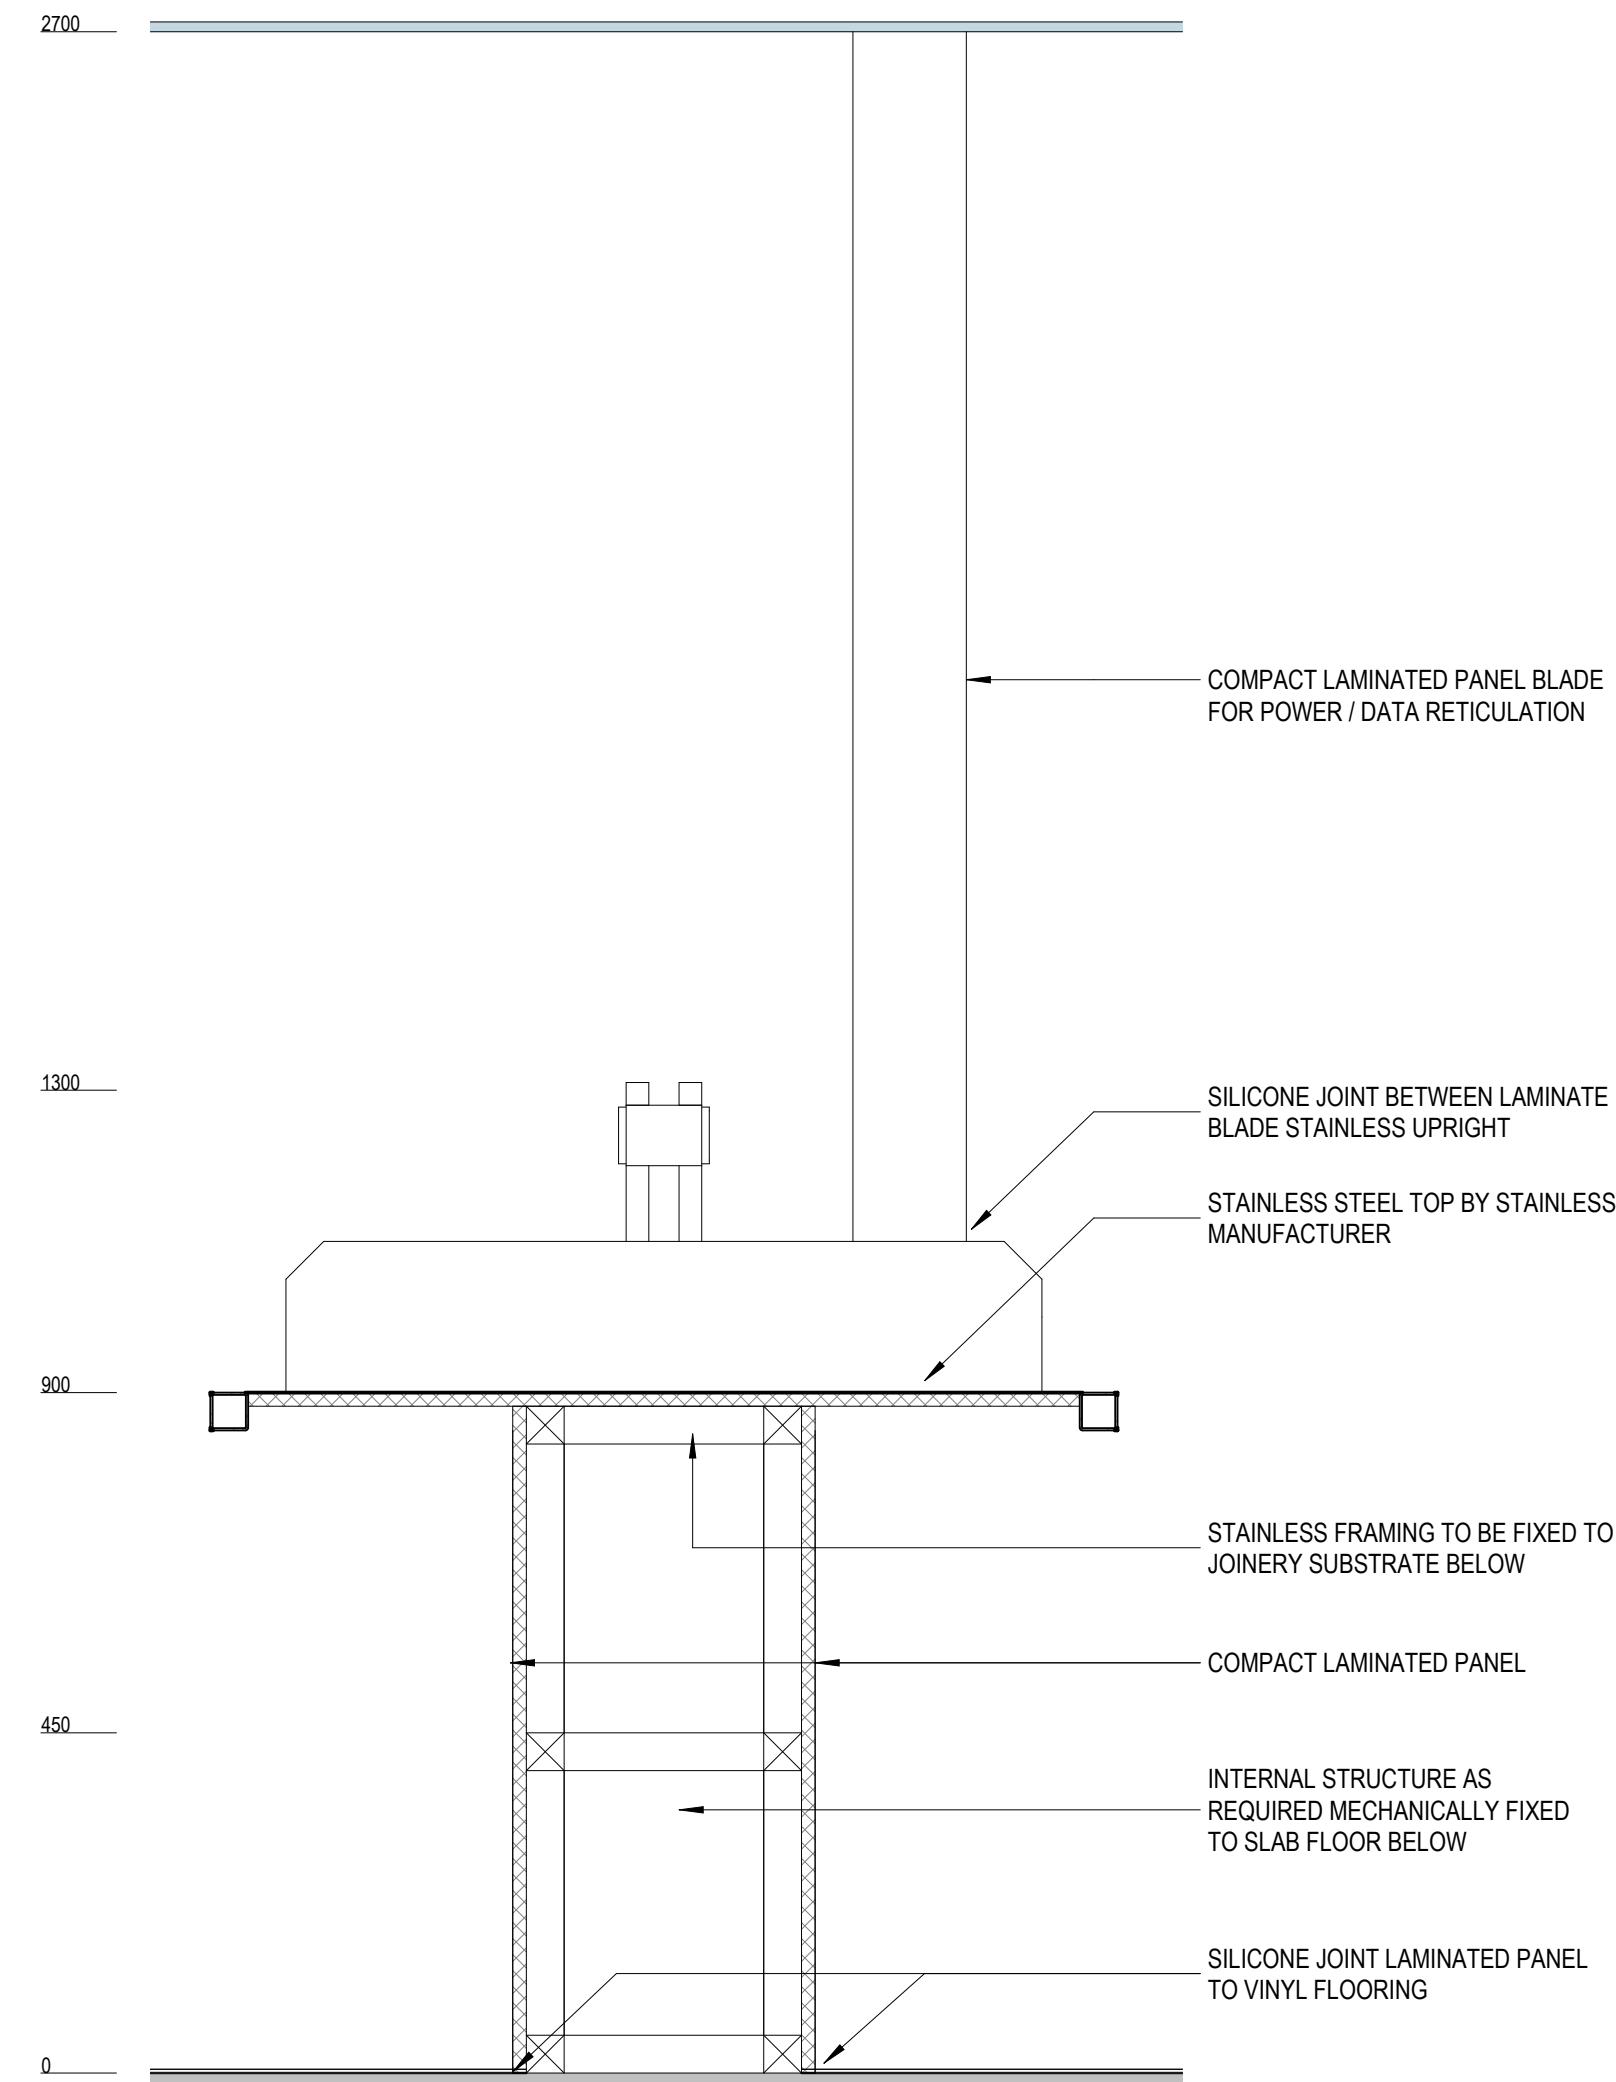

4 SECTION - 8 & 16P BENCH
1 : 10

AS CONSTRUCTED

thomson
adsett

Telephone +61 7 3840 9999
bne@thomsonadsett.com
Level 9, 470 St Pauls Terrace
Fortitude Valley
Qld 4006 Australia
thomsonadsett.com

© Copyright
These drawings and designs and the copyright thereof are the property of Thomson Adsett Pty Ltd and must not be used, retained or copied without written permission of Thomson Adsett Pty Ltd. ABN 76 105 314 654 Trading as ThomsonAdsett. Dimensions take precedence over scaling. Do not measure off drawings as print sizes may vary

BUILDING 33 REDEVELOPMENT

554/700 YAAMBA ROAD,
NORMAN GARDENS QLD 4701

for
CQUniversity
NORTH ROCKHAMPTON CAMPUS
& GIRVAN



GIRVAN

B	25/06/2024	AS CONSTRUCTED	PB
A	02/02/2024	IFC	PB
4	06/11/2023	REVISED ISSUE	AP
3	20/09/2023	ISSUE FOR INFORMATION	WL
2	11/09/2023	AMENDED 60% DD ISSUE	PB
1	28/08/2023	60% DD ISSUE	WL

rev	date	details	init
drawn	date		
WL	JUL 2023		
checked	date		
NC	JUL 2023		
verified	date		
GK	DEC 2023		

scale	


JOINERY DETAILS

scale	project no.
As indicated @ A1	23.0078.17


sheet no.	revision
CQU-ROK-033-GN-ARC-70-09	B

original sheet size - A1 (594mm x 841mm)


C:\REVIT\LOCAL\FILES\23.0078.17_CQU Building 33 Redevelopment_2023_Philip Bugden.nt

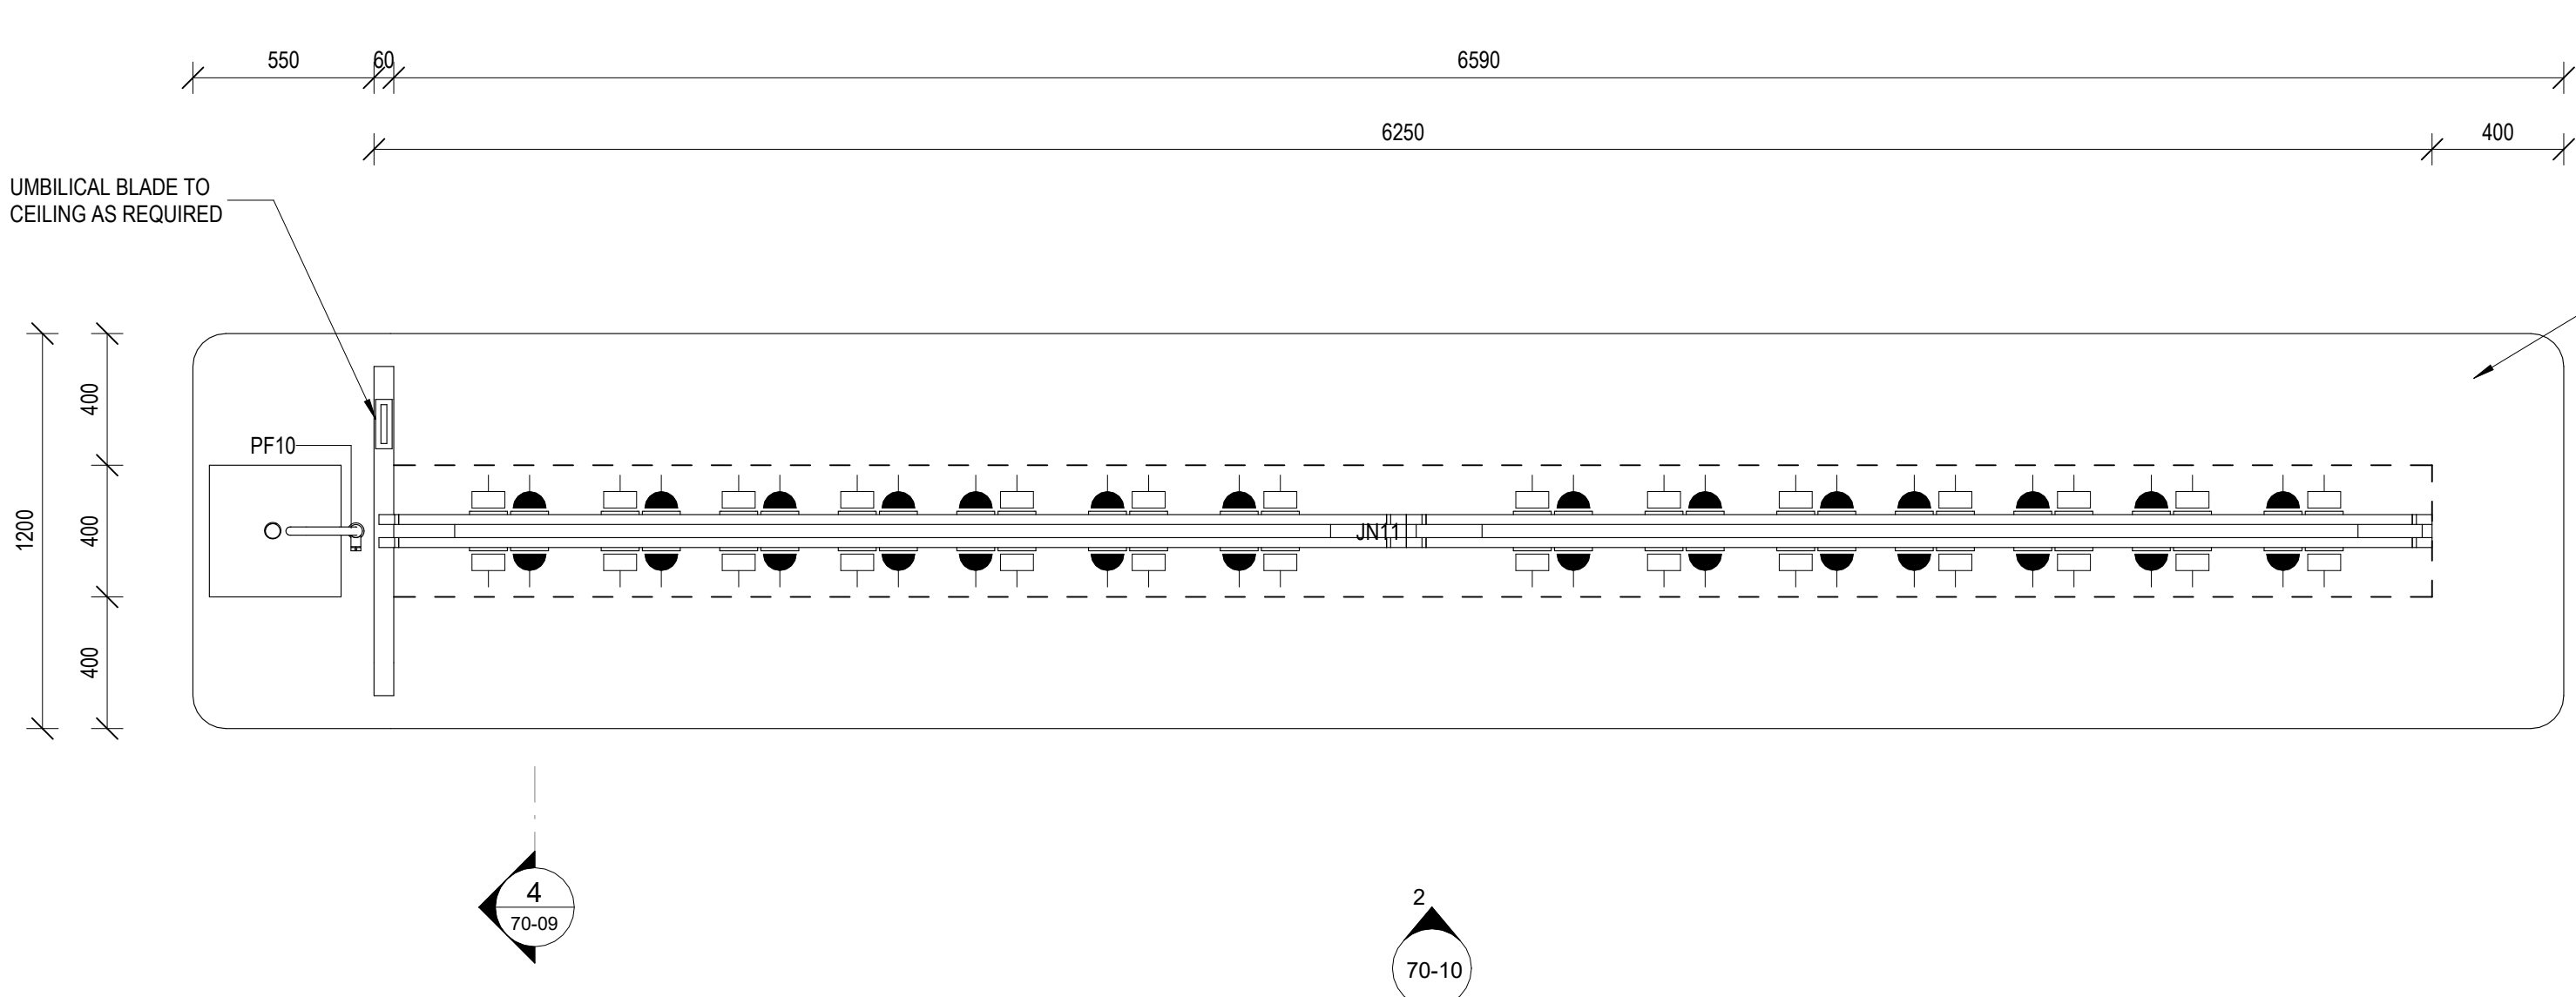


1 PLAN - JN11 - 16P LAB BENCH
1 : 20

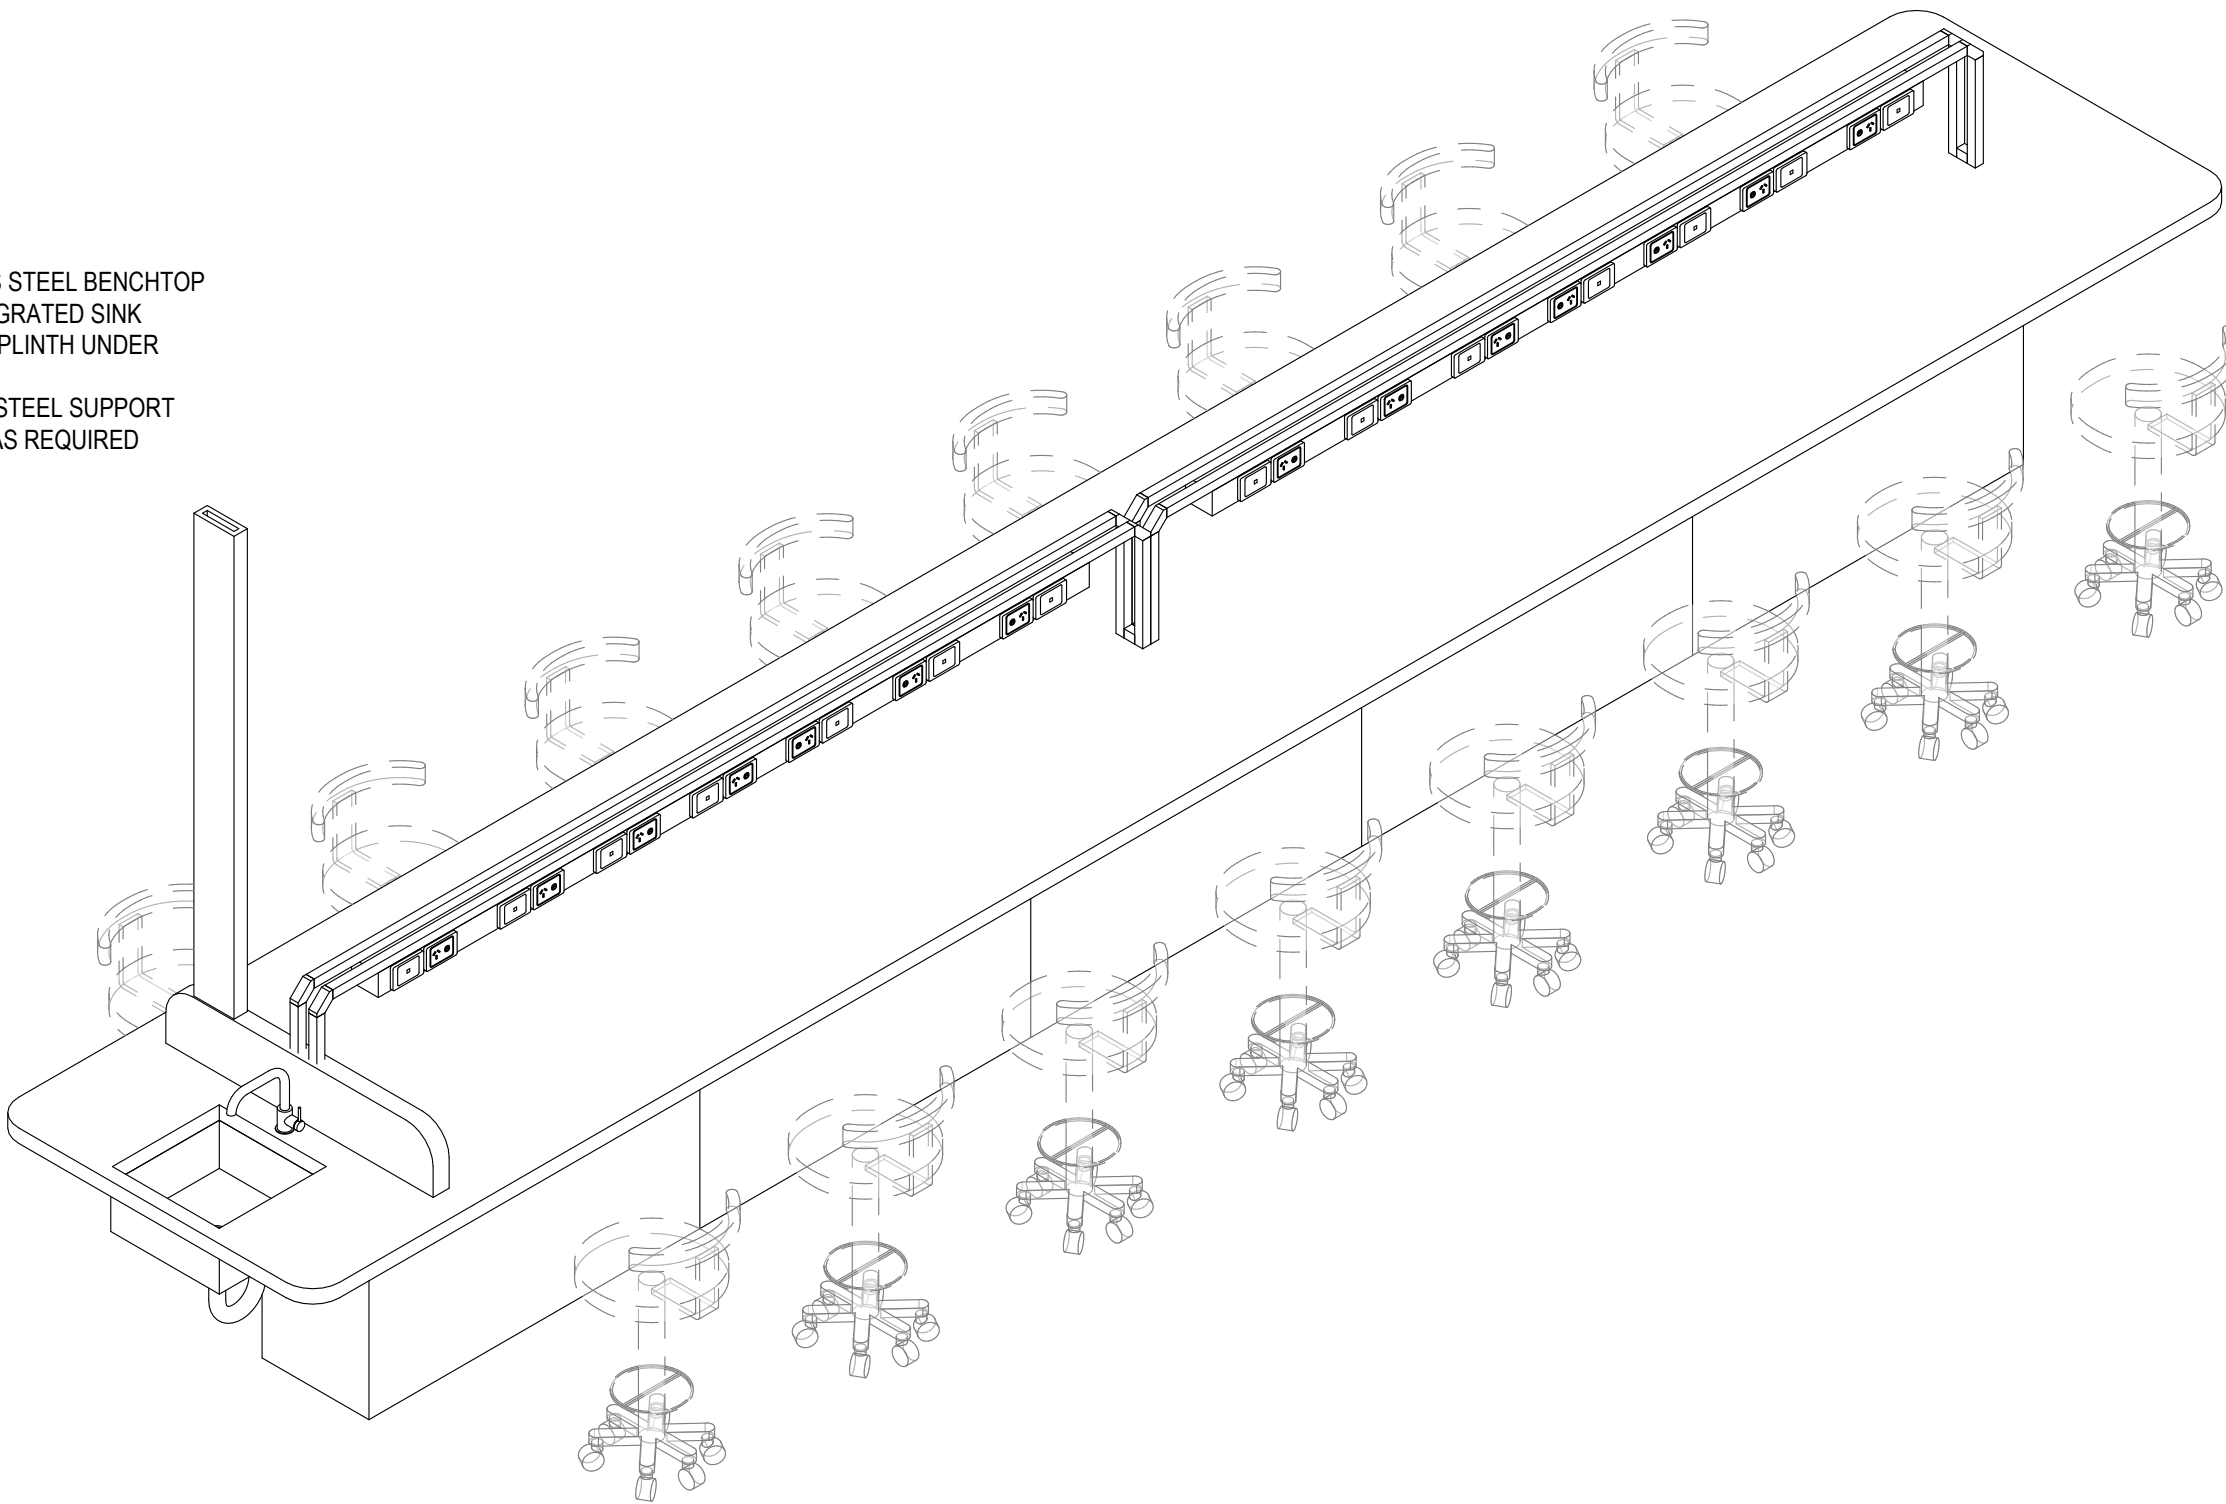

4 3D LAB 16P BENCH

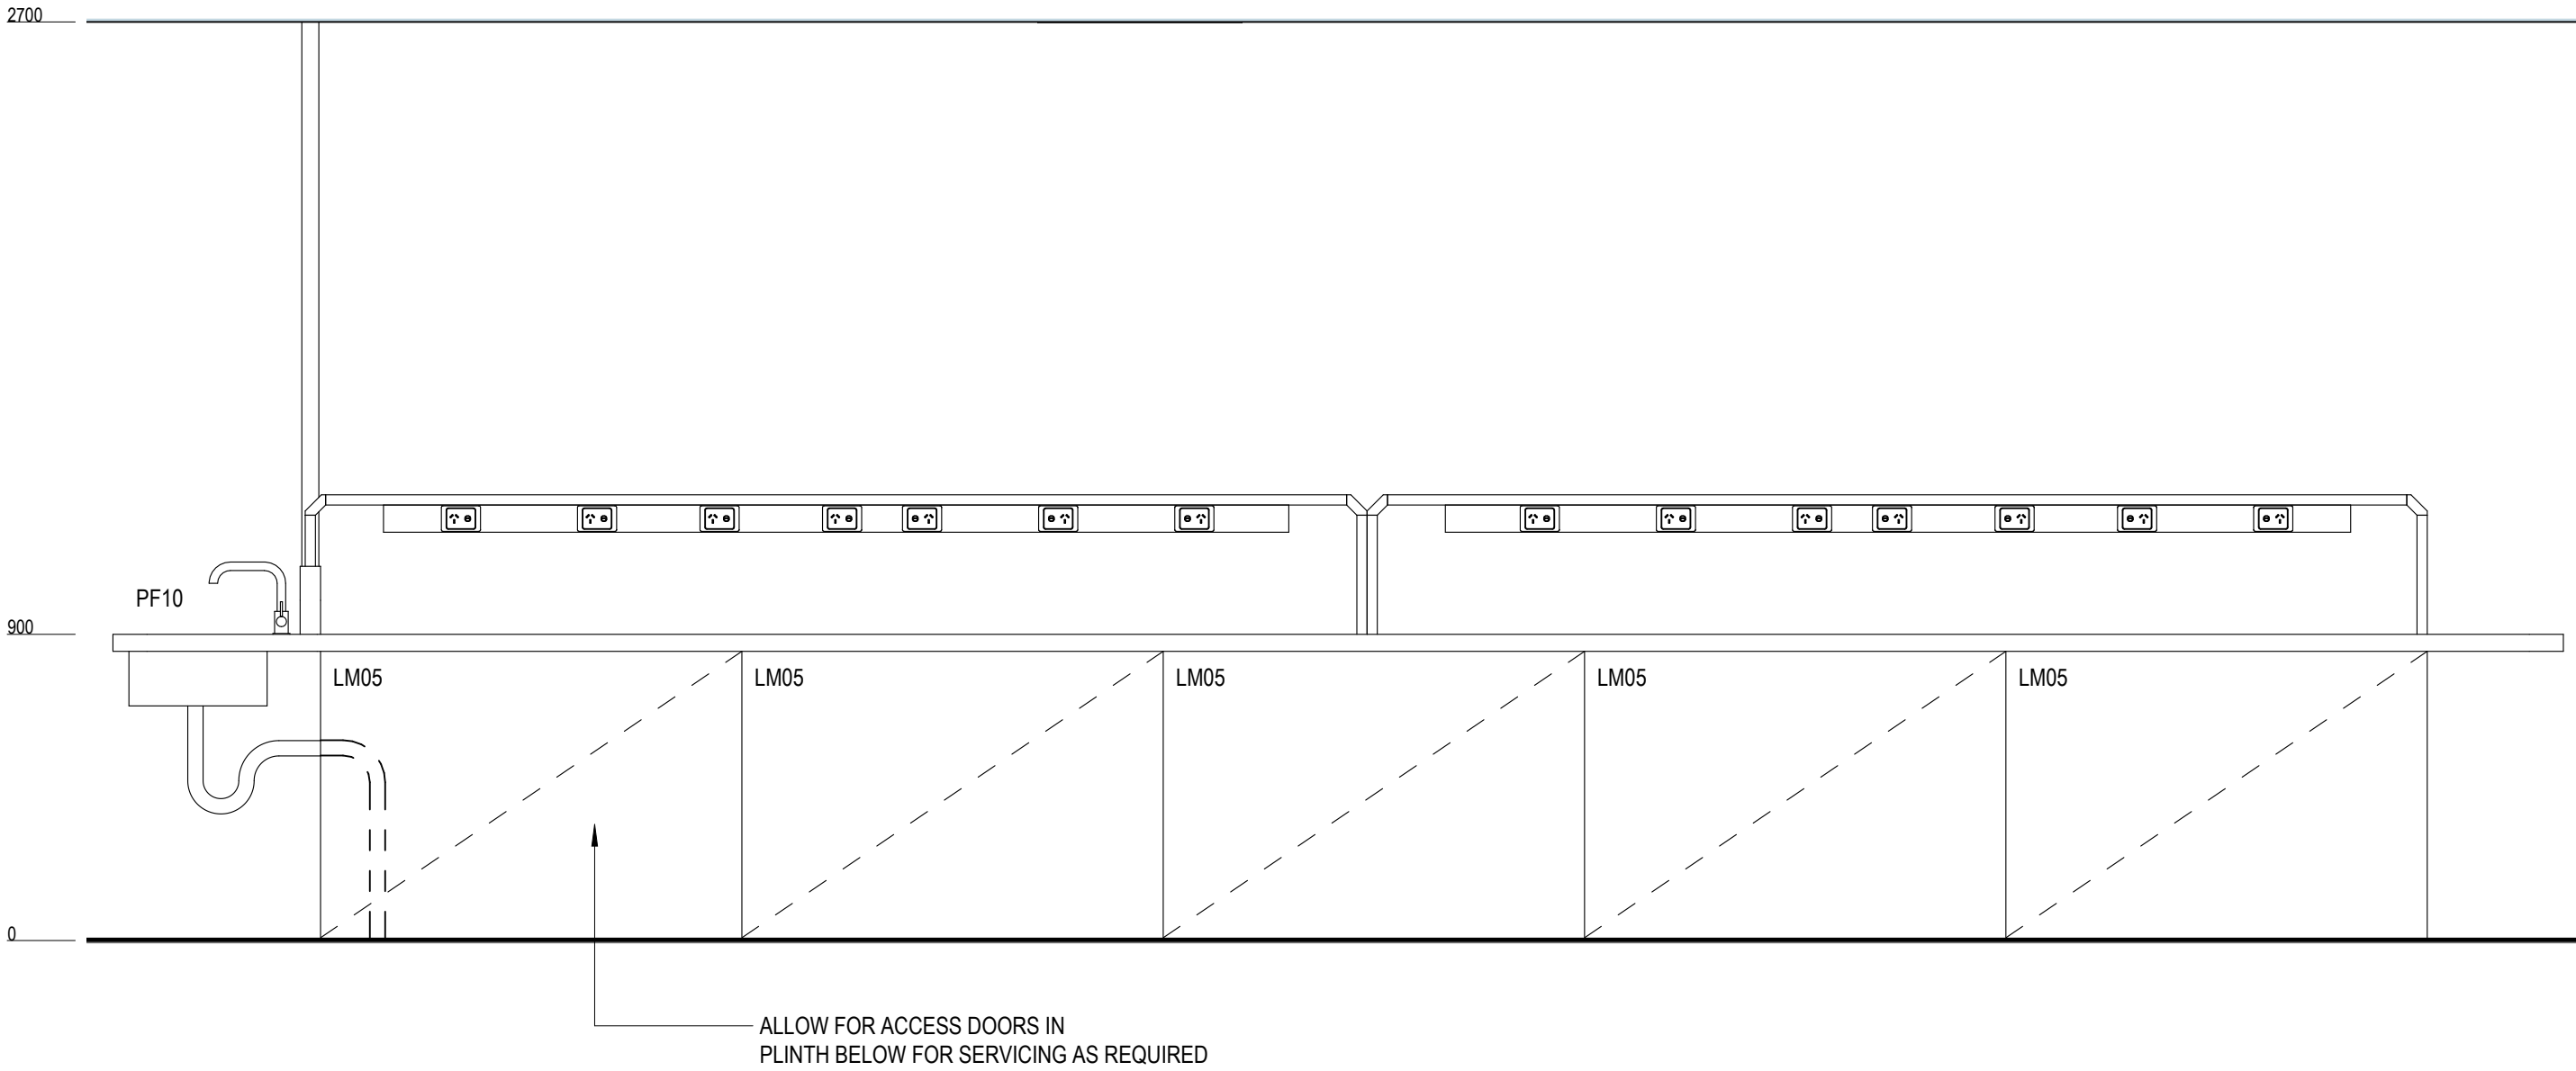

2 ELEVATION - 16P BENCH
1 : 20

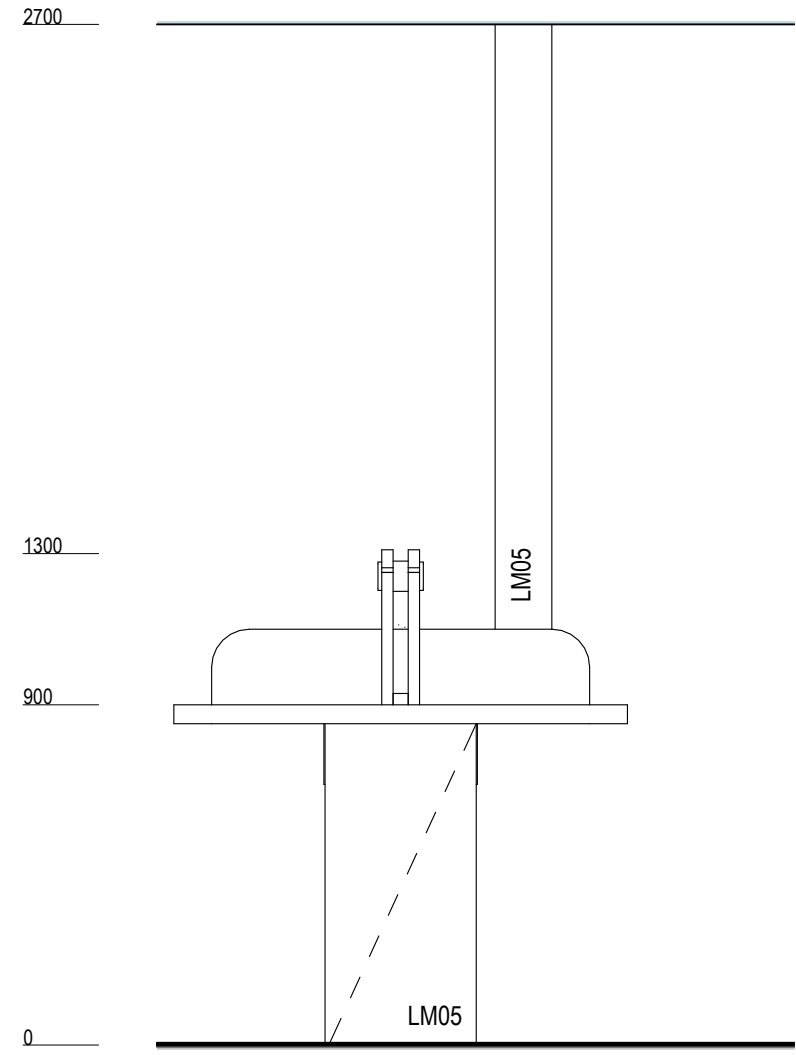

3 ELEVATION - 16P BENCH
1 : 20

AS CONSTRUCTED

thomson
adsett

Telephone +61 7 3840 9999
bne@thomsonadsett.com
Level 9, 470 St Pauls Terrace
Fortitude Valley
Qld 4006 Australia
thomsonadsett.com

© Copyright
These drawings and designs and the copyright thereof are the property of Thomson Adsett Pty Ltd and must not be used, retained or copied without written permission of Thomson Adsett Pty Ltd. ABN 76 105 314 654 Trading as ThomsonAdsett. Dimensions take precedence over scaling. Do not measure off drawings as print sizes may vary

BUILDING 33 REDEVELOPMENT

554/700 YAAMBA ROAD,
NORMAN GARDENS QLD 4701

for
CQUniversity
NORTH ROCKHAMPTON CAMPUS
& GIRVAN




GIRVAN

B	25/06/2024	AS CONSTRUCTED	PB
A	02/02/2024	IFC	PB
4	06/11/2023	REVISED ISSUE	AP
3	20/09/2023	ISSUE FOR INFORMATION	WL
2	11/09/2023	AMENDED 60% DD ISSUE	PB
1	28/08/2023	60% DD ISSUE	WL

rev	date	details	init
-----	------	---------	------

drawn	date
WL	JUL 2023
checked	date
NC	JUL 2023
verified	date
GK	DEC 2023

scale

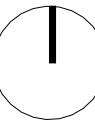

JOINERY DETAILS

scale	project no.
1 : 20 @ A1	23.0078.17

sheet no.
CQU-ROK-033-GN-ARC-70-10


revision
B

original sheet size - A1 (594mm x 841mm)


C:\REVIT\LOCAL\FILES\23.0078.17_CQU Building 33 Redevelopment_2023_Philip Bugden.nt

21/07/2024 4:53:25 PM


- NOTES
- STAINLESS STEEL
- TO BE 316 GRADE UNLESS NOTED OTHERWISE
 - BENCHTOP TO BE 1.2mm THICK
 - FRAMING AND LEGS TO BE 32mm RHS
- SUBSTRATE TO SS BENCH
- 18mm MARINE GRADE PLY
 - UNDERSIDE TO BE SEALED WITH -

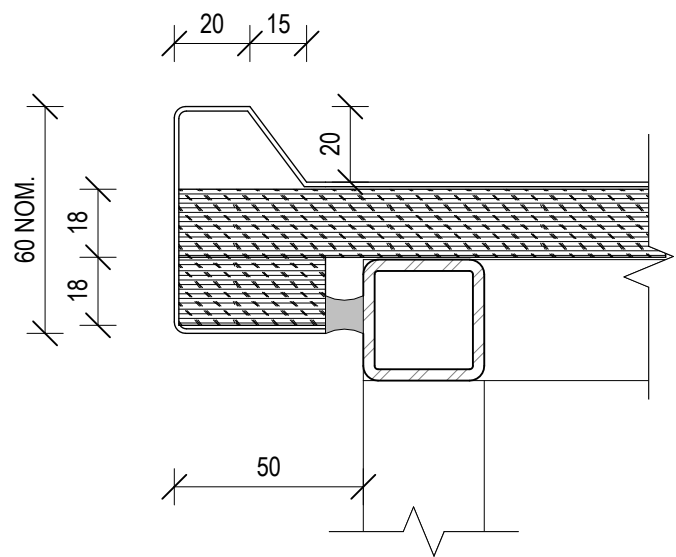


1 SS BENCHTOP NOSING - WET EDGE
1 : 2 DETAIL - SECTION

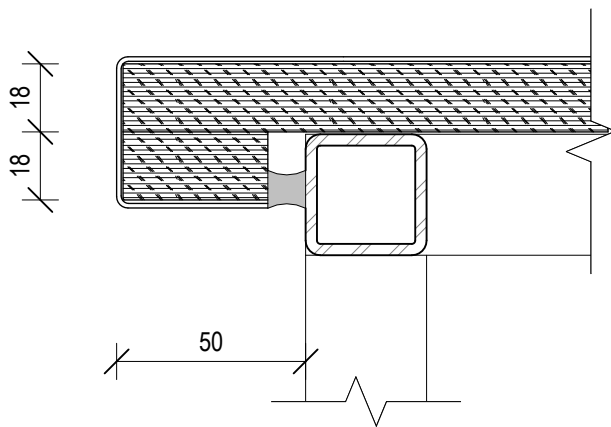


2 SS BENCHTOP NOSING - DRY EDGE
1 : 2 DETAIL - SECTION

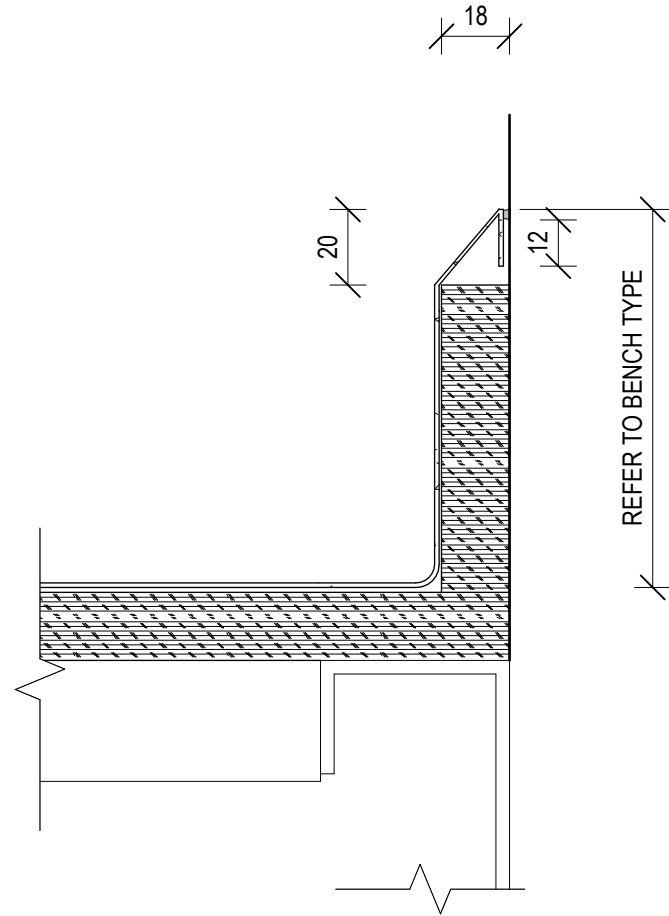


4 SS BENCHTOP - UPTURN SPLASHBACK
1 : 2 DETAIL - SECTION

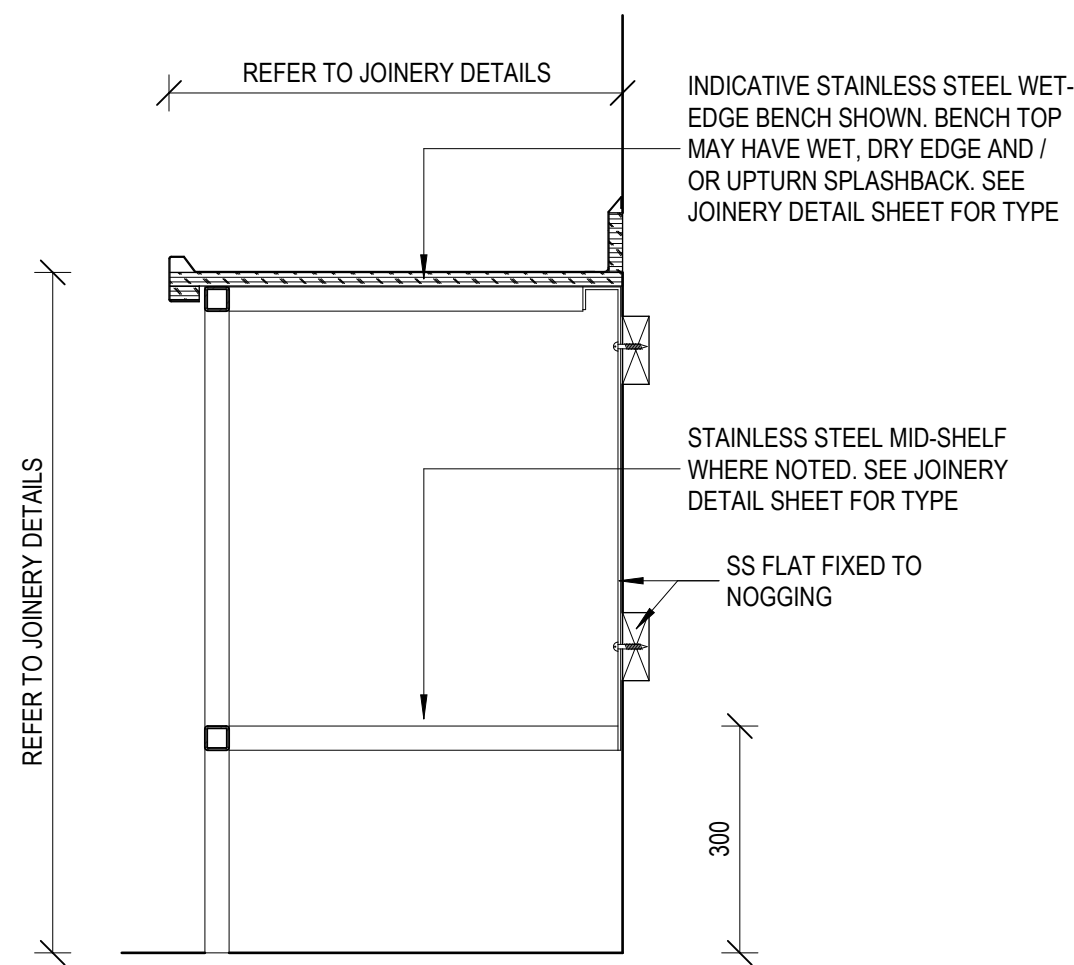


5 SS BENCH LEGS WITH WALL FIXINGS
1 : 10 DETAIL - SECTION

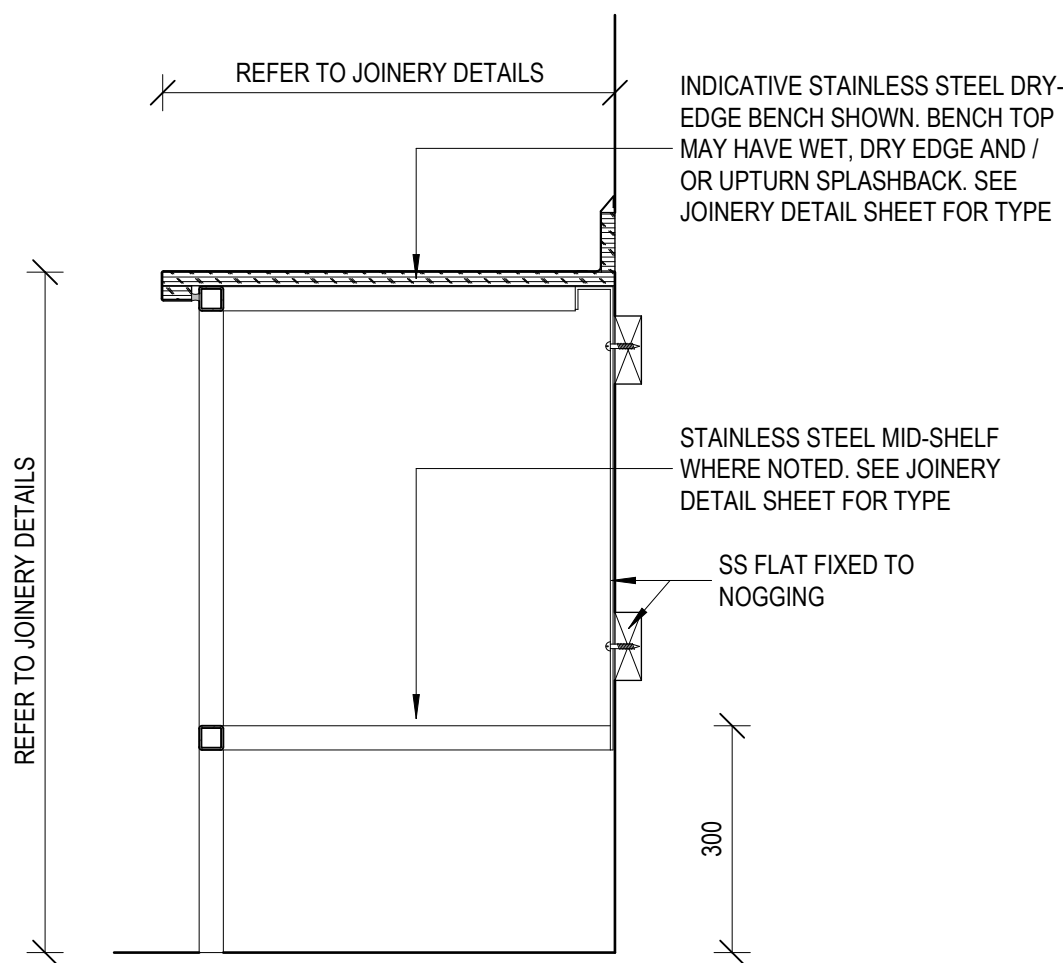


5a SS BENCH (DRY EDGE) LEGS WITH WALL FIXINGS
1 : 10

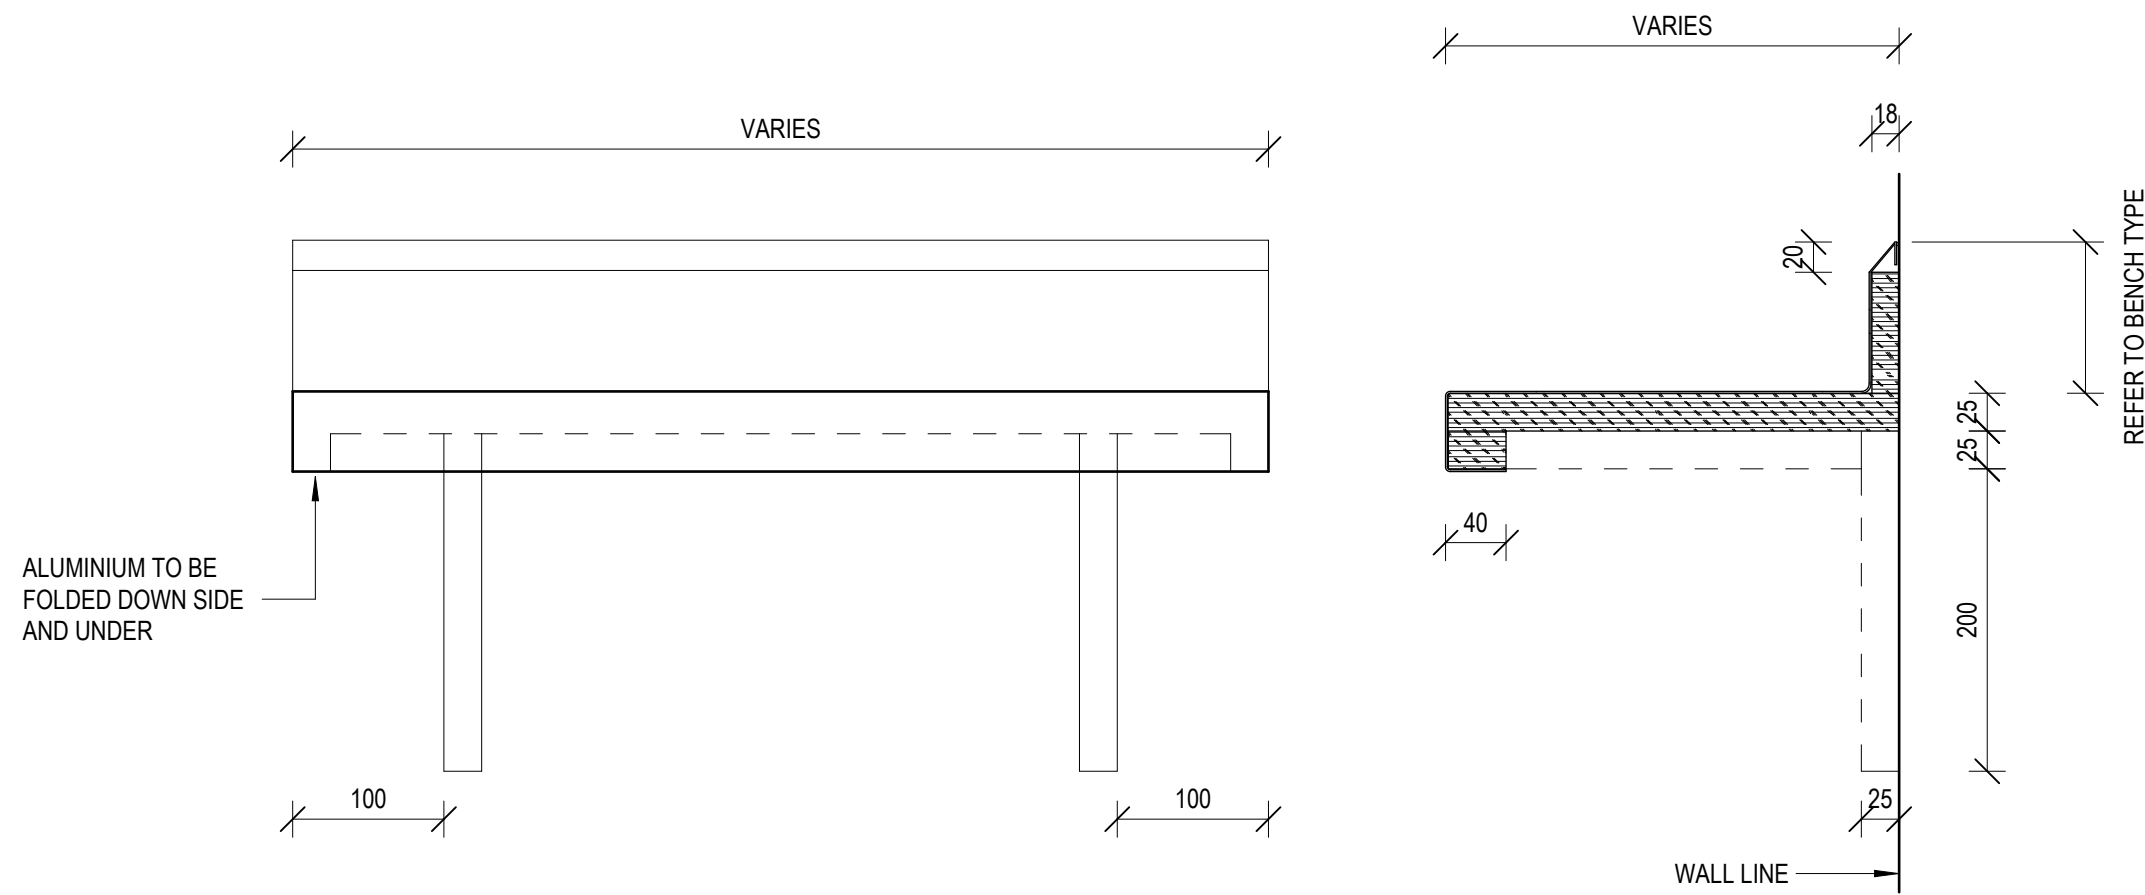


6 SS SHELF - FIXED WITH UPTURN
1 : 5

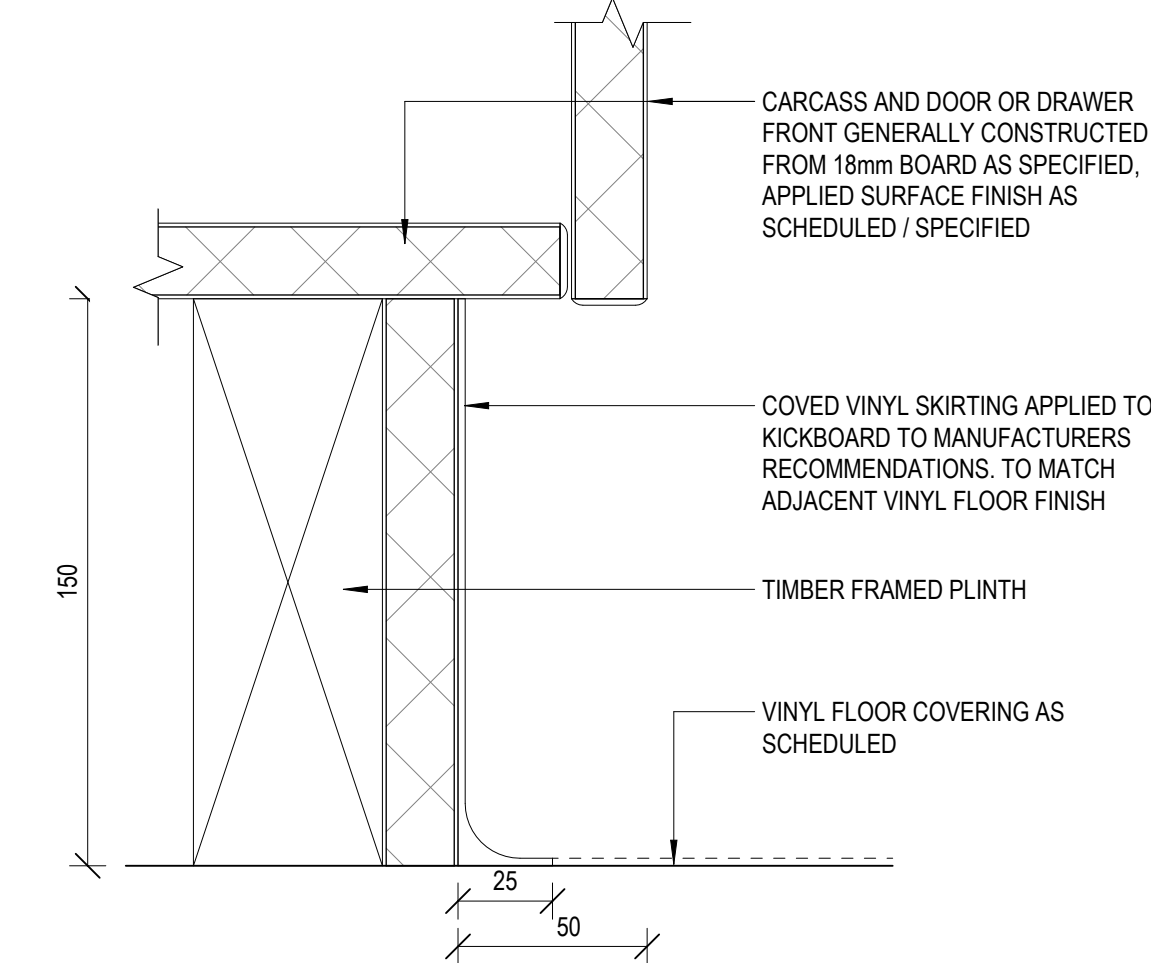


7 Kick with covered vinyl skirting detail
1 : 2 DETAIL - SECTION

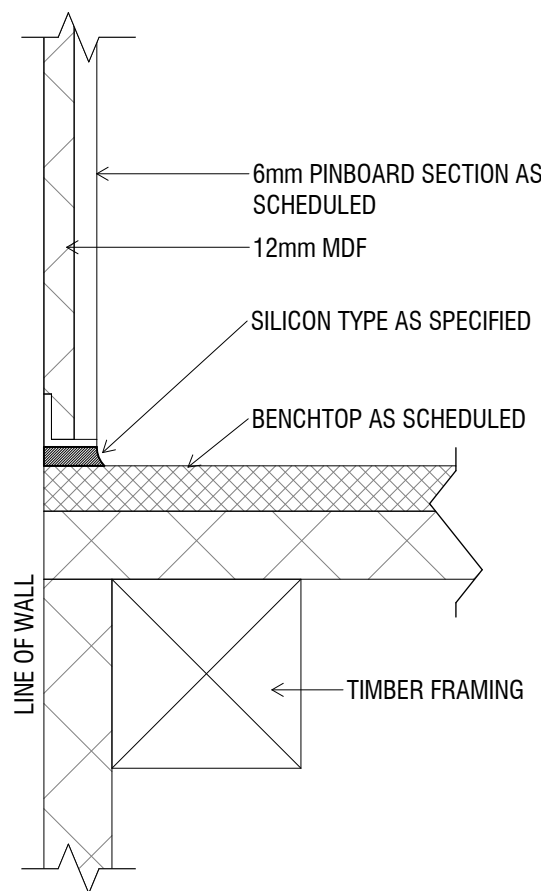


8 PINBOARD DETAIL
1 : 2 DETAIL - SECTION

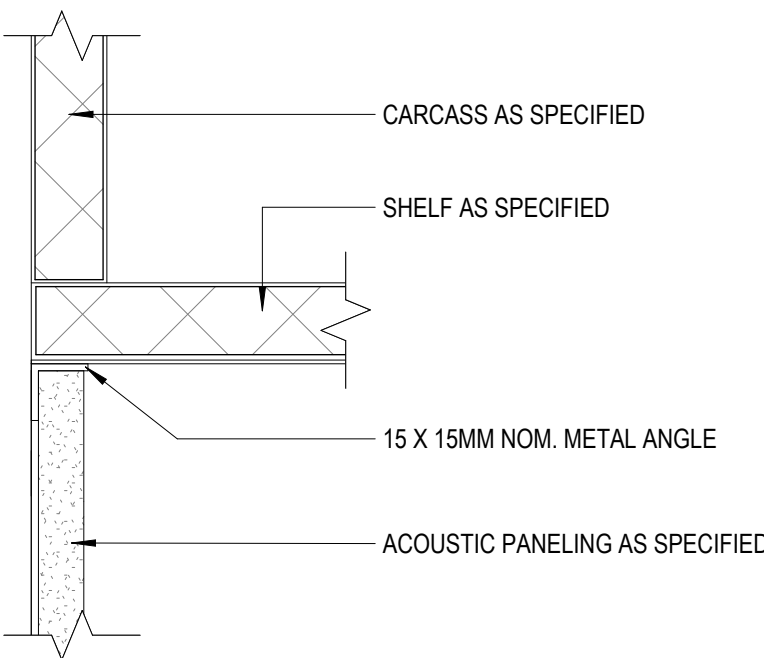

9 OVERHEADS TO ACOUSTIC PANELLING
1 : 2 DETAIL - SECTION

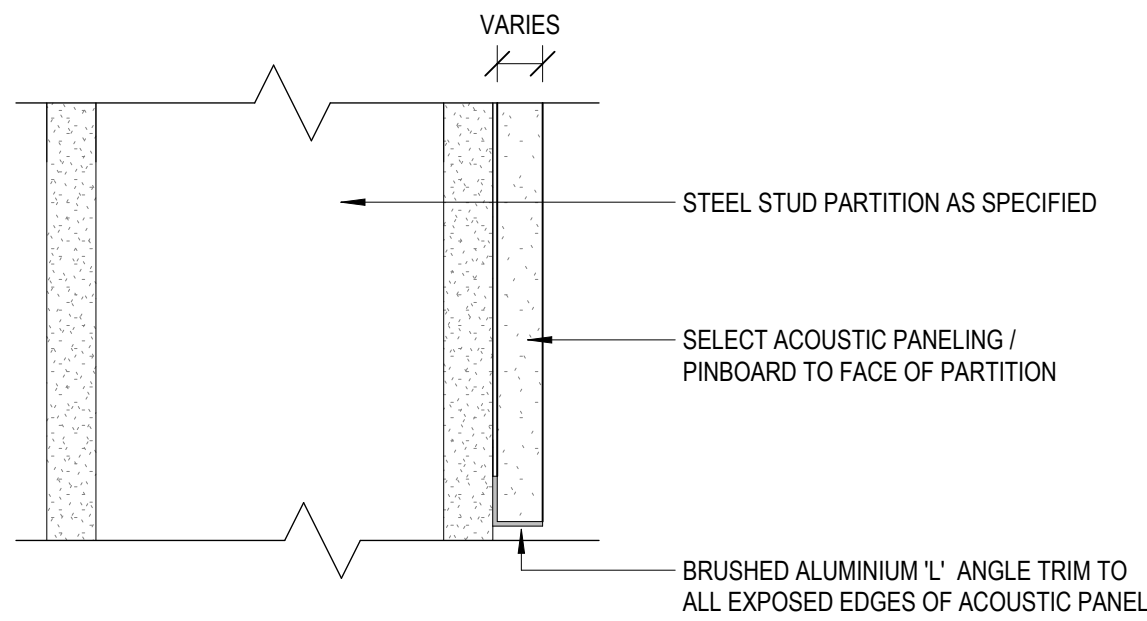

10 ACOUSTIC PANELLING EDGE DETAIL
1 : 2 DETAIL - PLAN

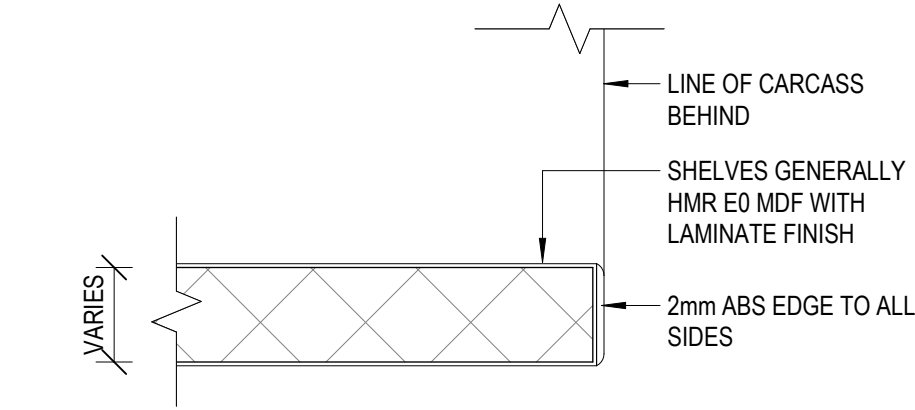

11 OPEN SHELF DETAIL
1 : 2

AS CONSTRUCTED

thomson
adsett

Telephone +61 7 3840 9999
bne@thomsonadsett.com
Level 9, 470 St Pauls Terrace
Fortitude Valley
Qld 4006 Australia
thomsonadsett.com

© Copyright
These drawings and designs and the copyright thereof are the property of Thomson Adsett Pty Ltd and must not be used, retained or copied without written permission of Thomson Adsett Pty Ltd. ABN 76 105 314 654 Trading as ThomsonAdsett. Dimensions take precedence over scaling. Do not measure off drawings as print sizes may vary

BUILDING 33 REDEVELOPMENT

554/700 YAAMBA ROAD,
NORMAN GARDENS QLD 4701

for
CQUniversity
NORTH ROCKHAMPTON CAMPUS
& GIRVAN



GIRVAN

B	25/06/2024	AS CONSTRUCTED	PB
A	02/02/2024	IFC	PB
3	20/09/2023	ISSUE FOR INFORMATION	WL
2	11/09/2023	AMENDED 60% DD ISSUE	PB
1	28/08/2023	60% DD ISSUE	WL

rev/ date details init

drawn	date
WL	JUL 2023
checked	date
NC	JUL 2023
verified	date
GK	DEC 2023

scale



TYPICAL JOINERY DETAILS

scale project no.
As indicated @ A1 23.0078.17


sheet no.
CQU-ROK-033-GN-ARC-72-00

revision
B


original sheet size - A1 (594mm x 841mm)

C:\REVIT\LOCAL\FILES\23.0078.17_CQU Building 33 Redevelopment_2023_Philip Bugden.nt


20/7/2024 4:53:26 PM

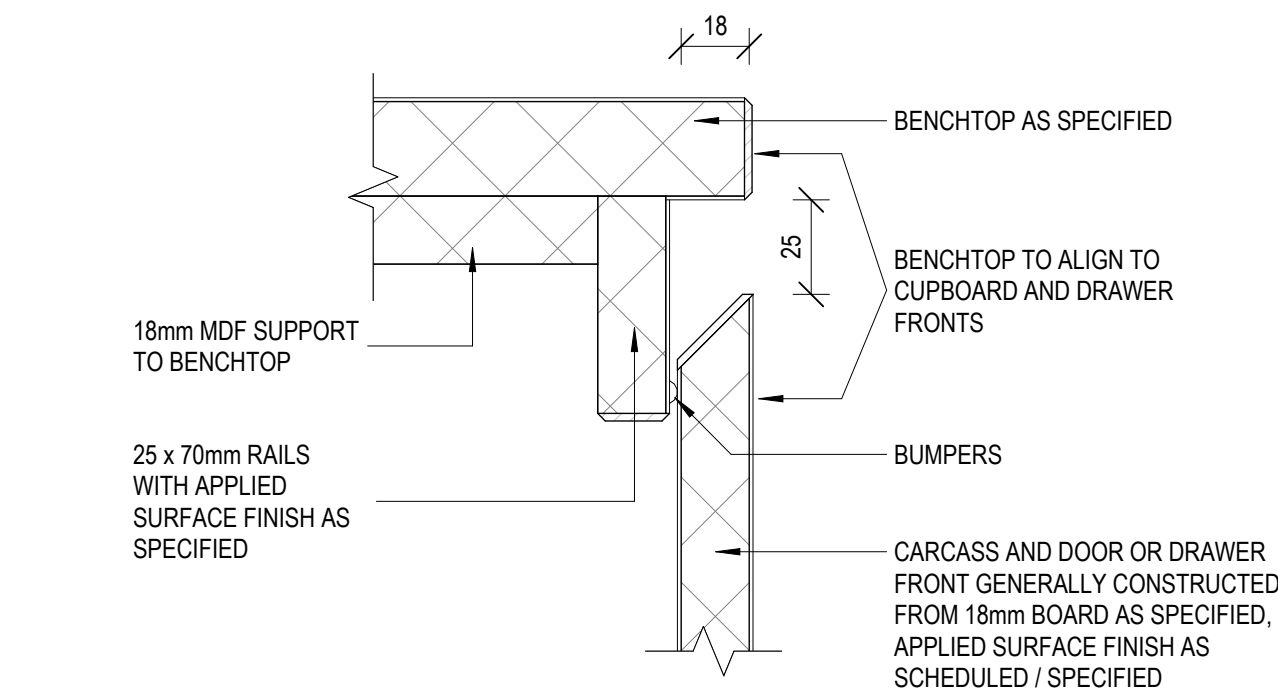


1 TYPICAL FINGER PULL DETAIL - LAMINATE
1 : 2 DETAIL - SECTION

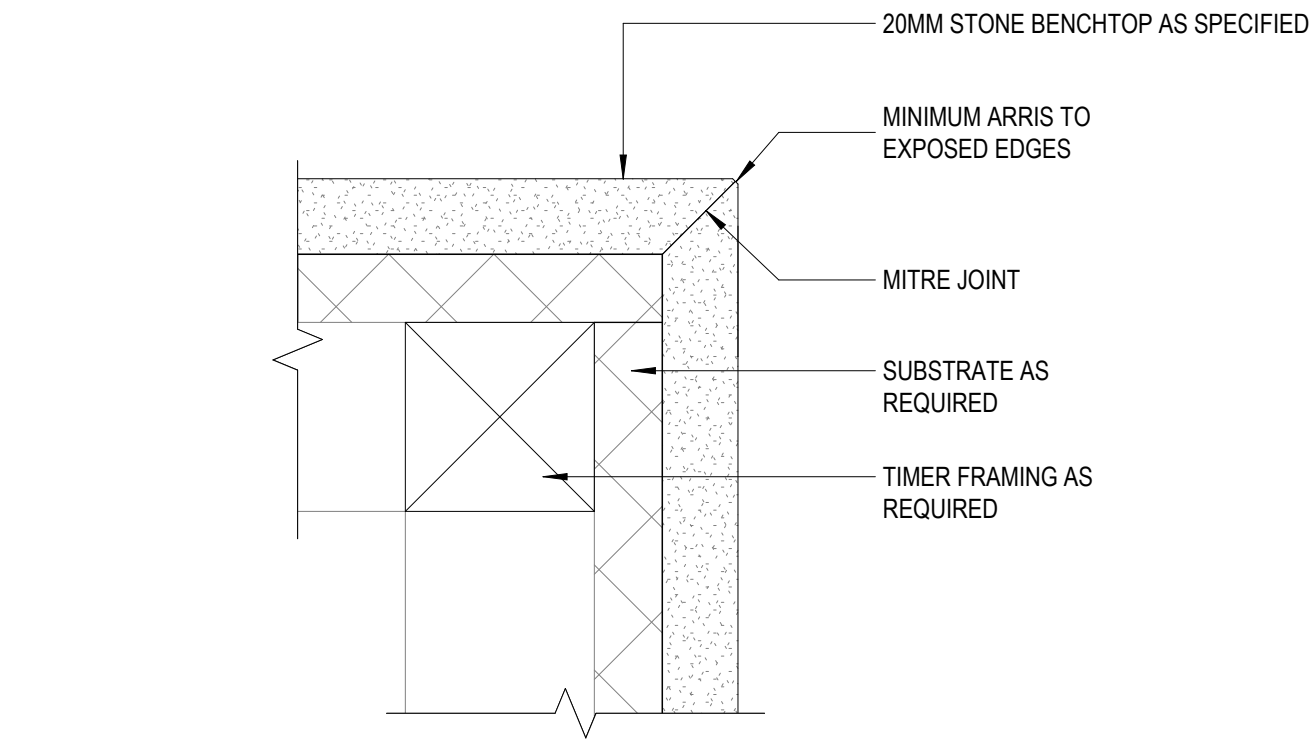


2 TYPICAL BENCHTOP DETAIL - STONE
1 : 2 DETAIL - SECTION

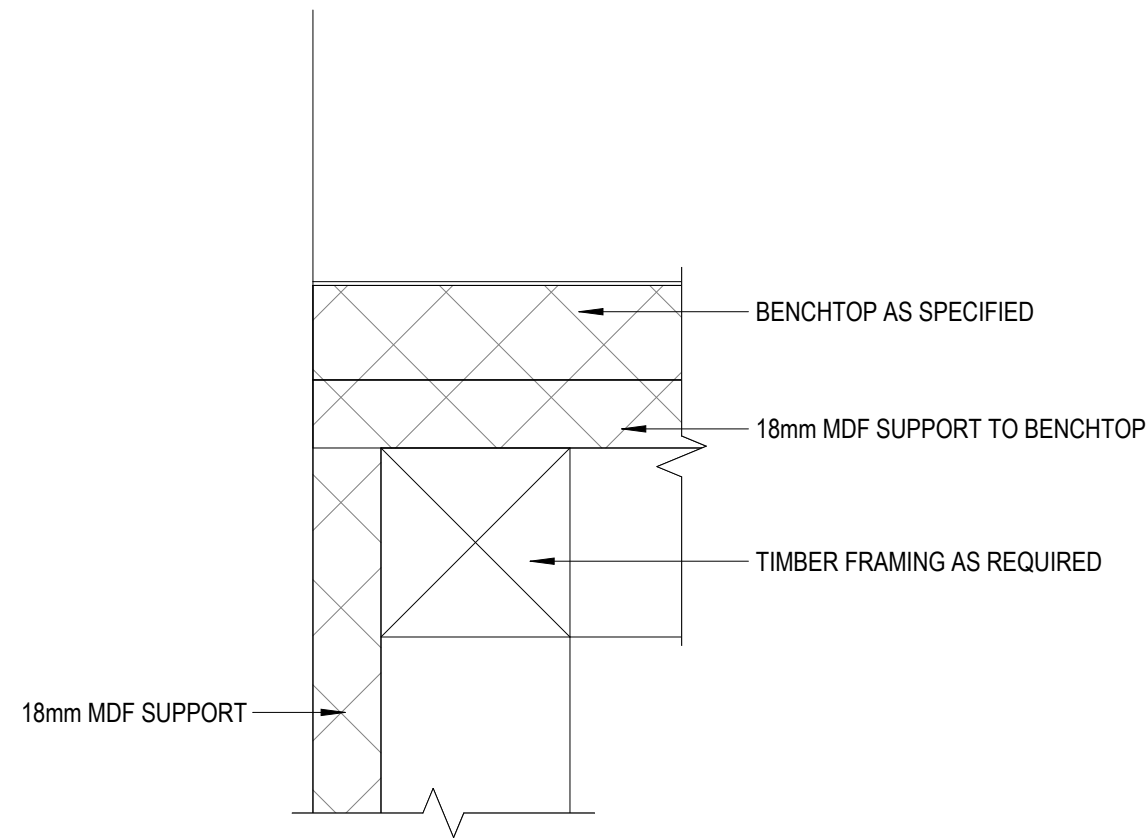


3 BENCH JUNCTION
1 : 2 DETAIL - SECTION

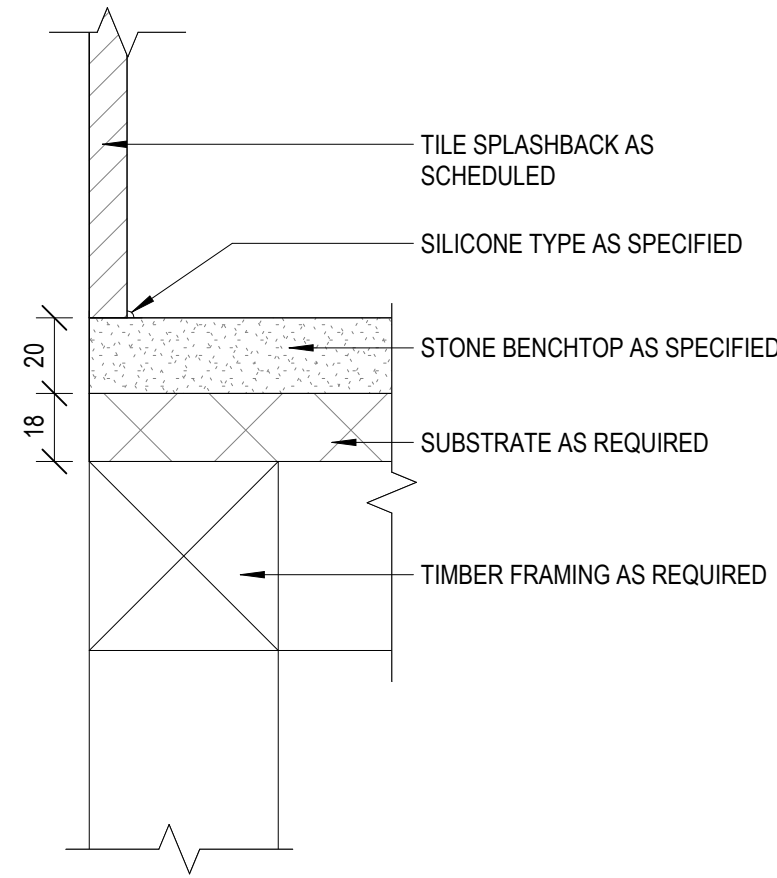


4 SPLASHBACK TO BENCHTOP DETAIL
1 : 2 DETAIL - SECTION

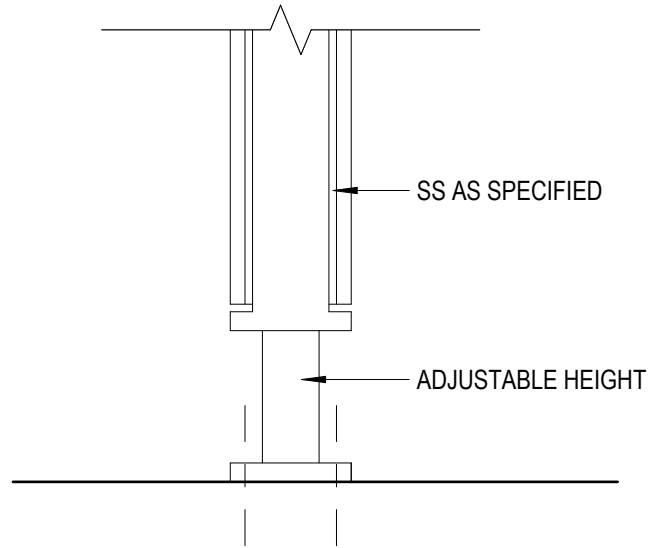

5 SS BENCH LEGS (ADJ. HEIGHT)
1 : 2 DETAIL - SECTION

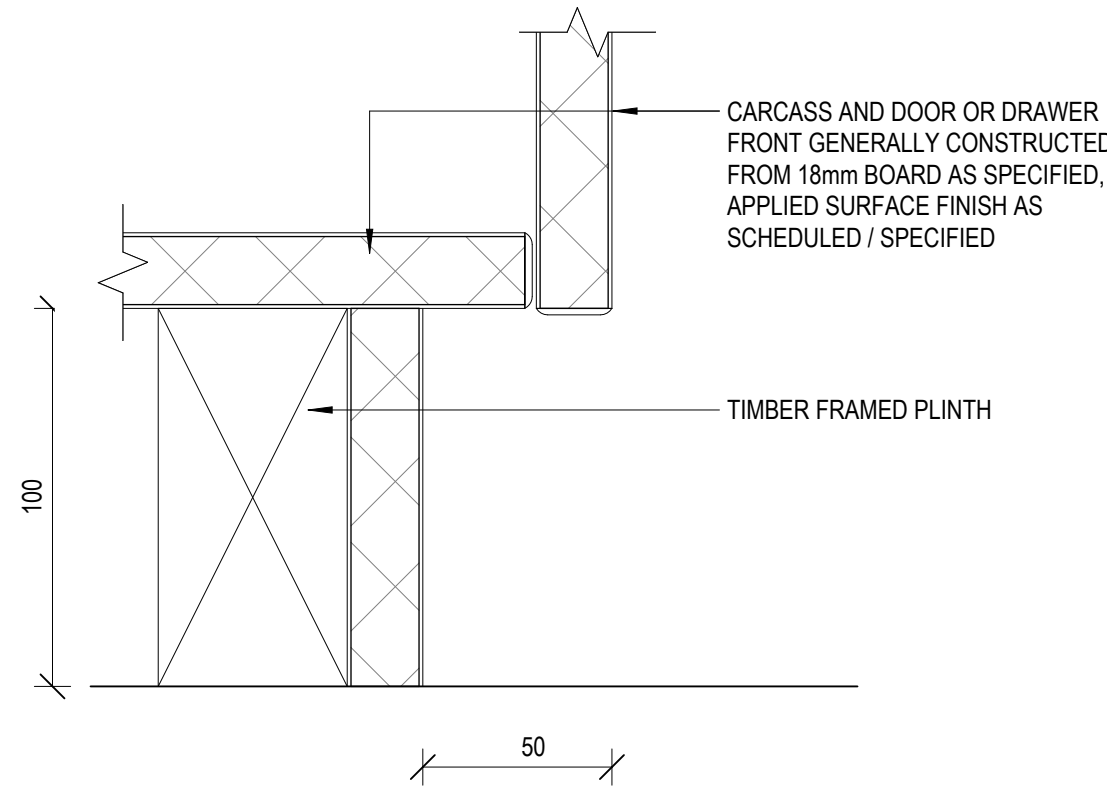

6 TYPICAL KICK DETAIL
1 : 2 DETAIL - SECTION

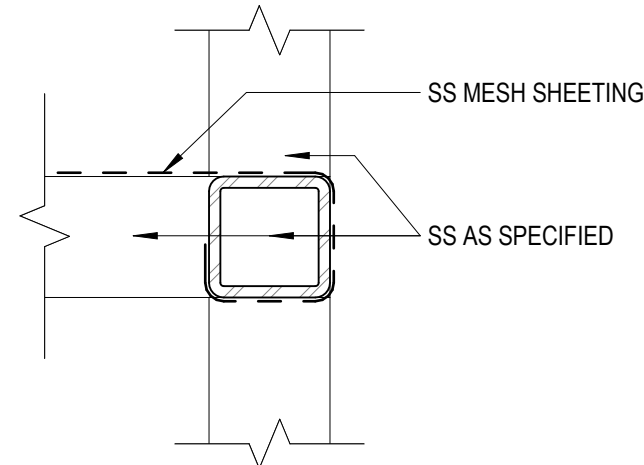

7 SS MESH SHELVING DETAIL
1 : 2 DETAIL - SECTION

thomson
adsett

Telephone +61 7 3840 9999
bne@thomsonadsett.com
Level 9, 470 St Pauls Terrace
Fortitude Valley
Qld 4006 Australia
thomsonadsett.com

© Copyright
These drawings and designs and the copyright thereof are the property of Thomson Adsett Pty Ltd and must not be used, retained or copied without written permission of Thomson Adsett Pty Ltd. ABN 76 105 314 654 Trading as ThomsonAdsett. Dimensions take precedence over scaling. Do not measure off drawings as print sizes may vary

BUILDING 33 REDEVELOPMENT

554/700 YAAMBA ROAD,
NORMAN GARDENS QLD 4701

for
CQUniversity
NORTH ROCKHAMPTON CAMPUS
& GIRVAN




GIRVAN

B	25/06/2024	AS CONSTRUCTED	PB
A	02/02/2024	IFC	PB
rev\	date	details	init.

drawn	date
TA	DEC 2023
checked	date
PB	DEC 2023
verified	date
GK	DEC 2023

scale

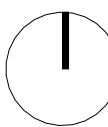

TYPICAL JOINERY DETAILS

scale
1 : 2 @ A1

project no.
23.0078.17

sheet no.
CQU-ROK-033-GN-ARC-72-01

revision
B

original sheet size - A1 (594mm x 841mm)

AS CONSTRUCTED

C:\REVIT\LOCAL\FILES\23\0078.17_CQU Building 33 Redevelopment_2023_Philip Bugden.nt

FIRE PROTECTION SERVICES

FIRE HAZARD CLASSIFICATION


FIRE HYDRANT : COVERAGE ONLY TO AS2419.1-2005 VIA 30M HOSE FROM INTERNAL HYDRANTS,
LOCATIONS AND EXISTING HYDRANT SYSTEM TO ORIGINAL BUILDING
LEGISLATION.

FIRE HOSE REEL : COVERAGE ONLY TO AS2441-2005


EMERGENCY WARNING & : EXISTING TO REMAIN
INTERCOM SYSTEM

LEGEND	
 (TYPE)	PORTABLE FIRE EXTINGUISHER
	EXISTING FIRE HOSE REEL
	EXISTING FIRE HYDRANT
	EXISTING WALL MOUNTED FIRE BELL
	EXISTING FIRE INDICATOR PANEL
	EXISTING MANUAL CALL POINT


PIPING LEGENDS	
 FH	HYDRANT HOSE REEL
 FHR	FIRE HOSE REEL
	HYDRANT PIPEWORK

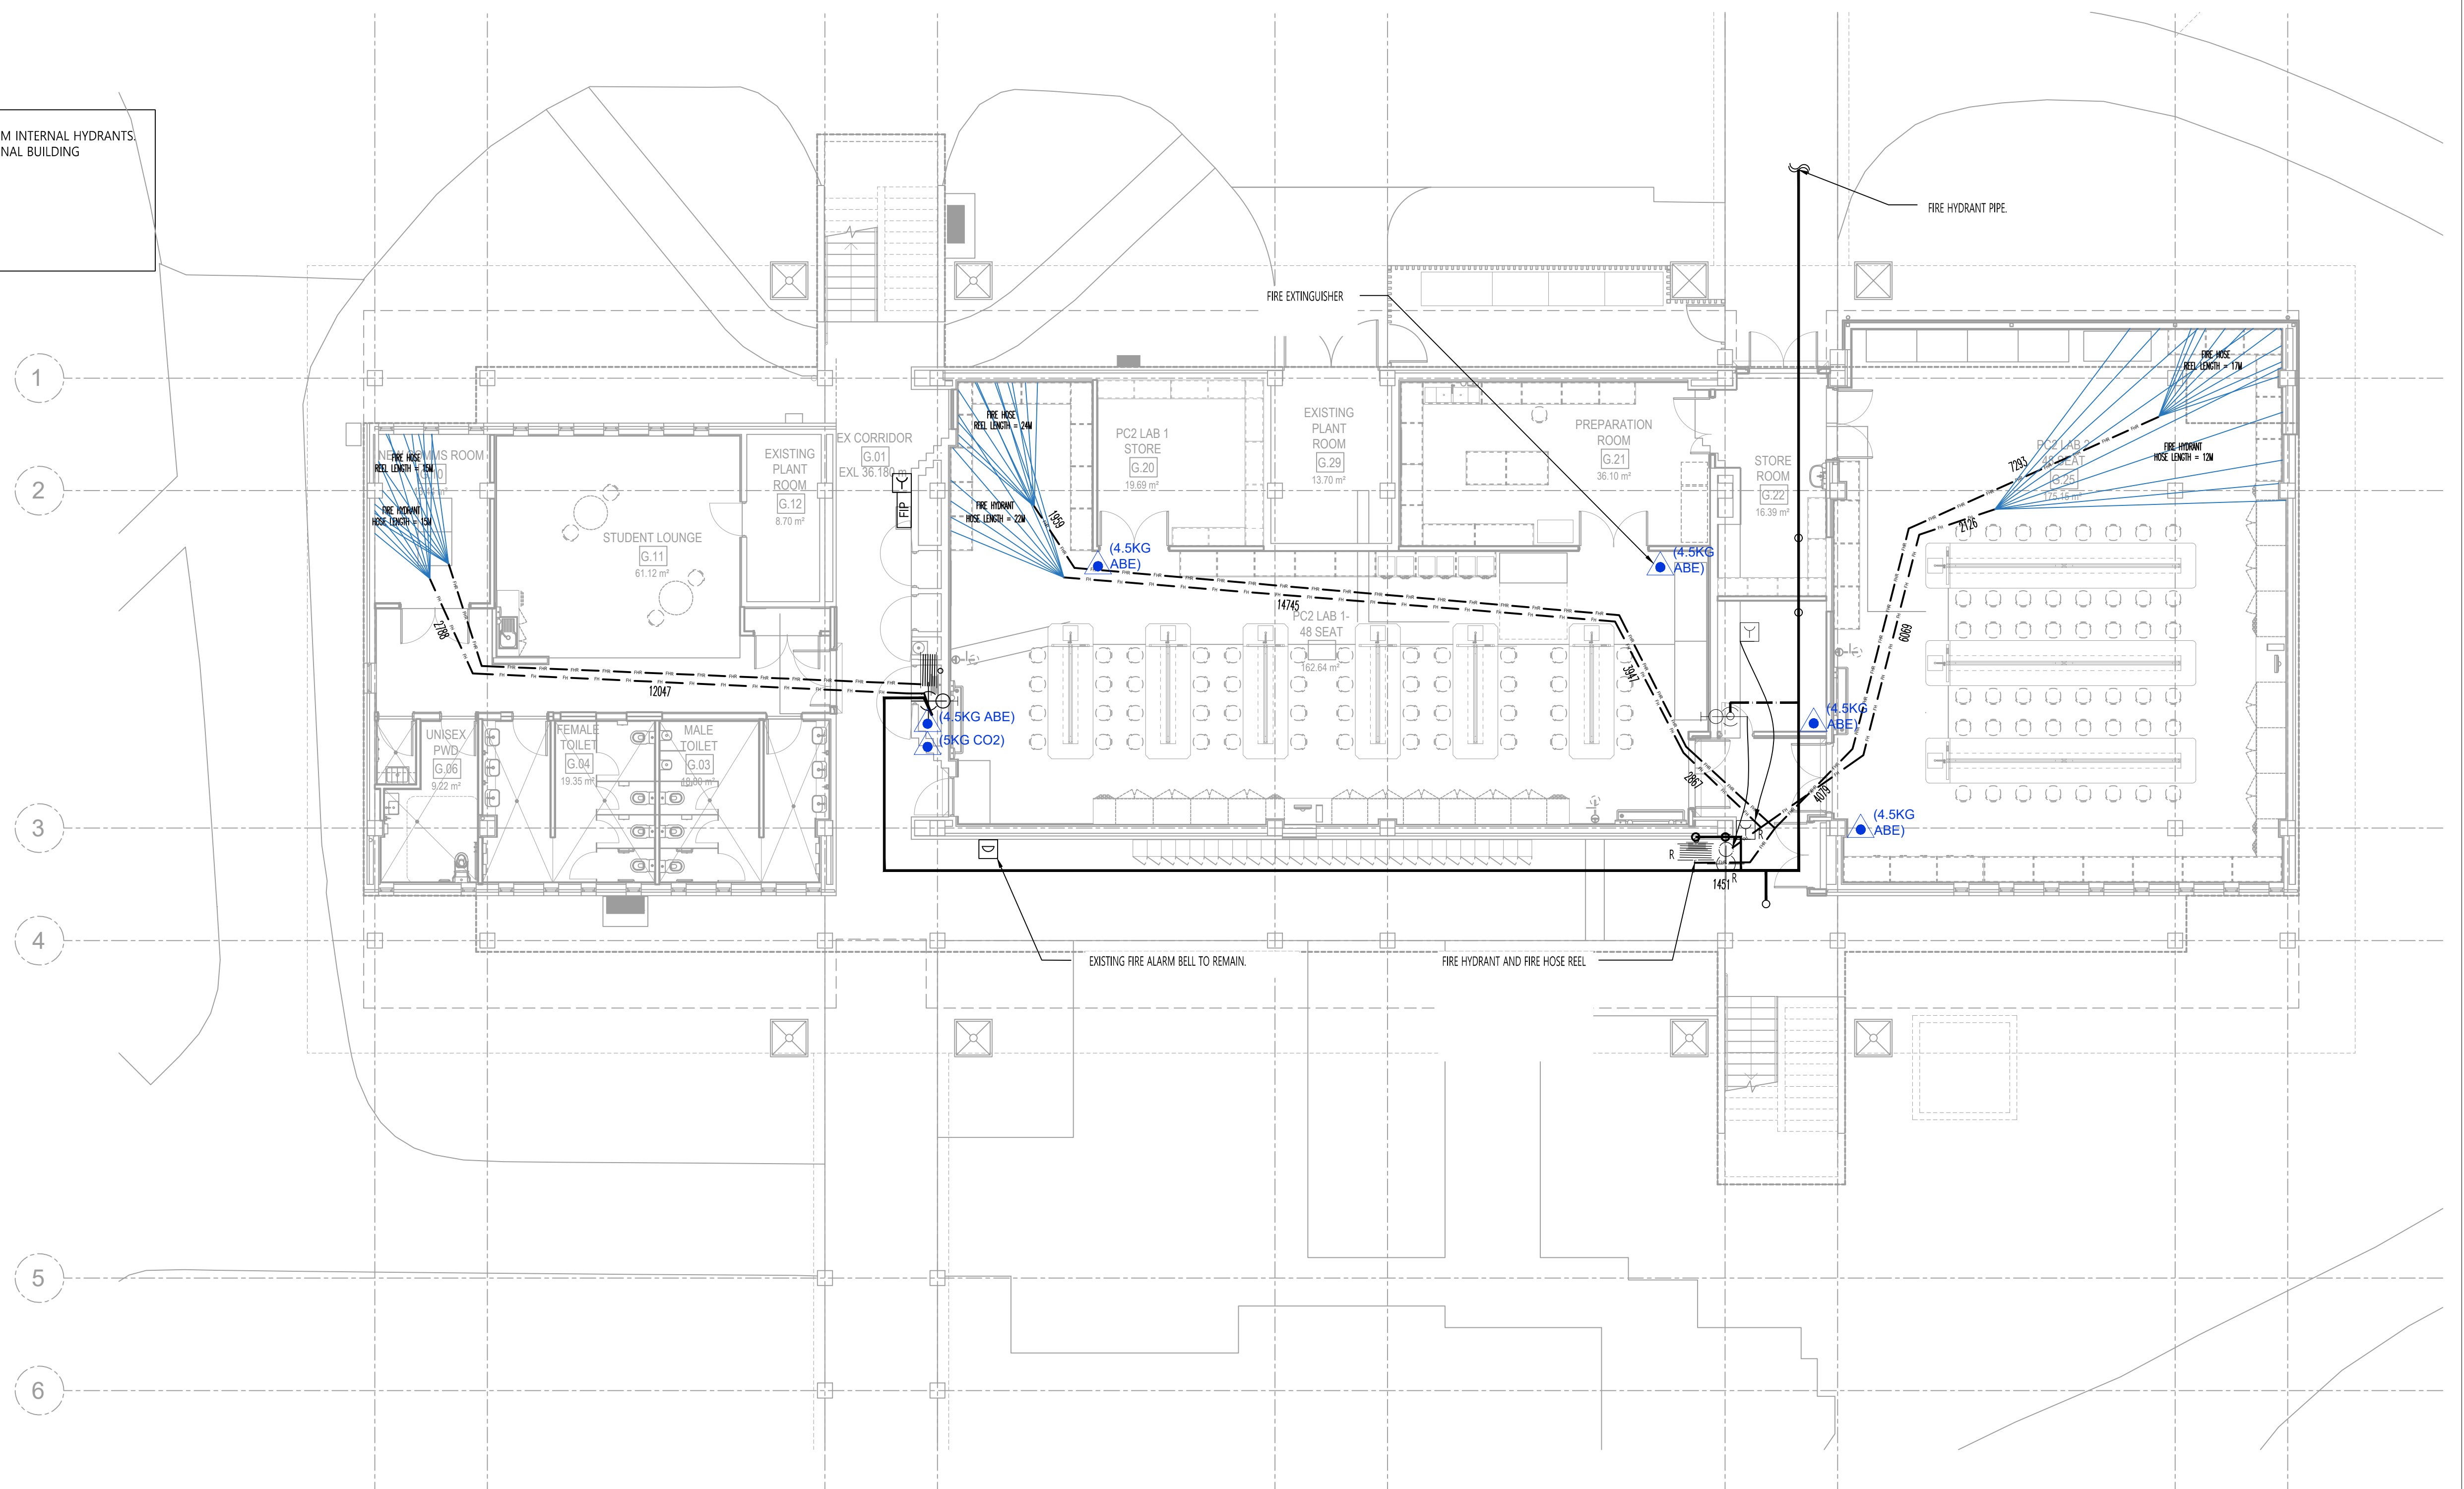

							ARCHIBUS FUNC. LOCATION	DRAWN	SA			CQUniversity CAMPUS: ROCKHAMPTON NORTH BUILDING: BUILDING 33 VENDOR: GIRVAN GROUP	BUILDING 33 PC2 LABORATORY CENTRAL QUEENSLAND UNIVERSITY 554/700 YAMMBA RD, NORMANGARDENS QLD 4701 CQU DWG. No. CQU-ROK-GN-FIRE-01	Sheet Size	A1	
							RPEQ ENGINEER	ENGINEER	SM					Scale	1:100	
02	AS CONSTRUCTED	SA	SM	SM	02.08.2024		RPEQ NUMBER	DATE	APPROVED	SM					Revision:	02
01	AS CONSTRUCTED	SA	SM	SM	11.07.2024		-	-								
REV	DESCRIPTION	DRN	ENG	APP	DATE	REFERENCE DRAWINGS	RPEQ APPROVAL			SIGNATURE				DATE		

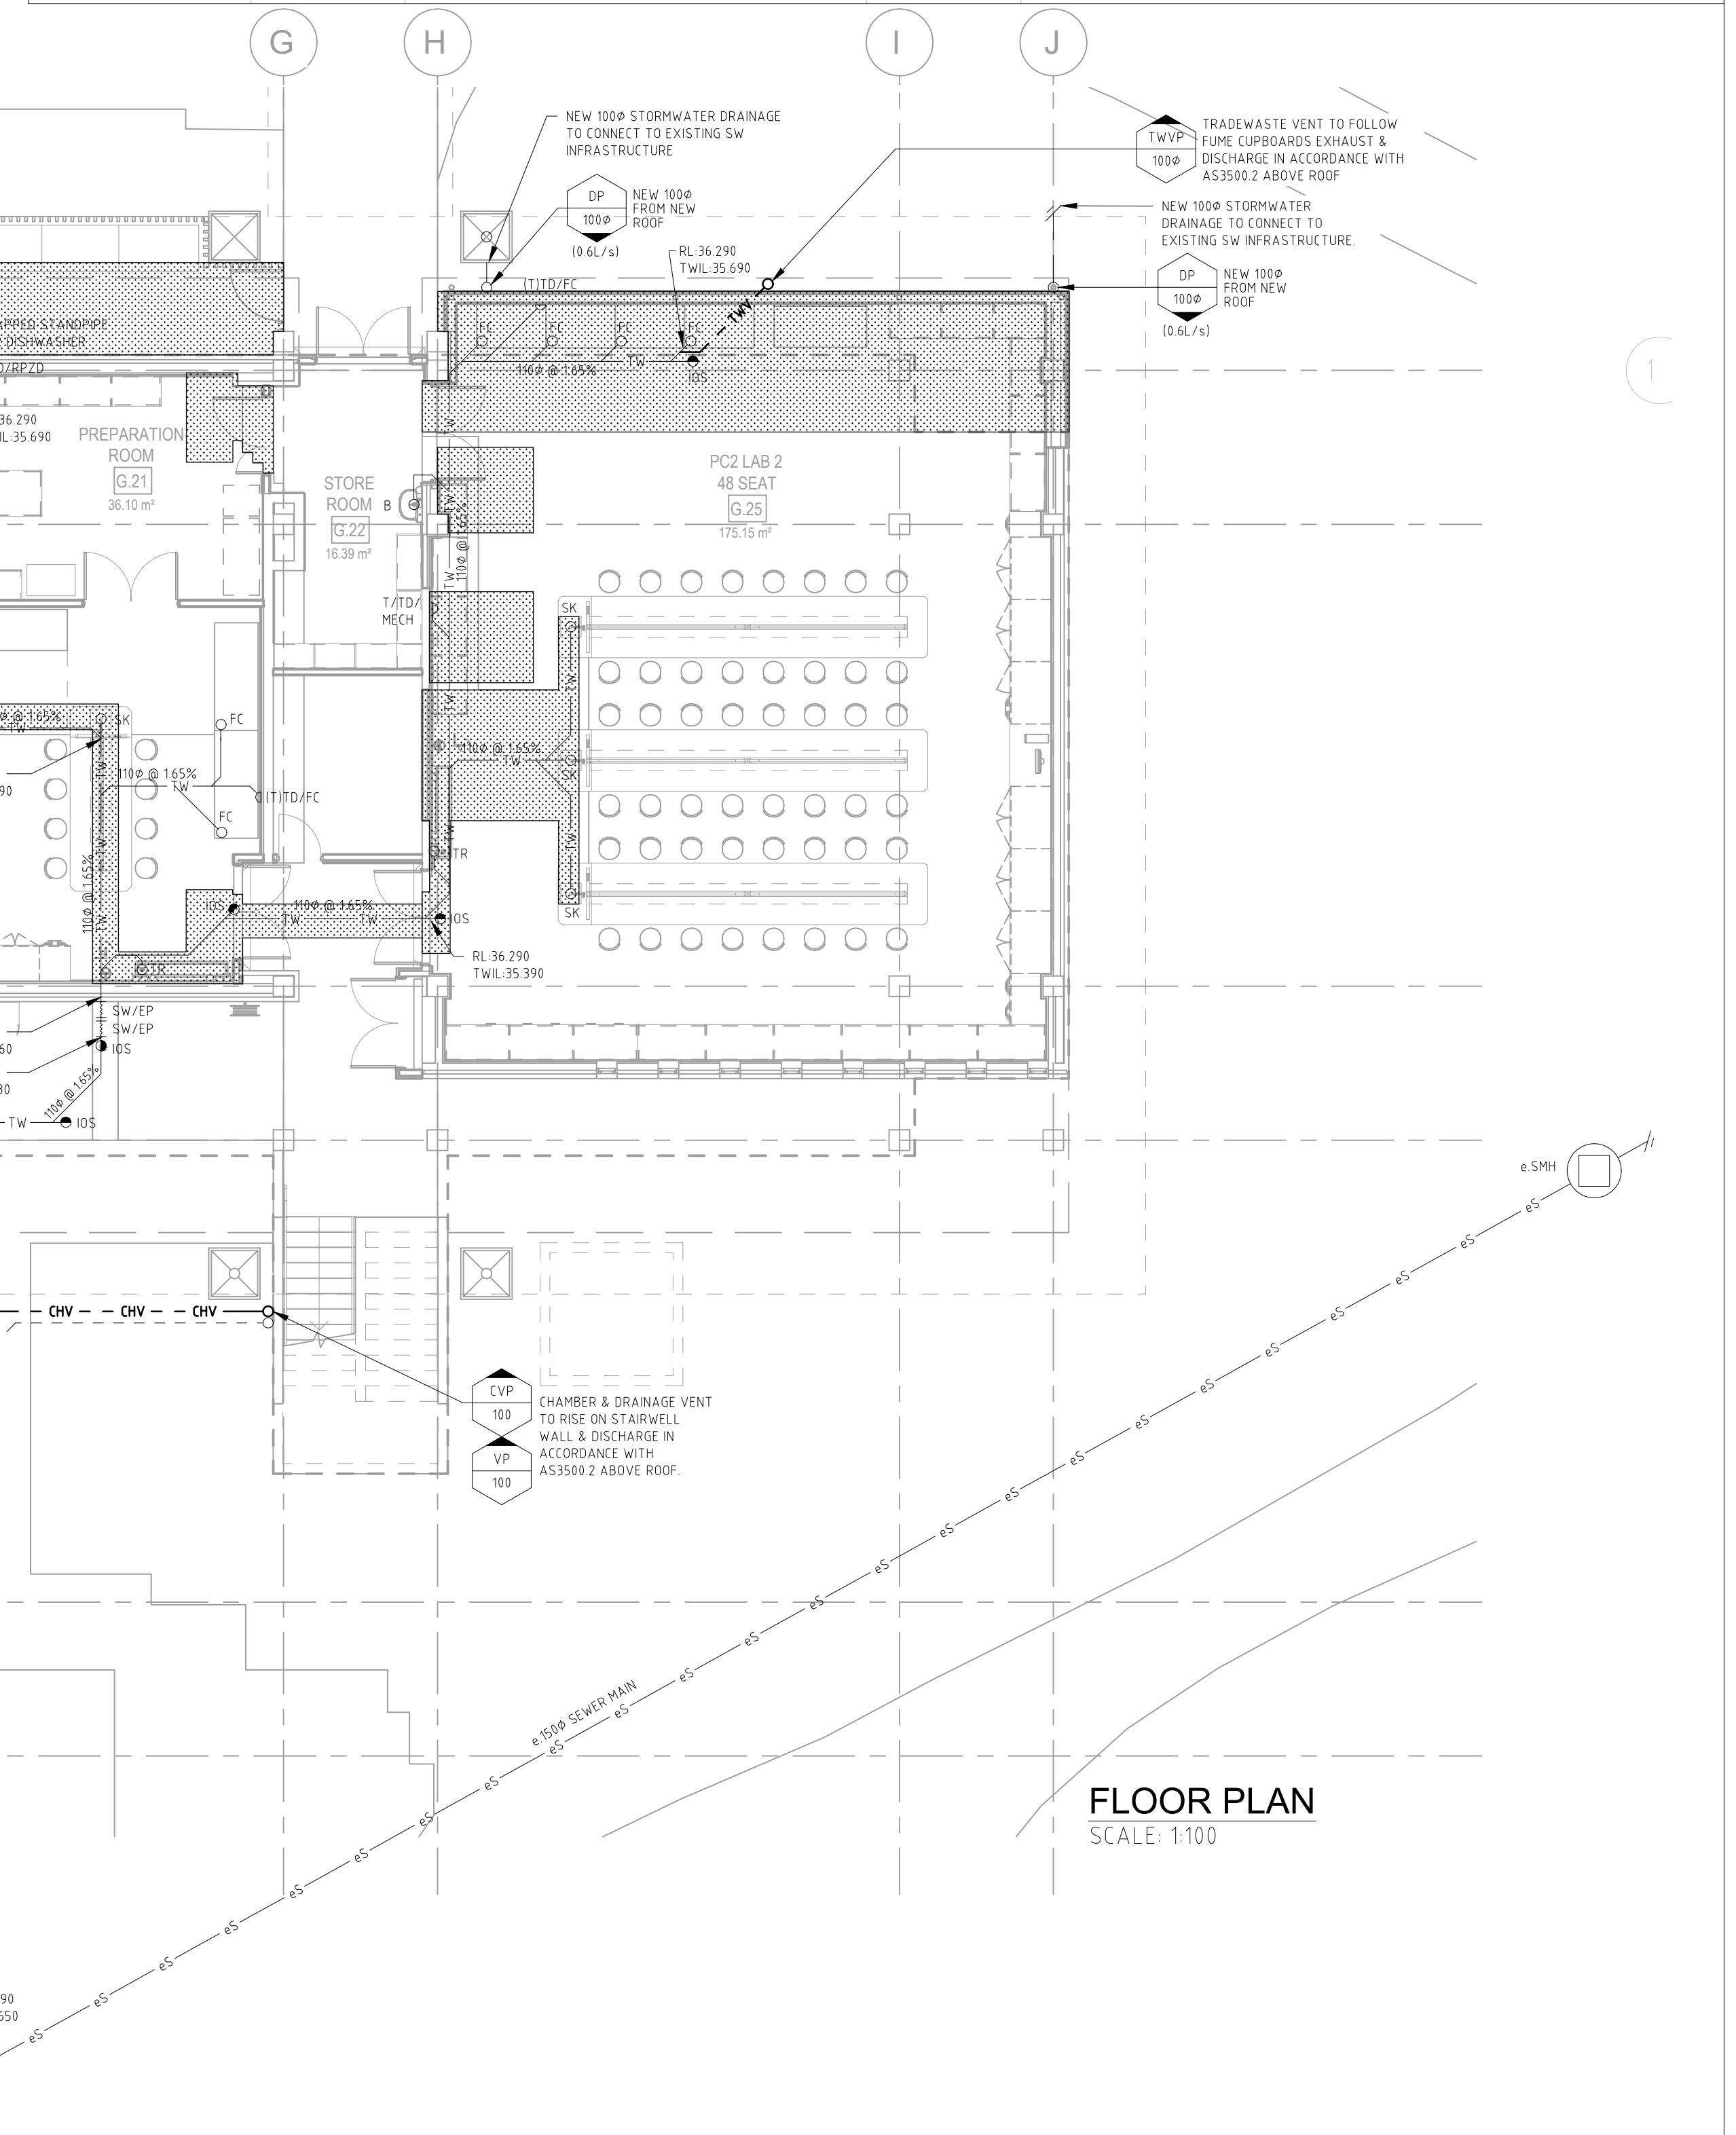

							ARCHIBUS FUNC. LOCATION -	DRAWN	KK			CQUniversity ROCKHAMPTON NORTH BUILDING 33 GIRVAN GROUP	BUILDING 33 PC2 LABORATORY CENTRAL QUEENSLAND UNIVERSITY 554/700 YAMMBA RD, NORMANGARDENS QLD 4701 CQU DWG. No. CQU-ROK-GN-HYD-02	Sheet Size	A1	
							RPEQ ENGINEER -	ENGINEER	DW					Scale	1:100	
02	AS CONSTRUCTED		KK	DW	DW	02.08.2024	RPEQ NUMBER	DATE	APPROVED	DW					Revision:	02
01	AS CONSTRUCTED		KK	DW	DW	11.07.2024	-	-								
REV	DESCRIPTION	DRN	ENG	APP	DATE	REFERENCE DRAWINGS	RPEQ APPROVAL			SIGNATURE				DATE		

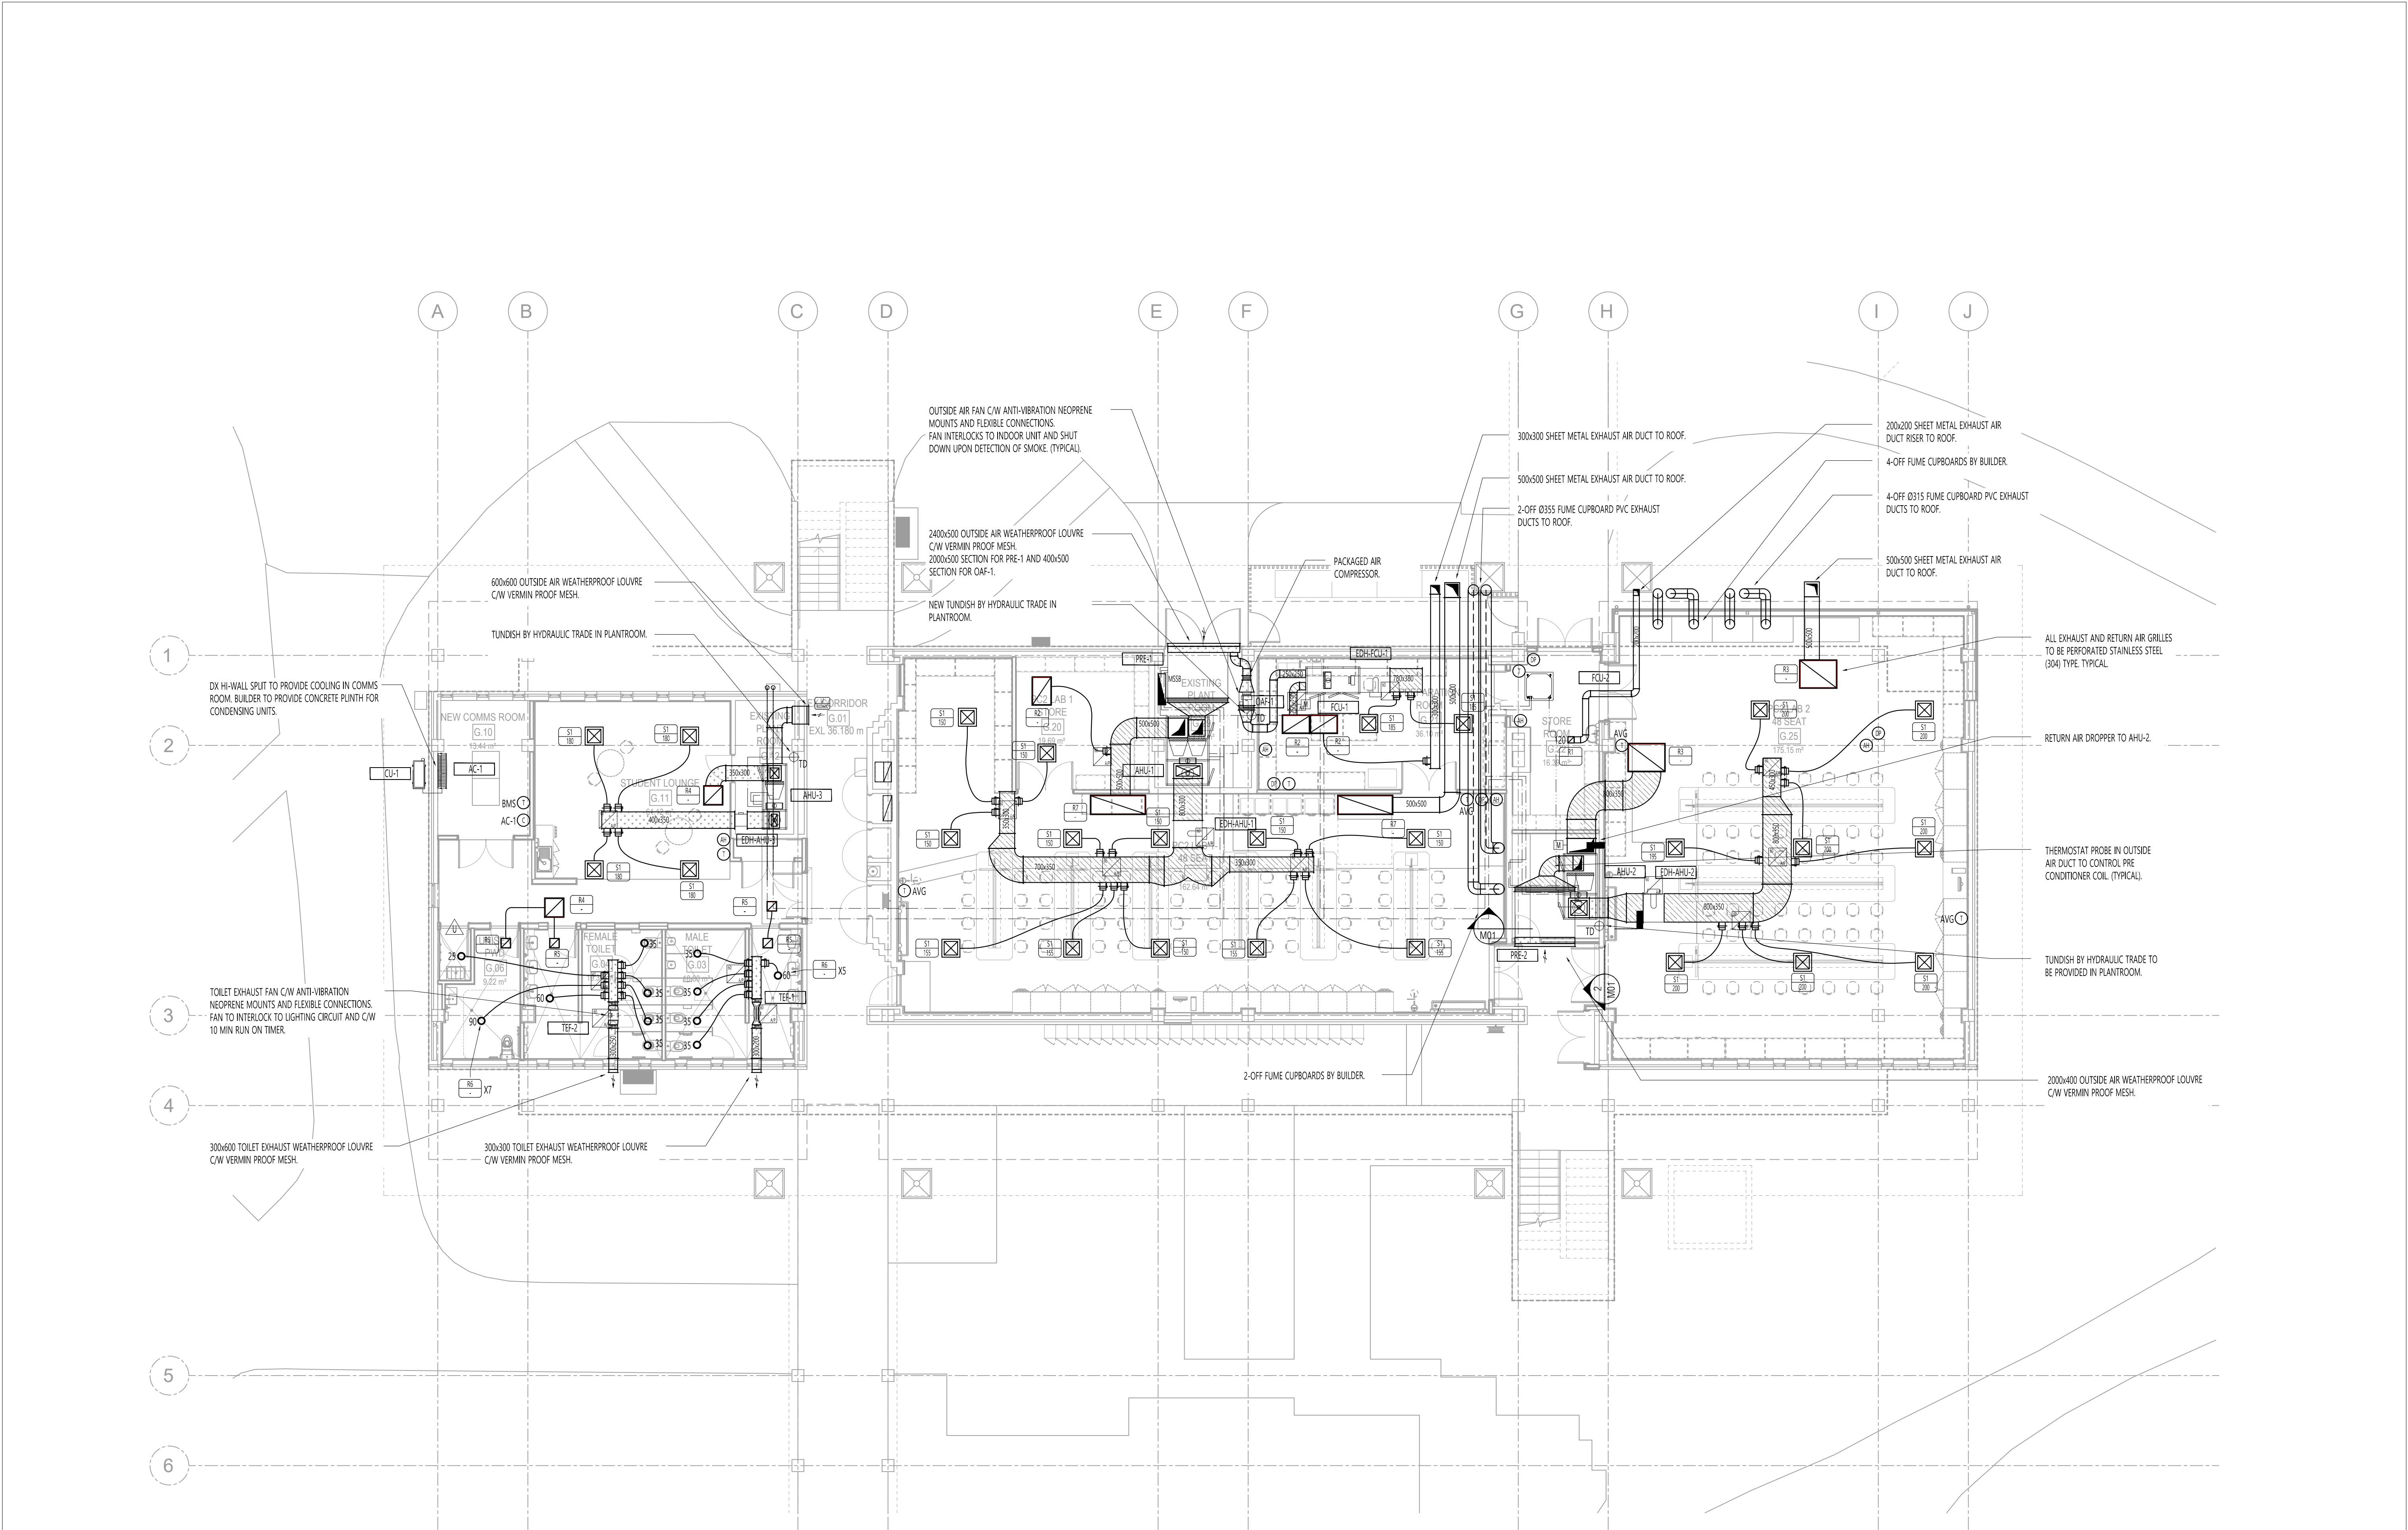

						ARCHIBUS FUNC. LOCATION -		DRAWN	WH				CQUniversity CAMPUS: ROCKHAMPTON NORTH		BUILDING 33 PC2 LABORATORY CENTRAL QUEENSLAND UNIVERSITY 554/700 YAMMBA RD, NORMANGARDENS QLD 4701		Sht Size A1
						RPEQ ENGINEER -		ENGINEER	SM				BUILDING: BUILDING 33		CQU DWG. No. CQU-ROK-GN-MECH-02		Scale 1:100
						RPEQ NUMBER -	DATE -	APPROVED	SM				VENDOR: GIRVAN GROUP				Revision: 02
02	AS CONSTRUCTED	WH	SM	SM	02.08.2024												
01	AS CONSTRUCTED	WH	SM	SM	11.07.2024												
REV	DESCRIPTION	DRN	ENG	APP	DATE	REFERENCE DRAWINGS	RPEQ APPROVAL			SIGNATURE	DATE						