


Each building will have its own individual building master key, which will have a Grand Master key override		
Room/Door type	Lock type	
External entry doors Classrooms Meeting Rooms Single person office Doors into open plan workspace Staffrooms Student kitchenette area Cleaners room Quiet recording rooms Sliding gates (compound entry) Pedestrian gates (compound entry) Technical training rooms (Trades) Storerooms	Monitored Electronic Strike Access Control Mortice Lock with Individual Building Master key and Cylinder	
Comms room	Monitored Electronic Strike Access Control Mortice Lock with 005 Building Master key and Cylinder	
Electrical cupboards and DBs, Mech boards, Plant rooms, Risers	Mortice Lock with Grand Master key and Cylinder	
Fire hose reel cupboard	No lock – free to open	
External roller doors	Reed switch	
Internal roller doors	No reed switch required	
Gas storage cages	Separate key under building master	
Fire stair exit from Refrigeration	Free to exit Monitored Electronic Strike Access Control to enter Mortice Lock with Specific Building Master key and Cylinder	
Horticulture doors	Individual Building Master key and Cylinder	
Horticulture compound gates	Padlock with Individual Building Master key and Cylinder	

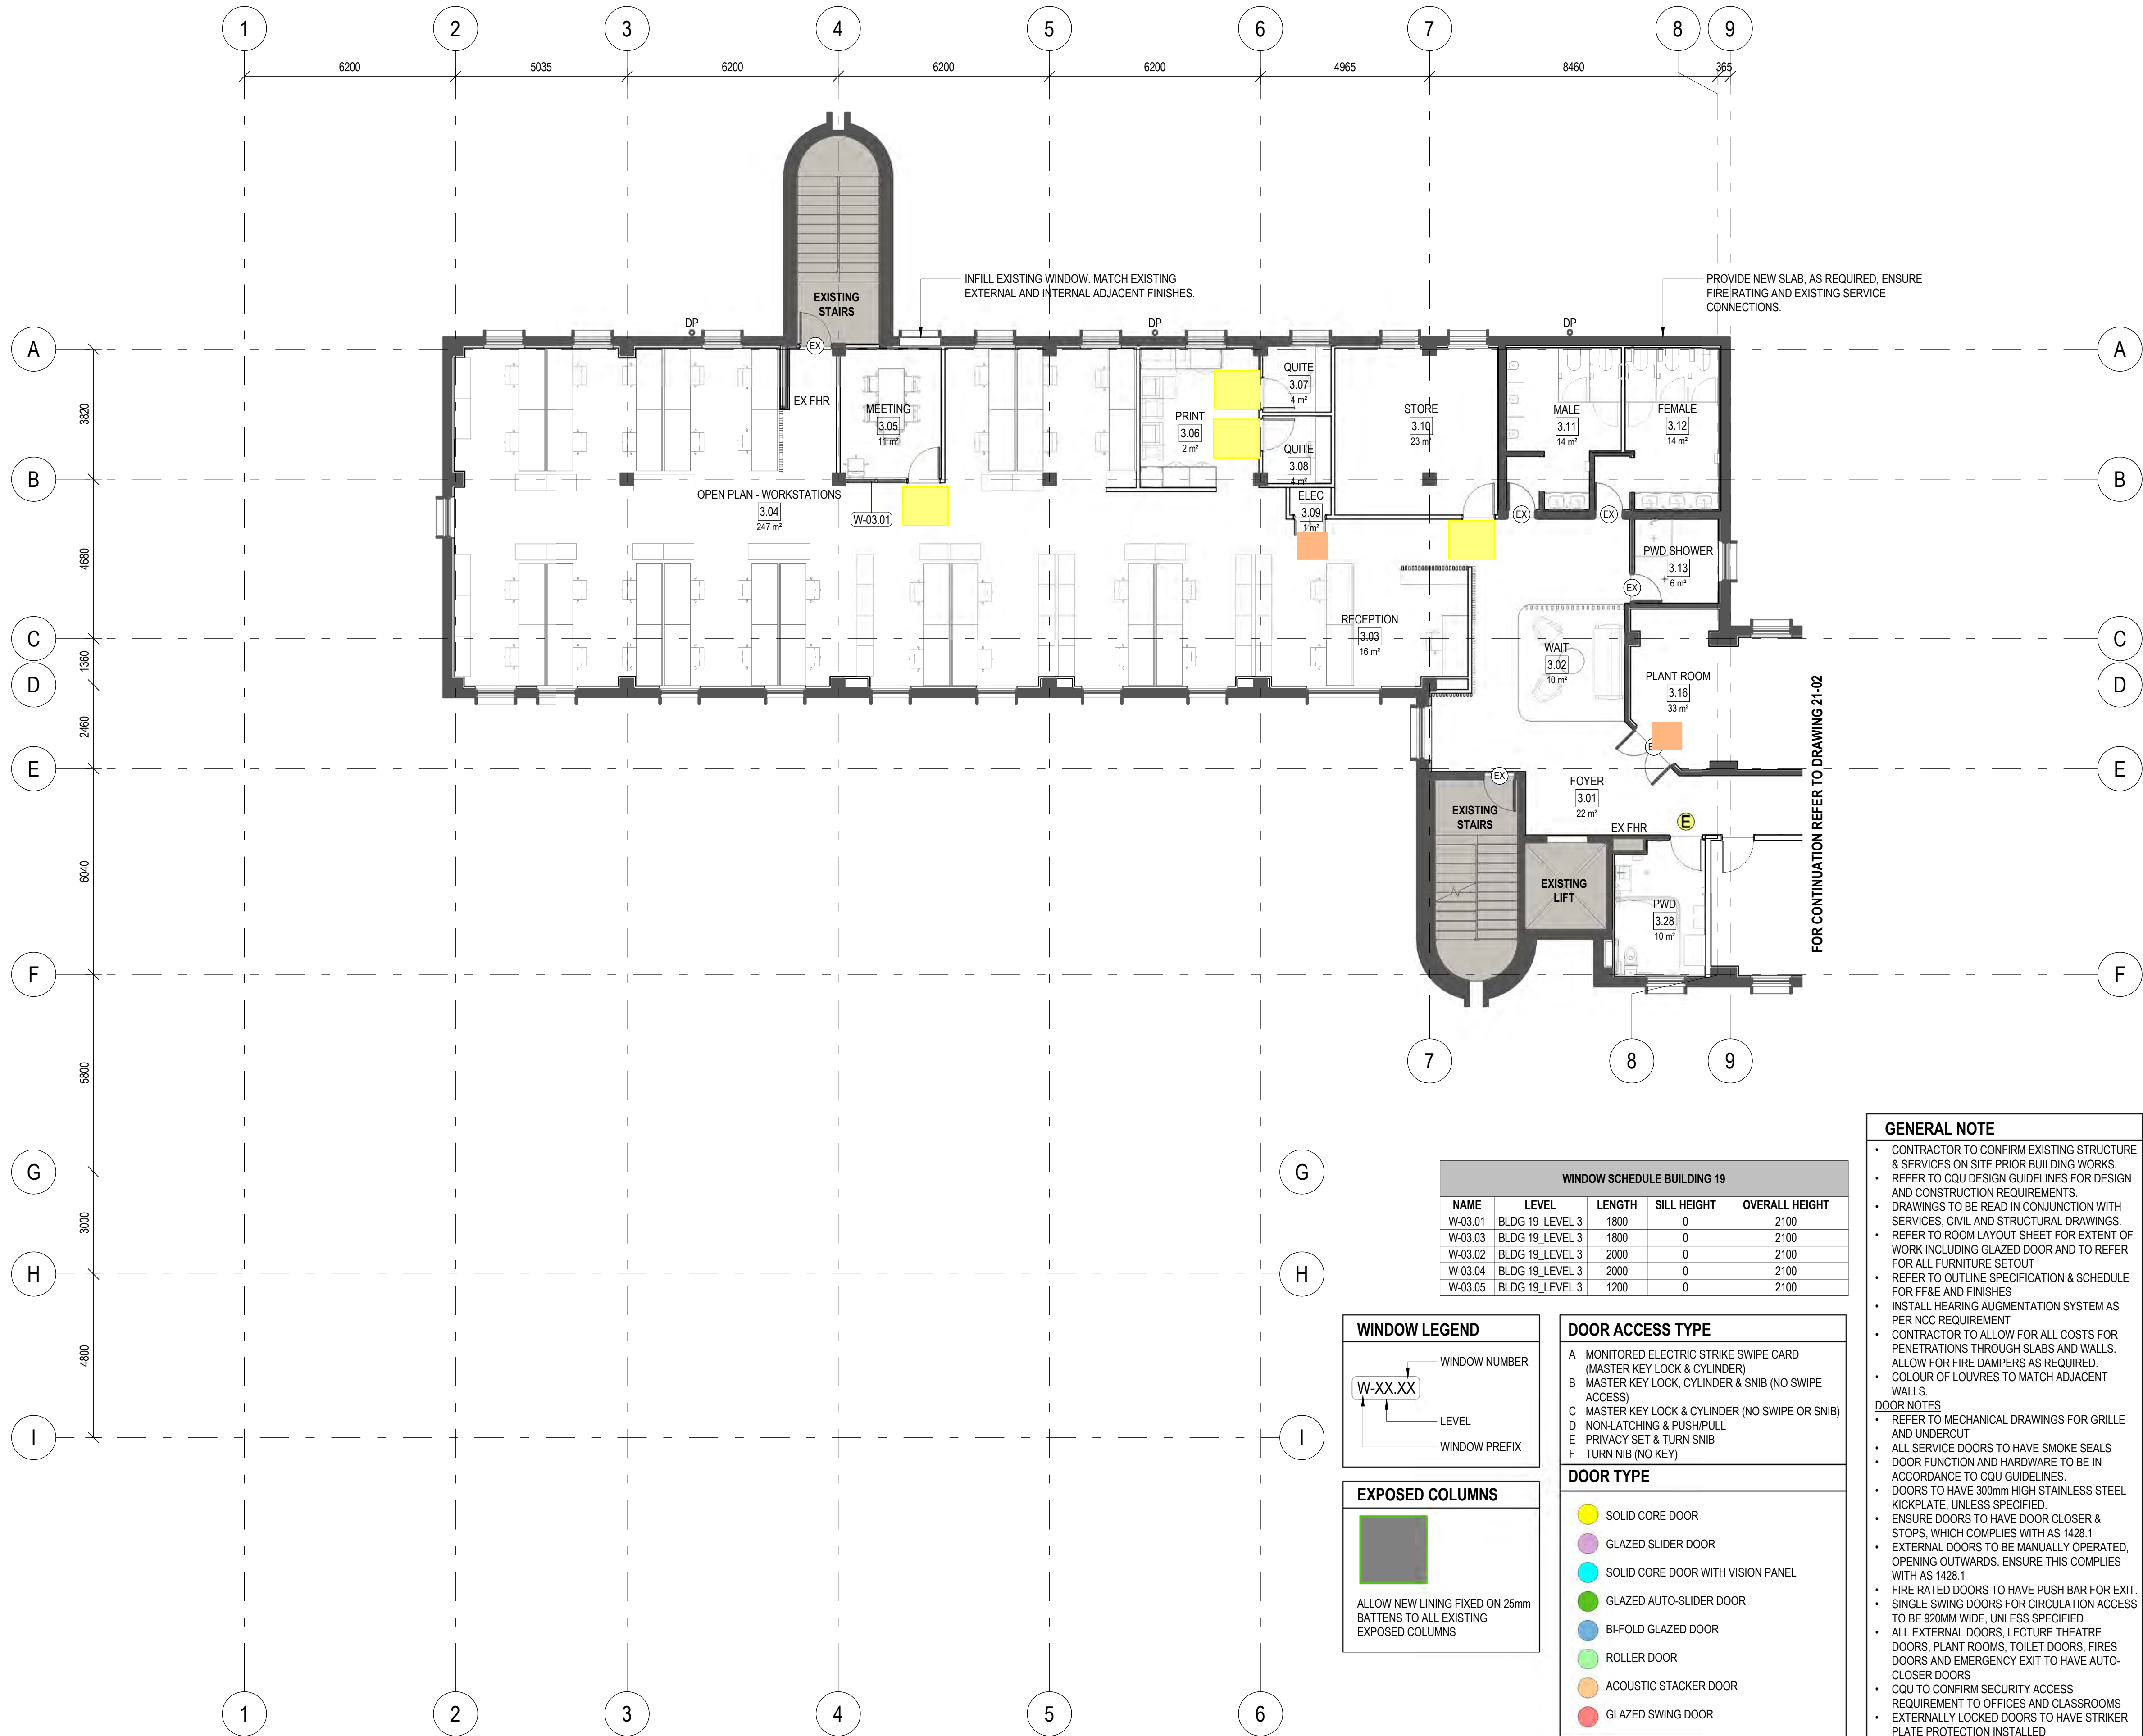

WINDOW SCHEDULE BUILDING 19				
NAME	LEVEL	LENGTH	SILL HEIGHT	OVERALL HEIGHT
W-03.01	BLDG 19_LEVEL 3	1800	0	2100
W-03.03	BLDG 19_LEVEL 3	1800	0	2100
W-03.02	BLDG 19_LEVEL 3	2000	0	2100
W-03.04	BLDG 19_LEVEL 3	2000	0	2100
W-03.05	BLDG 19_LEVEL 3	1200	0	2100

WINDOW LEGEND	
W-XX.XX	WINDOW NUMBER
XX	LEVEL
XX	WINDOW PREFIX

EXPOSED COLUMNS	
■	ALLOW NEW LINING FIXED ON 25mm BATTENS TO ALL EXISTING EXPOSED COLUMNS

DOOR ACCESS TYPE	
A	MONITORED ELECTRIC STRIKE SWIPE CARD (MASTER KEY LOCK & CYLINDER)
B	MASTER KEY LOCK, CYLINDER & SNIB (NO SWIPE ACCESS)
C	MASTER KEY LOCK & CYLINDER (NO SWIPE OR SNIB)
D	NON-LATCHING & PUSH/PULL
E	PRIVACY SET & TURN SNIB
F	TURN NIB (NO KEY)

DOOR TYPE	
●	SOLID CORE DOOR
●	GLAZED SLIDER DOOR
●	SOLID CORE DOOR WITH VISION PANEL
●	GLAZED AUTO-SLIDER DOOR
●	BI-FOLD GLAZED DOOR
●	ROLLER DOOR
●	ACOUSTIC STACKER DOOR
●	GLAZED SWING DOOR

DOOR ICON LEGEND	
●	ACCESS TYPE (TYPE MARK)
●	DOOR TYPE (COLOUR SHADE)

GENERAL NOTE	
• CONTRACTOR TO CONFIRM EXISTING STRUCTURE & SERVICES ON SITE PRIOR BUILDING WORKS.	
• REFER TO CQU DESIGN GUIDELINES FOR DESIGN AND CONSTRUCTION REQUIREMENTS.	
• DRAWINGS TO BE READ IN CONJUNCTION WITH SERVICES, CIVIL AND STRUCTURAL DRAWINGS.	
• REFER TO ROOM LAYOUT SHEET FOR EXTENT OF WORK INCLUDING GLAZED DOOR AND TO REFER FOR ALL FURNITURE SETOUT	
• REFER TO OUTLINE SPECIFICATION & SCHEDULE FOR FF&E AND FINISHES	
• INSTALL HEARING AUGMENTATION SYSTEM AS PER NCC REQUIREMENT	
• CONTRACTOR TO ALLOW FOR ALL COSTS FOR PENETRATIONS THROUGH SLABS AND WALLS. ALLOW FOR FIRE DAMPERS AS REQUIRED.	
• COLOUR OF LOUVRES TO MATCH ADJACENT WALLS.	
DOOR NOTES	
• REFER TO MECHANICAL DRAWINGS FOR GRILLE AND UNDERCUT	
• ALL SERVICE DOORS TO HAVE SMOKE SEALS	
• DOOR FUNCTION AND HARDWARE TO BE IN ACCORDANCE TO CQU GUIDELINES.	
• DOORS TO HAVE 300mm HIGH STAINLESS STEEL KICKPLATE, UNLESS SPECIFIED.	
• ENSURE DOORS TO HAVE DOOR CLOSER & STOPS, WHICH COMPLIES WITH AS 1428.1	
• EXTERNAL DOORS TO BE MANUALLY OPERATED, OPENING OUTWARDS. ENSURE THIS COMPLIES WITH AS 1428.1	
• FIRE RATED DOORS TO HAVE PUSH BAR FOR EXIT. SINGLE SWING DOORS FOR CIRCULATION ACCESS TO BE 920MM WIDE, UNLESS SPECIFIED	
• ALL EXTERNAL DOORS, LECTURE THEATRE DOORS, PLANT ROOMS, TOILET DOORS, FIRES DOORS AND EMERGENCY EXIT TO HAVE AUTO-CLOSER DOORS	
• CQU TO CONFIRM SECURITY ACCESS REQUIREMENT TO OFFICES AND CLASSROOMS	
• EXTERNALLY LOCKED DOORS TO HAVE STRIKER PLATE PROTECTION INSTALLED	
• PROVIDE DOOR CLOSERS TO ALL DOORS ENCLOSING AIR-CONDITIONED SPACES	
WINDOW NOTES	
• REFER TO SECTION J REPORT FOR THE REQUIRED GLAZING RATING	

CQU ROCKHAMPTON TAFE CONSOLIDATION - STAGE 2


554/700 Yaamba Rd, Norman
Gardens QLD 4701



B	2026-03-05	ISSUED FOR TENDER	BC
A	2026-02-12	ISSUED FOR TENDER	BC
6	2026-01-30	60% DRAFT ISSUE	BC
5	2026-01-23	CONSULTANT ISSUES	BC
4	2025-12-19	UPDATED ISSUE	BC
3	2025-12-16	UPDATED ISSUE	BC
2	2025-12-15	CONSULTANTS REVIEW	BC
1	2025-11-24	50% COSTING ISSUE	PT

rev	date	details	init.
-----	------	---------	-------

drawn	date
JS	19/01/2026
checked	date
SS	12/02/2026
verified	date

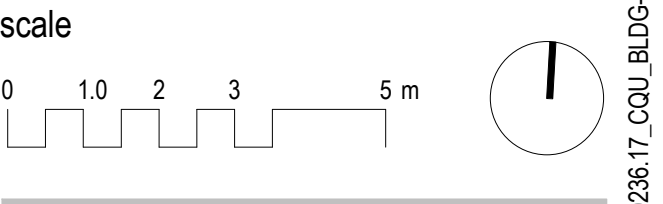

FLOOR PLAN - LEVEL 3 - PART 1 PROPOSED

scale	project no.
1 : 100 @ A1	25.0236.17

revision	
B	
sheet no.	
CQU-ROK-019-03-ARC-21-01	

ISSUED FOR TENDER




CQU ROCKHAMPTON TAFE CONSOLIDATION - STAGE 2

554/700 Yaamba Rd, Norman
Gardens QLD 4701



B	2026-03-05	ISSUED FOR TENDER	BC
A	2026-02-12	ISSUED FOR TENDER	BC
6	2026-01-30	60% DRAFT ISSUE	BC
5	2026-01-23	CONSULTANT ISSUES	BC
4	2025-12-19	UPDATED ISSUE	BC
3	2025-12-16	UPDATED ISSUE	BC
2	2025-12-15	CONSULTANTS REVIEW	BC
1	2025-11-24	50% COSTING ISSUE	PT
rev	date	details	init.


drawn	date
JS	19/01/2026
checked	date
SS	12/02/2026
verified	date

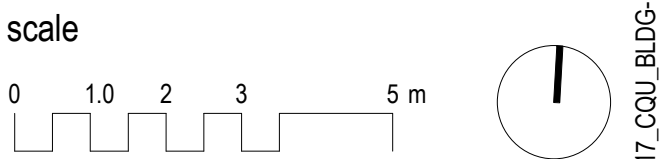

FLOOR PLAN - LEVEL 3 - PART 2 PROPOSED

scale project no.
1 : 100 @ A1 25.0236.17

revision
B
sheet no.
CQU-ROK-019-03-ARC-21-02

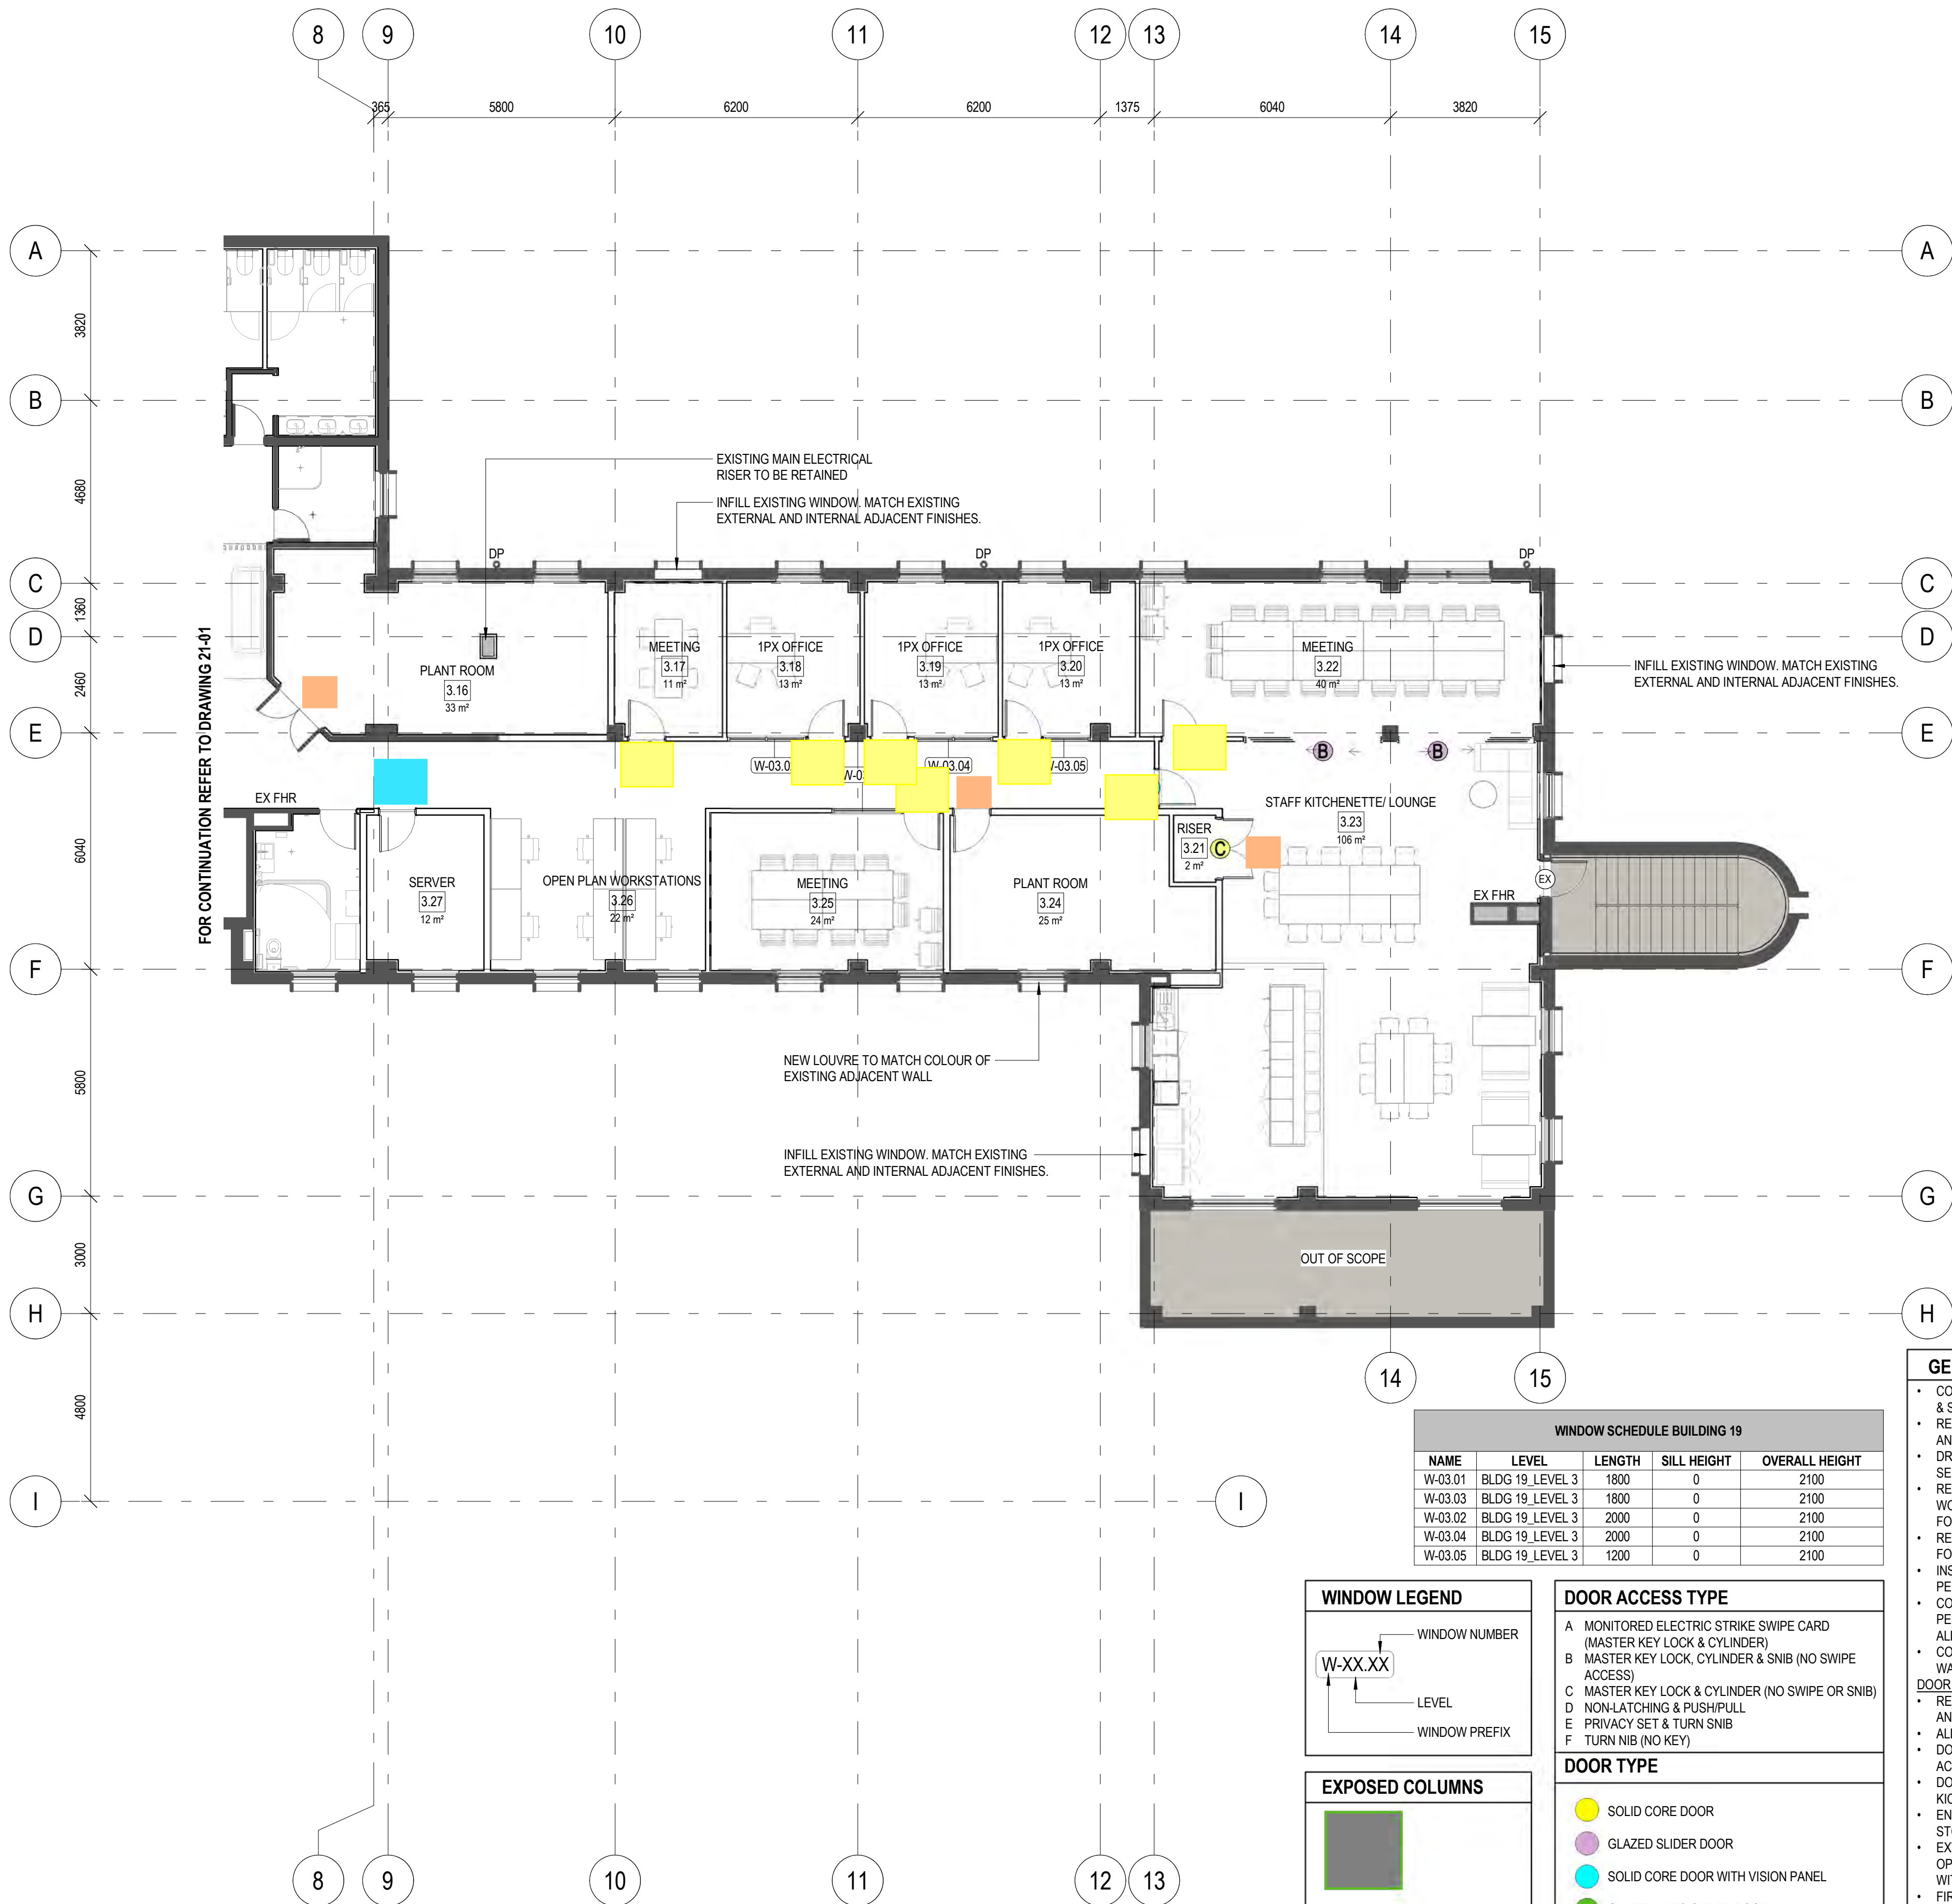

WINDOW SCHEDULE BUILDING 19				
NAME	LEVEL	LENGTH	SILL HEIGHT	OVERALL HEIGHT
W-03.01	BLDG 19 LEVEL 3	1800	0	2100
W-03.03	BLDG 19 LEVEL 3	1800	0	2100
W-03.02	BLDG 19 LEVEL 3	2000	0	2100
W-03.04	BLDG 19 LEVEL 3	2000	0	2100
W-03.05	BLDG 19 LEVEL 3	1200	0	2100

WINDOW LEGEND	
WINDOW NUMBER	
W-XX.XX	
LEVEL	
WINDOW PREFIX	

EXPOSED COLUMNS	
ALLOW NEW LINING FIXED ON 25mm BATTENS TO ALL EXISTING EXPOSED COLUMNS	

DOOR ACCESS TYPE	
A	MONITORED ELECTRIC STRIKE SWIPE CARD (MASTER KEY LOCK & CYLINDER)
B	MASTER KEY LOCK, CYLINDER & SNIB (NO SWIPE ACCESS)
C	MASTER KEY LOCK & CYLINDER (NO SWIPE OR SNIB)
D	NON-LATCHING & PUSH/PULL
E	PRIVACY SET & TURN SNIB
F	TURN NIB (NO KEY)

DOOR TYPE	
	SOLID CORE DOOR
	GLAZED SLIDER DOOR
	SOLID CORE DOOR WITH VISION PANEL
	GLAZED AUTO-SLIDER DOOR
	BI-FOLD GLAZED DOOR
	ROLLER DOOR
	ACOUSTIC STACKER DOOR
	GLAZED SWING DOOR

DOOR ICON LEGEND	
XX	ACCESS TYPE (TYPE MARK)
	DOOR TYPE (COLOUR SHADE)

- GENERAL NOTE**
- CONTRACTOR TO CONFIRM EXISTING STRUCTURE & SERVICES ON SITE PRIOR BUILDING WORKS.
 - REFER TO CQU DESIGN GUIDELINES FOR DESIGN AND CONSTRUCTION REQUIREMENTS.
 - DRAWINGS TO BE READ IN CONJUNCTION WITH SERVICES, CIVIL AND STRUCTURAL DRAWINGS.
 - REFER TO ROOM LAYOUT SHEET FOR EXTENT OF WORK INCLUDING GLAZED DOOR AND TO REFER FOR ALL FURNITURE SETOUT
 - REFER TO OUTLINE SPECIFICATION & SCHEDULE FOR FF&E AND FINISHES
 - INSTALL HEARING AUGMENTATION SYSTEM AS PER NCC REQUIREMENT
 - CONTRACTOR TO ALLOW FOR ALL COSTS FOR PENETRATIONS THROUGH SLABS AND WALLS. ALLOW FOR FIRE DAMPERS AS REQUIRED.
 - COLOUR OF LOUVRES TO MATCH ADJACENT WALLS.
- DOOR NOTES**
- REFER TO MECHANICAL DRAWINGS FOR GRILLE AND UNDERCUT
 - ALL SERVICE DOORS TO HAVE SMOKE SEALS
 - DOOR FUNCTION AND HARDWARE TO BE IN ACCORDANCE TO CQU GUIDELINES.
 - DOORS TO HAVE 300mm HIGH STAINLESS STEEL KICKPLATE, UNLESS SPECIFIED.
 - ENSURE DOORS TO HAVE DOOR CLOSER & STOPS, WHICH COMPLIES WITH AS 1428.1
 - EXTERNAL DOORS TO BE MANUALLY OPERATED, OPENING OUTWARDS. ENSURE THIS COMPLIES WITH AS 1428.1
 - FIRE RATED DOORS TO HAVE PUSH BAR FOR EXIT.
 - SINGLE SWING DOORS FOR CIRCULATION ACCESS TO BE 920MM WIDE, UNLESS SPECIFIED
 - ALL EXTERNAL DOORS, LECTURE THEATRE DOORS, PLANT ROOMS, TOILET DOORS, FIRES DOORS AND EMERGENCY EXIT TO HAVE AUTO-CLOSER DOORS
 - CQU TO CONFIRM SECURITY ACCESS REQUIREMENT TO OFFICES AND CLASSROOMS
 - EXTERNALLY LOCKED DOORS TO HAVE STRIKER PLATE PROTECTION INSTALLED
 - PROVIDE DOOR CLOSERS TO ALL DOORS ENCLOSING AIR-CONDITIONED SPACES
- WINDOW NOTES**
- REFER TO SECTION J REPORT FOR THE REQUIRED GLAZING RATING

ISSUED FOR TENDER

**CQU ROCKHAMPTON
TAFE
CONSOLIDATION -
STAGE 2**
ROCKHAMPTON, QUEENSLAND



A	12/02/26	ISSUED FOR TENDER	BS
1	30/01/26	DRAFT 60% ISSUE	BS
rev/	date	details	init.

drawn	date
BS	30/01/26
checked	date
Checker	30/01/26
verified	date
BS	30/01/26


scale

1


**ENGINEERING
DEPARTMENT GA PLANS**

scale project no.
1 : 100 @ A1 260018
revision
A
sheet no.
CQU-ROK-21A-G-ARC-21-00

NOTE: LAYOUT OF SHED BASED OFF AS BUILT DRAWINGS PROVIDED BY CLIENT. CONTRACTOR TO ALLOW FOR SITE VISIT TO ASSESS CURRENT CONDITION AND LAYOUT OF SHED BEFORE CONSTRUCTION DOCUMENTATION / CONSULTANT COORDINATION PHASE

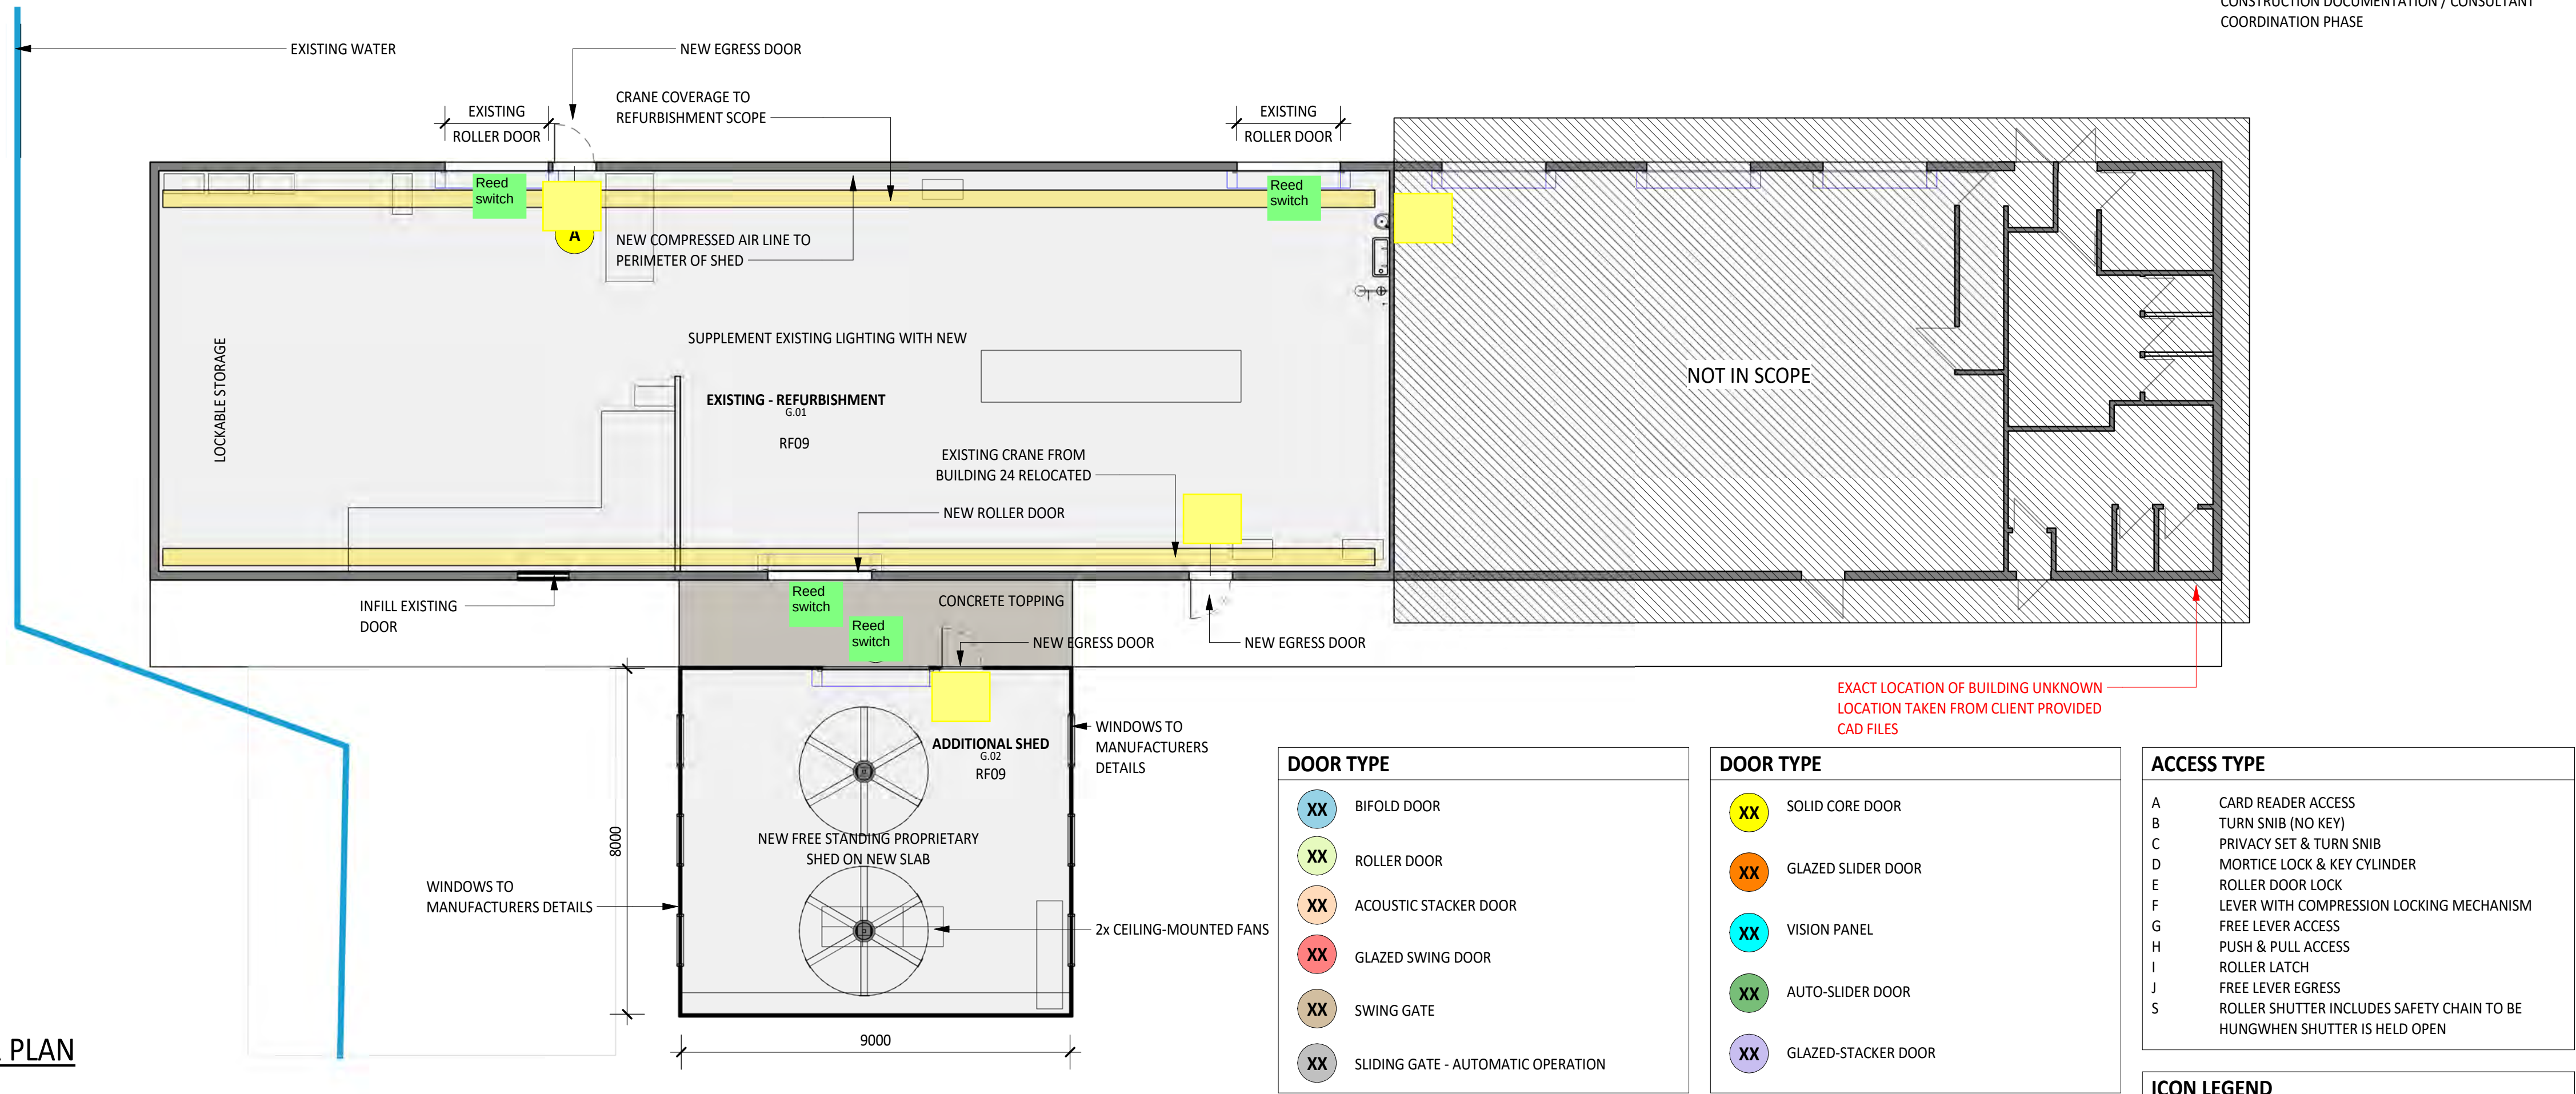

1 GROUND FLOOR PLAN
1 : 100

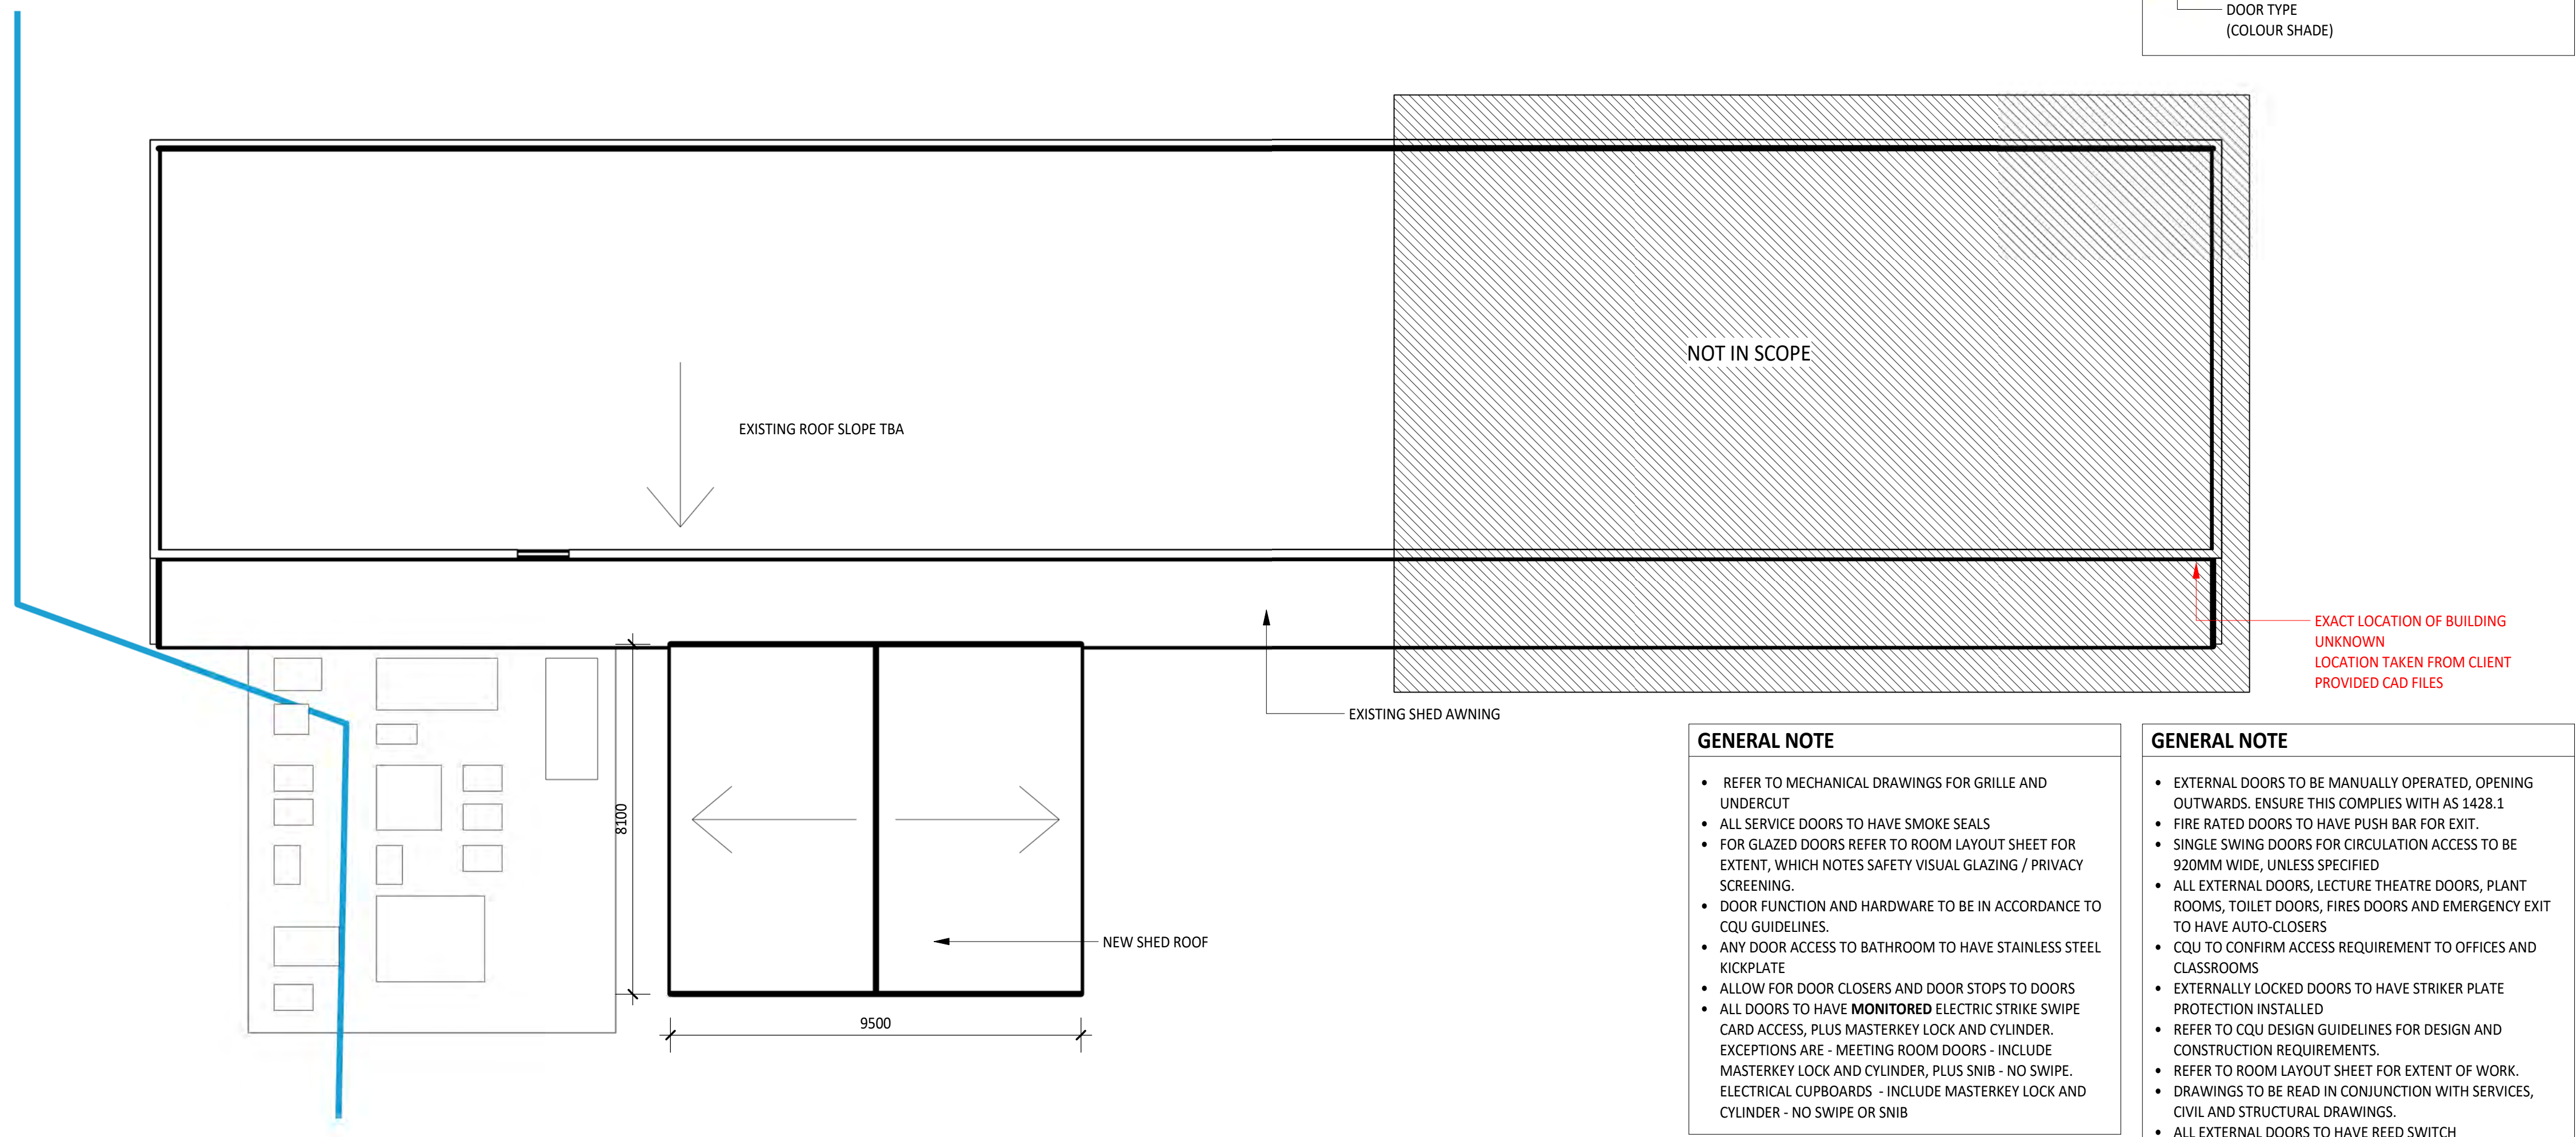

2 ROOF PLAN
1 : 100

GENERAL NOTE

- REFER TO MECHANICAL DRAWINGS FOR GRILLE AND UNDERCUT
- ALL SERVICE DOORS TO HAVE SMOKE SEALS
- FOR GLAZED DOORS REFER TO ROOM LAYOUT SHEET FOR EXTENT, WHICH NOTES SAFETY VISUAL GLAZING / PRIVACY SCREENING.
- DOOR FUNCTION AND HARDWARE TO BE IN ACCORDANCE TO CQU GUIDELINES.
- ANY DOOR ACCESS TO BATHROOM TO HAVE STAINLESS STEEL KICKPLATE
- ALLOW FOR DOOR CLOSERS AND DOOR STOPS TO DOORS
- ALL DOORS TO HAVE **MONITORED** ELECTRIC STRIKE SWIPE CARD ACCESS, PLUS MASTERKEY LOCK AND CYLINDER. EXCEPTIONS ARE - MEETING ROOM DOORS - INCLUDE MASTERKEY LOCK AND CYLINDER, PLUS SNIB - NO SWIPE. ELECTRICAL CUPBOARDS - INCLUDE MASTERKEY LOCK AND CYLINDER - NO SWIPE OR SNIB

GENERAL NOTE

- EXTERNAL DOORS TO BE MANUALLY OPERATED, OPENING OUTWARDS. ENSURE THIS COMPLIES WITH AS 1428.1
- FIRE RATED DOORS TO HAVE PUSH BAR FOR EXIT.
- SINGLE SWING DOORS FOR CIRCULATION ACCESS TO BE 920MM WIDE, UNLESS SPECIFIED
- ALL EXTERNAL DOORS, LECTURE THEATRE DOORS, PLANT ROOMS, TOILET DOORS, FIRES DOORS AND EMERGENCY EXIT TO HAVE AUTO-CLOSERS
- CQU TO CONFIRM ACCESS REQUIREMENT TO OFFICES AND CLASSROOMS
- EXTERNALLY LOCKED DOORS TO HAVE STRIKER PLATE PROTECTION INSTALLED
- REFER TO CQU DESIGN GUIDELINES FOR DESIGN AND CONSTRUCTION REQUIREMENTS.
- REFER TO ROOM LAYOUT SHEET FOR EXTENT OF WORK.
- DRAWINGS TO BE READ IN CONJUNCTION WITH SERVICES, CIVIL AND STRUCTURAL DRAWINGS.
- ALL EXTERNAL DOORS TO HAVE REED SWITCH

ISSUED FOR TENDER

**CQU ROCKHAMPTON
TAFE
CONSOLIDATION -
STAGE 2**554/700 Yaamba Rd, Norman
Gardens QLD 4701


for



B	2026-03-05	ISSUED FOR TENDER	BC
A	2026-02-12	ISSUED FOR TENDER	BC
6	2026-01-30	60% DRAFT ISSUE	BC
5	2026-01-23	CONSULTANT ISSUES	BC
4	2025-12-19	UPDATED ISSUE	BC
3	2025-12-16	UPDATED ISSUE	BC
2	2025-12-15	CONSULTANT ISSUES	BC
1	2025-11-24	50% COSTING ISSUE	PT

rev	date	details	init.
-----	------	---------	-------

drawn	date
JS/BC	19/01/2026
checked	date
SS	12/02/2026
verified	date

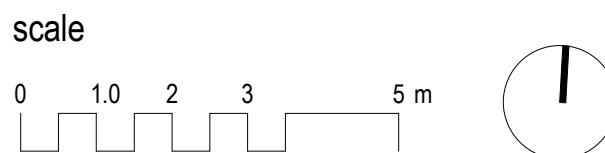**FLOOR PLAN - LEVEL 1 -
PROPOSED**scale
1 : 100 @ A1
project no.
25.0236.17


revision

B

sheet no.

CQU-ROK-033-01-ARC-21-01

original sheet size - A1 (594mm x 841mm)

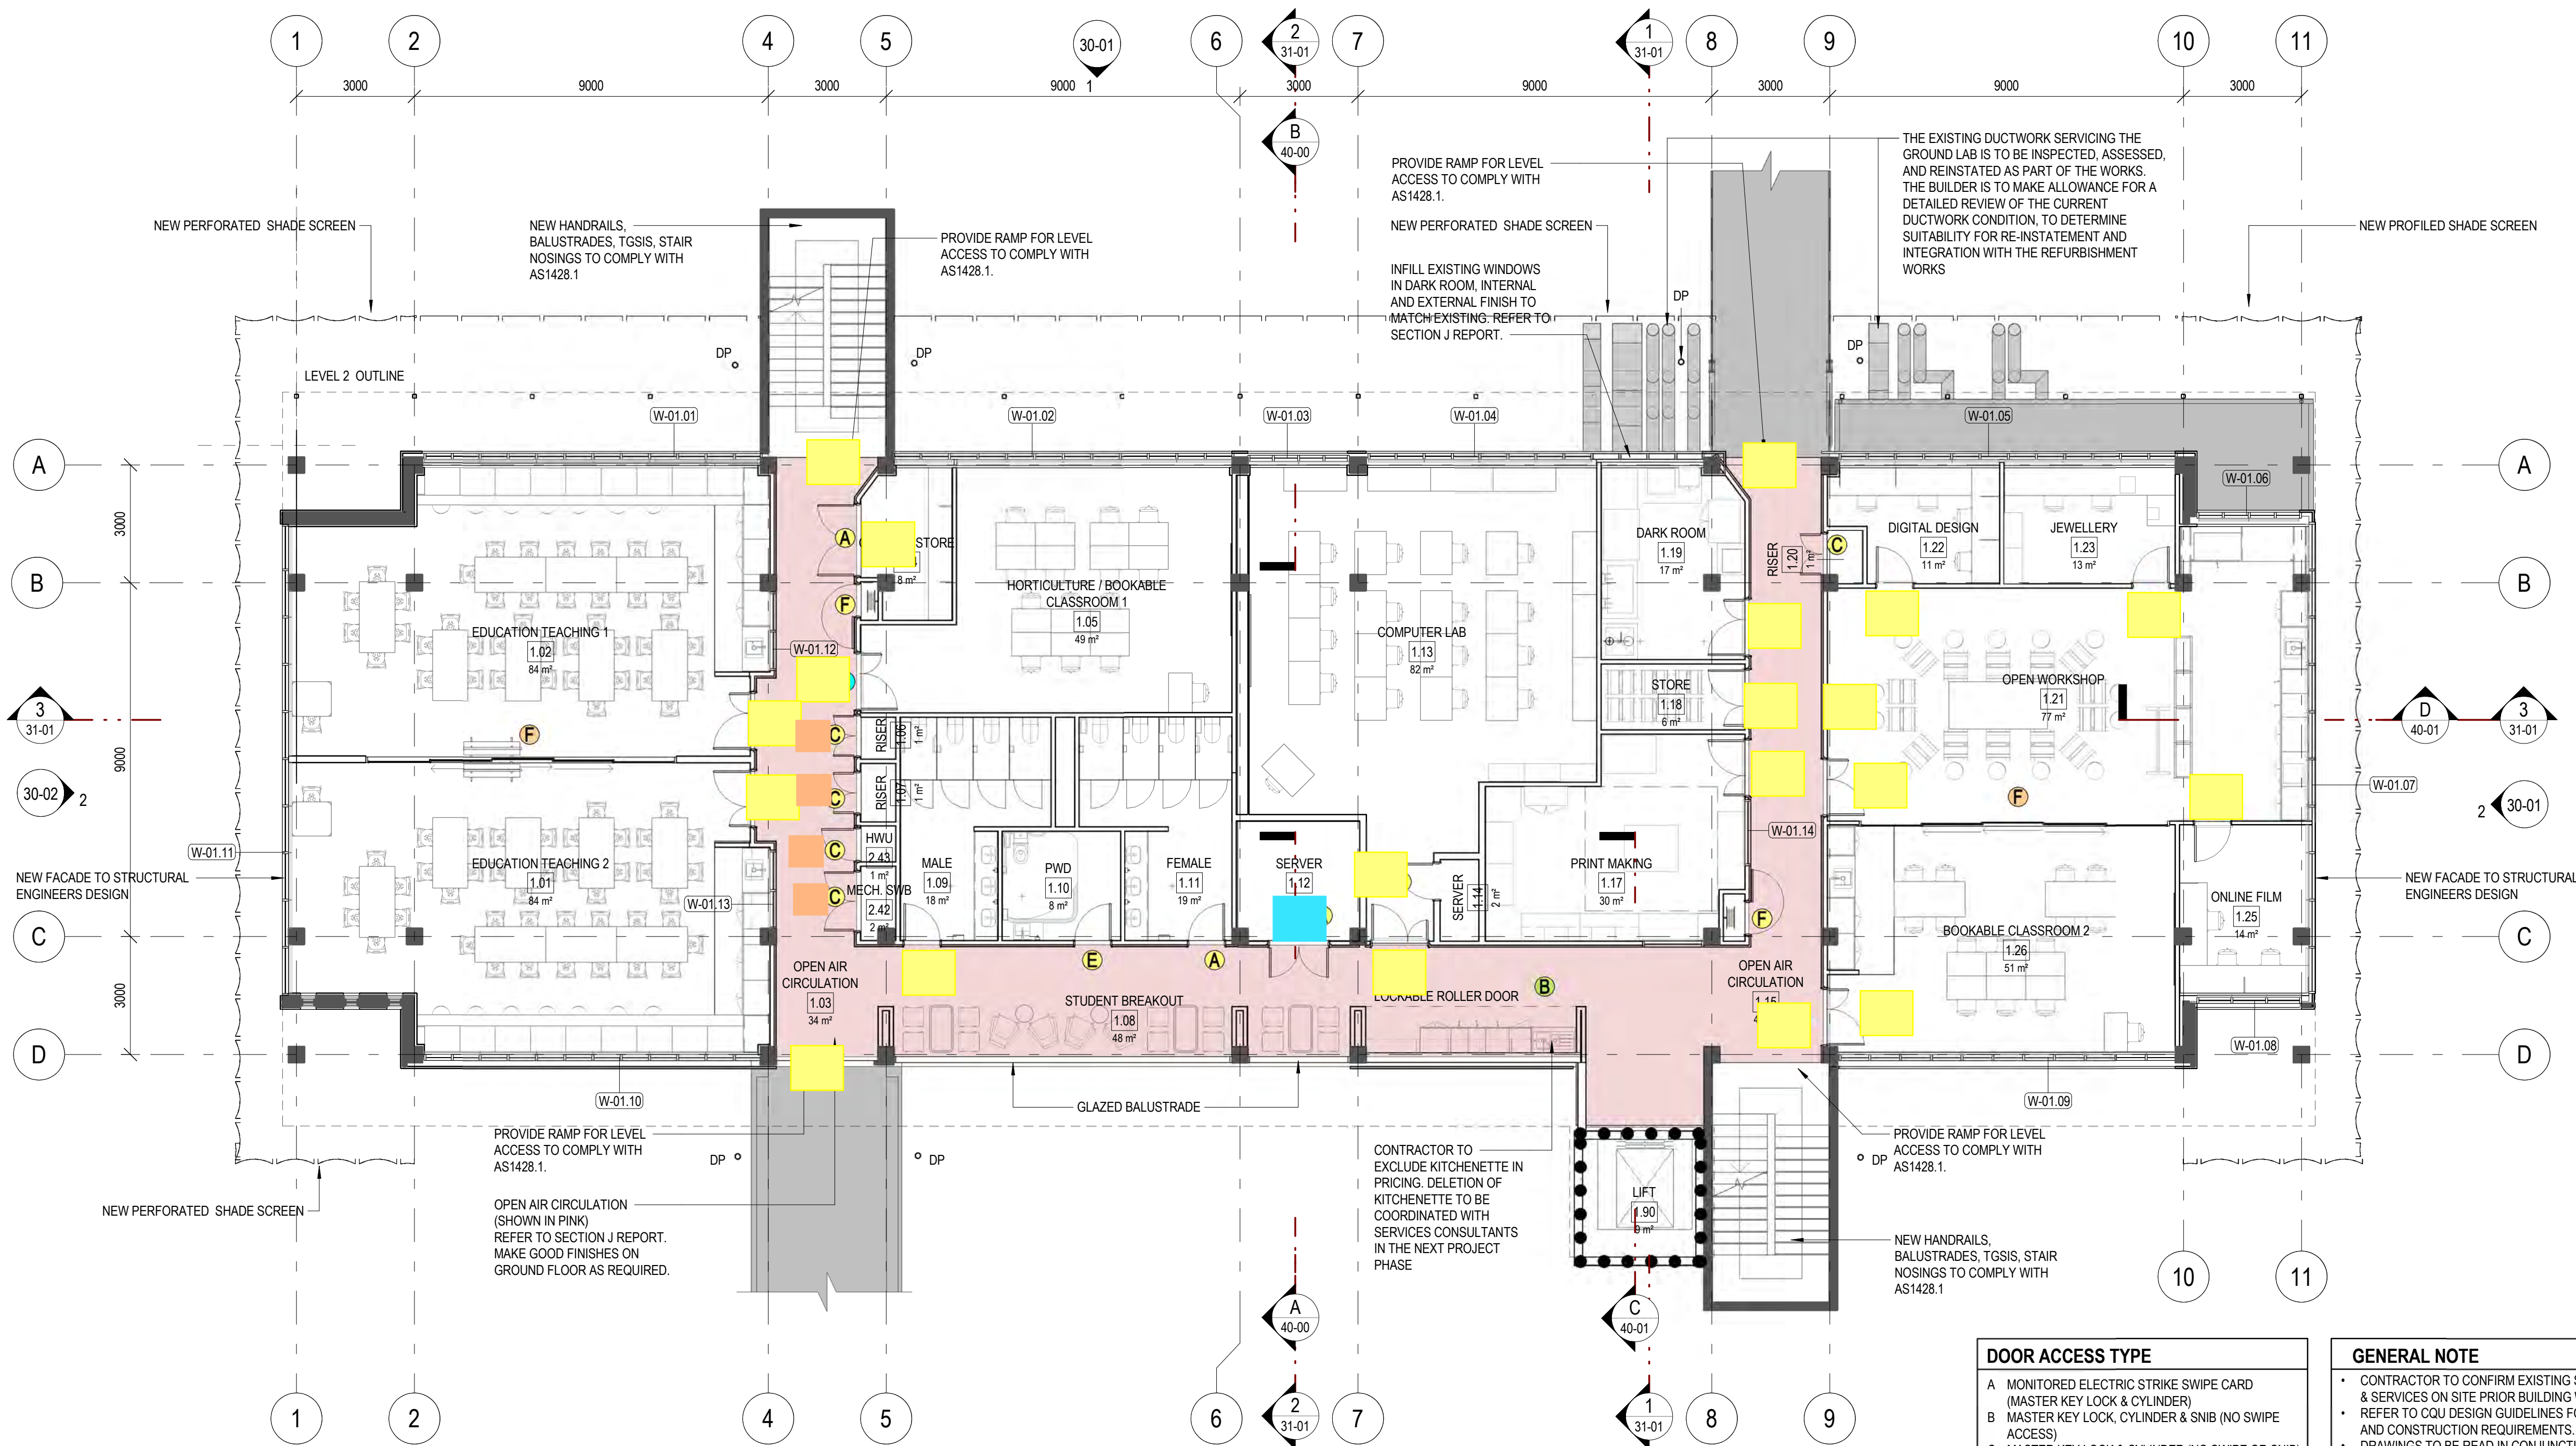**DOOR ACCESS TYPE**

- A MONITORED ELECTRIC STRIKE SWIPE CARD (MASTER KEY LOCK & CYLINDER)
- B MASTER KEY LOCK, CYLINDER & SNIB (NO SWIPE ACCESS)
- C MASTER KEY LOCK & CYLINDER (NO SWIPE OR SNIB)
- D NON-LATCHING & PUSH/PULL
- E PRIVACY SET & TURN SNIB
- F TURN NIB (NO KEY)

DOOR TYPE

- SOLID CORE DOOR
- GLAZED SLIDER DOOR
- SOLID CORE DOOR WITH VISION PANEL
- GLAZED AUTO-SLIDER DOOR
- BI-FOLD GLAZED DOOR
- ROLLER DOOR
- ACOUSTIC STACKER DOOR
- GLAZED SWING DOOR

DOOR ICON LEGEND

- xx ACCESS TYPE (TYPE MARK)
- DOOR TYPE (COLOUR SHADE)

WINDOW LEGEND

- WINDOW NUMBER
- LEVEL
- WINDOW PREFIX

WINDOW SCHEDULE BUILDING 33 - LEVEL 1 - INTERNAL				
NAME	LEVEL	LENGTH	SILL HEIGHT	OVERALL HEIGHT
W-01.12	LEVEL 1	2000	1200	1200
W-01.13	LEVEL 1	2000	1200	1200
W-01.14	LEVEL 1	1700	1100	1000


WINDOW SCHEDULE BUILDING 33 - LEVEL 1 - EXTERNAL				
NAME	LEVEL	LENGTH	SILL HEIGHT	OVERALL HEIGHT
W-01.01	LEVEL 1	EXISTING LENGTH	1000	1200
W-01.02	LEVEL 1	EXISTING LENGTH	1000	1200
W-01.03	LEVEL 1	EXISTING LENGTH	1000	1200
W-01.04	LEVEL 1	EXISTING LENGTH	1000	1200
W-01.05	LEVEL 1	EXISTING LENGTH	1000	1200
W-01.06	LEVEL 1	EXISTING LENGTH	1000	1200
W-01.07	LEVEL 1	EXISTING LENGTH	1100	1600
W-01.08	LEVEL 1	EXISTING LENGTH	1200	1200
W-01.09	LEVEL 1	EXISTING LENGTH	1200	1200
W-01.10	LEVEL 1	EXISTING LENGTH	1000	1200
W-01.11	LEVEL 1	EXISTING LENGTH	0	2700

GENERAL NOTE

- CONTRACTOR TO CONFIRM EXISTING STRUCTURE & SERVICES ON SITE PRIOR BUILDING WORKS.
- REFER TO CQU DESIGN GUIDELINES FOR DESIGN AND CONSTRUCTION REQUIREMENTS.
- DRAWINGS TO BE READ IN CONJUNCTION WITH SERVICES, CIVIL AND STRUCTURAL DRAWINGS.
- REFER TO ROOM LAYOUT SHEET FOR EXTENT OF WORK INCLUDING GLAZED DOOR AND TO REFER FOR ALL FURNITURE SETOUT
- REFER TO OUTLINE SPECIFICATION & SCHEDULE FOR FF&E AND FINISHES
- CONTRACTORS TO CONFIRM DIMENSIONS ON SITE
- INSTALL HEARING AUGMENTATION SYSTEM AS PER NOC REQUIREMENT
- ALLOW FOR PENETRATIONS AS REQUIRED. ENSURE FIRE SEPARATION IS PROVIDED AS REQUIRED.
- ALLOW FOR INSULATION INSTALLATION TO FLOOR ABOVE AND BELOW. MAKE GOOD AS REQUIRED.
- DOOR NOTES
 - TOILET DOORS TO HAVE CARD SWIPE ACCESS OUTSIDE OF OPERATING HOURS. CONFIRM WITH CQU.
 - REFER TO MECHANICAL DRAWINGS FOR GRILLE AND UNDERCUT
 - ALL SERVICE DOORS TO HAVE SMOKE SEALS
 - DOOR FUNCTION AND HARDWARE TO BE IN ACCORDANCE TO CQU GUIDELINES.
 - DOORS TO HAVE 300mm HIGH STAINLESS STEEL KICKPLATE, UNLESS SPECIFIED.
 - ENSURE DOORS TO HAVE DOOR CLOSER & STOPS, WHICH COMPLIES WITH AS 1428.1
 - EXTERNAL DOORS TO BE MANUALLY OPERATED, OPENING OUTWARDS. ENSURE THIS COMPLIES WITH AS 1428.1
 - FIRE RATED DOORS TO HAVE PUSH BAR FOR EXIT.
 - SINGLE SWING DOORS FOR CIRCULATION ACCESS TO BE 920MM WIDE, UNLESS SPECIFIED
 - ALL EXTERNAL DOORS, LECTURE THEATRE DOORS, PLANT ROOMS, TOILET DOORS, FIRES DOORS AND EMERGENCY EXIT TO HAVE AUTO-CLOSER DOORS
 - CQU TO CONFIRM SECURITY ACCESS REQUIREMENT TO OFFICES AND CLASSROOMS
 - EXTERNALLY LOCKED DOORS TO HAVE STRIKER PLATE PROTECTION INSTALLED
 - PROVIDE DOOR CLOSERS TO ALL DOORS ENCLOSING AIR-CONDITIONED SPACES

GENERAL

- REFER TO SECTION J REPORT FOR THE REQUIRED INSULATION REQUIREMENTS
- REFER TO CERTIFIER'S COMMENT FOR FRL REQUIREMENT

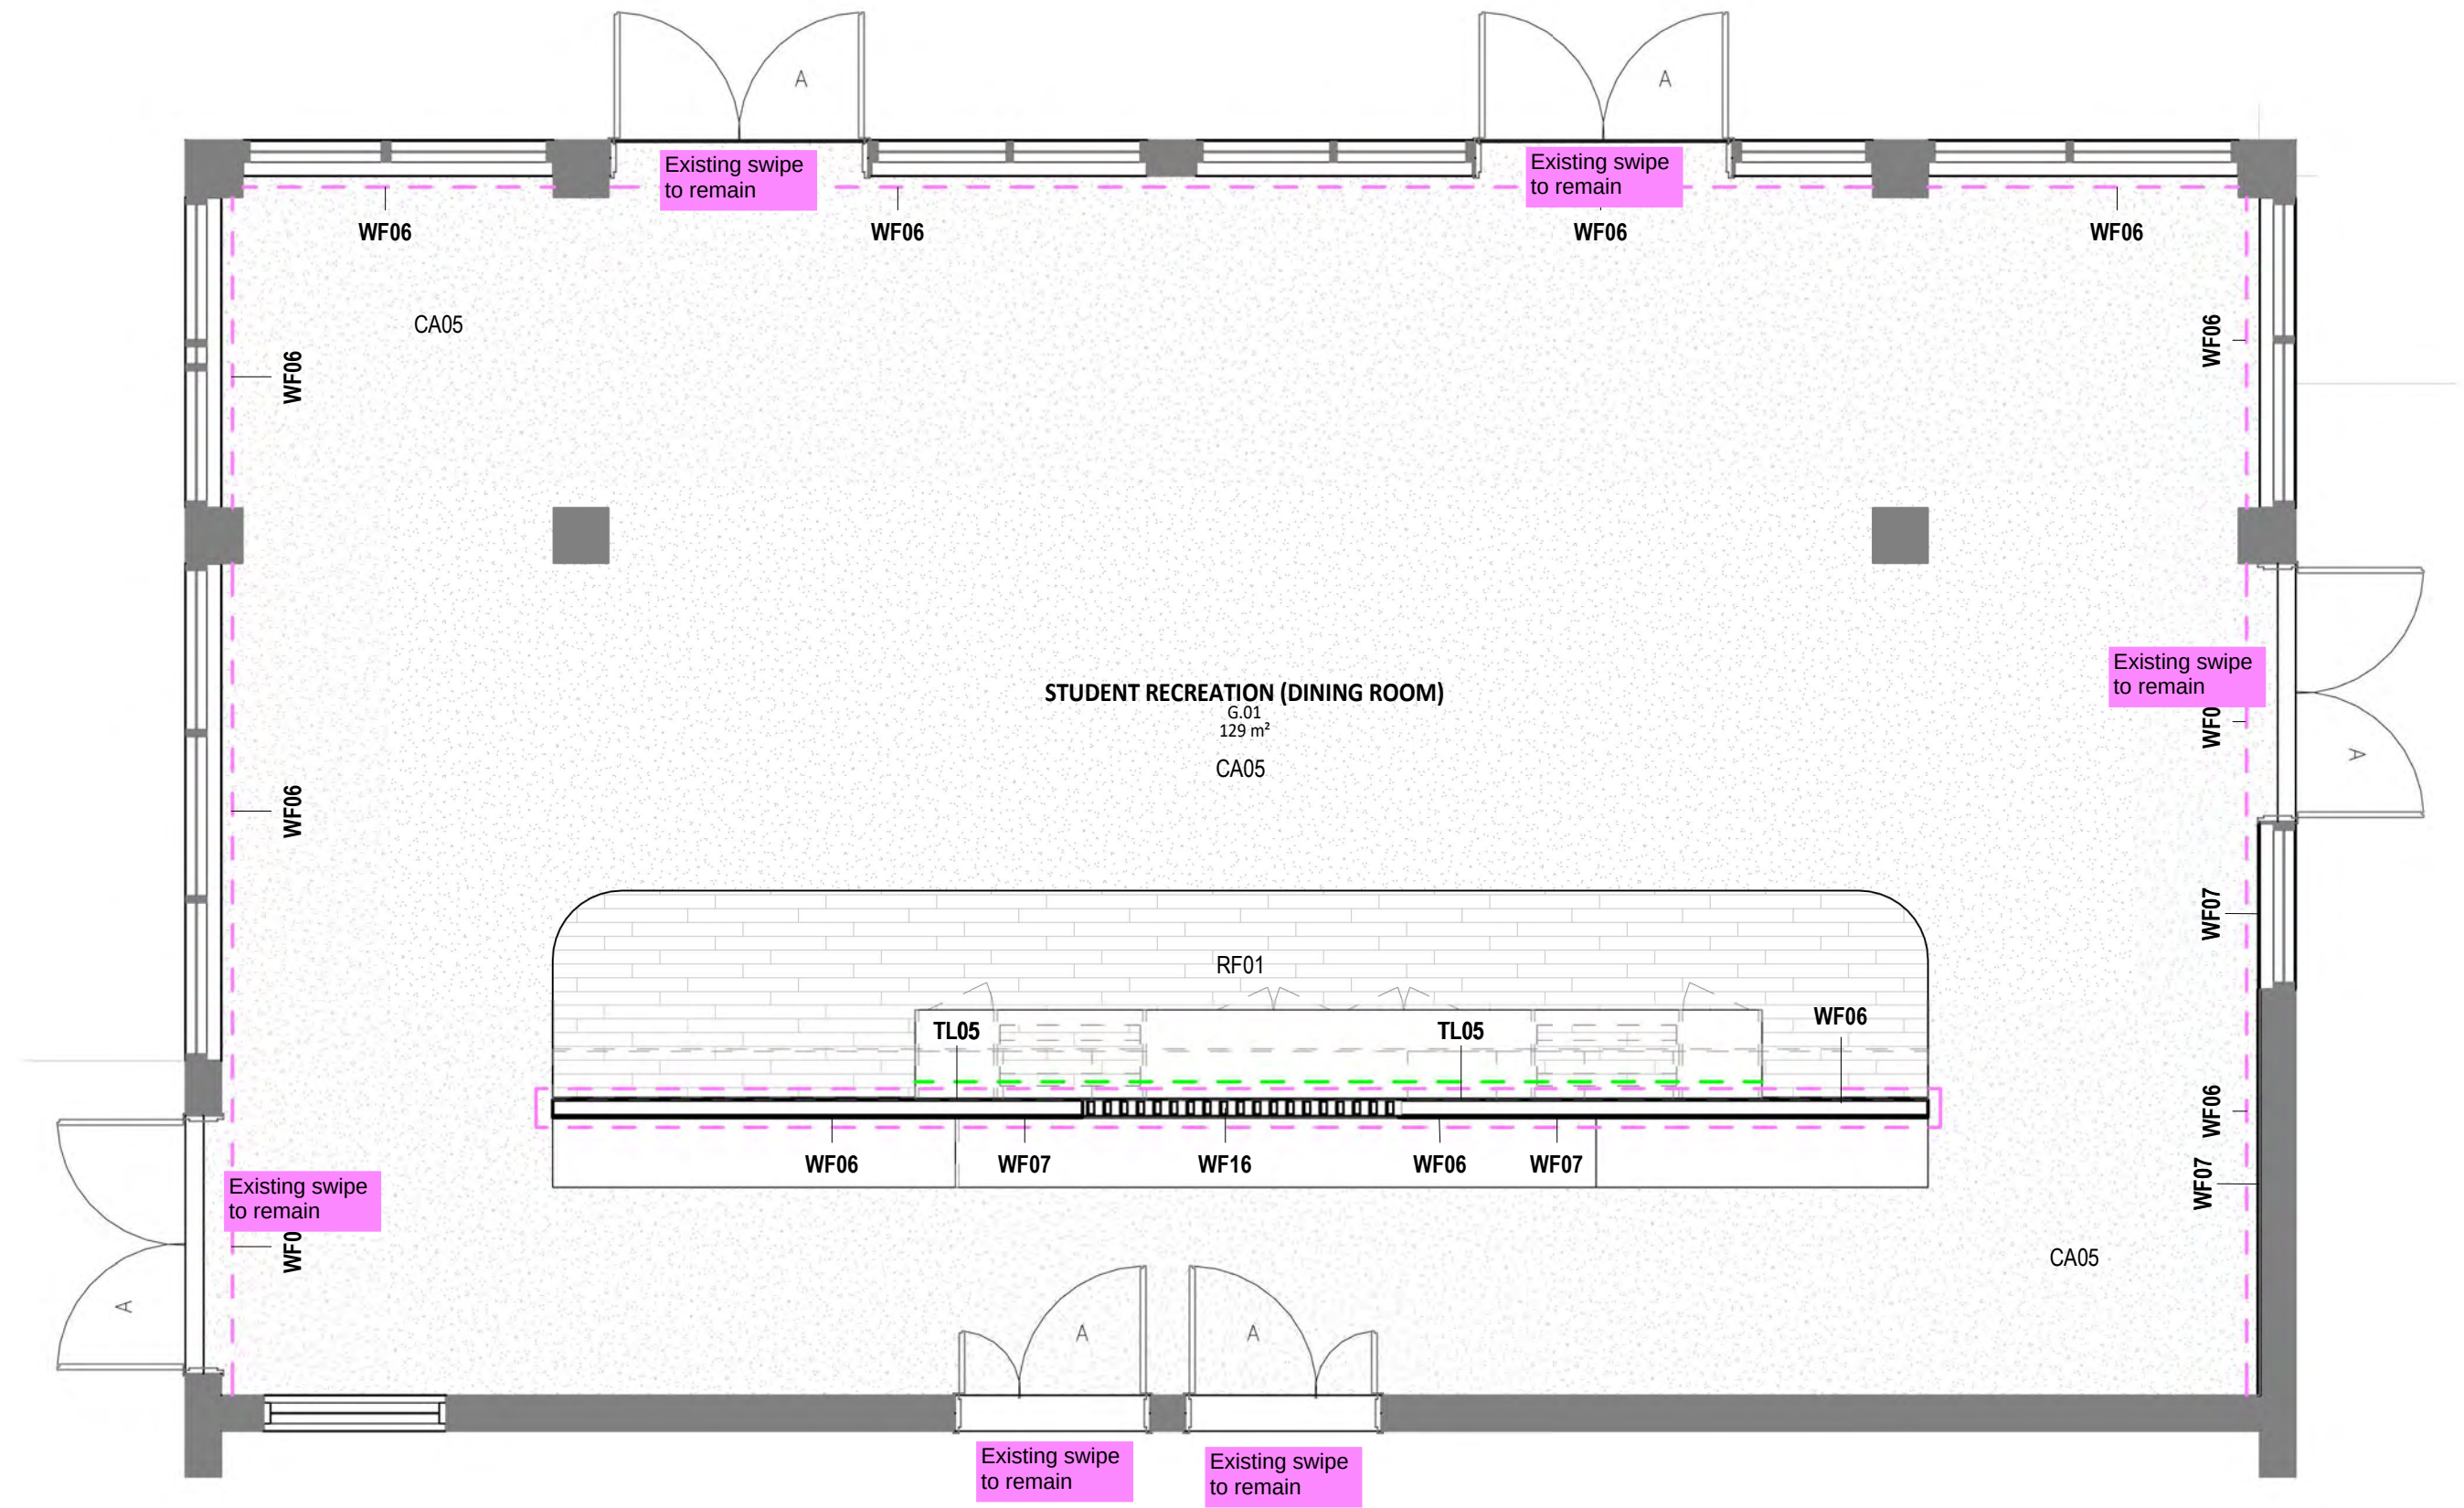

GENERAL NOTES:

- THIS DRAWING IS TO BE READ IN CONJUNCTION WITH ALL PROJECT DRAWINGS, SCHEDULES AND SPECIFICATIONS, PLUS ALL OTHER RELEVANT CONSULTANT DOCUMENTS.
- ALL WORKS TO COMPLY WITH BCA AND AUSTRALIAN STANDARDS.
- ANY DISCREPANCIES ON THE DRAWINGS OR IRREGULARITIES BETWEEN INFORMATION SHOWN ON INTERIOR DRAWINGS AND SERVICES CONSULTANTS DOCUMENTS ARE TO BE REFERRED TO THE DESIGNER FOR CLARIFICATION PRIOR TO THE WORKS PROCEEDING.
- ALL DIMENSIONS AND AREAS PROVIDED TO BE CONFIRMED ON SITE PRIOR TO COMMENCEMENT OF WORKS

FINISHES NOTES:

- ALL JUNCTIONS IN FLOOR FINISHES TO BE FLUSH.
- CHANGES TO FLOOR FINISH TO OCCUR UNDER THE CENTRE LINE OF THE DOOR LEAF UNLESS NOTED OTHERWISE.
- ALL WALLS TO BE PA01 UNLESS OTHERWISE NOTED.
- ALL SOLID CORE DOORS TO BE PA11 UNLESS OTHERWISE NOTED.
- REFER 60 SERIES DRAWINGS & SCH-INT-01 INTERIOR FINISHES SCHEDULE FOR SKIRTING TYPES AND SPECIFICATION. ALL WALLS TO RECEIVE SK01 SKIRTING UNLESS NOTED OTHERWISE.
- NEW SKIRTING TO MATCH EXISTING WHERE RELEVANT.
- ALL DOOR STATUTORY SIGNAGE AND ROOM SIGNAGE TO BE REMOVED BEFORE PAINTING.
- ALL WINDOW FURNISHING TO BE REMOVED BEFORE PAINTING, CLEANED AND REINSTALLED.
- FLOOR FINISHES TO CONTINUE UNDER NEW JOINERY.

FINISHES LEGEND

REFER SCH-INT-01 FINISHES SCHEDULE AND 60 SERIES DRAWINGS FOR FURTHER DETAILS AND SPECIFICATION

- PA## FEATURE WALL PAINT
- TL## WALL TILE
- WF## WALL FINISH
- CA## CARPET FLOOR FINISH
- RF## RESILIENT FLOOR FINISH
- TL## TILE FLOOR FINISH

ISSUE FOR TENDER

FINISHES PLAN - BLD34-GL

scale As indicated @ A1
revision A
project no. 260018
sheet no. CQU-ROK-034-GN-ARC-28-01

© Copyright
These drawings and designs and the copyright thereof are the property of Thomson Adsett Pty Ltd and must not be used, retained or copied without written permission of Thomson Adsett Pty Ltd. ABN 76 105 314 654 Trading as ThomsonAdsett. Dimensions take precedence over scaling. Do not measure off drawings as print sizes may vary

CQU ROCKHAMPTON
TAFE
CONSOLIDATION -
STAGE 2
ROCKHAMPTON, QUEENSLAND



A	12/02/26	ISSUED FOR TENDER	SM
1	30/01/26	60% DRAFT ISSUE	SM

rev	date	details	init.
-----	------	---------	-------

drawn	date
TA/PT	27/01/26
checked	date
SZ	27/01/26
verified	date
	27/01/26

scale

CQU ROCKHAMPTON TAFE CONSOLIDATION - STAGE 2


554/700 Yaamba Rd, Norman
Gardens QLD 4701



B	2026-03-05	UPDATED ISSUED FOR TENDER	BC
A	2026-02-12	ISSUED FOR TENDER	BC
4	2026-01-30	60% DRAFT ISSUE	BC
3	2026-01-23	CONSULTANTS ISSUE	BC
2	2025-12-19	UPDATED ISSUE	BC
1	2025-12-17	CONSULTANTS REVIEW	BC

rev	date	details	init.
-----	------	---------	-------

drawn	date
JS/BC	19/01/2026
checked	date
SS	12/02/2026
verified	date

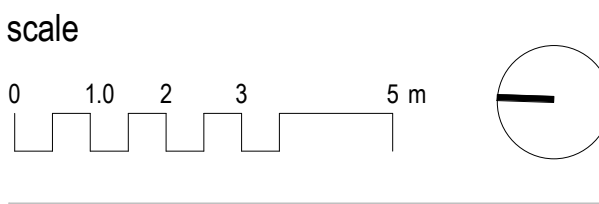


FLOOR PLAN - GROUND FLOOR - PROPOSED

scale
1 : 100 @ A1

project no.
25.0236.17

revision
B

sheet no.
CQU-ROK-036-GN-ARC-21-01

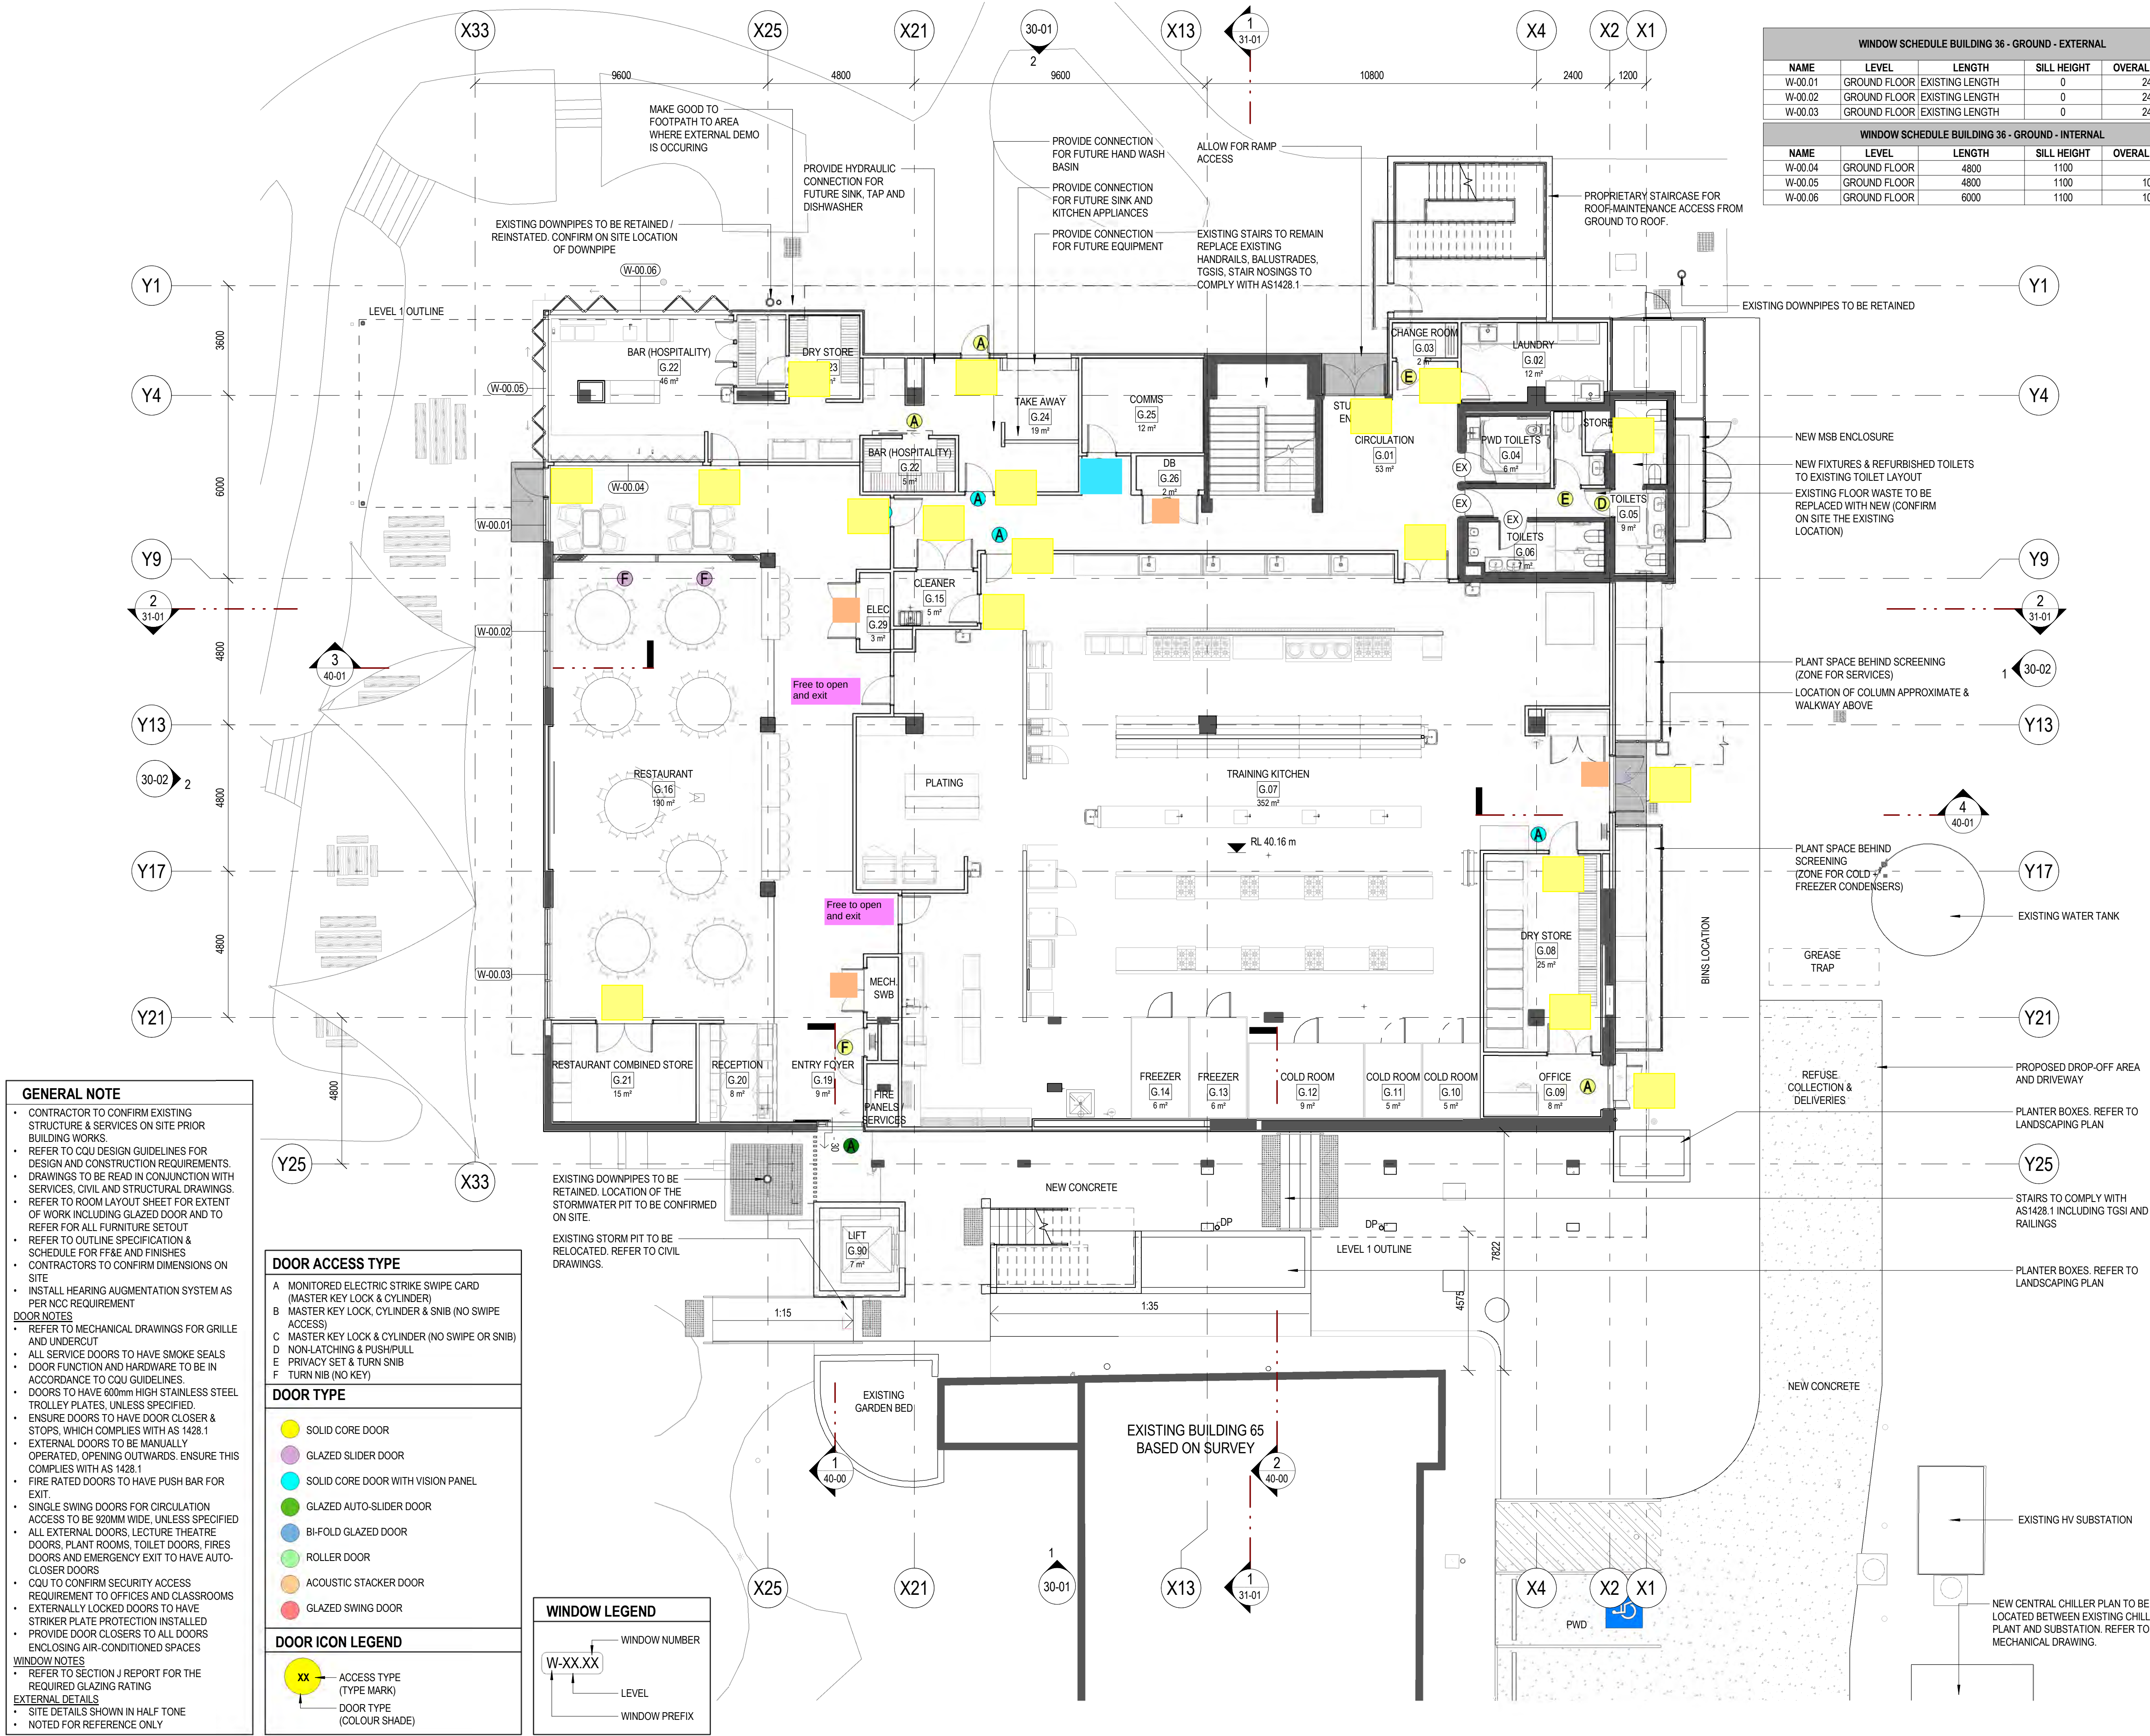

ISSUED FOR TENDER

CQU ROCKHAMPTON TAFE CONSOLIDATION - STAGE 2

554/700 Yaamba Rd, Norman
Gardens QLD 4701

for



CQUniversity
AUSTRALIA

B	2026-03-05	UPDATED ISSUED FOR TENDER	BC
A	2026-02-12	ISSUED FOR TENDER	BC
4	2026-01-30	60% DRAFT ISSUE	BC
3	2026-01-23	CONSULTANTS ISSUE	BC
2	2025-12-19	UPDATED ISSUE	BC
1	2025-12-17	CONSULTANTS REVIEW	BC

rev	date	details	init.
-----	------	---------	-------

drawn	date
JS/BC	19/01/2026
checked	date
SS	12/02/2026
verified	date

scale

The scale bar shows a horizontal line with vertical ticks at 0, 1.0, 2, 3, and 5 m. The distance between 0 and 1.0 is the same as between 1.0 and 2, 2 and 3, and 3 and 5. To the right of the scale bar is a circle with a horizontal line segment inside, representing a radius. The length of this radius is equal to the distance between 0 and 1.0 on the scale bar.

**FLOOR PLAN - LEVEL 1 -
PROPOSED**


scale	project no.
1 : 100 @ A1	25.0236.17


B

sheet no.

CQU-ROK-036-01-ARC-21-02

original sheet size - A1 (594mm x 841mm)

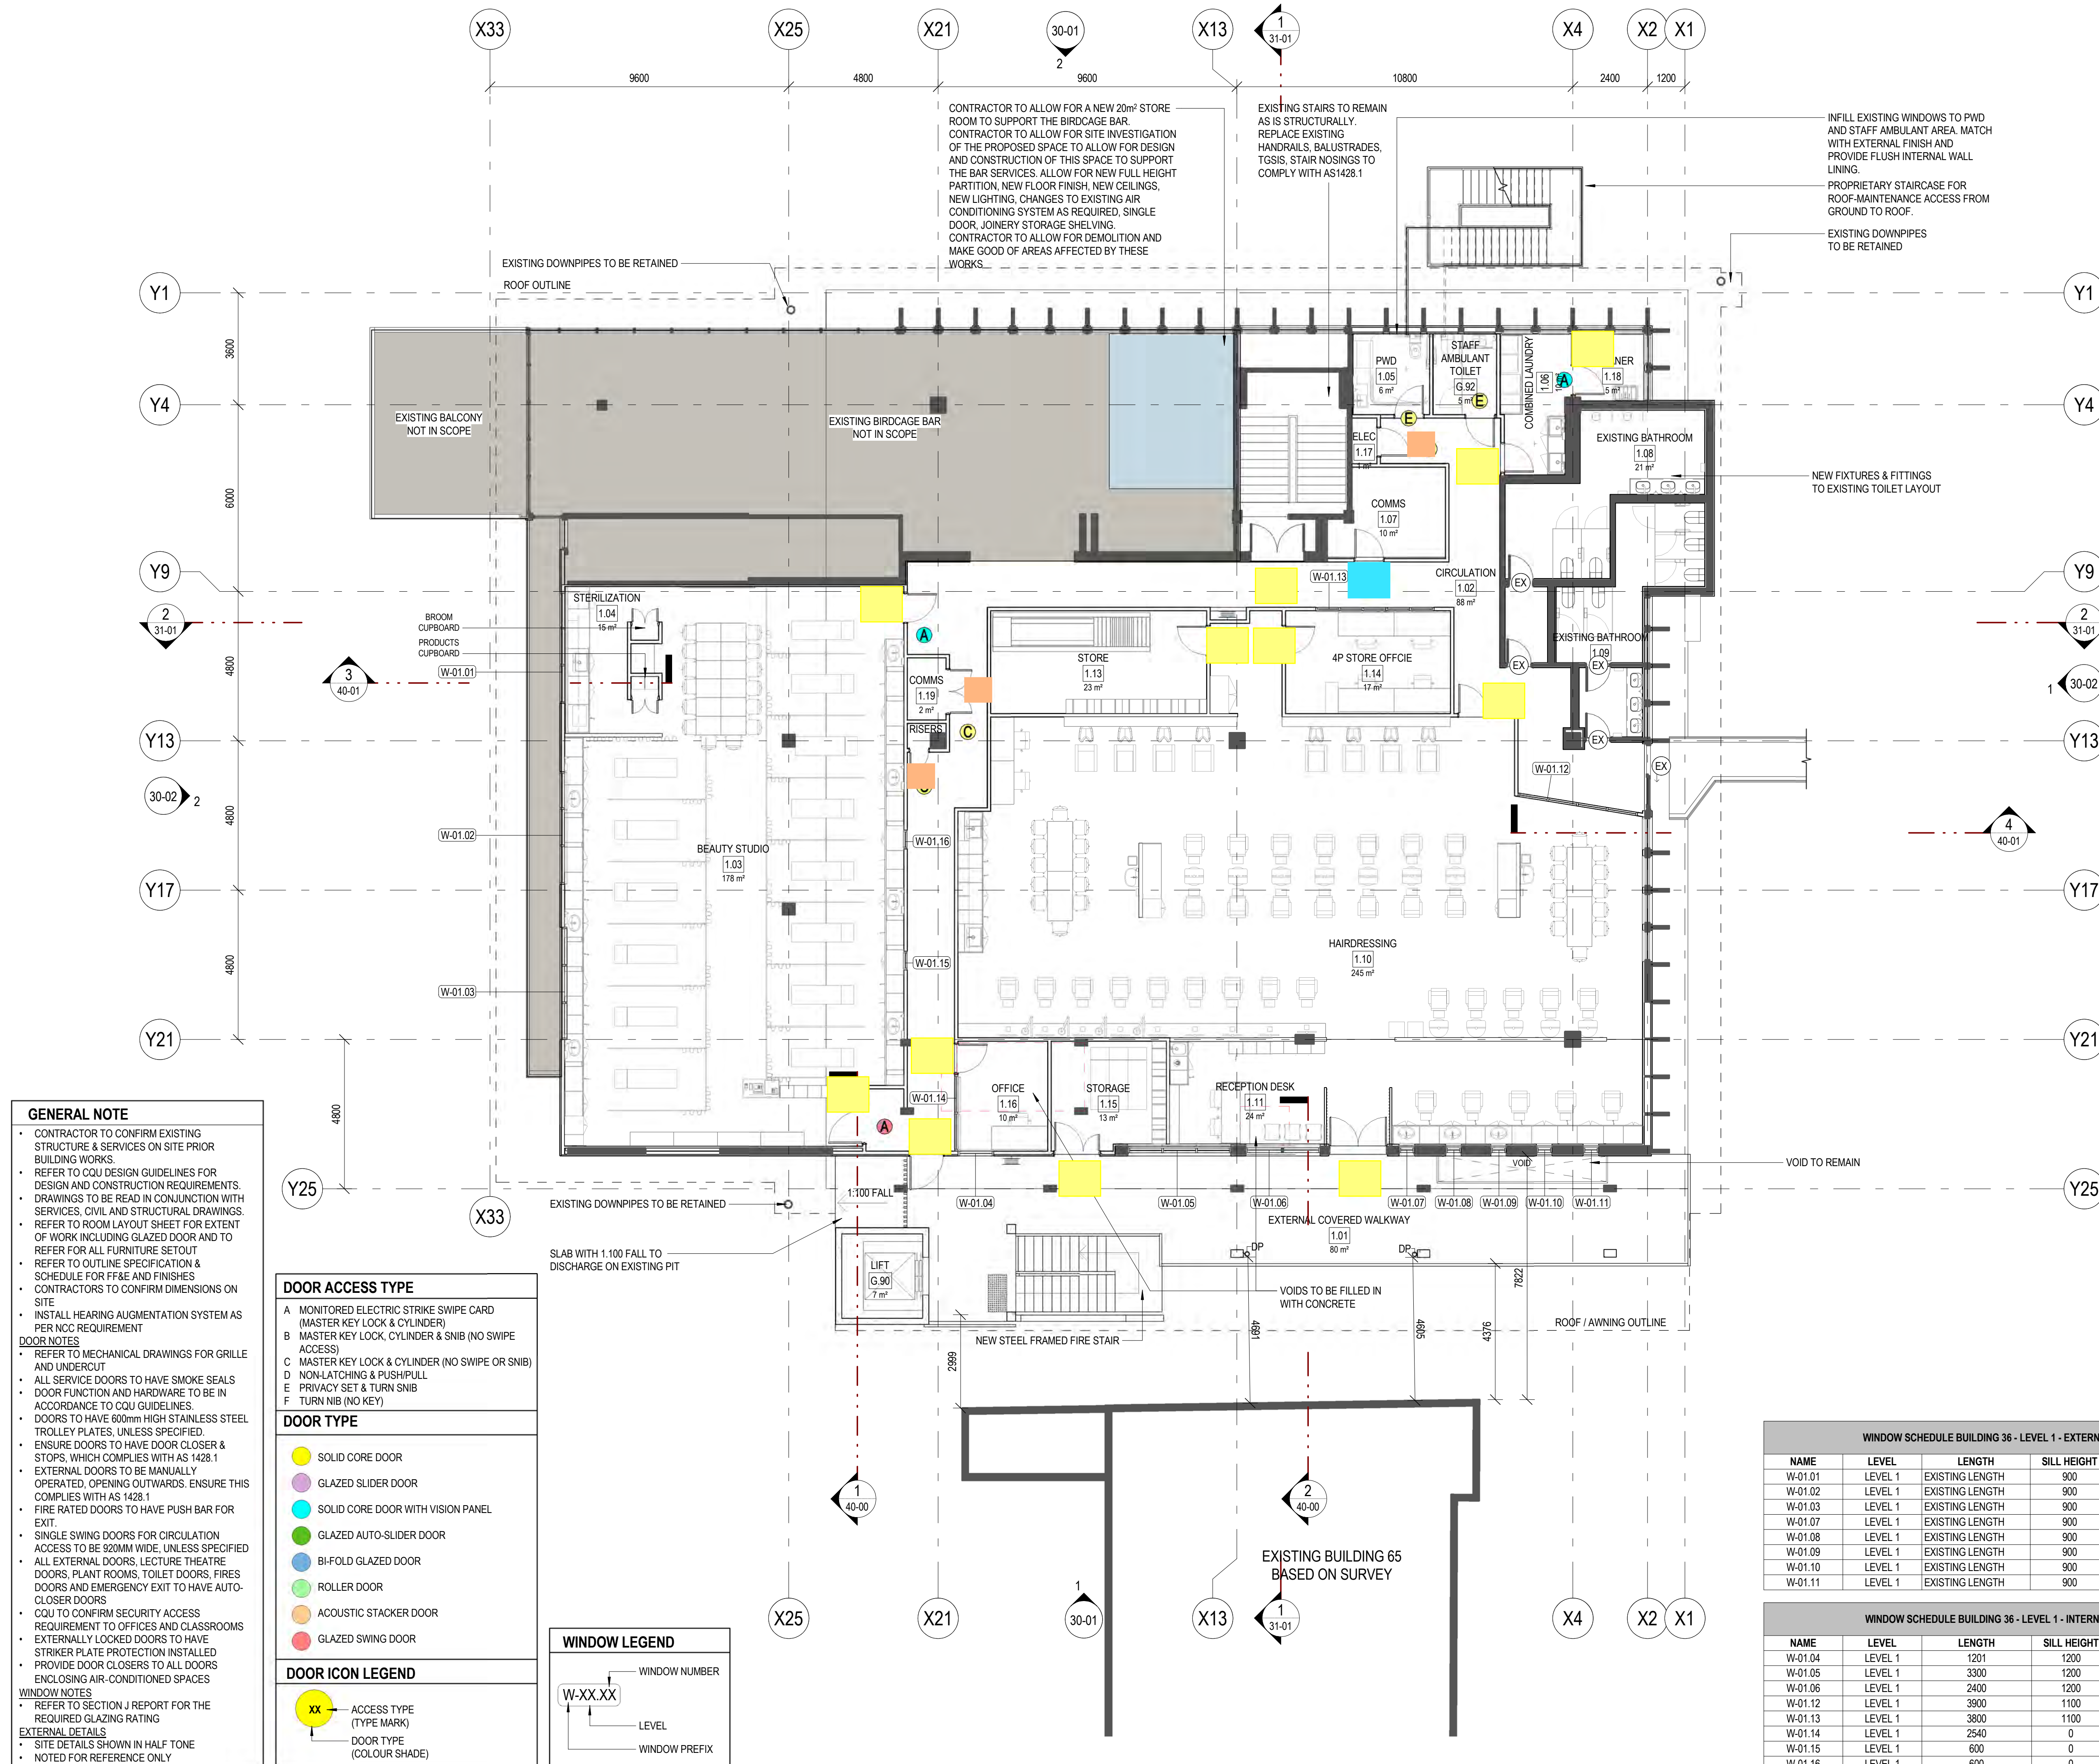

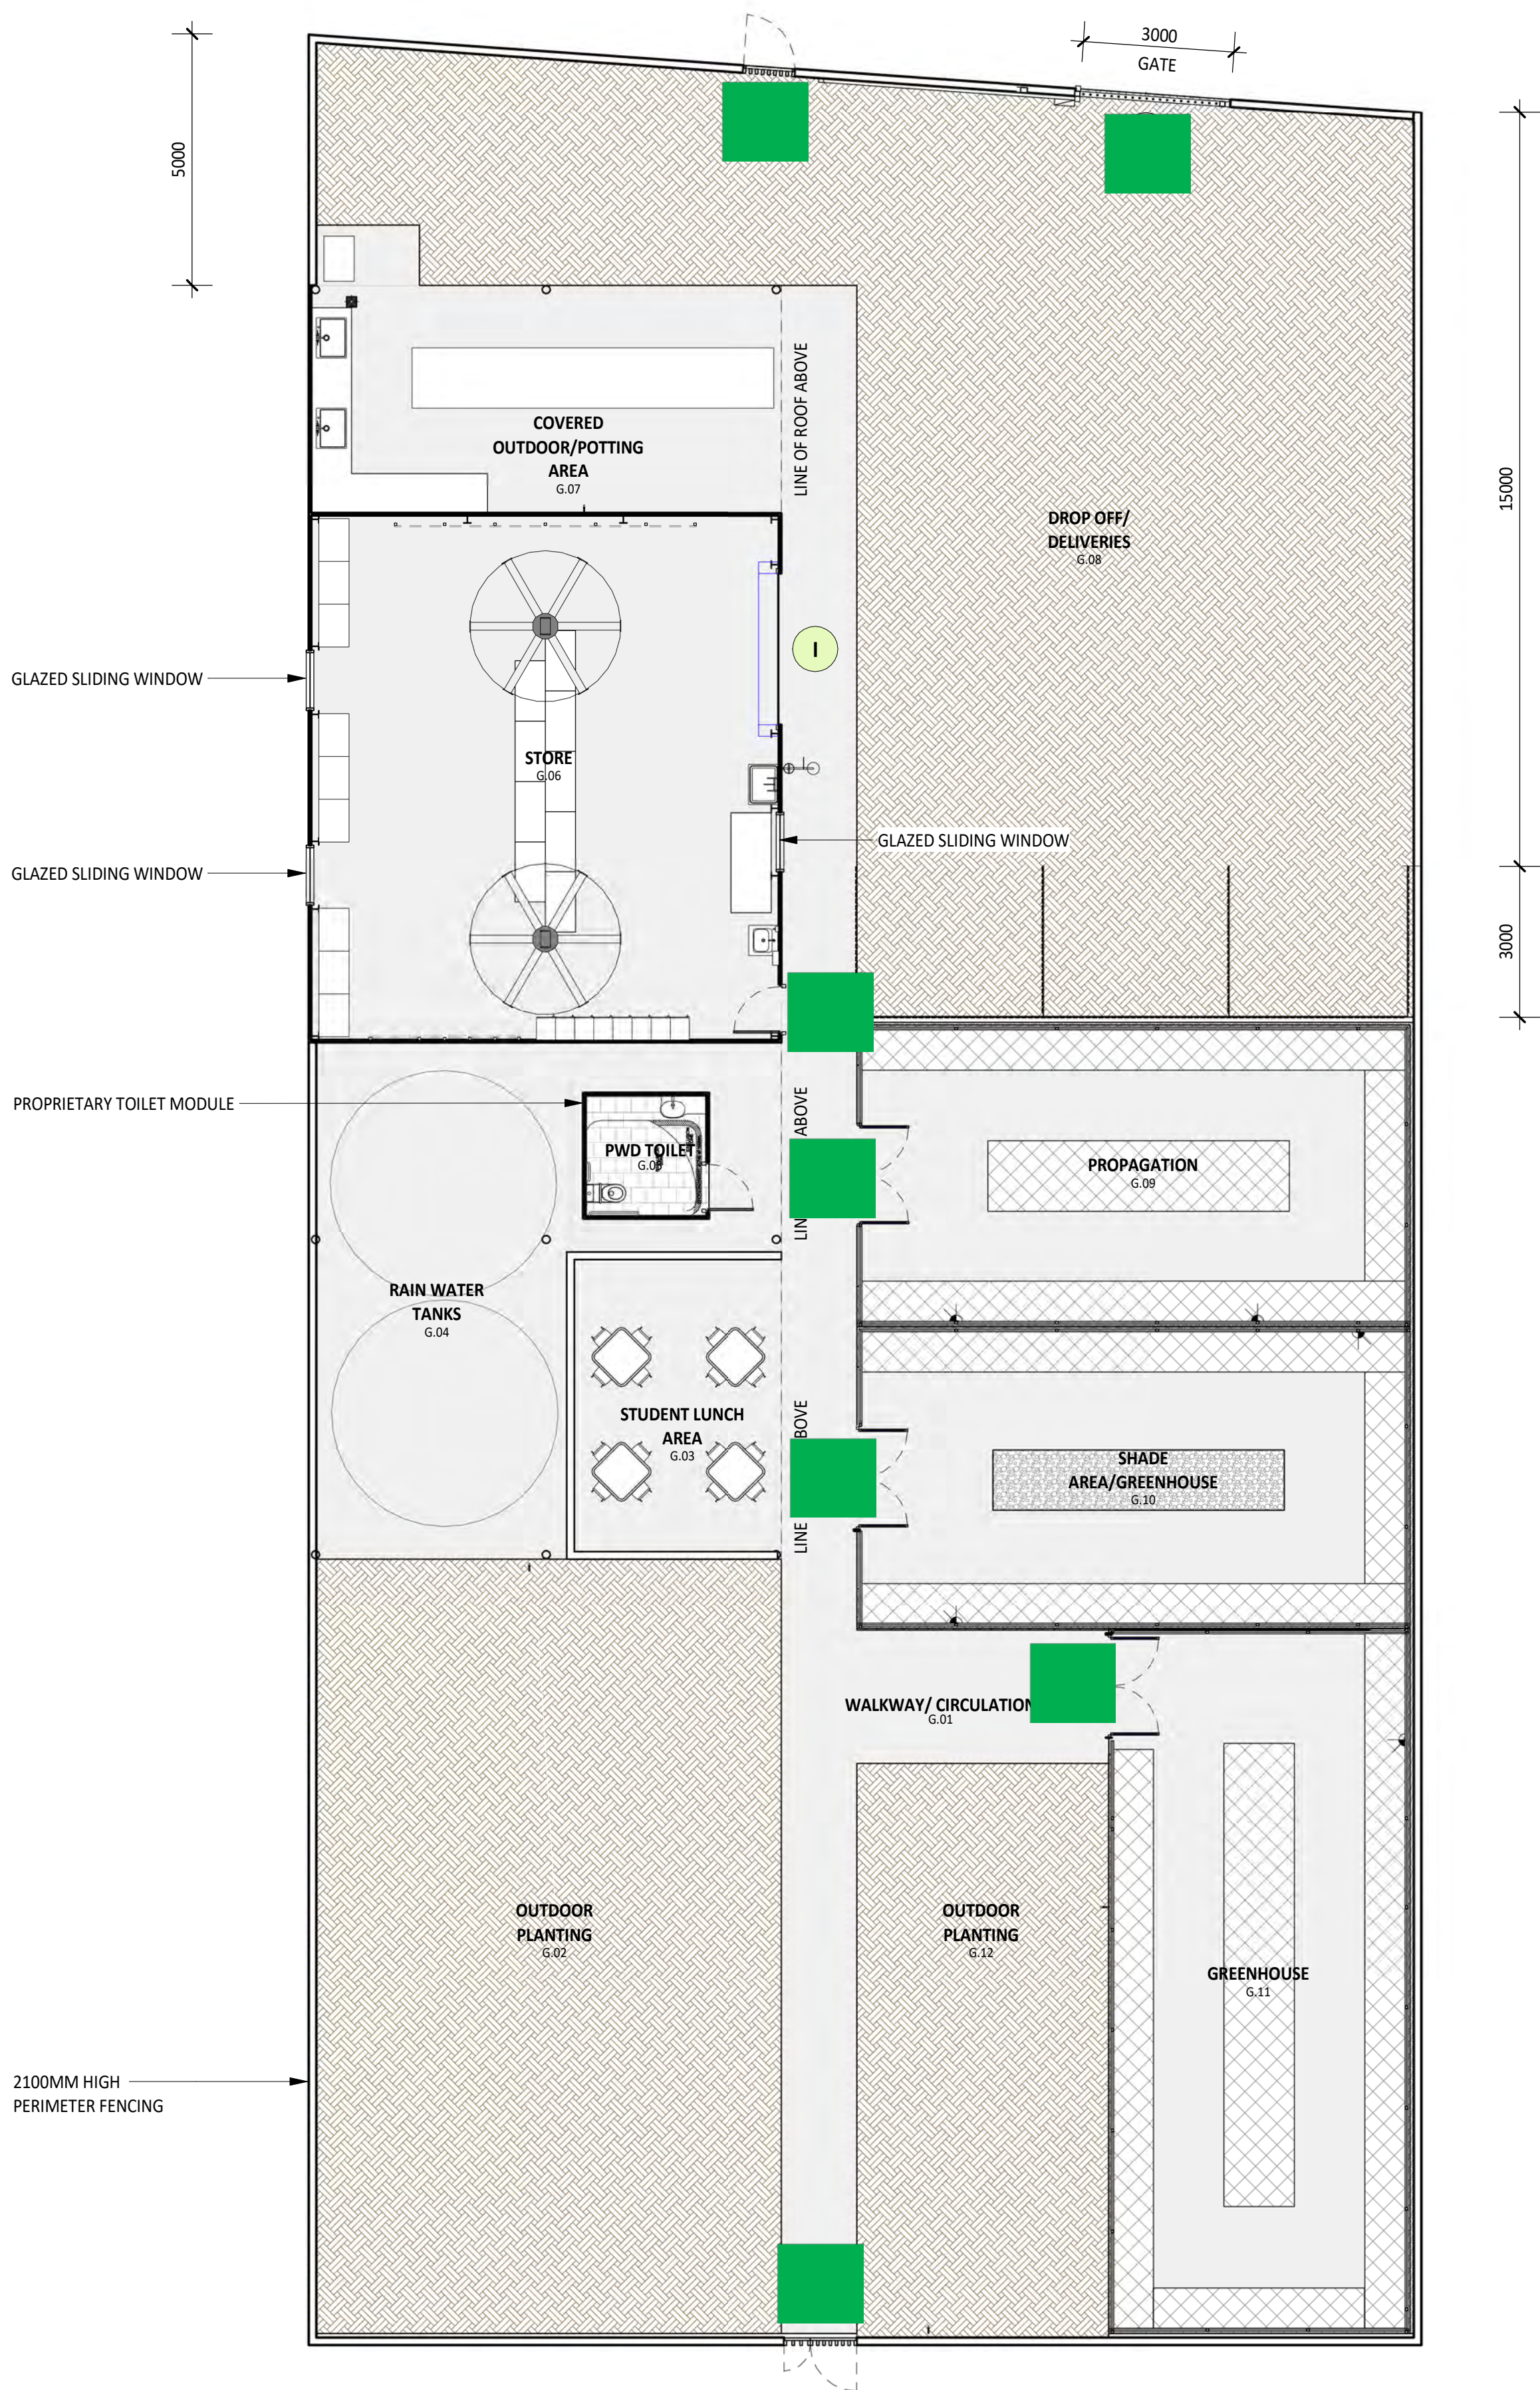

ACCESS TYPE	
A	CARD READER ACCESS
B	TURN SNIB (NO KEY)
C	PRIVACY SET & TURN SNIB
D	MORTICE LOCK & KEY CYLINDER
E	ROLLER DOOR LOCK
F	LEVER WITH COMPRESSION LOCKING MECHANISM
G	FREE LEVER ACCESS
H	PUSH & PULL ACCESS
I	ROLLER LATCH
J	FREE LEVER EGRESS
S	ROLLER SHUTTER INCLUDES SAFETY CHAIN TO BE HUNG WHEN SHUTTER IS HELD OPEN

DOOR TYPE	
XX	SOLID CORE DOOR
XX	GLAZED SLIDER DOOR
XX	VISION PANEL
XX	AUTO-SLIDER DOOR
XX	GLAZED-SACKER DOOR
XX	BIFOLD DOOR
XX	ROLLER DOOR
XX	ACOUSTIC STACKER DOOR
XX	GLAZED SWING DOOR
XX	SWING GATE
XX	SLIDING GATE - AUTOMATIC OPERATION
ALL DOORS TO HAVE MONITORED ELECTRIC STRIKE SWIPE CARD ACCESS, PLUS MASTERKEY LOCK AND CYLINDER. EXCEPTIONS ARE - MEETING ROOM DOORS - INCLUDE MASTERKEY LOCK AND CYLINDER, PLUS SNIB - NO SWIPE. ELECTRICAL CUPBOARDS - INCLUDE MASTERKEY LOCK AND CYLINDER - NO SWIPE OR SNIB	

ICON LEGEND	
XX	ACCESS TYPE (TYPE MARK)
	DOOR TYPE (COLOUR SHADE)

GENERAL NOTE	
- REFER TO MECHANICAL DRAWINGS FOR GRILLE AND UNDERCUT - ALL SERVICE DOORS TO HAVE SMOKE SEALS - FOR GLAZED DOORS REFER TO ROOM LAYOUT SHEET FOR EXTENT, WHICH NOTES SAFETY VISUAL GLAZING / PRIVACY SCREENING. - DOOR FUNCTION AND HARDWARE TO BE IN ACCORDANCE TO CQU GUIDELINES. - ANY DOOR ACCESS TO BATHROOM TO HAVE STAINLESS STEEL KICKPLATE - ALLOW FOR DOOR CLOSERS AND DOOR STOPS TO DOORS - EXTERNAL DOORS TO BE MANUALLY OPERATED, OPENING OUTWARDS. ENSURE THIS COMPLIES WITH AS 1428.1 - FIRE RATED DOORS TO HAVE PUSH BAR FOR EXIT. - SINGLE SWING DOORS FOR CIRCULATION ACCESS TO BE 920MM WIDE, UNLESS SPECIFIED - ALL EXTERNAL DOORS, LECTURE THEATRE DOORS, PLANT ROOMS, TOILET DOORS, FIRES DOORS AND EMERGENCY EXIT TO HAVE AUTO-CLOSER DOORS - CQU TO CONFIRM ACCESS REQUIREMENT TO OFFICES AND CLASSROOMS - EXTERNALLY LOCKED DOORS TO HAVE STRIKER PLATE PROTECTION INSTALLED - REFER TO CQU DESIGN GUIDELINES FOR DESIGN AND CONSTRUCTION REQUIREMENTS. - REFER TO ROOM LAYOUT SHEET FOR EXTENT OF WORK. - DRAWINGS TO BE READ IN CONJUNCTION WITH SERVICES, CIVIL AND STRUCTURAL DRAWINGS. - ALL EXTERNAL DOORS TO HAVE REED SWITCH	

ISSUED FOR TENDER

HORTICULTURE FLOOR PLAN	
scale	project no.
1 : 100 @ A1	260018
revision	
A	
sheet no.	
CQU-ROK-076-GN-ARC-21-00	

CQU ROCKHAMPTON TAFE

554/700 Yaamba Rd, Norman Gardens QLD 4701




for

A	12/02/26	ISSUED FOR TENDER	BS
4	30/01/26	DRAFT 60% ISSUE	BS
3	23/01/25	COORDINATION ISSUE FOR CONSULTANTS	KM
2	19/12/25	ISSUED FOR COORDINATION	KM
1	16/12/25	FROZEN ISSUE	KM
rev	date	details	init.

drawn	date
PT	19/12/25
checked	date
BS	19/12/25
verified	date
BS	19/12/25



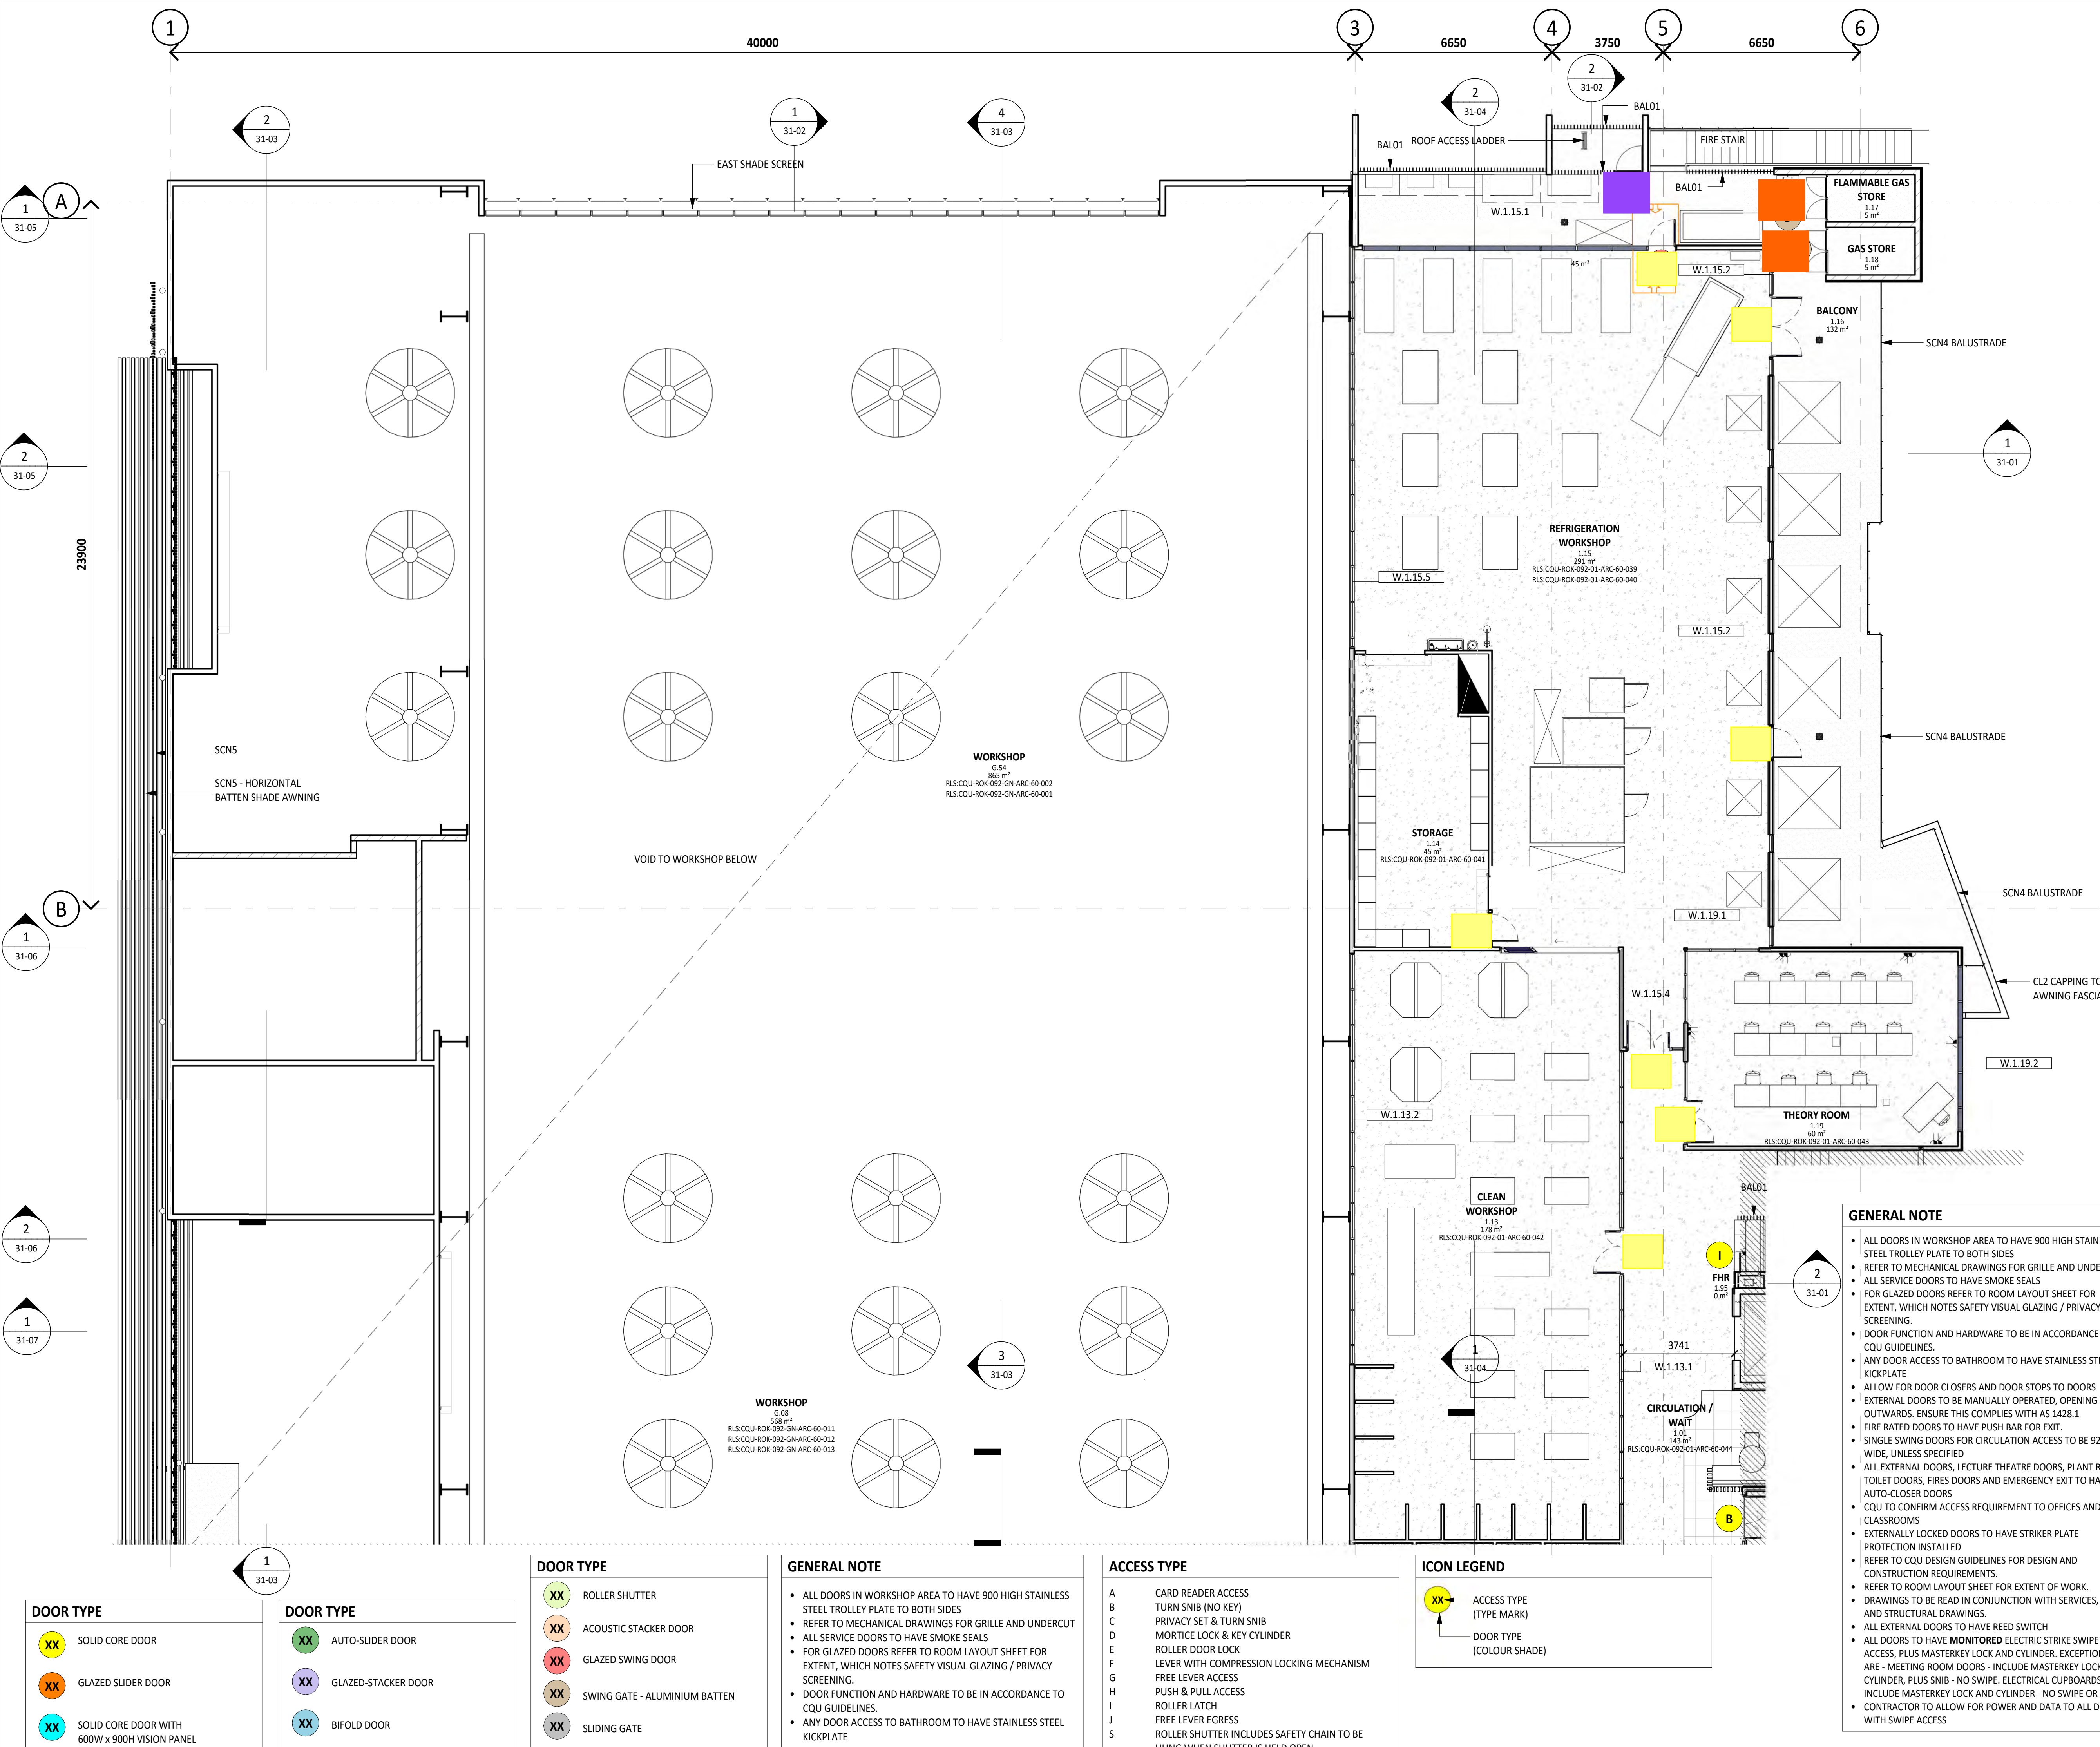

CQU ROCKHAMPTON TAFE CONSOLIDATION - STAGE 2

554/700 Yaamba Rd, Norman
Gardens QLD 4701



A	12/02/26	ISSUED FOR TENDER	BS
3	30/01/26	DRAFT 60% ISSUE	BS
2	23/01/26	COORDINATION ISSUE FOR CONSULTANTS	BS
1	19/12/25	ISSUE FOR COORDINATION	BS

drawn	date
PT	19/12/25
checked	date
use 'Approved By' only	19/12/25
verified	date
BS	19/12/25

scale

FLOOR PLAN LEVEL 01 - ZONE 1

scale project no.

1 : 100 @ A1 260018

revision

A

sheet no.

CQU-ROK-092-01-ARC-21-11

original sheet size - A1 (594mm x 841mm)

ISSUED FOR TENDER

12/02/2026 4:37:31 PM Autodesk Docs: CQU ROK TAFE 260018_A_CQU-UNIVERSITY_BLD-TRADES_R25.rvt

CQU ROCKHAMPTON TAFE CONSOLIDATION - STAGE 2

554/700 Yaamba Rd, Norman
Gardens QLD 4701



A	12/02/26	ISSUED FOR TENDER	BS
3	30/01/26	DRAFT 60% ISSUE	BS
2	23/01/26	COORDINATION ISSUE FOR CONSULTANTS	BS
1	19/12/25	ISSUE FOR COORDINATION	BS
rev	date	details	init.

drawn	date
PT	19/12/25
checked	date
Checker	19/12/25
verified	date
BS	19/12/25

scale

1

FLOOR PLAN LEVEL 01 - ZONE 2

scale project no.
1 : 100 @ A1 260018

revision
A

sheet no.
CQU-ROK-092-01-ARC-21-12

original sheet size - A1 (594mm x 841mm)

ISSUED FOR TENDER

12/02/2026 4:41:28 PM Autodesk Docs: CQU ROCK TAFE260018_A_CQU-UNIVERSITY_BLD-TRADES_R25.rvt



GENERAL NOTE

- ALL DOORS IN WORKSHOP AREA TO HAVE 900 HIGH STAINLESS STEEL TROLLEY PLATE TO BOTH SIDES
- REFER TO MECHANICAL DRAWINGS FOR GRILLE AND UNDERCUT
- ALL SERVICE DOORS TO HAVE SMOKE SEALS
- FOR GLAZED DOORS REFER TO ROOM LAYOUT SHEET FOR EXTENT, WHICH NOTES SAFETY VISUAL GLAZING / PRIVACY SCREENING.
- DOOR FUNCTION AND HARDWARE TO BE IN ACCORDANCE TO CQU GUIDELINES.
- ANY DOOR ACCESS TO BATHROOM TO HAVE STAINLESS STEEL KICKPLATE
- ALLOW FOR DOOR CLOSERS AND DOOR STOPS TO DOORS
- EXTERNAL DOORS TO BE MANUALLY OPERATED, OPENING OUTWARDS. ENSURE THIS COMPLIES WITH AS 1428.1
- FIRE RATED DOORS TO HAVE PUSH BAR FOR EXIT.

GENERAL NOTE

- SINGLE SWING DOORS FOR CIRCULATION ACCESS TO BE 920MM WIDE, UNLESS SPECIFIED
- ALL EXTERNAL DOORS, LECTURE THEATRE DOORS, PLANT ROOMS, TOILET DOORS, FIRES DOORS AND EMERGENCY EXIT TO HAVE AUTO-CLOSER DOORS
- CQU TO CONFIRM ACCESS REQUIREMENT TO OFFICES AND CLASSROOMS
- EXTERNALLY LOCKED DOORS TO HAVE STRIKER PLATE PROTECTION INSTALLED
- REFER TO CQU DESIGN GUIDELINES FOR DESIGN AND CONSTRUCTION REQUIREMENTS.
- REFER TO ROOM LAYOUT SHEET FOR EXTENT OF WORK.
- DRAWINGS TO BE READ IN CONJUNCTION WITH SERVICES, CIVIL AND STRUCTURAL DRAWINGS.
- ALL EXTERNAL DOORS TO HAVE REED SWITCH
- ALL DOORS TO HAVE **MONITORED** ELECTRIC STRIKE SWIPE CARD ACCESS, PLUS MASTERKEY LOCK AND CYLINDER. EXCEPTIONS ARE - MEETING ROOM DOORS - INCLUDE MASTERKEY LOCK AND CYLINDER, PLUS SNIB - NO SWIPE. ELECTRICAL CUPBOARDS - INCLUDE MASTERKEY LOCK AND CYLINDER - NO SWIPE OR SNIB

DOOR TYPE

- XX** BIFOLD DOOR
- XX** ROLLER SHUTTER
- XX** ACOUSTIC STACKER DOOR
- XX** GLAZED SWING DOOR
- XX** SWING GATE - ALUMINIUM BATTEN
- XX** SLIDING GATE

DOOR TYPE

- XX** SOLID CORE DOOR
- XX** GLAZED SLIDER DOOR
- XX** SOLID CORE DOOR WITH 600W x 900H VISION PANEL
- XX** AUTO-SLIDER DOOR
- XX** GLAZED-STACKER DOOR

ACCESS TYPE

- A CARD READER ACCESS
- B TURN SNIB (NO KEY)
- C PRIVACY SET & TURN SNIB
- D MORTICE LOCK & KEY CYLINDER
- E ROLLER DOOR LOCK
- F LEVER WITH COMPRESSION LOCKING MECHANISM
- G FREE LEVER ACCESS
- H PUSH & PULL ACCESS
- I ROLLER LATCH
- J FREE LEVER EGRESS
- S ROLLER SHUTTER INCLUDES SAFETY CHAIN TO BE HUNG WHEN SHUTTER IS HELD OPEN

ICON LEGEND

- XX** ACCESS TYPE (TYPE MARK)
- DOOR TYPE (COLOUR SHADE)

FIRE MANAGEMENT LEGEND

- FIRE RATED WALL - REFER TO PARTITION DETAILS FOR MORE INFO
- SMOKE COMPARTMENT WALL
- PLANS TO BE PRINTED IN COLOUR

**CQU ROCKHAMPTON
TAFE
CONSOLIDATION -
STAGE 2**554/700 Yaamba Rd, Norman
Gardens QLD 4701

for



B	05/03/26	ISSUED FOR TENDER	BS
A	12/02/26	ISSUED FOR TENDER	BS
3	30/01/26	DRAFT 60% ISSUE	BS
2	23/01/26	COORDINATION ISSUE FOR CONSULTANTS	BS
1	19/12/25	ISSUE FOR COORDINATION	BS
rev	date	details	init.

drawn	date
PT	19/12/25
checked	date
use 'Approved By' only	19/12/25
verified	date
BS	19/12/25

scale



**FLOOR PLAN GROUND
LEVEL - ZONE 1**scale project no.
As indicated @ A1 260018

revision

B
sheet no.
CQU-ROK-092-GN-ARC-21-01

original sheet size - A1 (594mm x 841mm)

ISSUED FOR TENDER

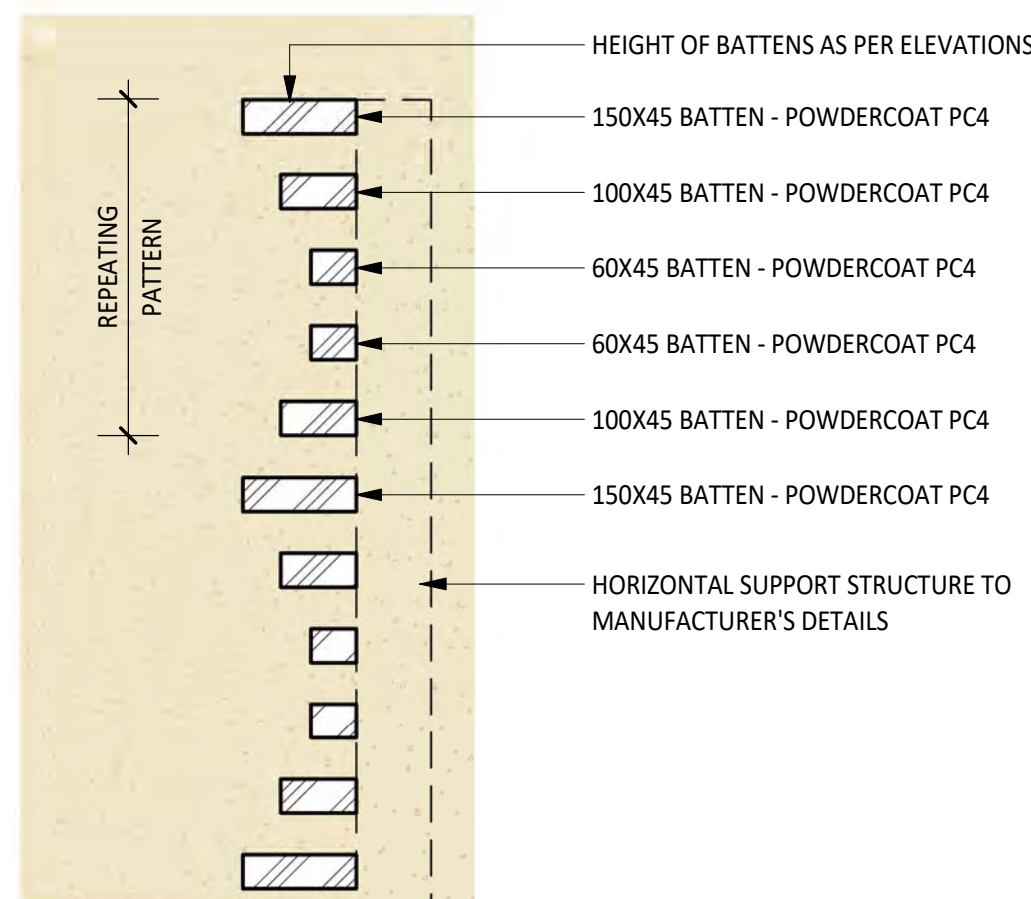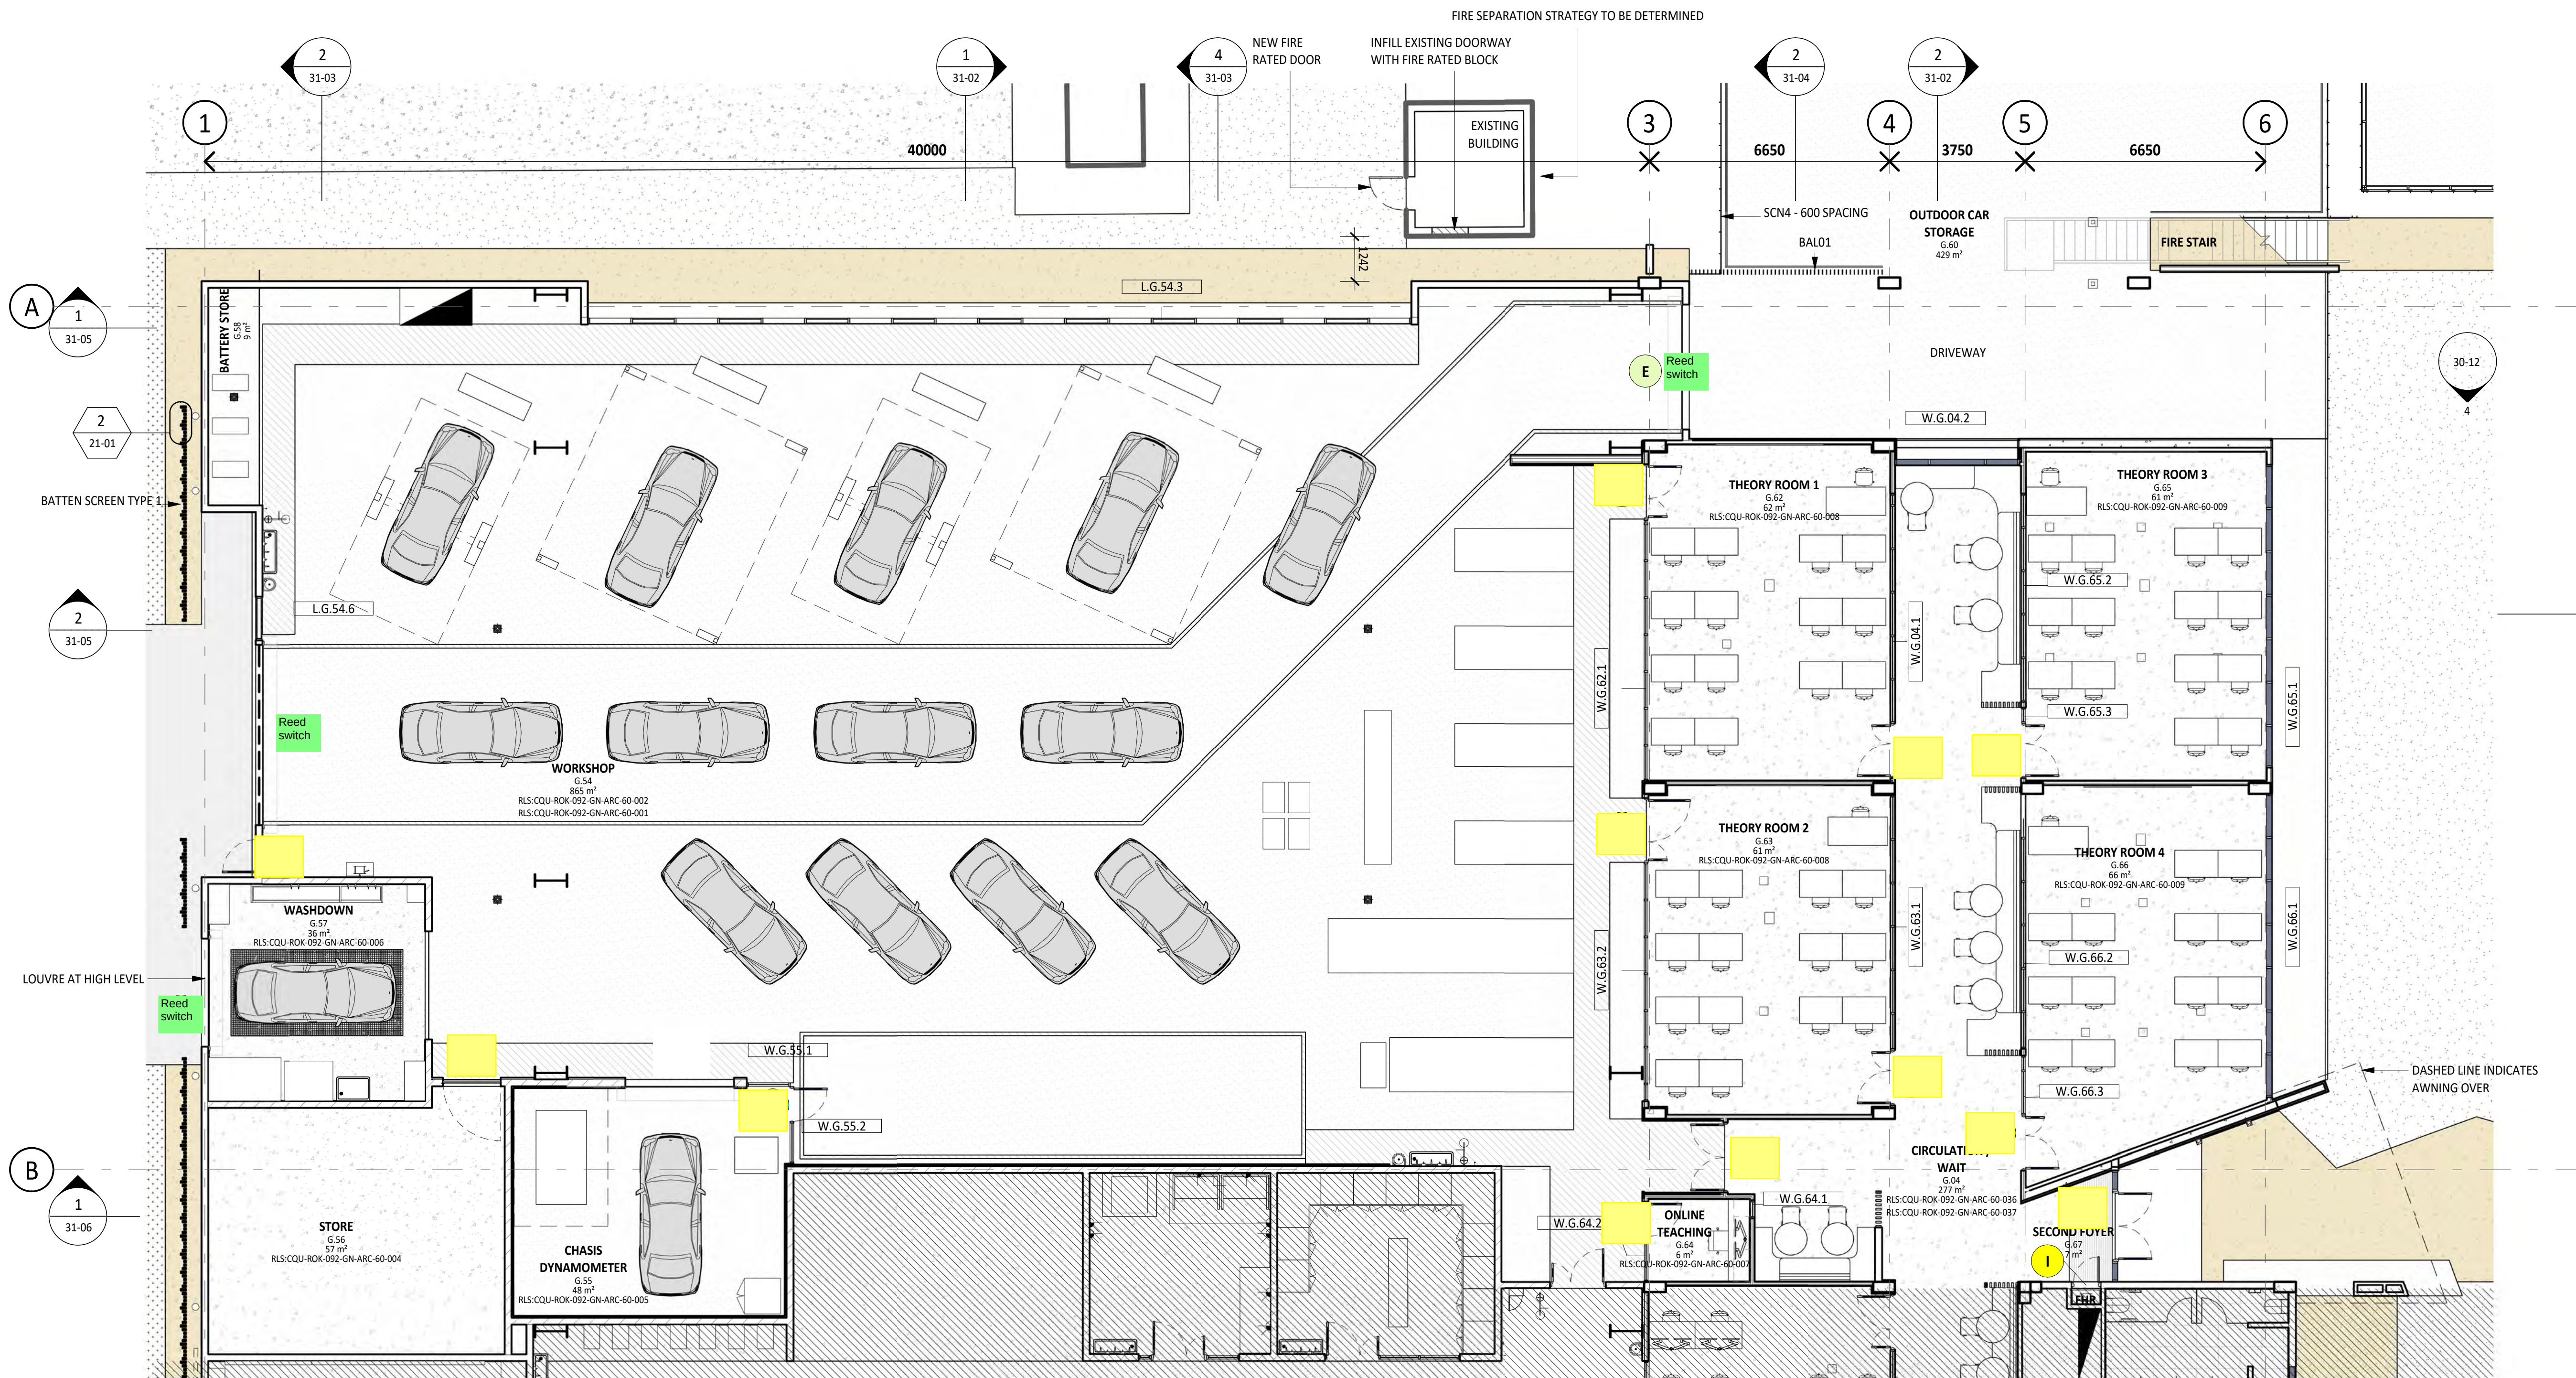**2**
21-01
PLAN DETAIL - BATTEN SCREEN TYPE 1 - BST 1
1 : 10

ACCESS TYPE	
A	CARD READER ACCESS
B	TURN SNIB (NO KEY)
C	PRIVACY SET & TURN SNIB
D	MORTICE LOCK & KEY CYLINDER
E	ROLLER DOOR LOCK
F	LEVER WITH COMPRESSION LOCKING MECHANISM
G	FREE LEVER ACCESS
H	PUSH & PULL ACCESS
I	ROLLER LATCH
J	FREE LEVER EGRESS
S	ROLLER SHUTTER INCLUDES SAFETY CHAIN TO BE HUNG WHEN SHUTTER IS HELD OPEN

ICON LEGEND	
XX	ACCESS TYPE (TYPE MARK)
XX	DOOR TYPE (COLOUR SHADE)

DOOR TYPE

XX	SOLID CORE DOOR
XX	GLAZED SLIDER DOOR
XX	SOLID CORE DOOR WITH 600W x 900H VISION PANEL
XX	AUTO-SLIDER DOOR
XX	GLAZED-STACKER DOOR
XX	BIFOLD DOOR
XX	ROLLER SHUTTER
XX	ACOUSTIC STACKER DOOR
XX	GLAZED SWING DOOR
XX	SWING GATE - ALUMINIUM BATTEN
XX	SLIDING GATE - AUTOMATIC OPERATION

GENERAL NOTE

- ALL DOORS IN WORKSHOP AREA TO HAVE 900 HIGH STAINLESS STEEL TROLLEY PLATE TO BOTH SIDES
- REFER TO MECHANICAL DRAWINGS FOR GRILLE AND UNDERCUT
- ALL SERVICE DOORS TO HAVE SMOKE SEALS
- FOR GLAZED DOORS REFER TO ROOM LAYOUT SHEET FOR EXTENT, WHICH NOTES SAFETY VISUAL GLAZING / PRIVACY SCREENING.
- DOOR FUNCTION AND HARDWARE TO BE IN ACCORDANCE TO CQU GUIDELINES.
- ANY DOOR ACCESS TO BATHROOM TO HAVE STAINLESS STEEL KICKPLATE
- ALLOW FOR DOOR CLOSERS AND DOOR STOPS TO DOORS
- EXTERNAL DOORS TO BE MANUALLY OPERATED, OPENING OUTWARDS. ENSURE THIS COMPLIES WITH AS 1428.1
- FIRE RATED DOORS TO HAVE PUSH BAR FOR EXIT.
- SINGLE SWING DOORS FOR CIRCULATION ACCESS TO BE 920MM WIDE, UNLESS SPECIFIED
- ALL EXTERNAL DOORS, LECTURE THEATRE DOORS, PLANT ROOMS, TOILET DOORS, FIRES DOORS AND EMERGENCY EXIT TO HAVE AUTO-CLOSER DOORS
- CQU TO CONFIRM ACCESS REQUIREMENT TO OFFICES AND CLASSROOMS
- EXTERNALLY LOCKED DOORS TO HAVE STRIKER PLATE PROTECTION INSTALLED
- REFER TO CQU DESIGN GUIDELINES FOR DESIGN AND CONSTRUCTION REQUIREMENTS.
- REFER TO ROOM LAYOUT SHEET FOR EXTENT OF WORK.
- DRAWINGS TO BE READ IN CONJUNCTION WITH SERVICES, CIVIL AND STRUCTURAL DRAWINGS.
- ALL EXTERNAL DOORS TO HAVE REED SWITCH
- ALL DOORS TO HAVE **MONITORED** ELECTRIC STRIKE SWIPE CARD ACCESS, PLUS MASTERKEY LOCK AND CYLINDER. EXCEPTIONS ARE - MEETING ROOM DOORS - INCLUDE MASTERKEY LOCK AND CYLINDER, PLUS SNIB - NO SWIPE. ELECTRICAL CUPBOARDS - INCLUDE MASTERKEY LOCK AND CYLINDER - NO SWIPE OR SNIB
- CONTRACTOR TO ALLOW FOR POWER AND DATA TO ALL DOORS WITH SWIPE ACCESS

FIRE MANAGEMENT LEGEND

	FIRE RATED WALL - REFER TO PARTITION DETAILS FOR MORE INFO
	SMOKE COMPARTMENT WALL
PLANS TO BE PRINTED IN COLOUR	

CQU ROCKHAMPTON TAFE CONSOLIDATION - STAGE 2

554/700 Yaamba Rd, Norman
Gardens QLD 4701



A	12/02/26	ISSUED FOR TENDER	BS
3	30/01/26	DRAFT 60% ISSUE	BS
2	23/01/26	COORDINATION ISSUE FOR CONSULTANTS	BS
1	19/12/25	ISSUE FOR COORDINATION	BS
rev/	date	details	init.

drawn	date
PT	19/12/25
checked	date
use 'Approved By' only	19/12/25
verified	date
BS	19/12/25

scale


1

FLOOR PLAN GROUND LEVEL - ZONE 2

scale	project no.
1 : 100 @ A1	260018
revision	
A	
sheet no.	
CQU-ROK-092-GN-ARC-21-02	

original sheet size - A1 (594mm x 841mm)

ISSUED FOR TENDER

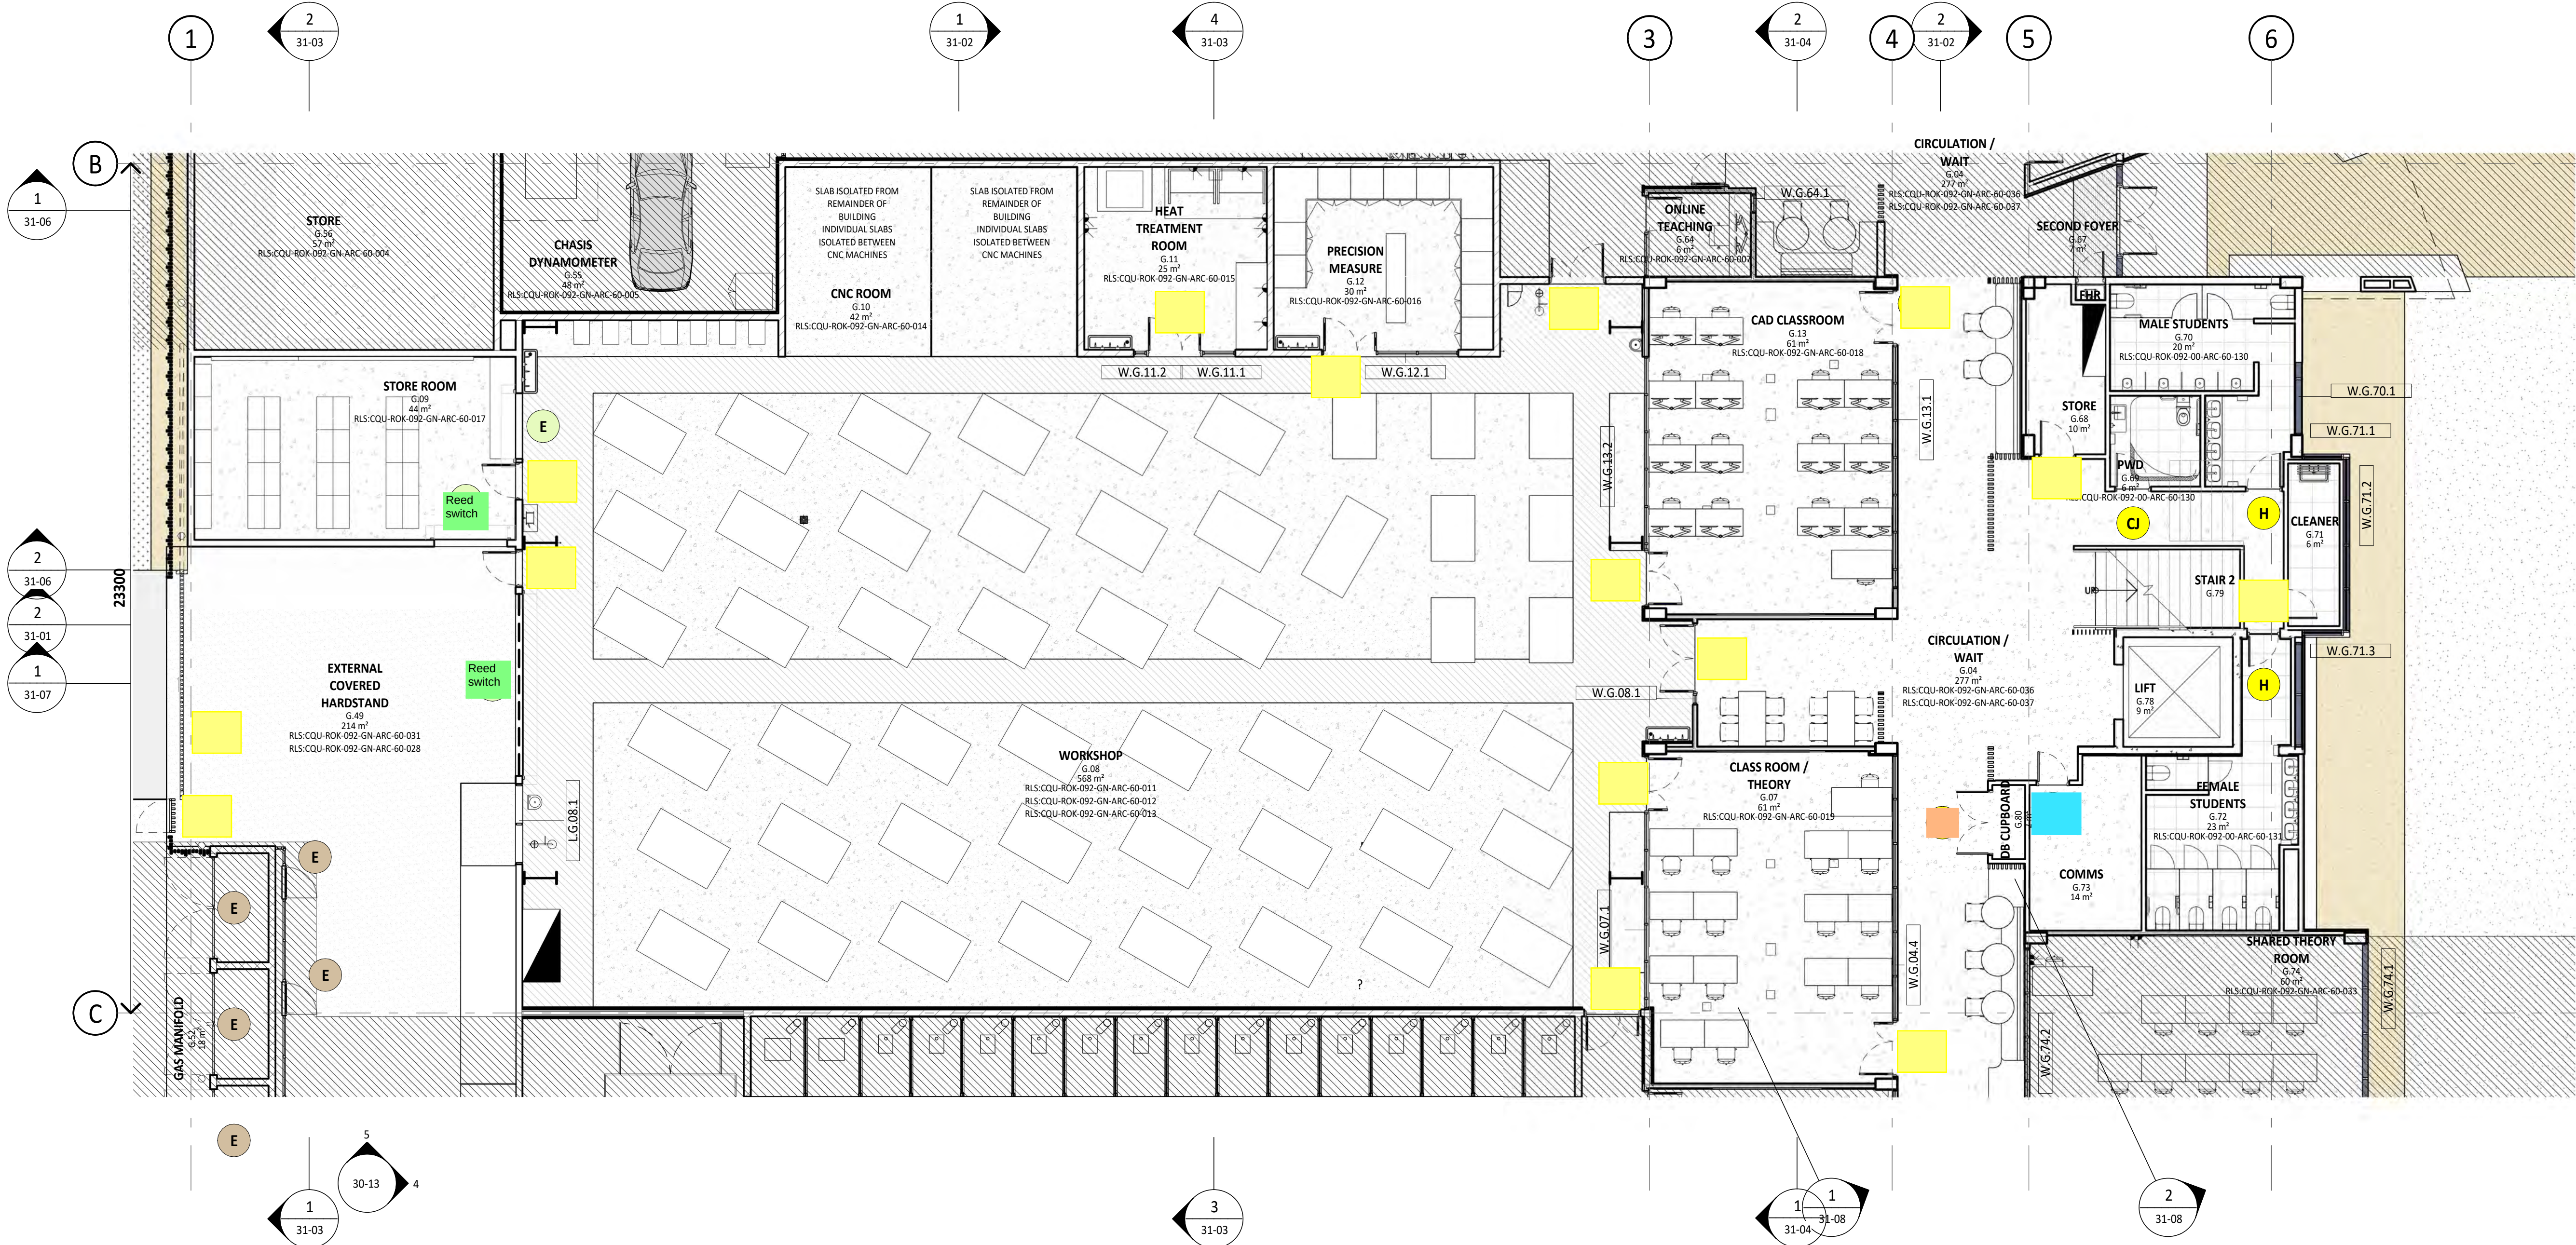

CQU ROCKHAMPTON TAFE CONSOLIDATION - STAGE 2

554/700 Yaamba Rd, Norman
Gardens QLD 4701



A	12/02/26	ISSUED FOR TENDER	BS
3	30/01/26	DRAFT 60% ISSUE	BS
2	23/01/26	COORDINATION ISSUE FOR CONSULTANTS	BS
1	19/12/25	ISSUE FOR COORDINATION	BS

drawn	date
PT	19/12/25
checked	date
use 'Approved By' only	19/12/25
verified	date
BS	19/12/25

scale

FLOOR PLAN GROUND LEVEL - ZONE 3

scale project no.
1 : 100 @ A1 260018

revision
A

sheet no.
CQU-ROK-092-GN-ARC-21-03

original sheet size - A1 (594mm x 841mm)

ISSUED FOR TENDER

GENERAL NOTE

- ALL DOORS IN WORKSHOP AREA TO HAVE 900 HIGH STAINLESS STEEL TROLLEY PLATE TO BOTH SIDES
- REFER TO MECHANICAL DRAWINGS FOR GRILLE AND UNDERCUT
- ALL SERVICE DOORS TO HAVE SMOKE SEALS
- FOR GLAZED DOORS REFER TO ROOM LAYOUT SHEET FOR EXTENT, WHICH NOTES SAFETY VISUAL GLAZING / PRIVACY SCREENING.
- DOOR FUNCTION AND HARDWARE TO BE IN ACCORDANCE TO CQU GUIDELINES.
- ANY DOOR ACCESS TO BATHROOM TO HAVE STAINLESS STEEL KICKPLATE
- ALLOW FOR DOOR CLOSERS AND DOOR STOPS TO DOORS
- EXTERNAL DOORS TO BE MANUALLY OPERATED, OPENING OUTWARDS. ENSURE THIS COMPLIES WITH AS 1428.1
- FIRE RATED DOORS TO HAVE PUSH BAR FOR EXIT.
- SINGLE SWING DOORS FOR CIRCULATION ACCESS TO BE 920MM WIDE, UNLESS SPECIFIED
- ALL EXTERNAL DOORS, LECTURE THEATRE DOORS, PLANT ROOMS, TOILET DOORS, FIRES DOORS AND EMERGENCY EXIT TO HAVE AUTO-CLOSER DOORS
- CQU TO CONFIRM ACCESS REQUIREMENT TO OFFICES AND CLASSROOMS
- EXTERNALLY LOCKED DOORS TO HAVE STRIKER PLATE PROTECTION INSTALLED
- REFER TO CQU DESIGN GUIDELINES FOR DESIGN AND CONSTRUCTION REQUIREMENTS.
- REFER TO ROOM LAYOUT SHEET FOR EXTENT OF WORK.
- DRAWINGS TO BE READ IN CONJUNCTION WITH SERVICES, CIVIL AND STRUCTURAL DRAWINGS.
- ALL EXTERNAL DOORS TO HAVE REED SWITCH
- ALL DOORS TO HAVE MONITORED ELECTRIC STRIKE SWIPE CARD ACCESS, PLUS MASTERKEY LOCK AND CYLINDER. EXCEPTIONS ARE - MEETING ROOM DOORS - INCLUDE MASTERKEY LOCK AND CYLINDER, PLUS SNIB - NO SWIPE. ELECTRICAL CUPBOARDS - INCLUDE MASTERKEY LOCK AND CYLINDER - NO SWIPE OR SNIB
- CONTRACTOR TO ALLOW FOR POWER AND DATA TO ALL DOORS WITH SWIPE ACCESS

FIRE MANAGEMENT LEGEND

- FIRE RATED WALL - REFER TO PARTITION DETAILS FOR MORE INFO
- SMOKE COMPARTMENT WALL
- PLANS TO BE PRINTED IN COLOUR

DOOR TYPE


- XX SOLID CORE DOOR
- XX GLAZED SLIDER DOOR
- XX SOLID CORE DOOR WITH 600W x 900H VISION PANEL
- XX AUTO-SLIDER DOOR
- XX GLAZED STACKER DOOR
- XX BIFOLD DOOR
- XX ROLLER SHUTTER
- XX ACOUSTIC STACKER DOOR
- XX GLAZED SWING DOOR
- XX SWING GATE - ALUMINIUM BATTEN
- XX SLIDING GATE - AUTOMATIC OPERATION

ACCESS TYPE

- A CARD READER ACCESS
- B TURN SNIB (NO KEY)
- C PRIVACY SET & TURN SNIB
- D MORTICE LOCK & KEY CYLINDER
- E ROLLER DOOR LOCK
- F LEVER WITH COMPRESSION LOCKING MECHANISM
- G FREE LEVER ACCESS
- H PUSH & PULL ACCESS
- I ROLLER LATCH
- J FREE LEVER EGRESS
- S ROLLER SHUTTER INCLUDES SAFETY CHAIN TO BE HUNG WHEN SHUTTER IS HELD OPEN

ICON LEGEND

- XX ACCESS TYPE (TYPE MARK)
- DOOR TYPE (COLOUR SHADE)

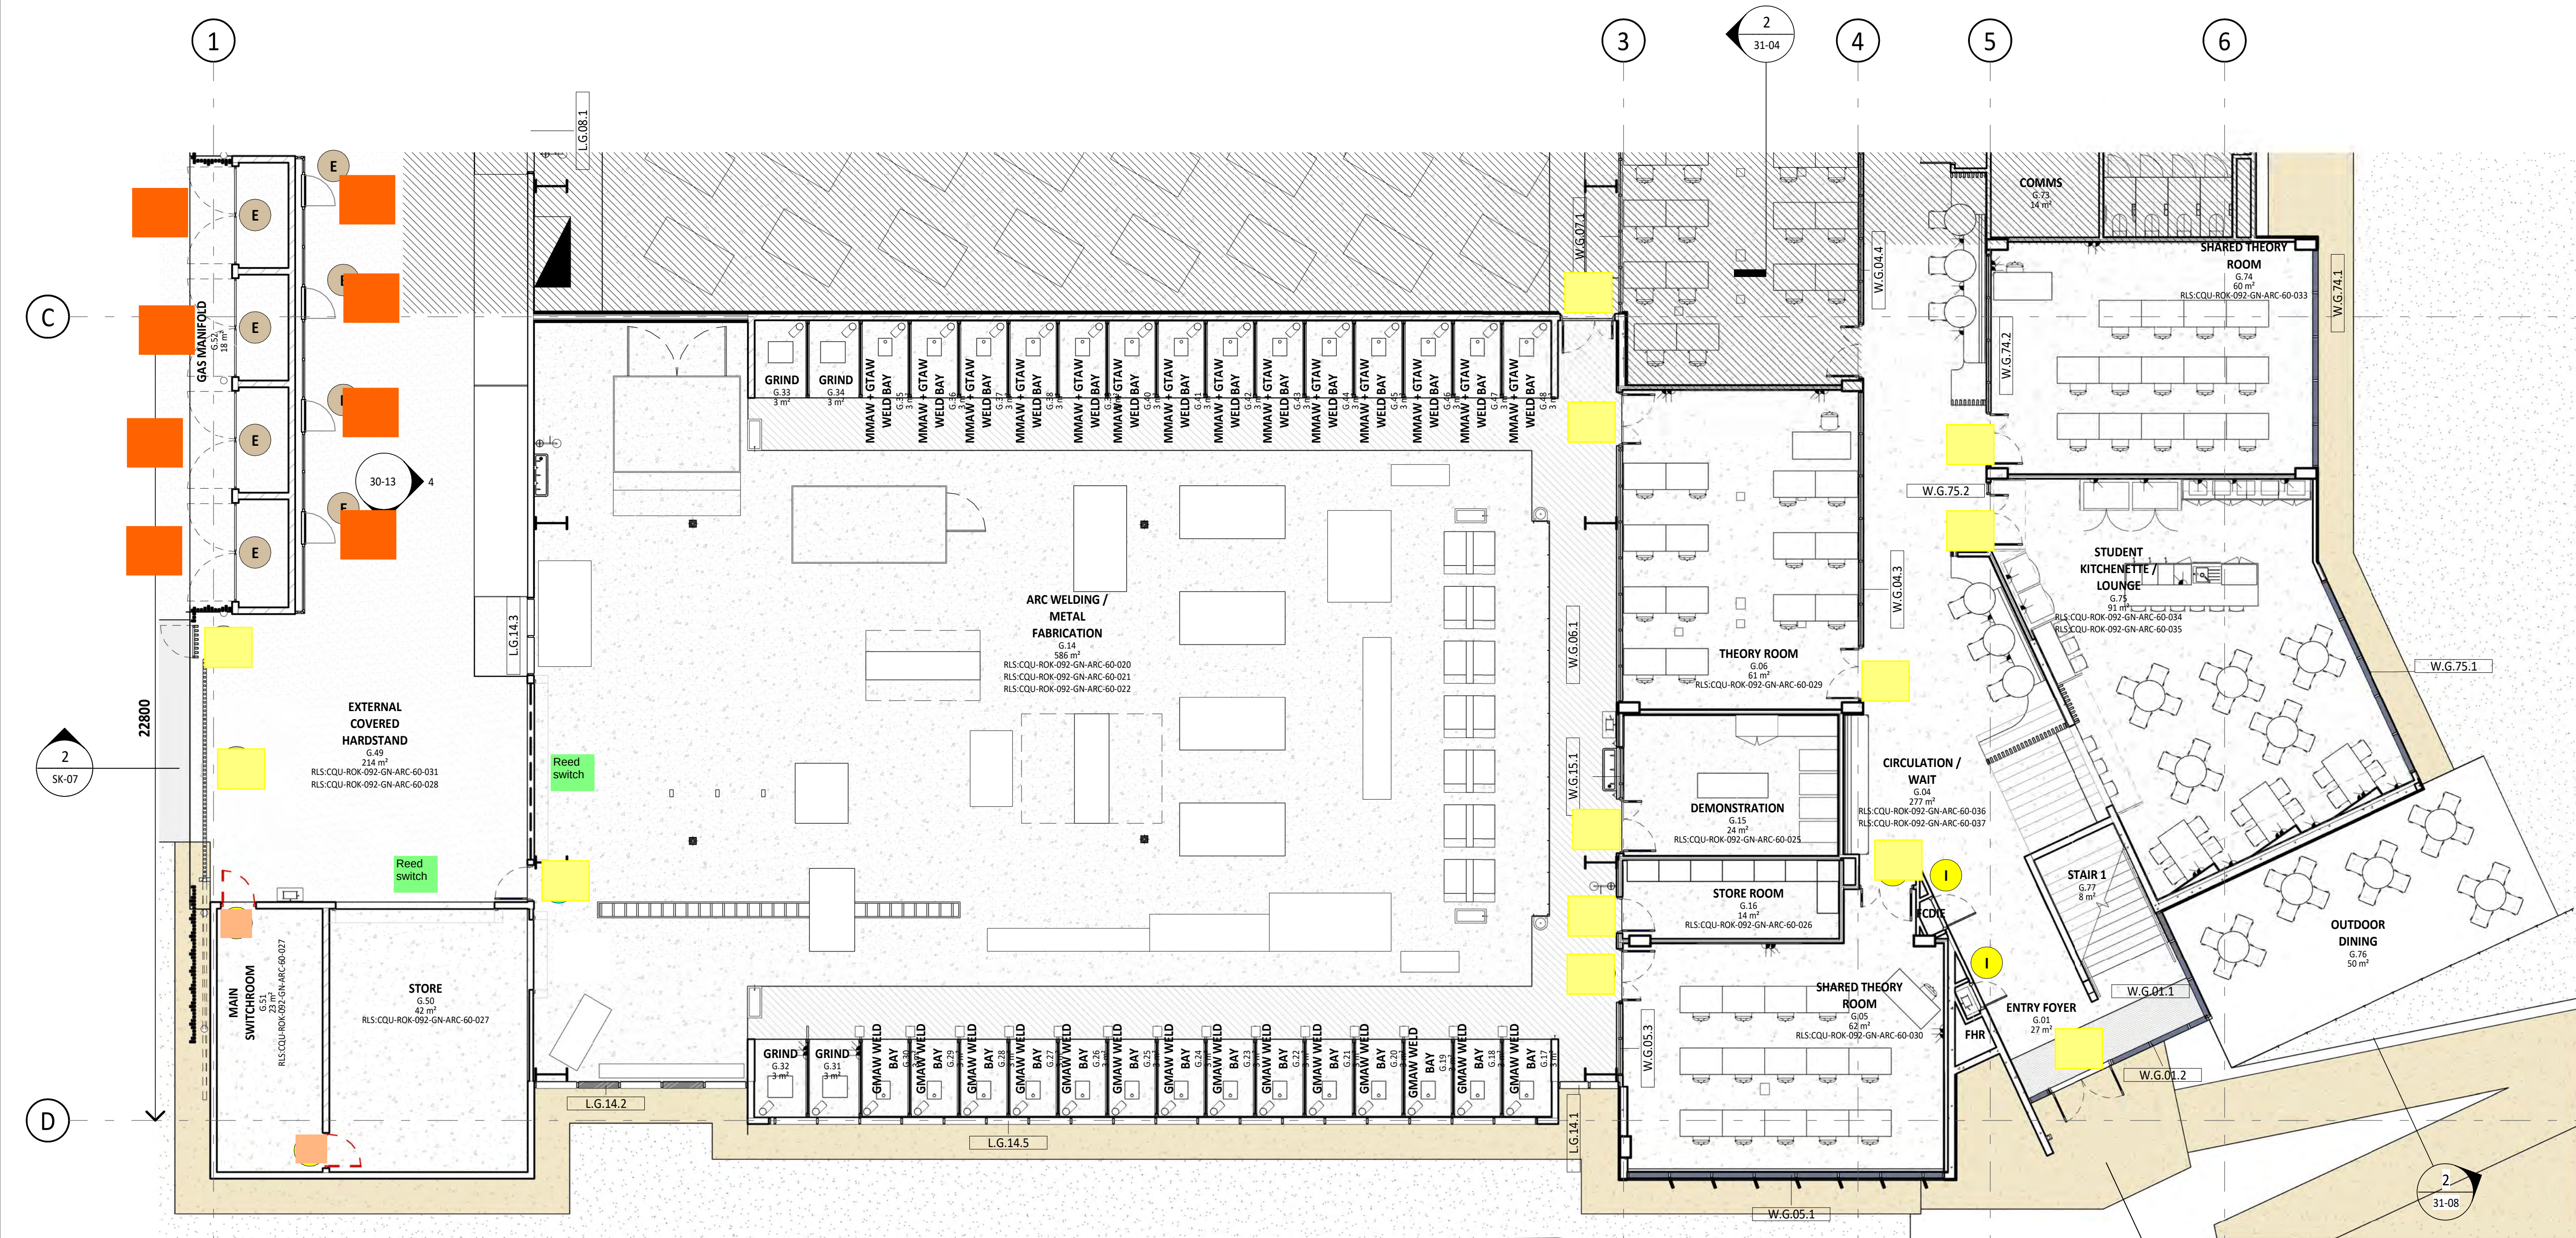

DOOR TYPE

- XX SOLID CORE DOOR
- XX GLAZED SLIDER DOOR
- XX SOLID CORE DOOR WITH 600W x 900H VISION PANEL
- XX AUTO-SLIDER DOOR
- XX GLAZED STACKER DOOR
- XX BIFOLD DOOR
- XX ROLLER SHUTTER
- XX ACOUSTIC STACKER DOOR
- XX GLAZED SWING DOOR
- XX SWING GATE - ALUMINIUM BATTEN
- XX SLIDING GATE - AUTOMATIC OPERATION

ACCESS TYPE

- A CARD READER ACCESS
- B TURN SNIB (NO KEY)
- C PRIVACY SET & TURN SNIB
- D MORTICE LOCK & KEY CYLINDER
- E ROLLER DOOR LOCK
- F LEVER WITH COMPRESSION LOCKING MECHANISM
- G FREE LEVER ACCESS
- H PUSH & PULL ACCESS
- I ROLLER LATCH
- J FREE LEVER EGRESS
- S ROLLER SHUTTER INCLUDES SAFETY CHAIN TO BE HUNG WHEN SHUTTER IS HELD OPEN

ICON LEGEND

- XX ACCESS TYPE (TYPE MARK)
- DOOR TYPE (COLOUR SHADE)