

ROK019
4 Internal Cameras

thomson
adsett



PEDDLE THORP
architecture | interiors | health | planning

Telephone +61 7 3840 9999
bne@thomsonadsett.com
Level 9, 470 St Pauls Terrace
Fortitude Valley
Qld 4006 Australia
thomsonadsett.com


© Copyright
These drawings and designs and the copyright thereof are the property of Thomson Adsett Pty Ltd and must not be used, retained or copied without written permission of Thomson Adsett Pty Ltd. ABN 76 105 314 654 Trading as ThomsonAdsett. Dimensions take precedence over scaling. Do not measure off drawings as print sizes may vary

CQU ROCKHAMPTON
TAFE
CONSOLIDATION -
STAGE 2
554/700 Yaamba Rd, Norman
Gardens QLD 4701



A	12/02/26	ISSUED FOR TENDER	SM
1	30/01/26	60% DRAFT ISSUE	SM
rev/	date	details	init.


drawn	date
TA/PT	27/01/26
checked	date
SZ	27/01/26
verified	date
	27/01/26

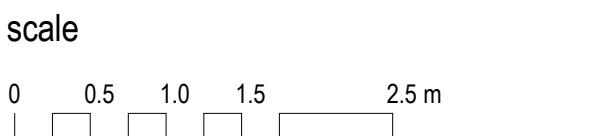

FLOOR & WALL FINISHES
PLAN LEVEL 03

scale	project no.
1 : 100 @ A1	260018
revision	
A	
sheet no.	
CQU-ROK-019-03-ARC-28-01	

ISSUE FOR TENDER

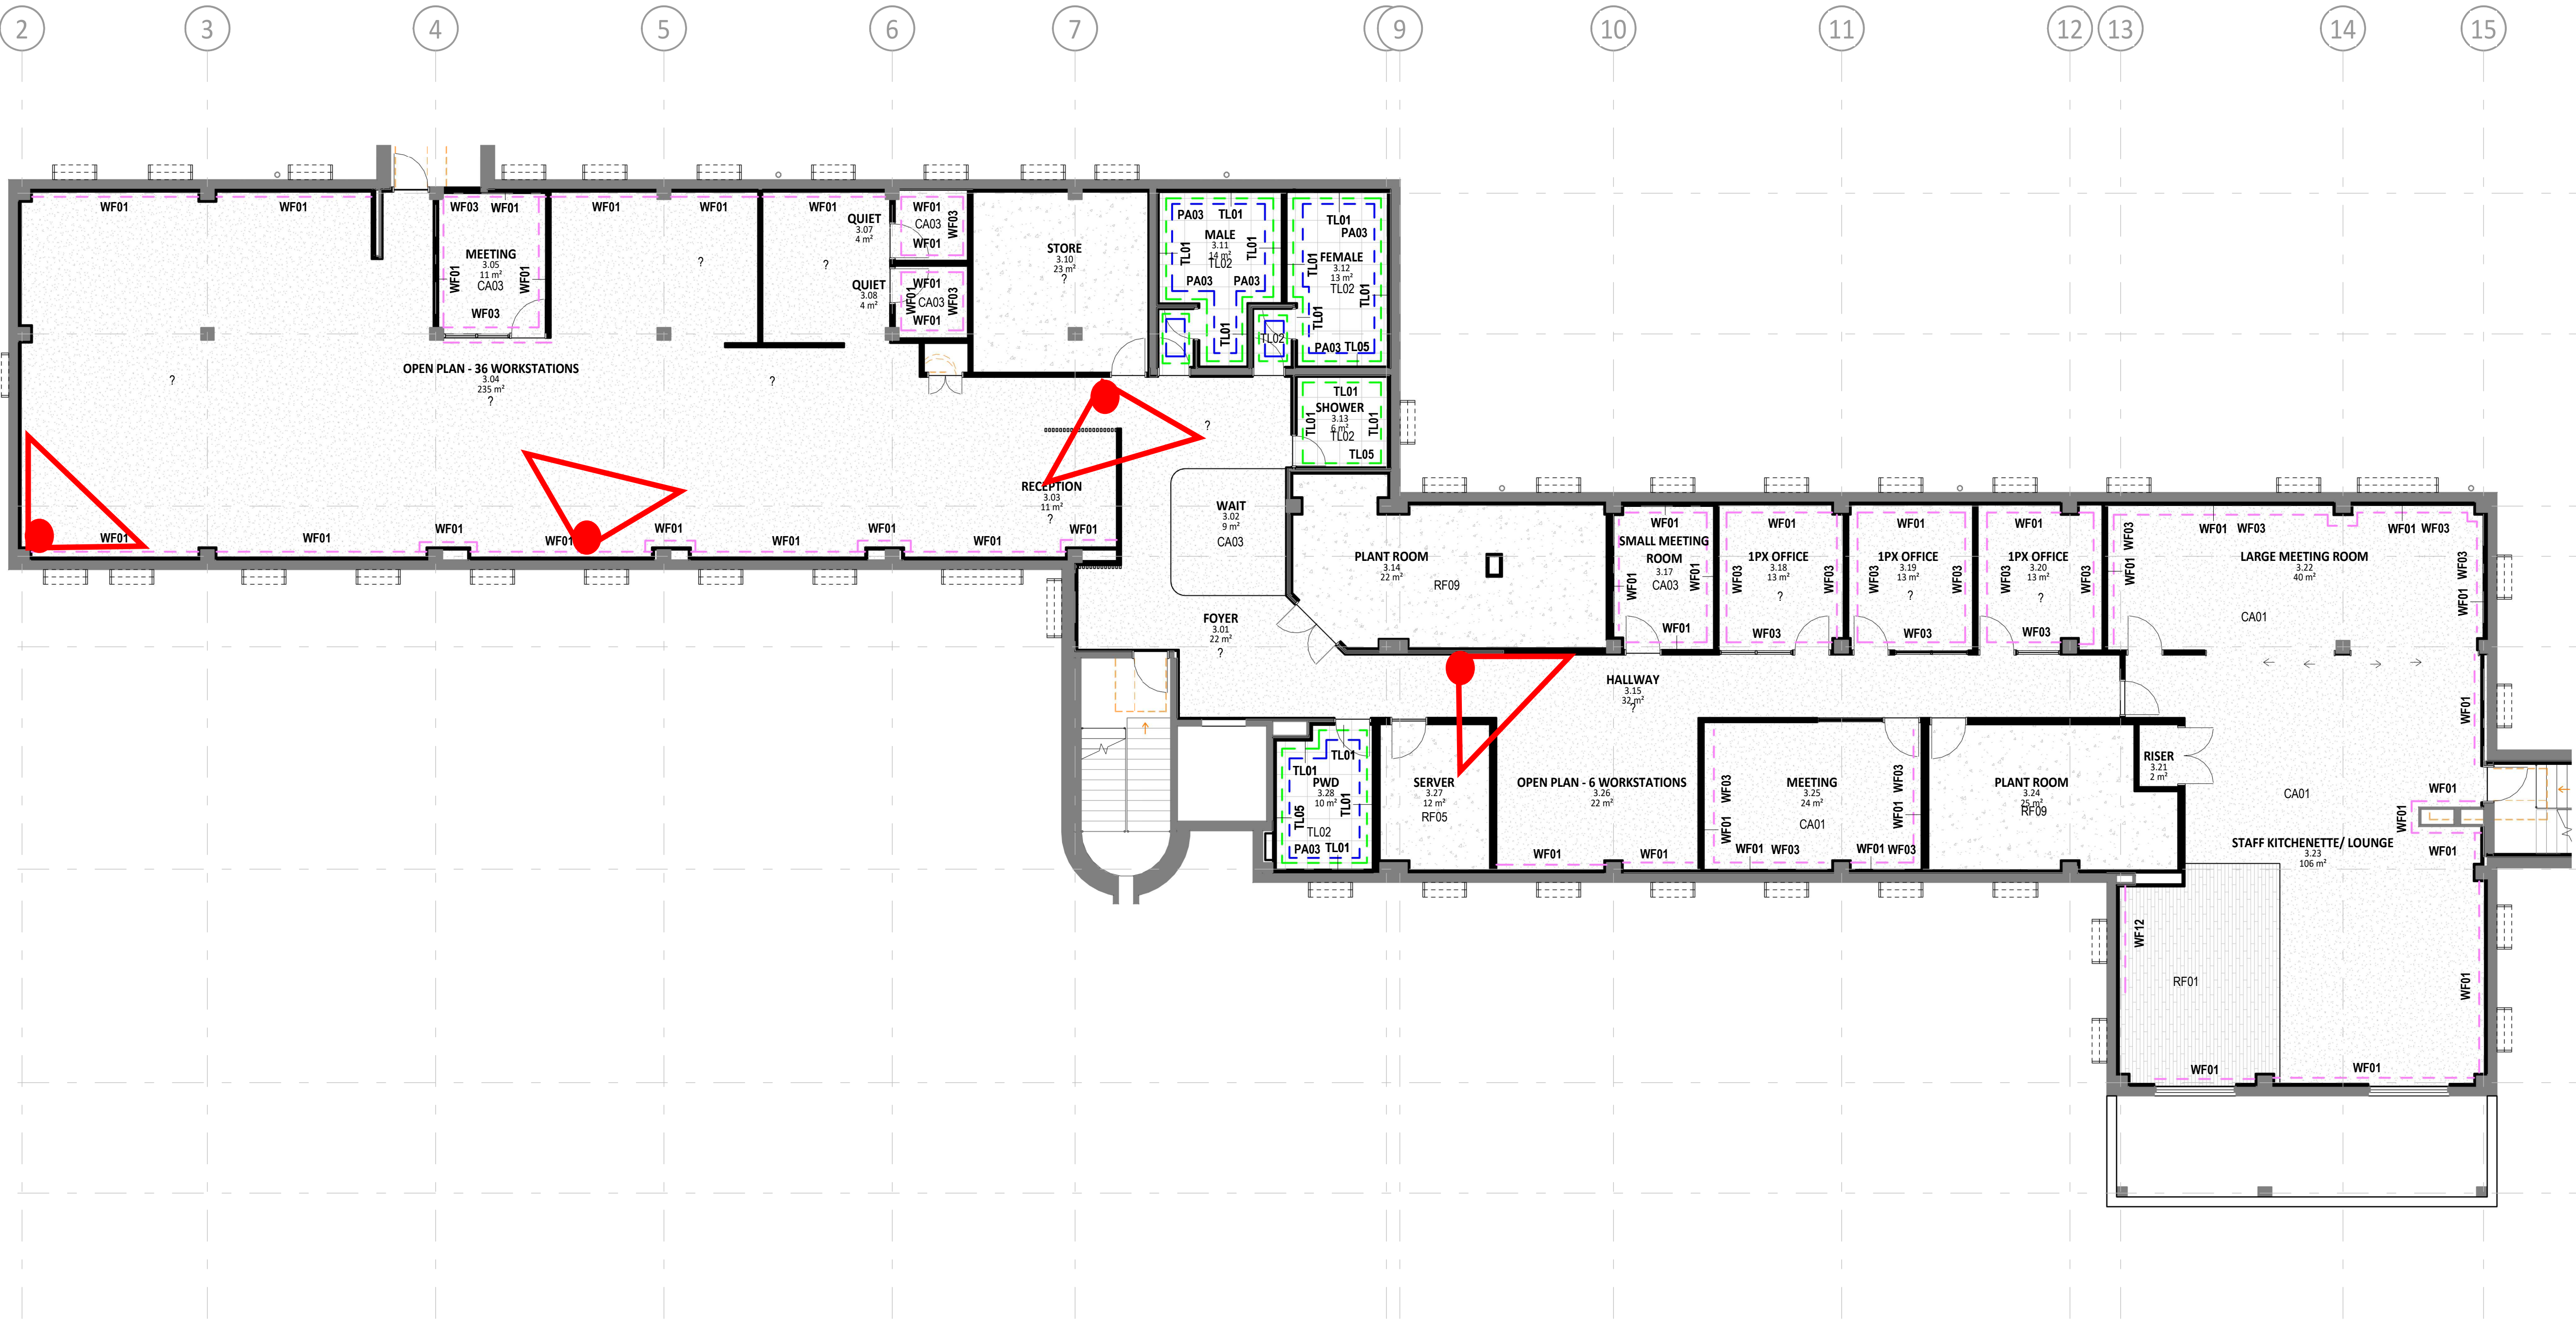

- GENERAL NOTES:
- THIS DRAWING IS TO BE READ IN CONJUNCTION WITH ALL PROJECT DRAWINGS, SCHEDULES AND SPECIFICATIONS, PLUS ALL OTHER RELEVANT CONSULTANT DOCUMENTS.
 - ALL WORKS TO COMPLY WITH BCA AND AUSTRALIAN STANDARDS.
 - ANY DISCREPANCIES ON THE DRAWINGS OR IRREGULARITIES BETWEEN INFORMATION SHOWN ON INTERIOR DRAWINGS AND SERVICES CONSULTANTS DOCUMENTS ARE TO BE REFERRED TO THE DESIGNER FOR CLARIFICATION PRIOR TO THE WORKS PROCEEDING.
 - ALL DIMENSIONS AND AREAS PROVIDED TO BE CONFIRMED ON SITE PRIOR TO COMMENCEMENT OF WORKS

- FINISHES NOTES:
- ALL JUNCTIONS IN FLOOR FINISHES TO BE FLUSH.
 - CHANGES TO FLOOR FINISH TO OCCUR UNDER THE CENTRE LINE OF THE DOOR LEAF UNLESS NOTED OTHERWISE.
 - ALL WALLS TO BE PA01 UNLESS OTHERWISE NOTED.
 - ALL SOLID CORE DOORS TO BE PA11 UNLESS OTHERWISE NOTED.
 - REFER 60 SERIES DRAWINGS & SCH-INT-01 INTERIOR FINISHES SCHEDULE FOR SKIRTING TYPES AND SPECIFICATION. ALL WALLS TO RECEIVE SK01 SKIRTING UNLESS NOTED OTHERWISE.
 - NEW SKIRTING TO MATCH EXISTING WHERE RELEVANT.
 - ALL DOOR STATUTORY SIGNAGE AND ROOM SIGNAGE TO BE REMOVED BEFORE PAINTING.
 - ALL WINDOW FURNISHING TO BE REMOVED BEFORE PAINTING, CLEANED AND REINSTALLED.
 - FLOOR FINISHES TO CONTINUE UNDER NEW JOINERY.


FINISHES LEGEND

REFER SCH-INT-01 FINISHES SCHEDULE AND 60 SERIES DRAWINGS FOR FURTHER DETAILS AND SPECIFICATION


PA##	FEATURE WALL PAINT
TL##	WALL TILE
WF##	WALL FINISH
CA##	CARPET FLOOR FINISH
RF##	RESILIENT FLOOR FINISH
TL##	TILE FLOOR FINISH

NOTE: PLAN TO BE PRINTED IN COLOUR

ROK21A
4 External Cameras

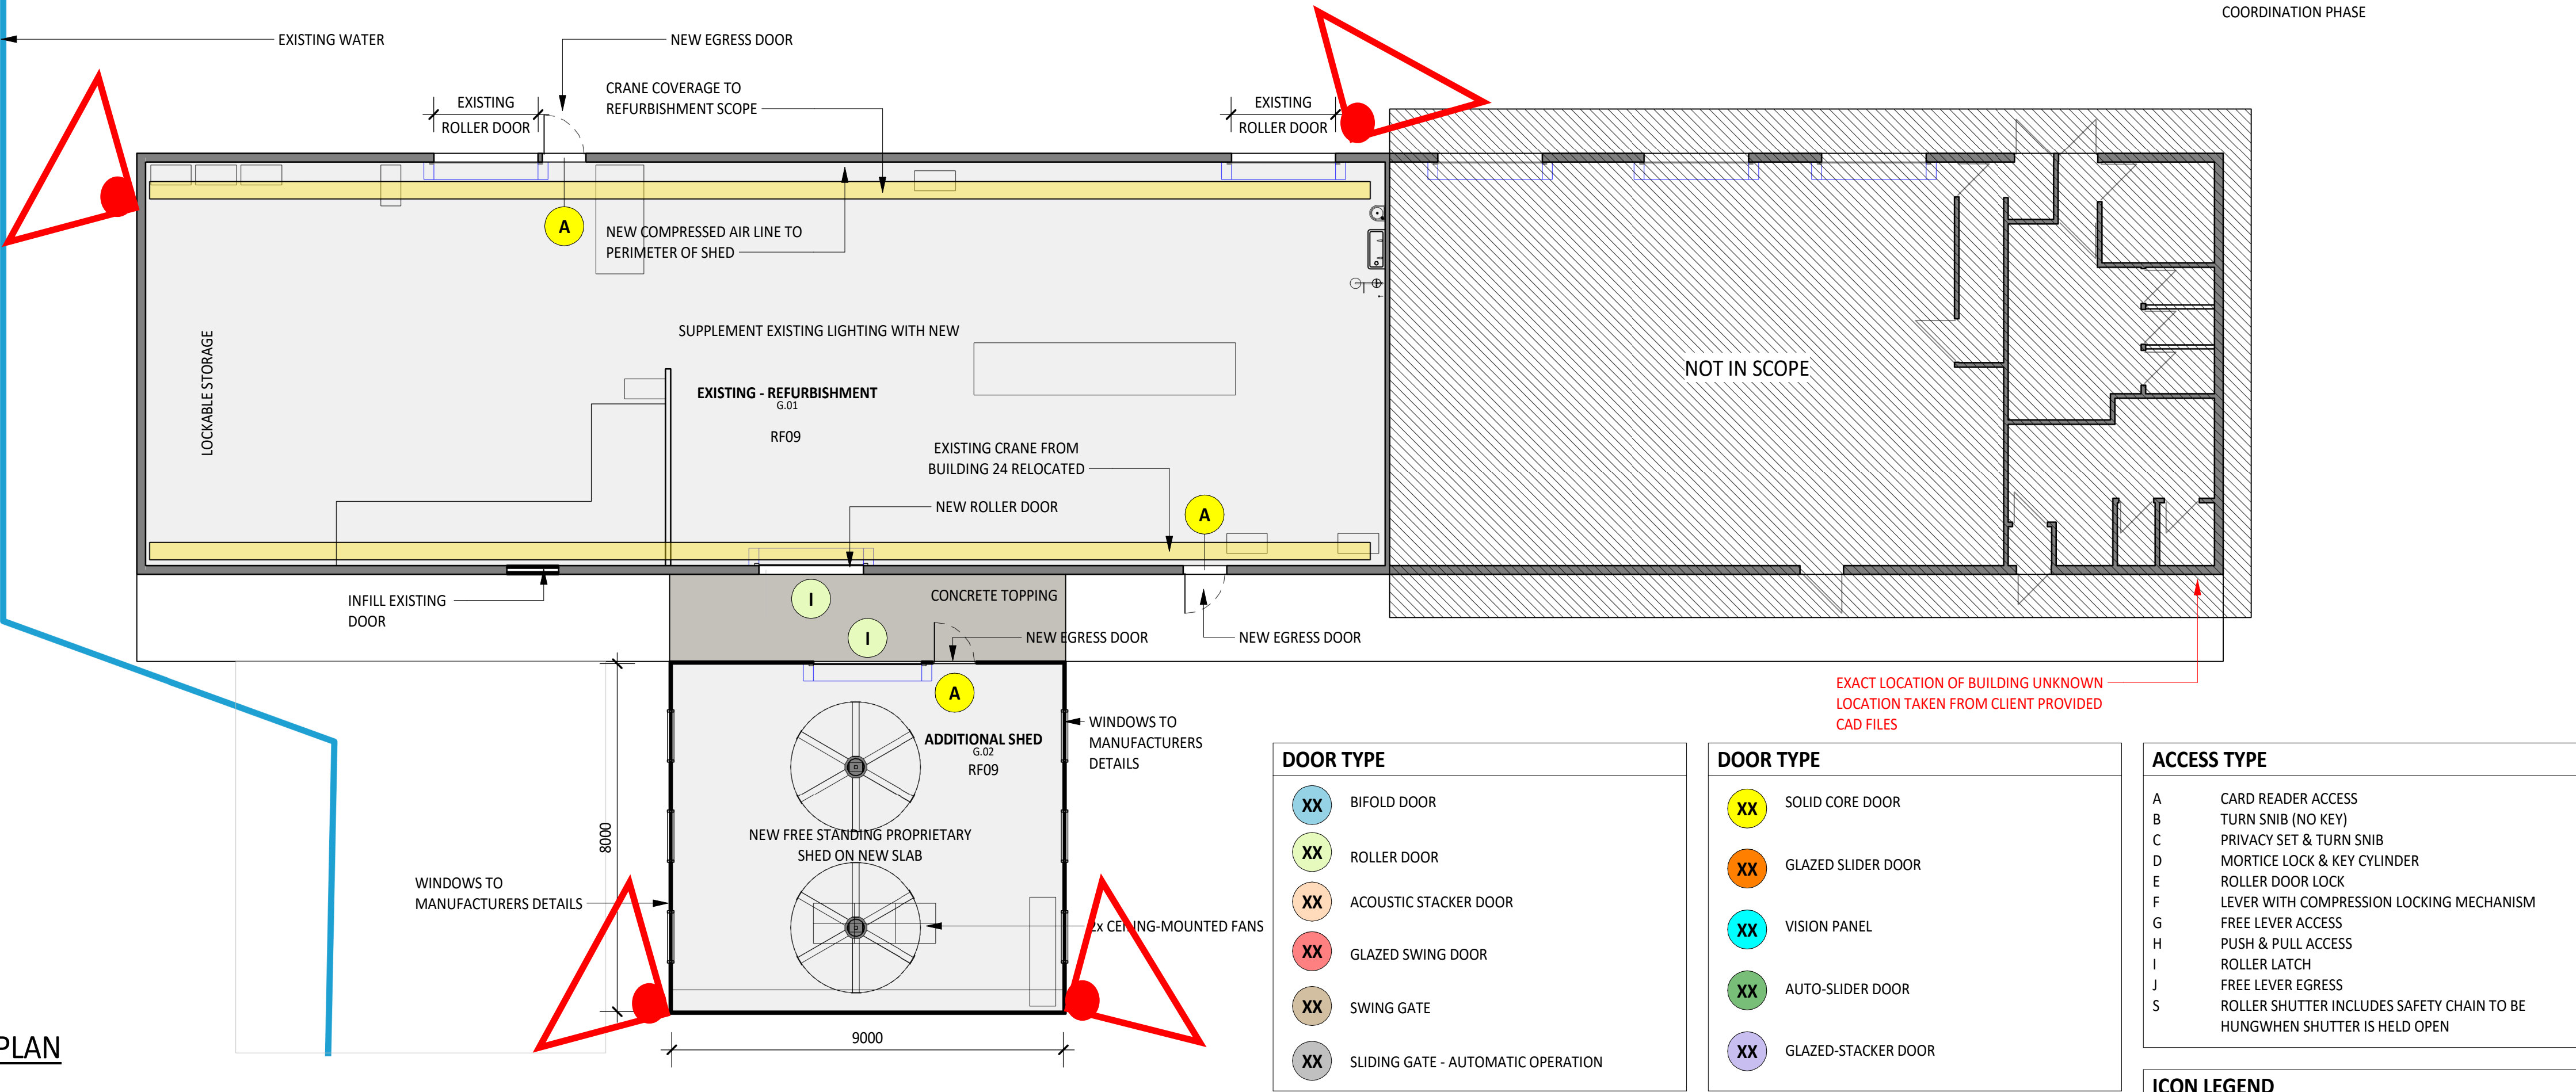

1 GROUND FLOOR PLAN
1 : 100

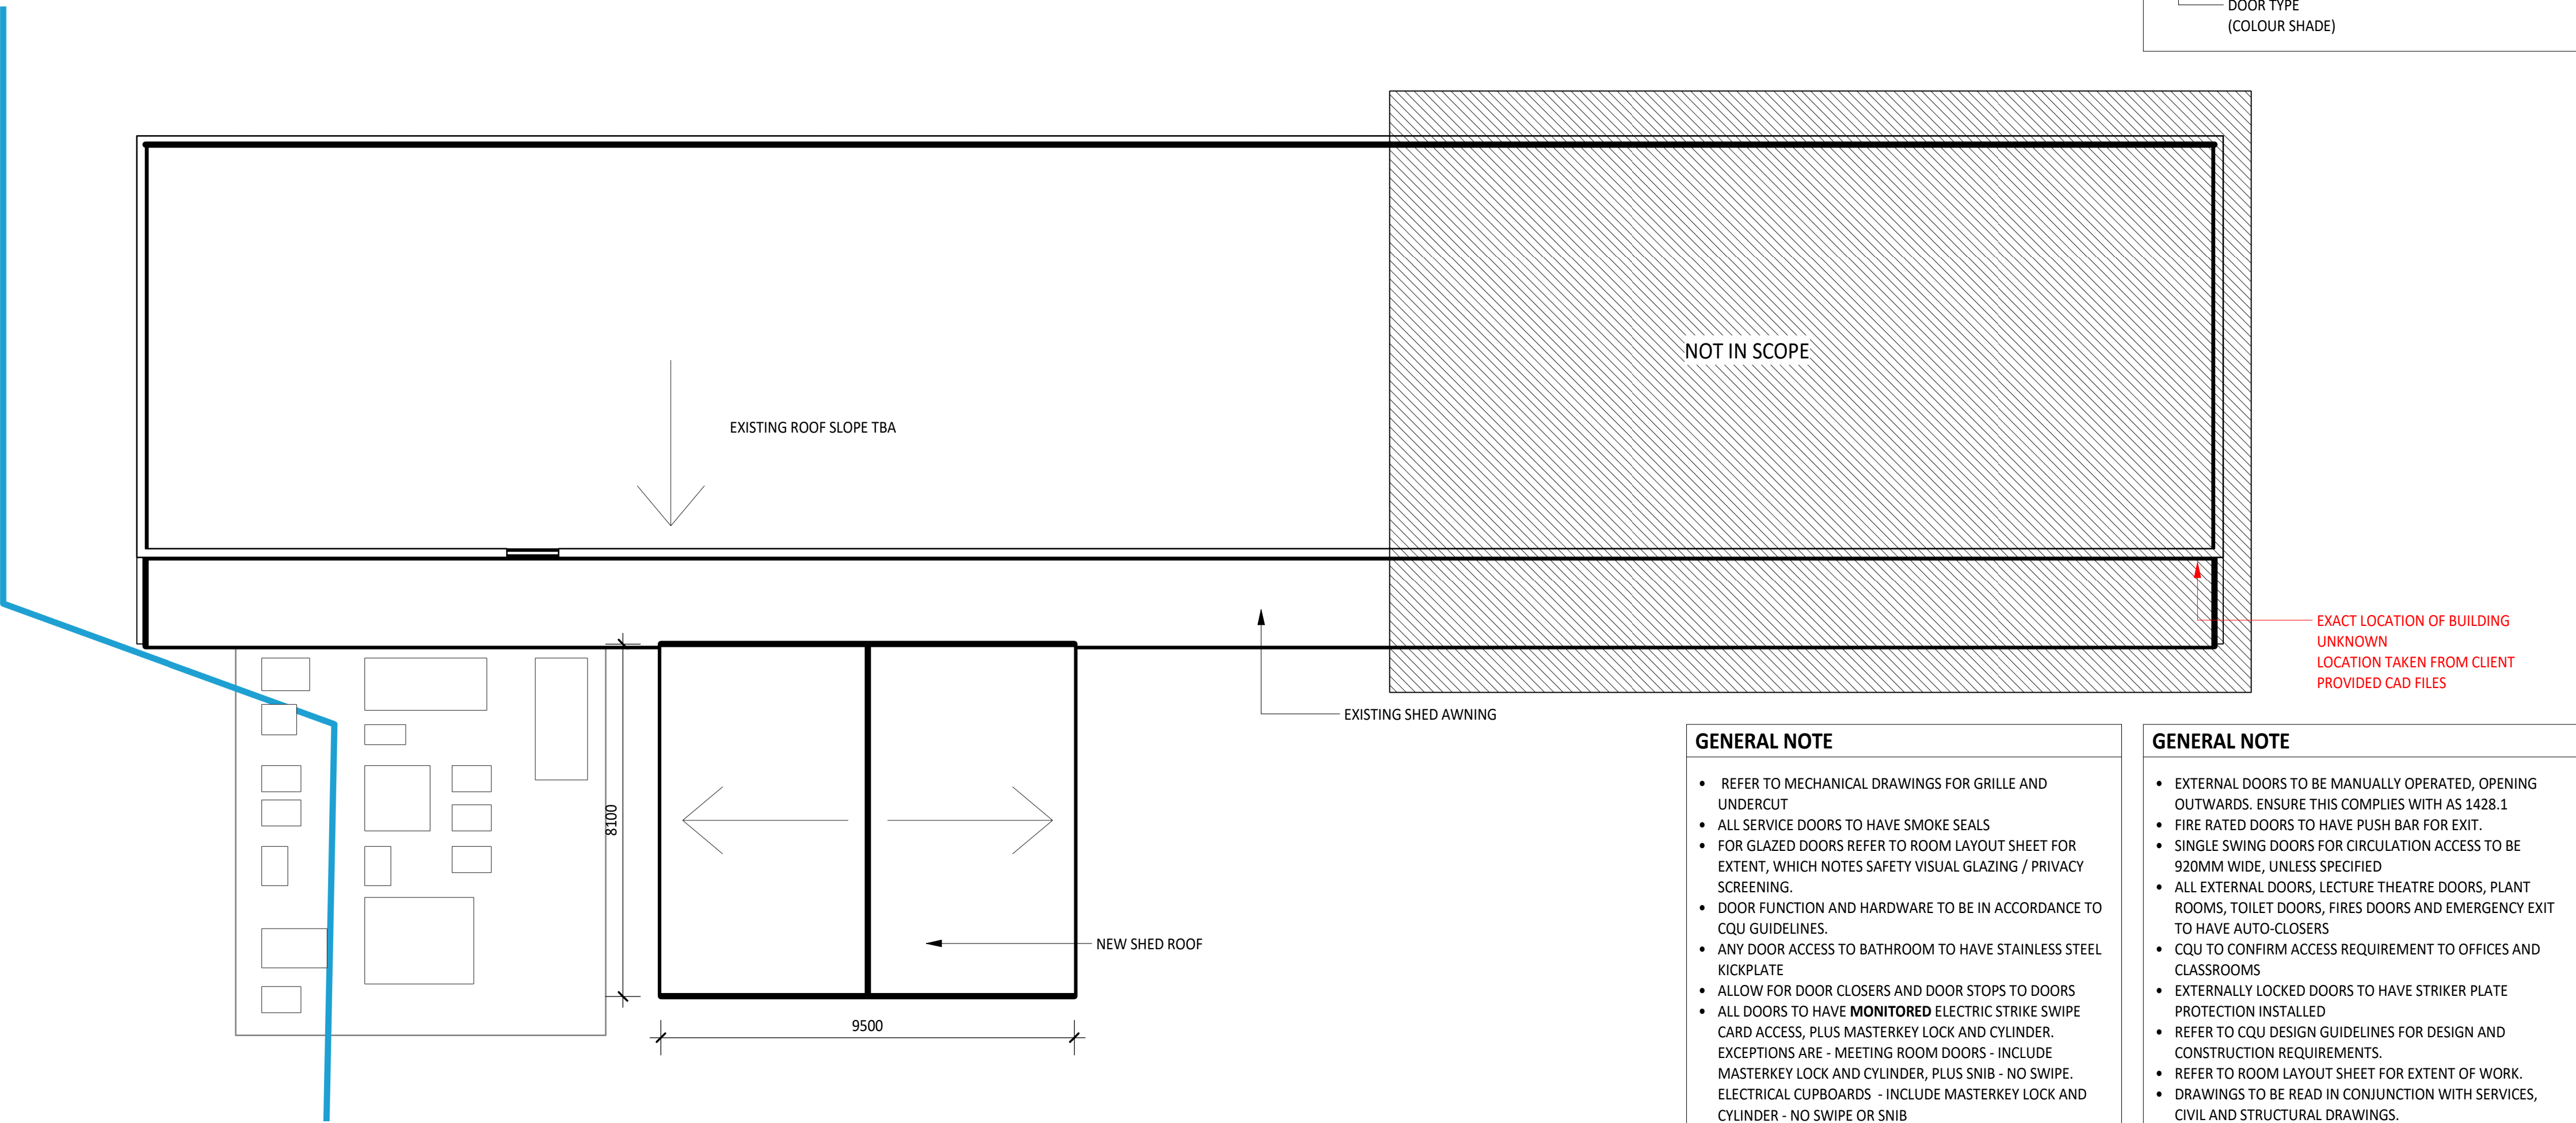

2 ROOF PLAN
1 : 100

NOTE: LAYOUT OF SHED BASED OFF AS BUILT DRAWINGS PROVIDED BY CLIENT. CONTRACTOR TO ALLOW FOR SITE VISIT TO ASSESS CURRENT CONDITION AND LAYOUT OF SHED BEFORE CONSTRUCTION DOCUMENTATION / CONSULTANT COORDINATION PHASE

thomson
adsett

PEDDLE THORP
architecture | interiors | health | planning

Telephone +61 7 3840 9999
bne@thomsonadsett.com
Level 9, 470 St Pauls Terrace
Fortitude Valley
Qld 4006 Australia
thomsonadsett.com

© Copyright
These drawings and designs and the copyright thereof are the property of Thomson Adsett Pty Ltd and must not be used, retained or copied without written permission of Thomson Adsett Pty Ltd. ABN 76 105 314 654 Trading as ThomsonAdsett. Dimensions take precedence over scaling. Do not measure off drawings as print sizes may vary

CQU ROCKHAMPTON
TAFE
CONSOLIDATION -
STAGE 2
ROCKHAMPTON, QUEENSLAND

for
CQUniversity
AUSTRALIA

A	12/02/26	ISSUED FOR TENDER	BS
1	30/01/26	DRAFT 60% ISSUE	BS
rev/	date	details	init.

drawn	date
BS	30/01/26
checked	date
Checker	30/01/26
verified	date
BS	30/01/26

scale

1

ENGINEERING
DEPARTMENT GA PLANS


scale project no.
1 : 100 @ A1 260018
revision
A
sheet no.
CQU-ROK-21A-G-ARC-21-00

ISSUED FOR TENDER

original sheet size - A1 (594mm x 841mm)

12/02/2026 3:50:37 PM Autodesk Docs://CQU ROK TAFE/260018_A_CQU-UNIVERSITY_SITE_R25.rvt

ROK033
6 External (5 only required)

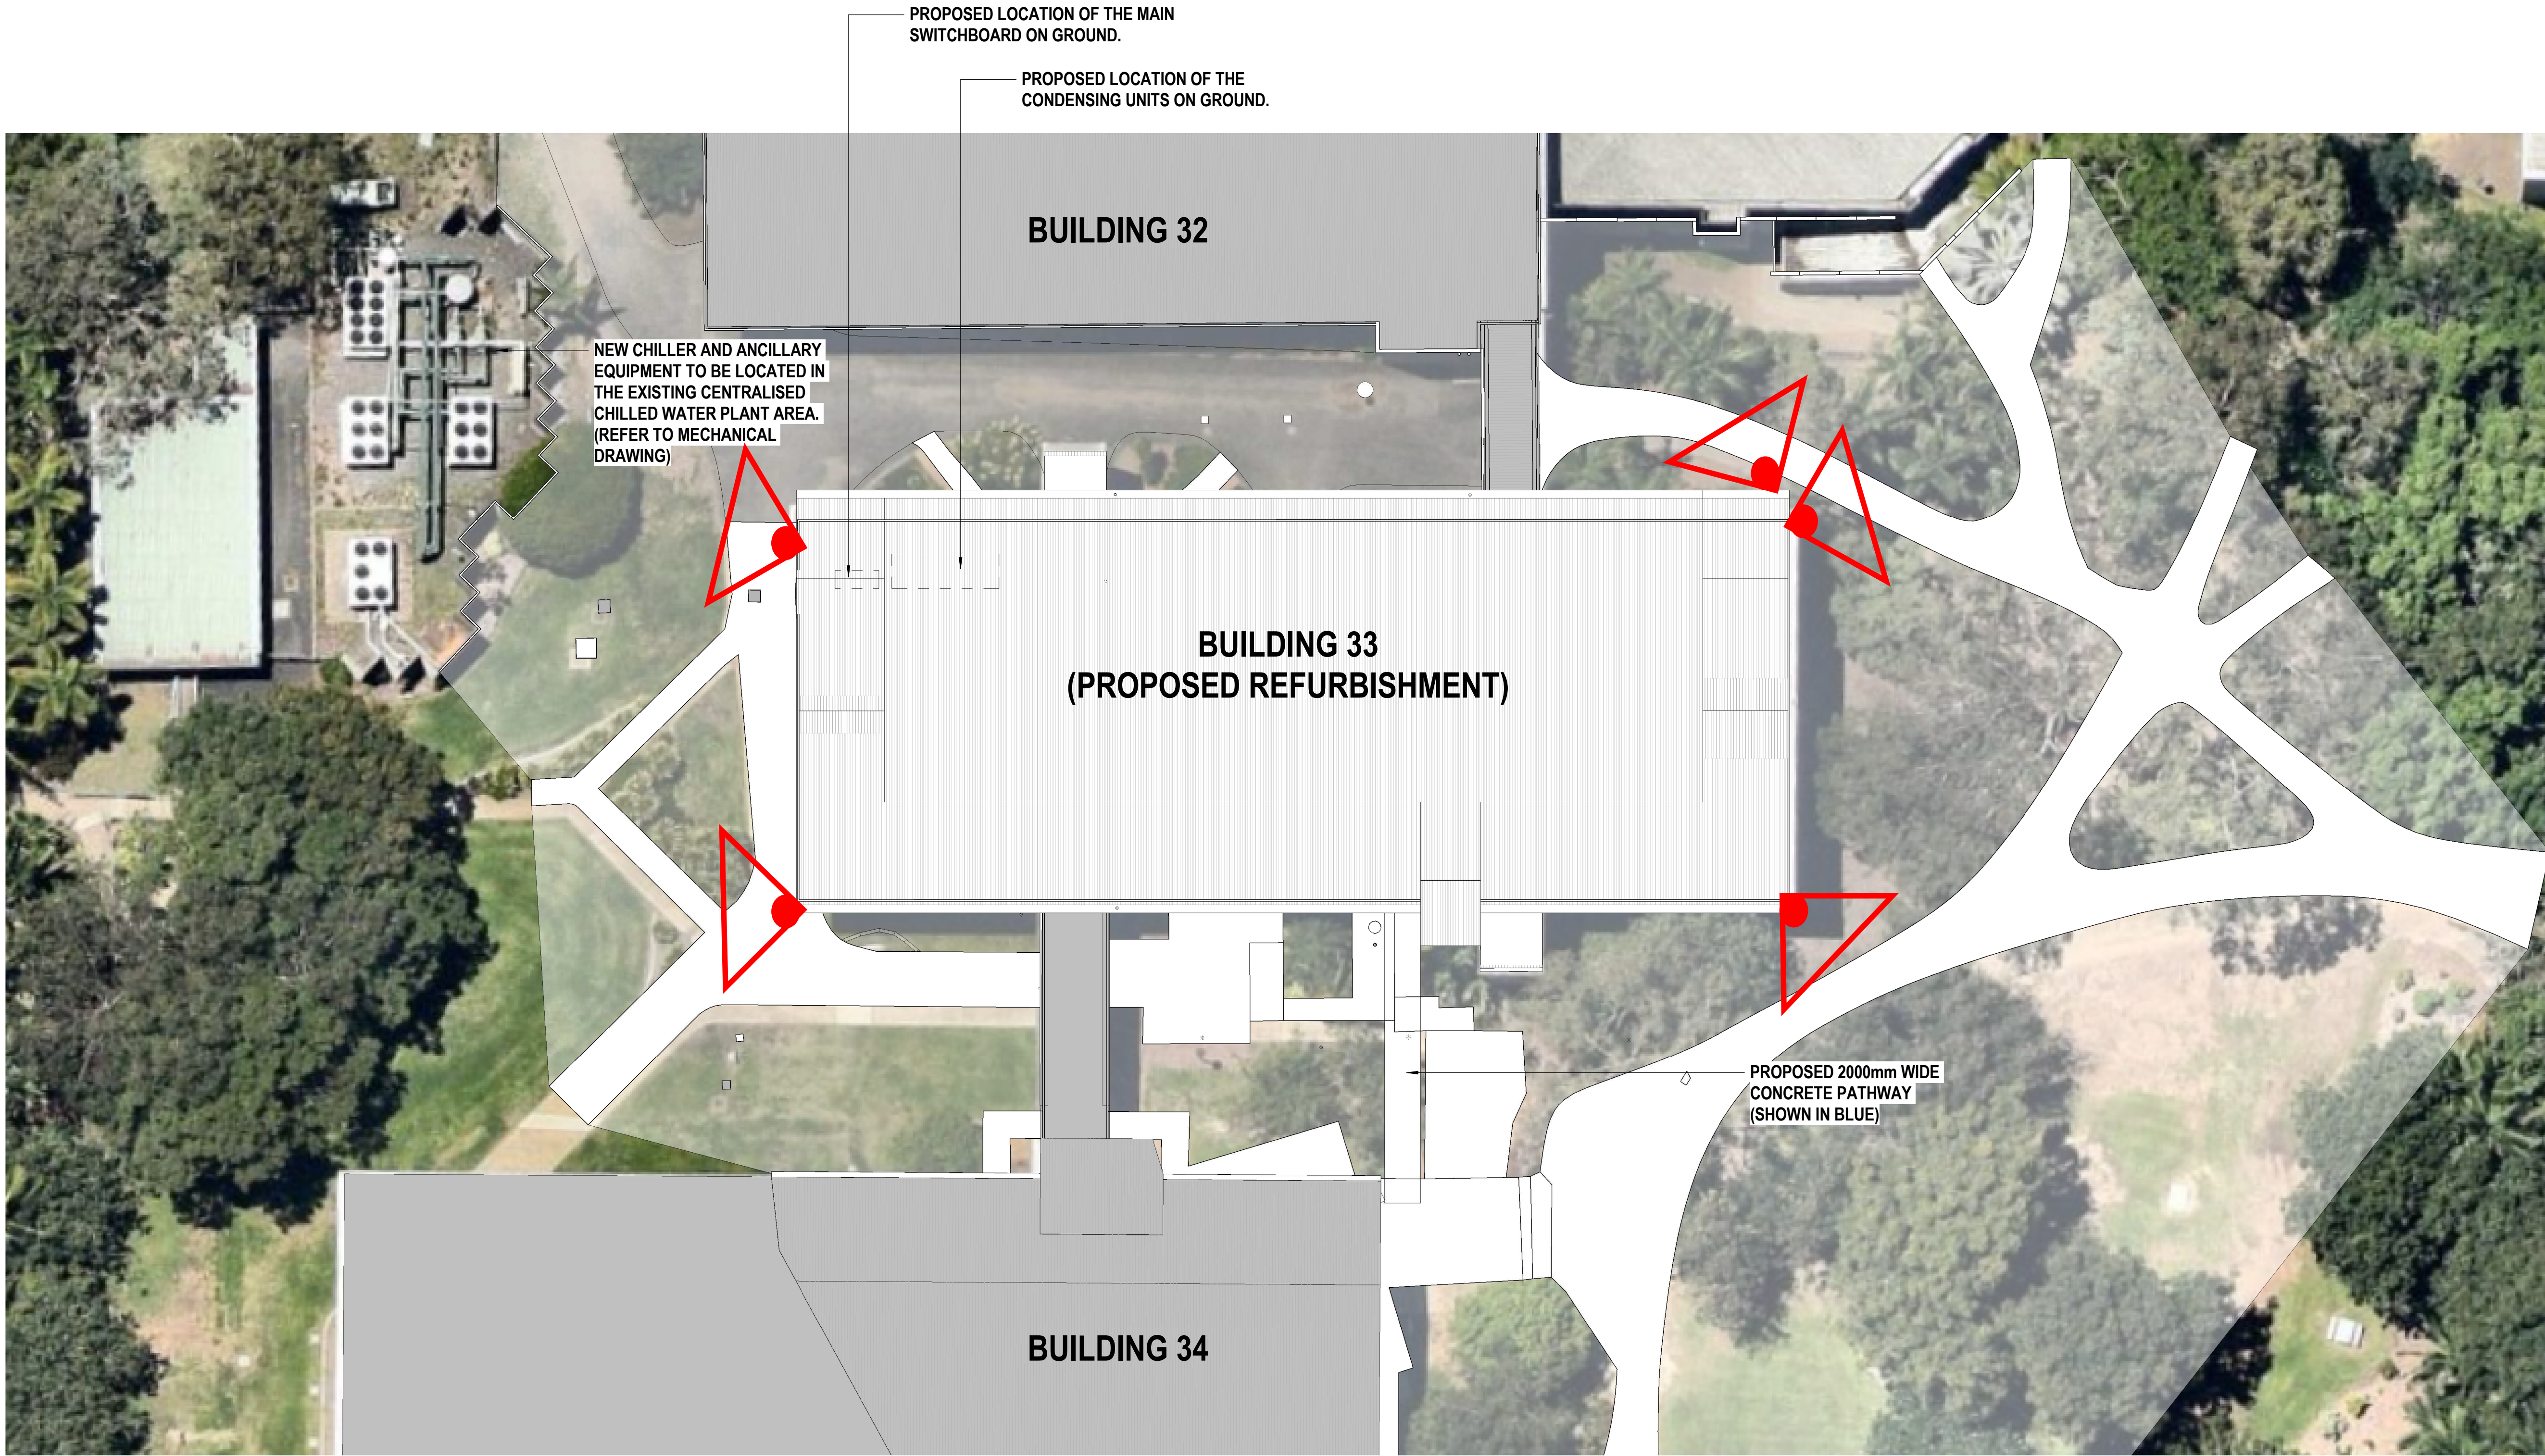

GENERAL NOTE

- REFER TO SURVEY DRAWINGS FOR MORE INFORMATION ON SITE FEATURES, CONDITIONS AND SERVICES.
- CONTRACTOR TO CONFIRM EXISTING STRUCTURES AND SERVICES ON SITE PRIOR TO BUILDING WORK.
- REFER TO LANDSCAPE AND CIVIL DRAWINGS FOR EXTENT OF EXTERNAL WORKS.

ISSUED FOR TENDER

**thomson
adsett**

PEDDLE THORP
architecture | interiors | health | planning

Telephone +61 7 3840 9999
bne@thomsonadsett.com
Level 9, 470 St Pauls Terrace
Fortitude Valley
Qld 4006 Australia
thomsonadsett.com

© Copyright
These drawings and designs and the copyright thereof are the property of Thomson Adsett Pty Ltd and must not be used, retained or copied without written permission of Thomson Adsett Pty Ltd. ABN 76 105 314 654 Trading as ThomsonAdsett. Dimensions take precedence over scaling. Do not measure off drawings as print sizes may vary

**CQU ROCKHAMPTON
TAFE
CONSOLIDATION -
STAGE 2**


554/700 Yaamba Rd, Norman
Gardens QLD 4701

for

**CQUniversity
AUSTRALIA**

B	2026-03-05	ISSUED FOR TENDER	BC
A	2026-02-12	ISSUED FOR TENDER	BC
1	2026-01-30	60% DRAFT ISSUE	BC
rev	date	details	init.

drawn	date
JS/BC	19/01/2026
checked	date
BC	12/02/2026
verified	date

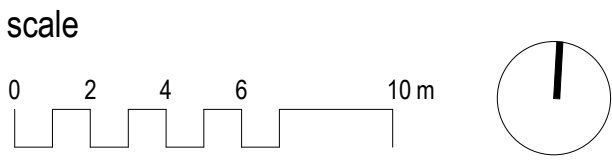

**SITE CONTEXT PLAN -
BUILDING 33**


scale
As indicated @ A1

project no.
25.0236.17

revision
B

sheet no.
CQU-ROK-033-00-ARC-10-00

ROK033 Level 1
6 Internal

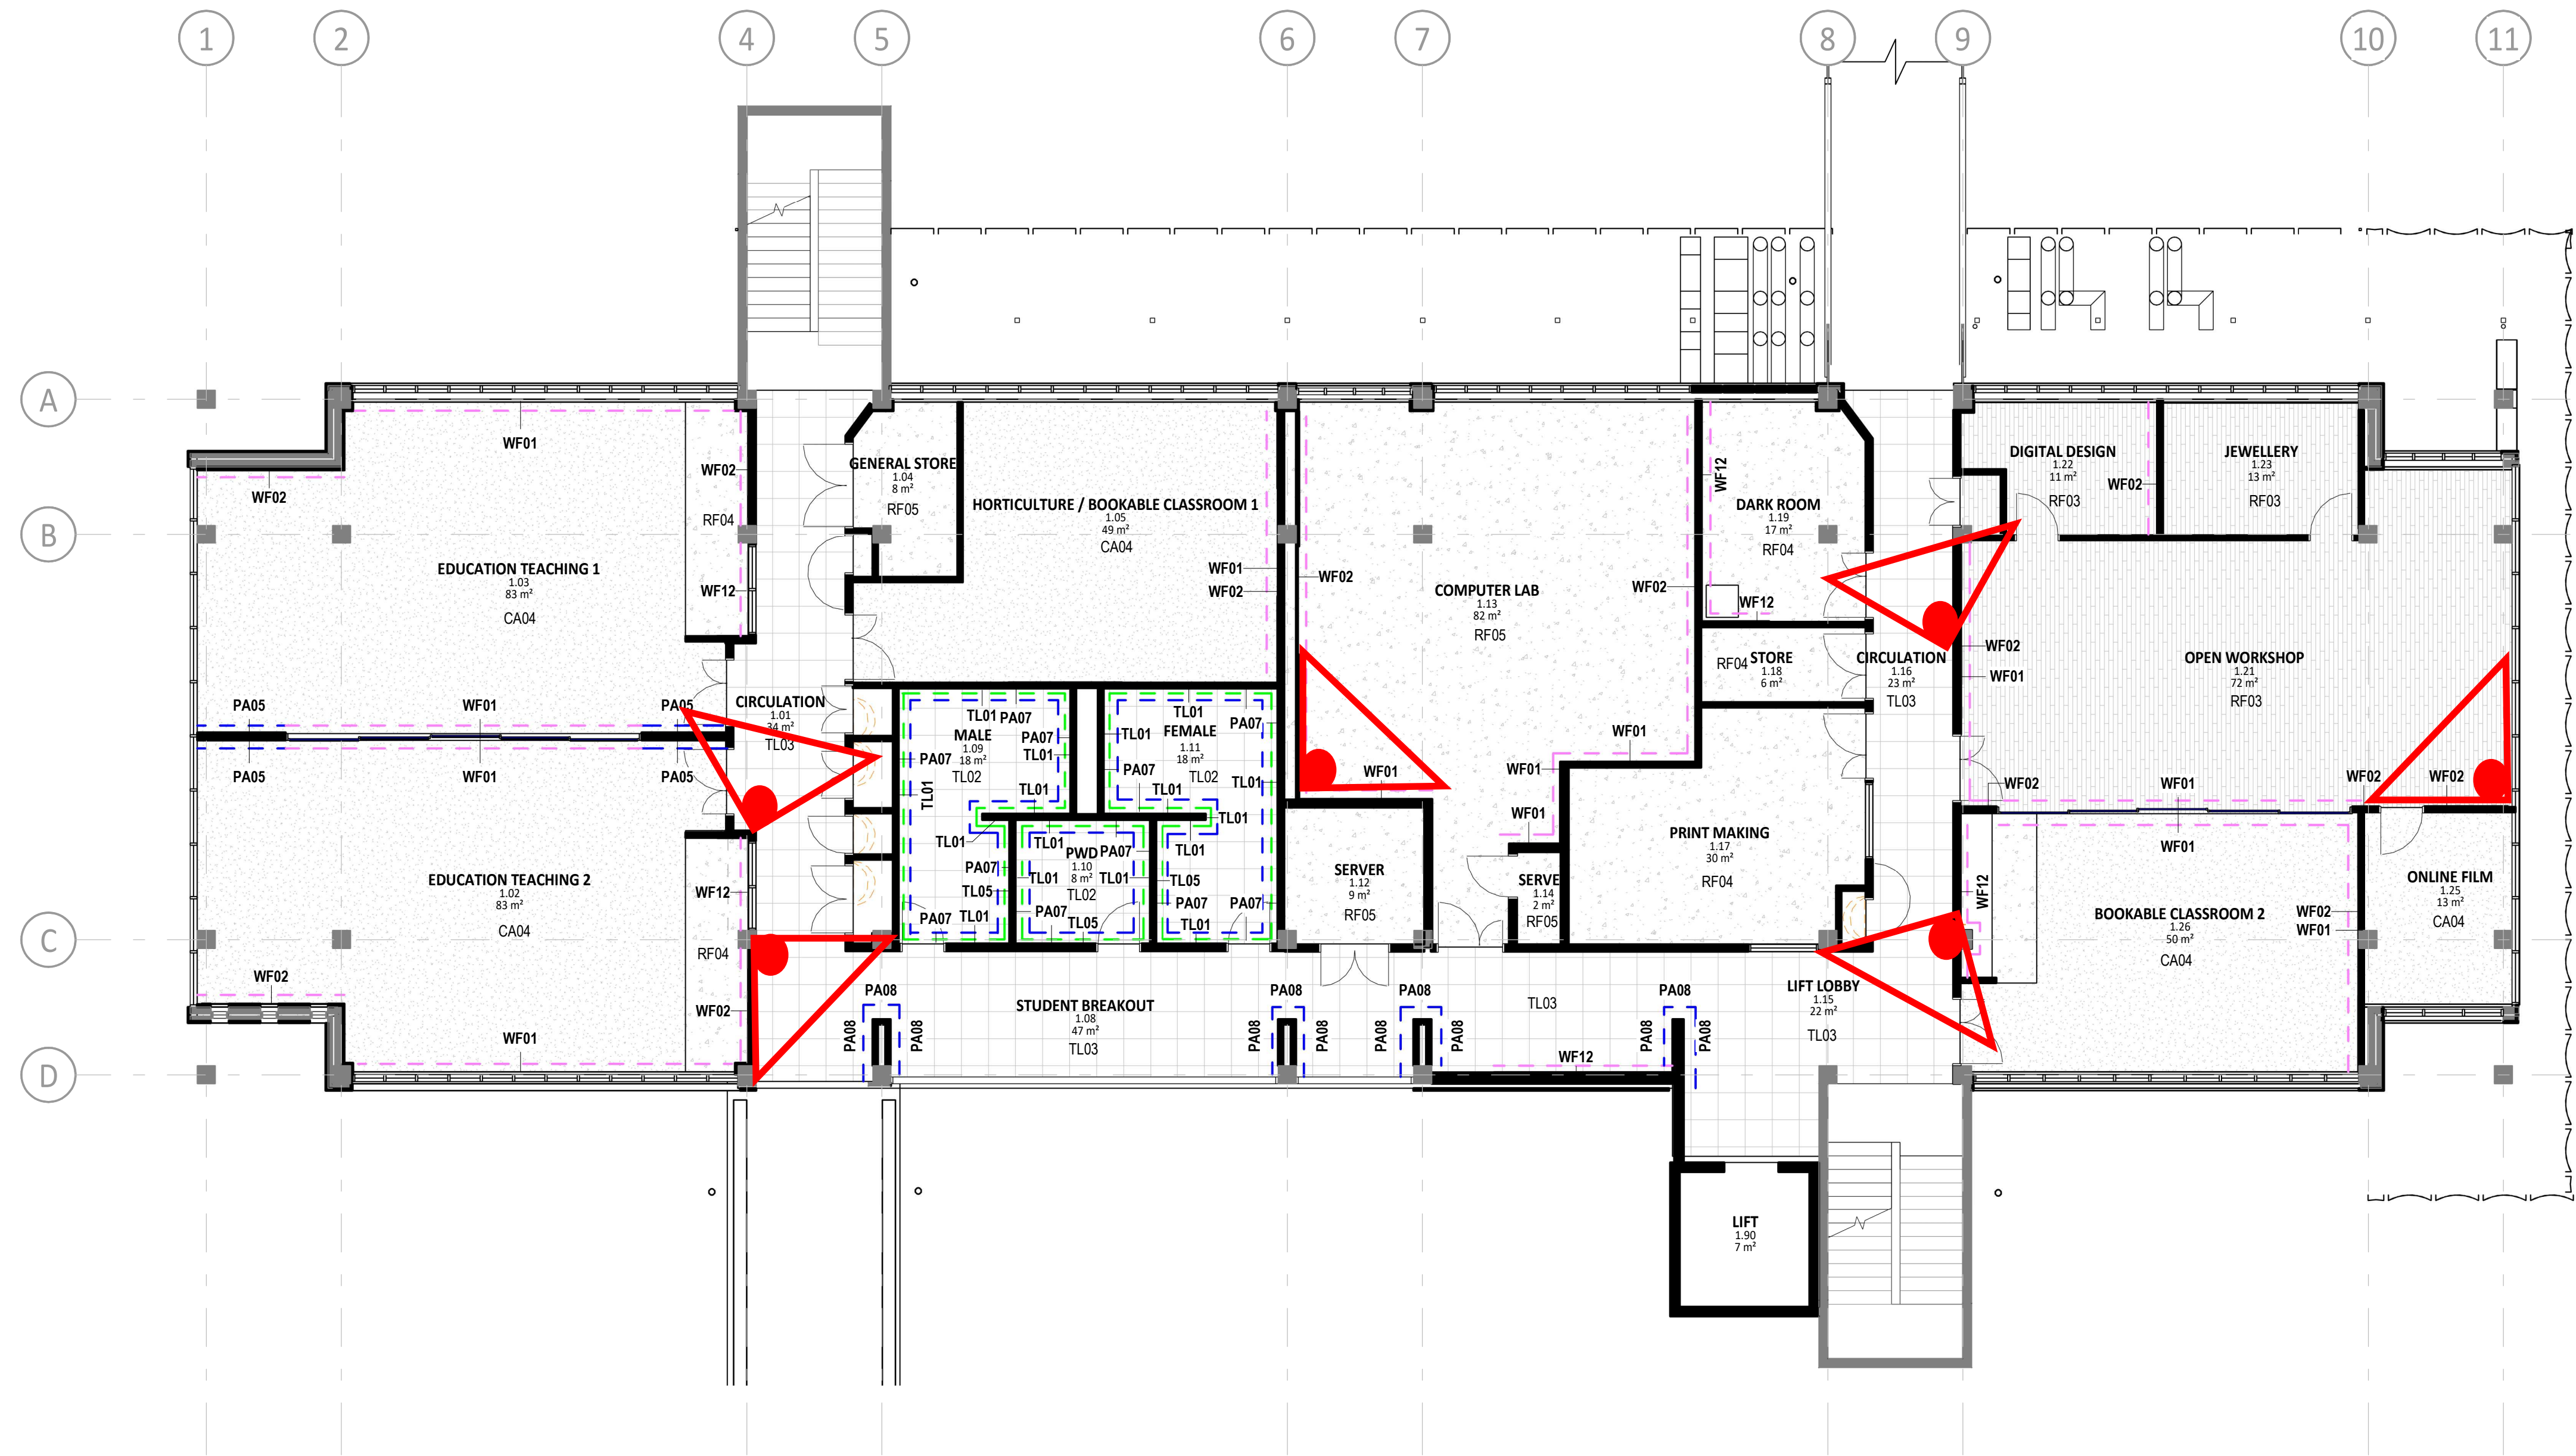

GENERAL NOTES:

- THIS DRAWING IS TO BE READ IN CONJUNCTION WITH ALL PROJECT DRAWINGS, SCHEDULES AND SPECIFICATIONS, PLUS ALL OTHER RELEVANT CONSULTANT DOCUMENTS.
- ALL WORKS TO COMPLY WITH BCA AND AUSTRALIAN STANDARDS.
- ANY DISCREPANCIES ON THE DRAWINGS OR IRREGULARITIES BETWEEN INFORMATION SHOWN ON INTERIOR DRAWINGS AND SERVICES CONSULTANTS DOCUMENTS ARE TO BE REFERRED TO THE DESIGNER FOR CLARIFICATION PRIOR TO THE WORKS PROCEEDING.
- ALL DIMENSIONS AND AREAS PROVIDED TO BE CONFIRMED ON SITE PRIOR TO COMMENCEMENT OF WORKS

FINISHES NOTES:

- ALL JUNCTIONS IN FLOOR FINISHES TO BE FLUSH.
- CHANGES TO FLOOR FINISH TO OCCUR UNDER THE CENTRE LINE OF THE DOOR LEAF UNLESS NOTED OTHERWISE.
- ALL WALLS TO BE PA01 UNLESS OTHERWISE NOTED.
- ALL SOLID CORE DOORS TO BE PA11 UNLESS OTHERWISE NOTED.
- REFER 60 SERIES DRAWINGS & SCH-INT-01 INTERIOR FINISHES SCHEDULE FOR SKIRTING TYPES AND SPECIFICATION. ALL WALLS TO RECEIVE SK01 SKIRTING UNLESS NOTED OTHERWISE.
- NEW SKIRTING TO MATCH EXISTING WHERE RELEVANT.
- ALL DOOR STATUTORY SIGNAGE AND ROOM SIGNAGE TO BE REMOVED BEFORE PAINTING.
- ALL WINDOW FURNISHING TO BE REMOVED BEFORE PAINTING, CLEANED AND REINSTALLED.
- FLOOR FINISHES TO CONTINUE UNDER NEW JOINERY.

FINISHES LEGEND

- REFER SCH-INT-01 FINISHES SCHEDULE AND 60 SERIES DRAWINGS FOR FURTHER DETAILS AND SPECIFICATION
- PA## FEATURE WALL PAINT
 - TL## WALL TILE
 - WF## WALL FINISH
 - CA## CARPET FLOOR FINISH
 - RF## RESILIENT FLOOR FINISH
 - TL## TILE FLOOR FINISH

ISSUE FOR TENDER

FINISHES PLAN - BLD33-L1

scale project no.
1 : 100 @ A1 260018
revision
A
sheet no.

CQU-ROK-033-01-ARC-28-01

original sheet size - A1 (594mm x 841mm)

thomson
adsett



Telephone +61 7 3840 9999
bne@thomsonadsett.com
Level 9, 470 St Pauls Terrace
Fortitude Valley
Qld 4006 Australia
thomsonadsett.com

© Copyright
These drawings and designs and the copyright thereof are the property of Thomson Adsett Pty Ltd and must not be used, retained or copied without written permission of Thomson Adsett Pty Ltd. ABN 76 105 314 654 Trading as ThomsonAdsett. Dimensions take precedence over scaling. Do not measure off drawings as print sizes may vary

CQU ROCKHAMPTON
TAFE
CONSOLIDATION -
STAGE 2


554/700 Yaamba Rd, Norman
Gardens QLD 4701

for



A	12/02/26	ISSUED FOR TENDER	SM
1	30/01/26	60% DRAFT ISSUE	SM
rev/	date	details	init.

drawn	date
PT/TA	
checked	date
SZ	
verified	date

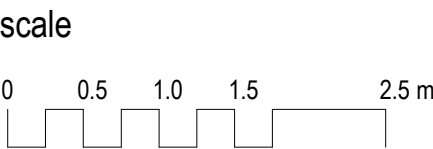

NOTE: PLAN TO BE PRINTED IN COLOUR

ROK033 Level 2
6 Internal

thomson
adsett




PEDDLE THORP
architecture | interiors | health | planning

Telephone +61 7 3840 9999
bne@thomsonadsett.com
Level 9, 470 St Pauls Terrace
Fortitude Valley
Qld 4006 Australia
thomsonadsett.com

© Copyright
These drawings and designs and the copyright thereof are the property of Thomson Adsett Pty Ltd and must not be used, retained or copied without written permission of Thomson Adsett Pty Ltd. ABN 76 105 314 654 Trading as ThomsonAdsett. Dimensions take precedence over scaling. Do not measure off drawings as print sizes may vary

CQU ROCKHAMPTON
TAFE
CONSOLIDATION -
STAGE 2
554/700 Yaamba Rd, Norman
Gardens QLD 4701

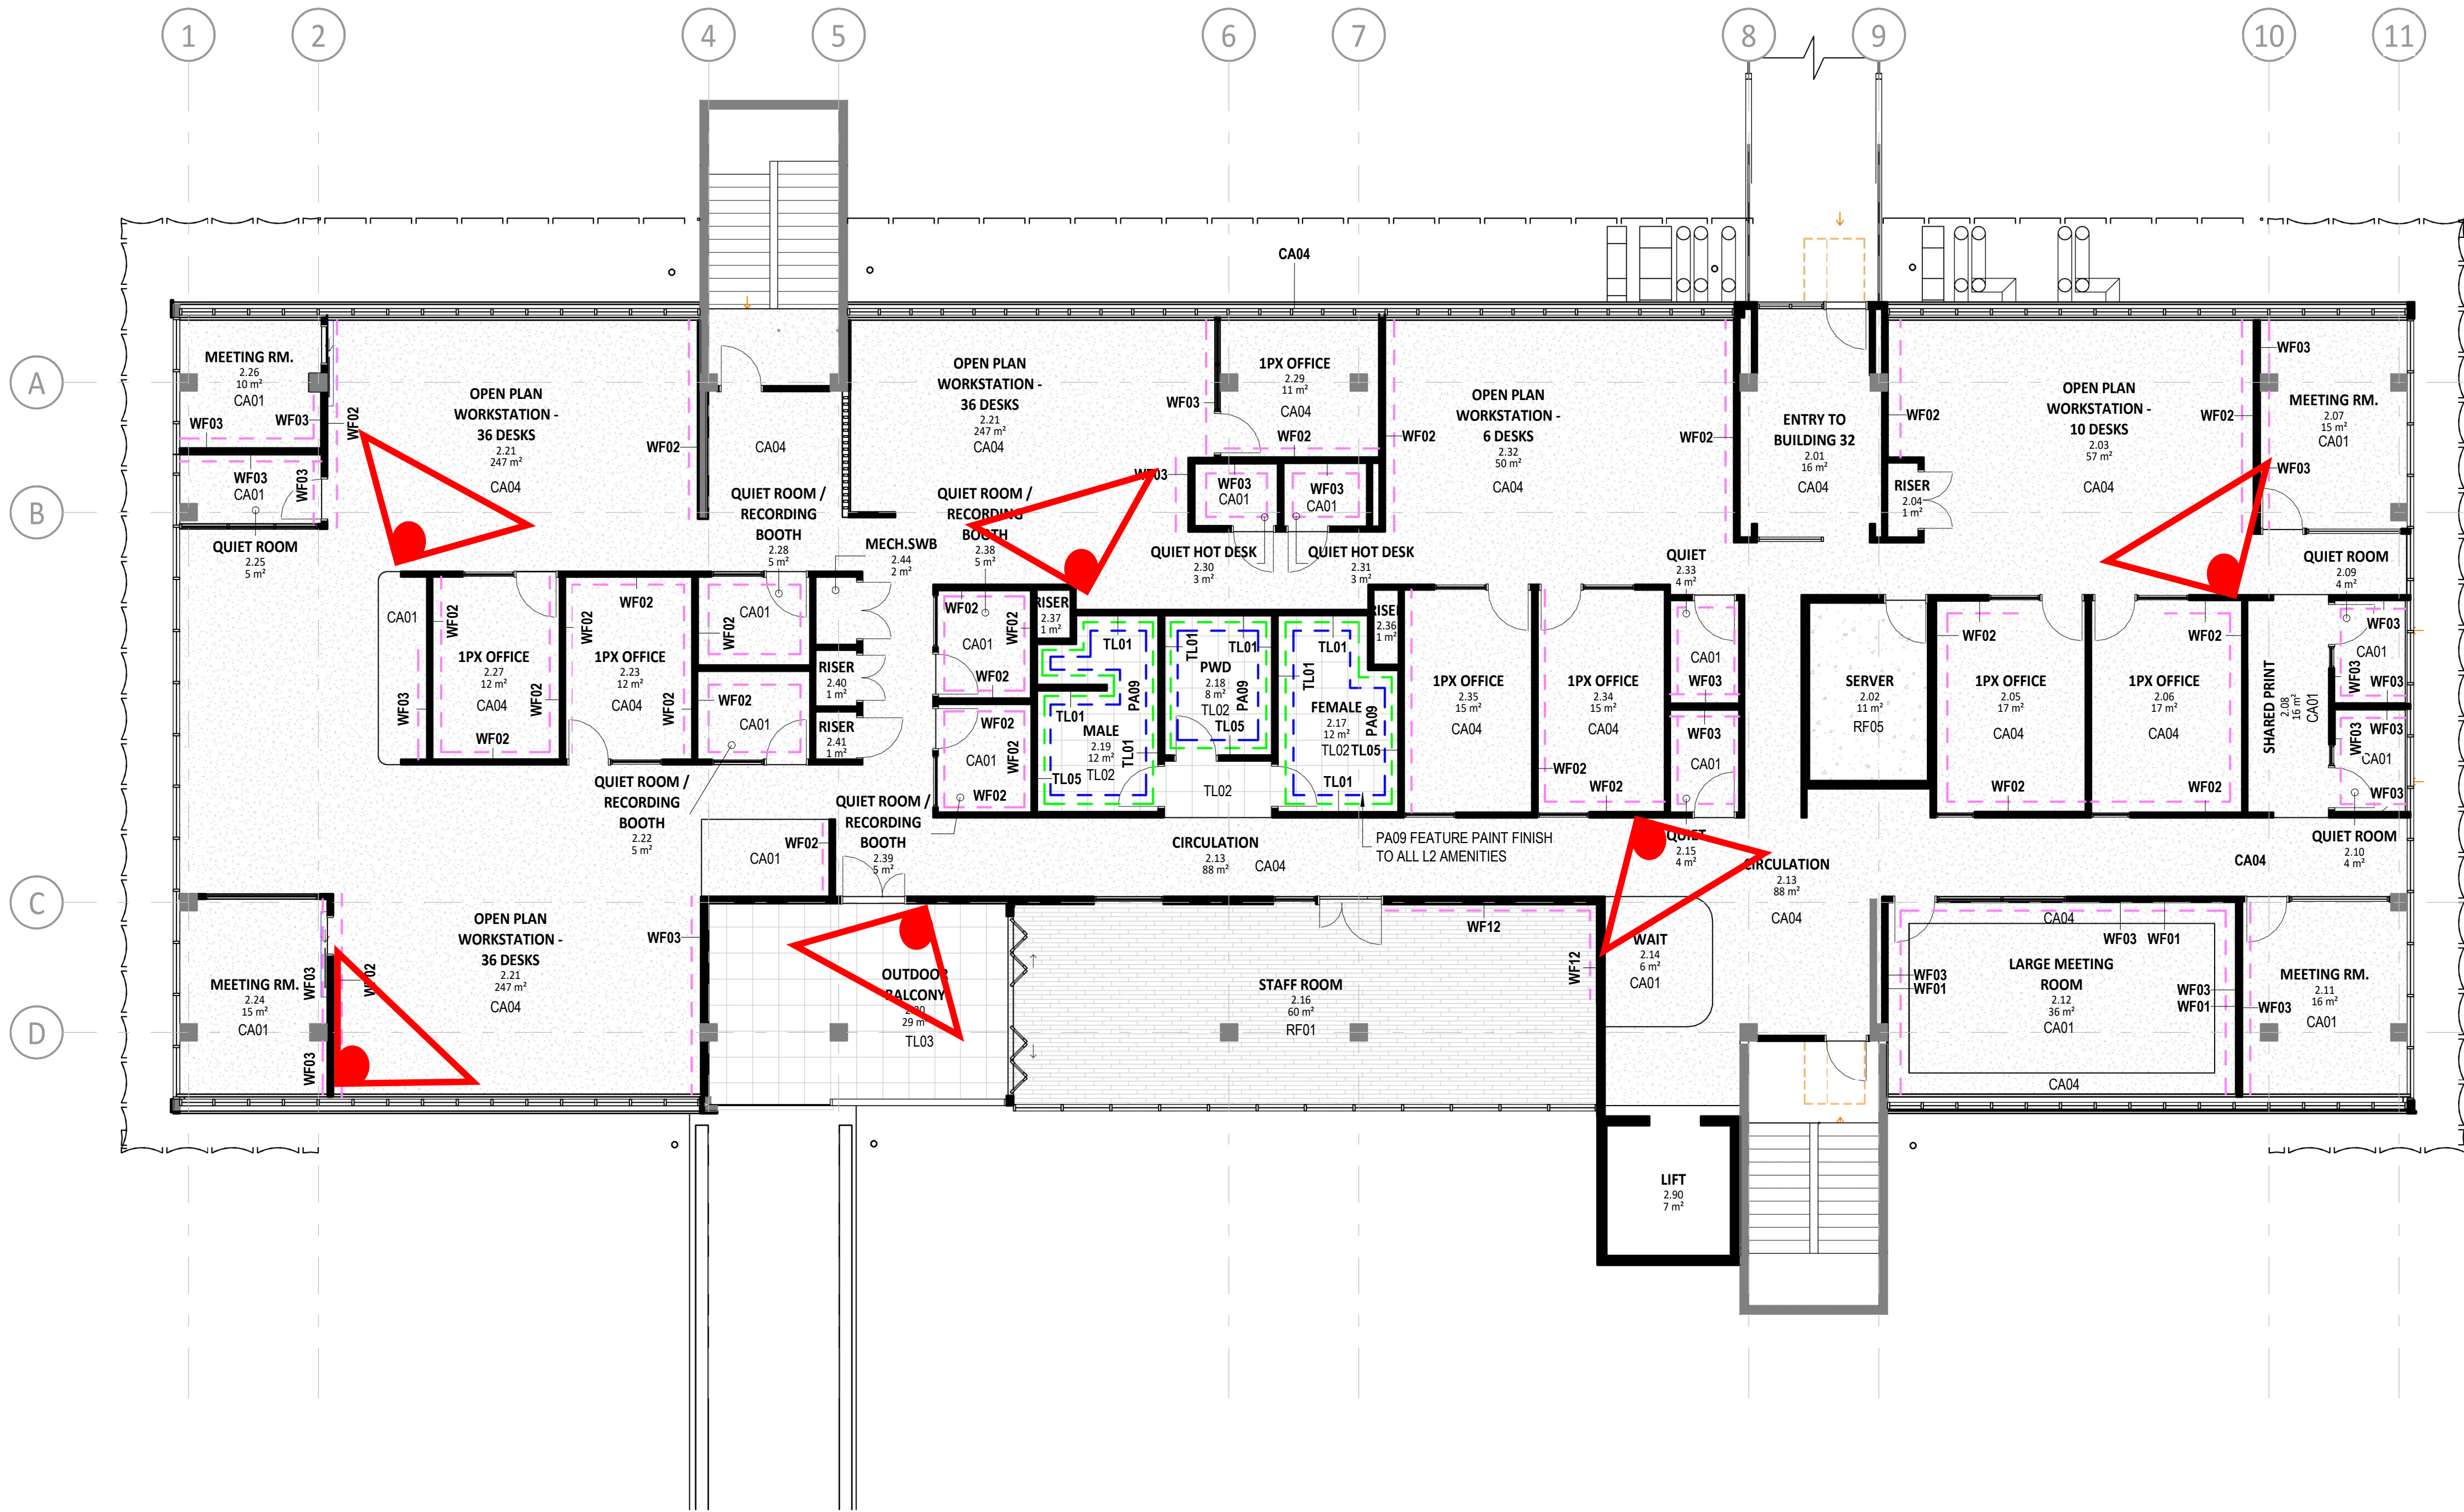

GENERAL NOTES:

- THIS DRAWING IS TO BE READ IN CONJUNCTION WITH ALL PROJECT DRAWINGS, SCHEDULES AND SPECIFICATIONS, PLUS ALL OTHER RELEVANT CONSULTANT DOCUMENTS.
- ALL WORKS TO COMPLY WITH BCA AND AUSTRALIAN STANDARDS.
- ANY DISCREPANCIES ON THE DRAWINGS OR IRREGULARITIES BETWEEN INFORMATION SHOWN ON INTERIOR DRAWINGS AND SERVICES CONSULTANTS DOCUMENTS ARE TO BE REFERRED TO THE DESIGNER FOR CLARIFICATION PRIOR TO THE WORKS PROCEEDING.
- ALL DIMENSIONS AND AREAS PROVIDED TO BE CONFIRMED ON SITE PRIOR TO COMMENCEMENT OF WORKS

FINISHES NOTES:

- ALL JUNCTIONS IN FLOOR FINISHES TO BE FLUSH.
- CHANGES TO FLOOR FINISH TO OCCUR UNDER THE CENTRE LINE OF THE DOOR LEAF UNLESS NOTED OTHERWISE.
- ALL WALLS TO BE PA01 UNLESS OTHERWISE NOTED.
- ALL SOLID CORE DOORS TO BE PA11 UNLESS OTHERWISE NOTED.
- REFER 60 SERIES DRAWINGS & SCH-INT-01 INTERIOR FINISHES SCHEDULE FOR SKIRTING TYPES AND SPECIFICATION. ALL WALLS TO RECEIVE SK01 SKIRTING UNLESS NOTED OTHERWISE.
- NEW SKIRTING TO MATCH EXISTING WHERE RELEVANT.
- ALL DOOR STATUTORY SIGNAGE AND ROOM SIGNAGE TO BE REMOVED BEFORE PAINTING.
- ALL WINDOW FURNISHING TO BE REMOVED BEFORE PAINTING, CLEANED AND REINSTALLED.
- FLOOR FINISHES TO CONTINUE UNDER NEW JOINERY.


FINISHES LEGEND

REFER SCH-INT-01 FINISHES SCHEDULE AND 60 SERIES DRAWINGS FOR FURTHER DETAILS AND SPECIFICATION

- PA## FEATURE WALL PAINT
- TL## WALL TILE
- WF## WALL FINISH
- CA## CARPET FLOOR FINISH
- RF## RESILIENT FLOOR FINISH
- TL## TILE FLOOR FINISH

B	05/03/26	ISSUED FOR TENDER	BS
A	12/02/26	ISSUED FOR TENDER	SM
1	30/01/26	60% DRAFT ISSUE	SM
rev/	date	details	init.

drawn	date
PT/TA	27/01/26
checked	date
SZ	27/01/26
verified	date
	27/01/26

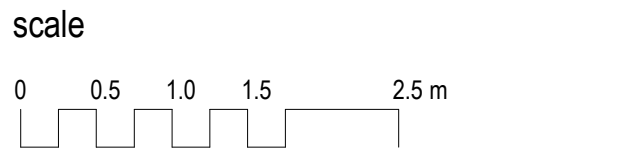

FINISHES PLAN - BLD33-L2

scale	project no.
1 : 100 @ A1	260018
revision	
B	
sheet no.	
CQU-ROK-033-01-ARC-28-02	

ISSUE FOR TENDER

NOTE: PLAN TO BE PRINTED IN COLOUR

**CQU ROCKHAMPTON
TAFE
CONSOLIDATION -
STAGE 2**

554/700 Yaamba Rd, Norman
Gardens QLD 4701

for



CQUniversity
AUSTRALIA

B	2026-03-05	ISSUED FOR TENDER	BC
A	2026-02-12	ISSUED FOR TENDER	BC
2	2026-01-30	60% DRAFT ISSUE	BC
1	2026-01-22	CONSULTANT ISSUE	BC

rev	date	details	init.
-----	------	---------	-------

drawn	date
JT/JS	19/01/2026
checked	date
SS	12/02/2026
verified	date

scale



0 1.0 2 3 5 m

**FLOOR & CEILING PLAN -
GROUND G.08 - PROPOSED**

scale	project no.
As indicated @ A1	25.0236.17


B

sheet no.

CQU-ROK-034-GN-ARC-21-0


original sheet size - A1 (594mm x 841mm)

3 External

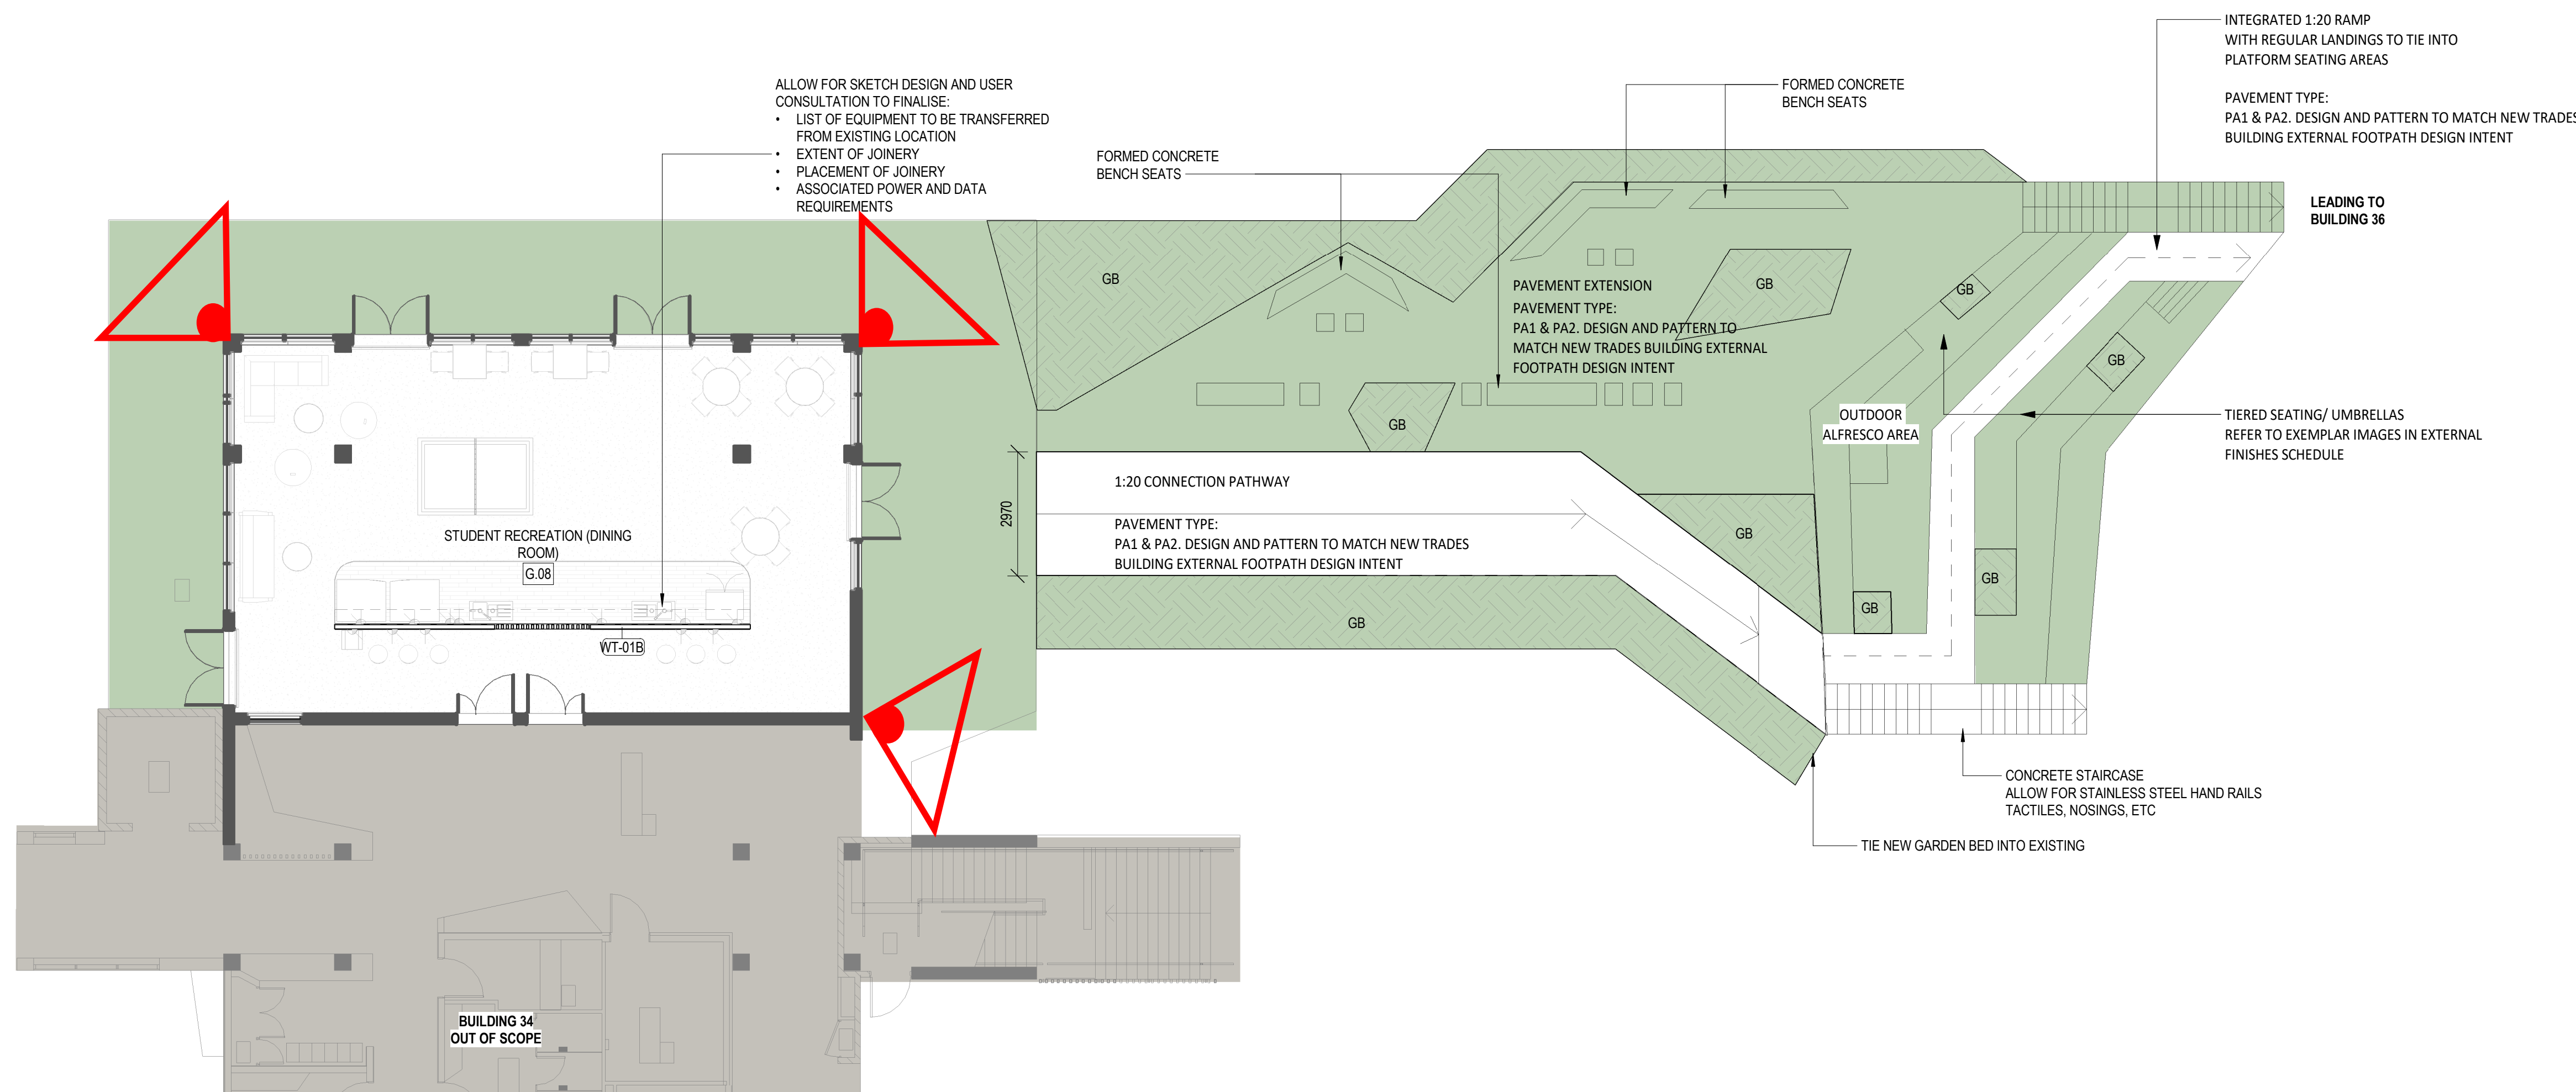

1
31-00

GROUND FLOOR - PROPOSED
1 : 100

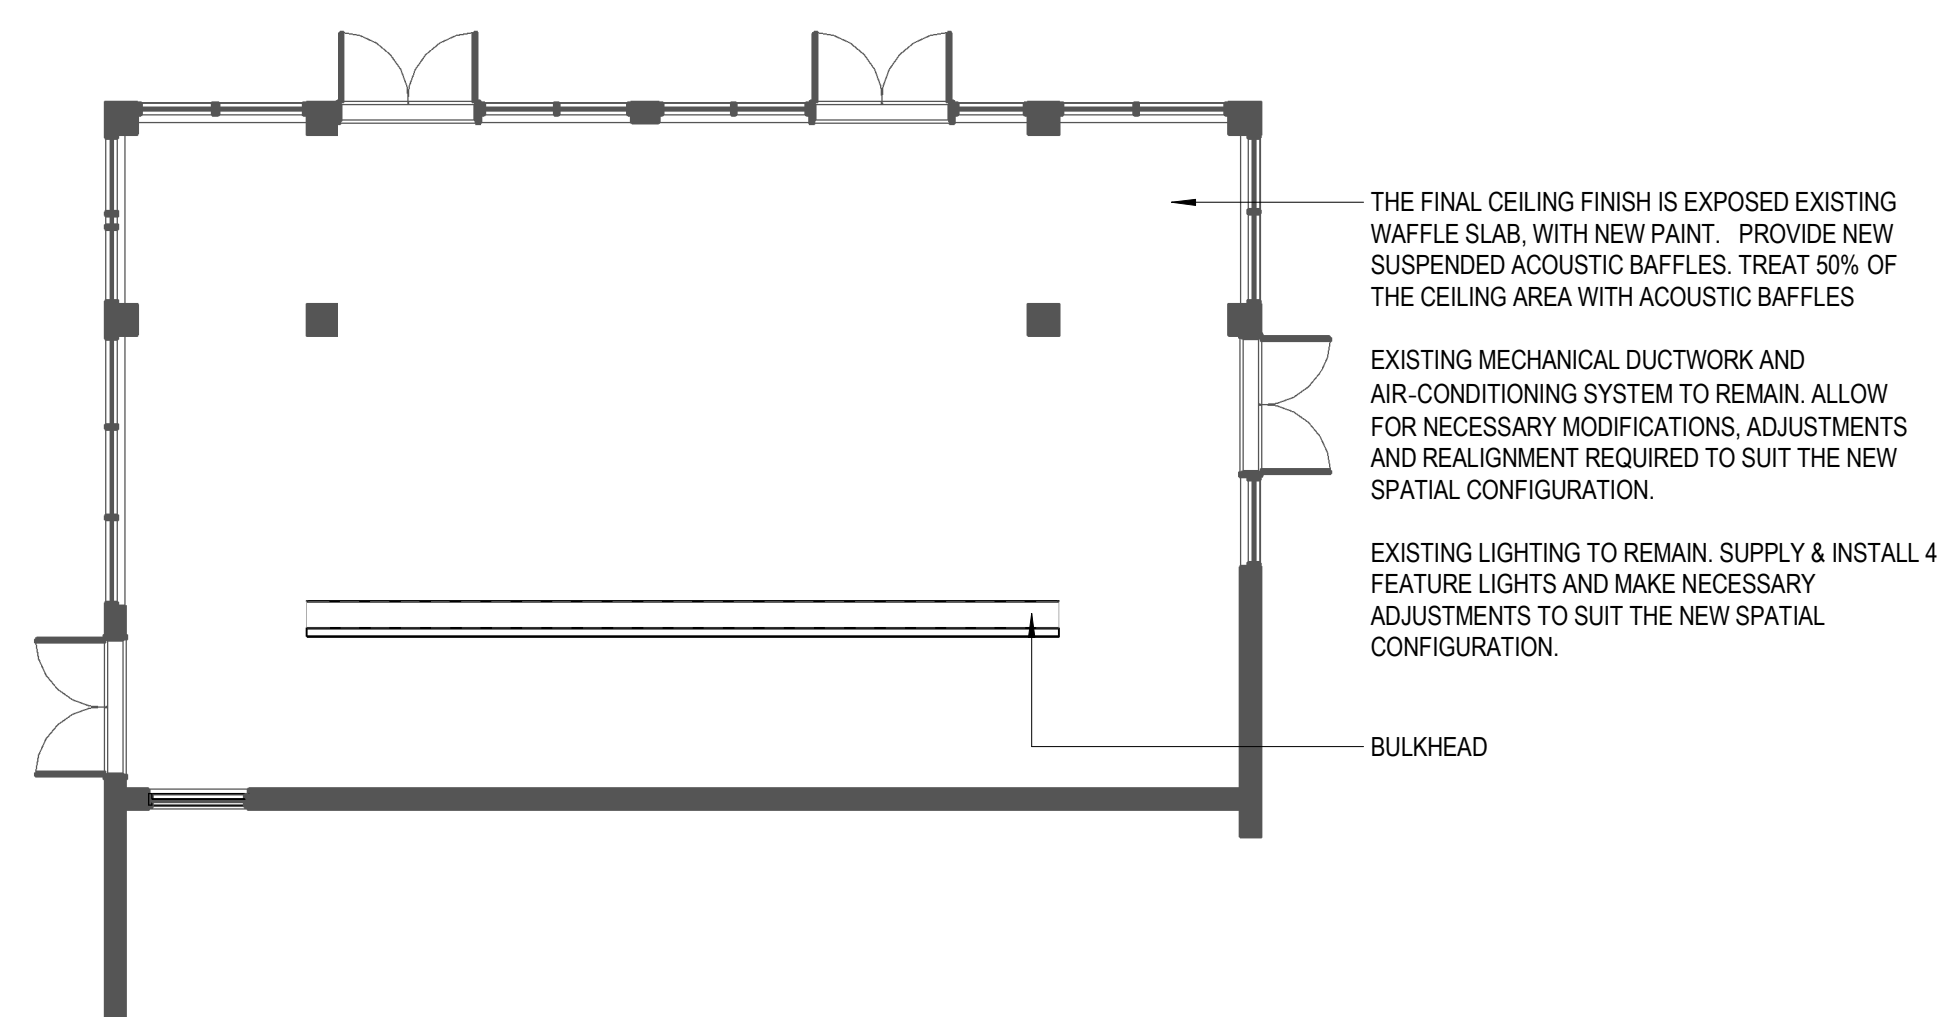

2 GROUND FLOOR - CEILING PLAN - GROUND FLOOR
31-00 1 : 100

WALL LEGEND

WT-01B_SF 92_PB 13 / PB WP 13

13 92 13

WT-01B

13mm PLASTERBOARD LINING, FLUSH SET
92mm STEEL STUD
13mm WATERPROOF PLASTERBOARD LINING, FLUSH SET

SCOPE LEGEND

 INCLUDED SCOPE

 MASTER PLANNED SCOPE
CONTRACTOR TO PROVIDE A 'BELOW THE LINE' COST FOR THESE WORKS SHOWN IN GREEN HATCH. THIS ADDITIONAL SCOPE MAY BE INCLUDED. THESE 'FUTURE' WORKS DO NOT FORM PART OF THE CORE SCOPE OF WORKS REQUIRED FOR THE STAGE 2 TAPE CONSOLIDATION.

GB - GARDEN BED. CONTRACTOR TO ALLOW FOR LANDSCAPE DESIGN AND INSTALL BASED OFF LANDSCAPE ARCHITECT'S PLANTING PALETTE

CEILING LEGEND

2700 ← CEILING HEIGHT ABOVE FFL
CT1 ← CEILING FINISHES

CEILING LEGEND

C/TI-01	1200x600 CEILING TILES
C/TI-02	1200x600 ACOUSTIC CEILING TILES
C/PB-S1	FLUSH SET PLASTERBOARD SHEETING
C/PB-S2	WATERPROOF PLASTERBOARD SHEETING
C/FC-01	FLUSH SET FIBRE CEMENT SHEETING

	GENERAL NOTE
--	--------------

- INSTALL NEW WALL LINING. MAKE GOOD.
 - CONTRACTOR TO CONFIRM EXISTING STRUCTURE & SERVICES ON SITE PRIOR BUILDING WORKS.
 - REFER TO CQU DESIGN GUIDELINES FOR DESIGN AND CONSTRUCTION REQUIREMENTS.
 - DRAWINGS TO BE READ IN CONJUNCTION WITH SERVICES, CIVIL AND STRUCTURAL DRAWINGS.
 - REFER TO ROOM LAYOUT SHEET FOR EXTENT OF WORK INCLUDING GLAZED DOOR AND TO REFER FOR ALL FURNITURE SETOUT
 - REFER TO OUTLINE SPECIFICATION & SCHEDULE FOR FR&E AND FINISHES
- DOOR NOTES**
- CQU TO CONFIRM ACCESS REQUIREMENT FOR STUDENT RECREATION SPACE
 - PROVIDE DOOR CLOSERS TO ALL DOORS ENCLOSING AIR-CONDITIONED SPACES
- CEILING NOTES**
- READ IN CONJUNCTION WITH SERVICE ENGINEERING DRAWINGS FOR MECHANICAL, FIRE, ELECTRICAL AND ALIKE
 - SETOUT OF CEILING TILES TO BE CONFIRMED

INSULATION NOTE

- COMPLY WITH ACOUSTIC REPORT TO ACHIEVE THE NOMINATED ACOUSTIC RATING AND SECTION J REPORT FOR THE REQUIRED EXTERNAL WALLS R VALUES.
- COMPLY WITH THE CQU DESIGN GUIDELINES FOR MINIMUM ACOUSTIC SEPARATION BETWEEN ROOMS. WHERE THE ACOUSTIC REPORT NOMINATES HIGHER PERFORMANCE REQUIREMENTS, THE HIGHER RW RATINGS ARE TO APPLY.
- NEW STUD TO GO UP TO UNDERSIDE OF SLAB, UNLESS SPECIFIED.

SSUED FOR TENDER

[illegible]

GENERAL NOTE	
•	REFER TO SURVEY DRAWINGS FOR MORE INFORMATION ON SITE FEATURES, CONDITIONS AND SERVICES
•	CONTRACTOR TO CONFIRM EXISTING STRUCTURES AND SERVICES ON SITE PRIOR BUILDING WORK
•	REFER TO LANDSCAPE AND CIVIL DRAWINGS FOR EXTENT OF EXTERNAL WORKS

© Copyright
These drawings and designs and the copyright
thereof are the property of Thomson Adsett Pty
Ltd and must not be used, retained or copied
without written permission of Thomson Adsett
Pty Ltd. ABN 76 105 314 654 Trading as
ThomsonAdsett. Dimensions take precedence
over scaling. Do not measure off drawings as
print sizes may vary

554/700 Yaamba Rd, Norman
Gardens QLD 4701

B	2026-03-05	UPDATED ISSUED FOR TENDER	BC
A	2026-02-12	ISSUED FOR TENDER	BC
1	2026-01-30	60% DRAFT ISSUE	BC
rev	date	details	init.

drawn	date
JS/BC	19/01/2026
checked	date
SS	12/02/2026
verified	date

scale



scale	project no.
As indicated @ A1	25.0236.17

revision


B

sheet no.

CQU-ROK-036-00-ARC-10-00

5/03/2026 12:08:26 PM Autodesk Docs://CQU ROK TAFE/25.0236.17_CQU_BLDG-36_2025.m

ROK036 Level G
6 Internal

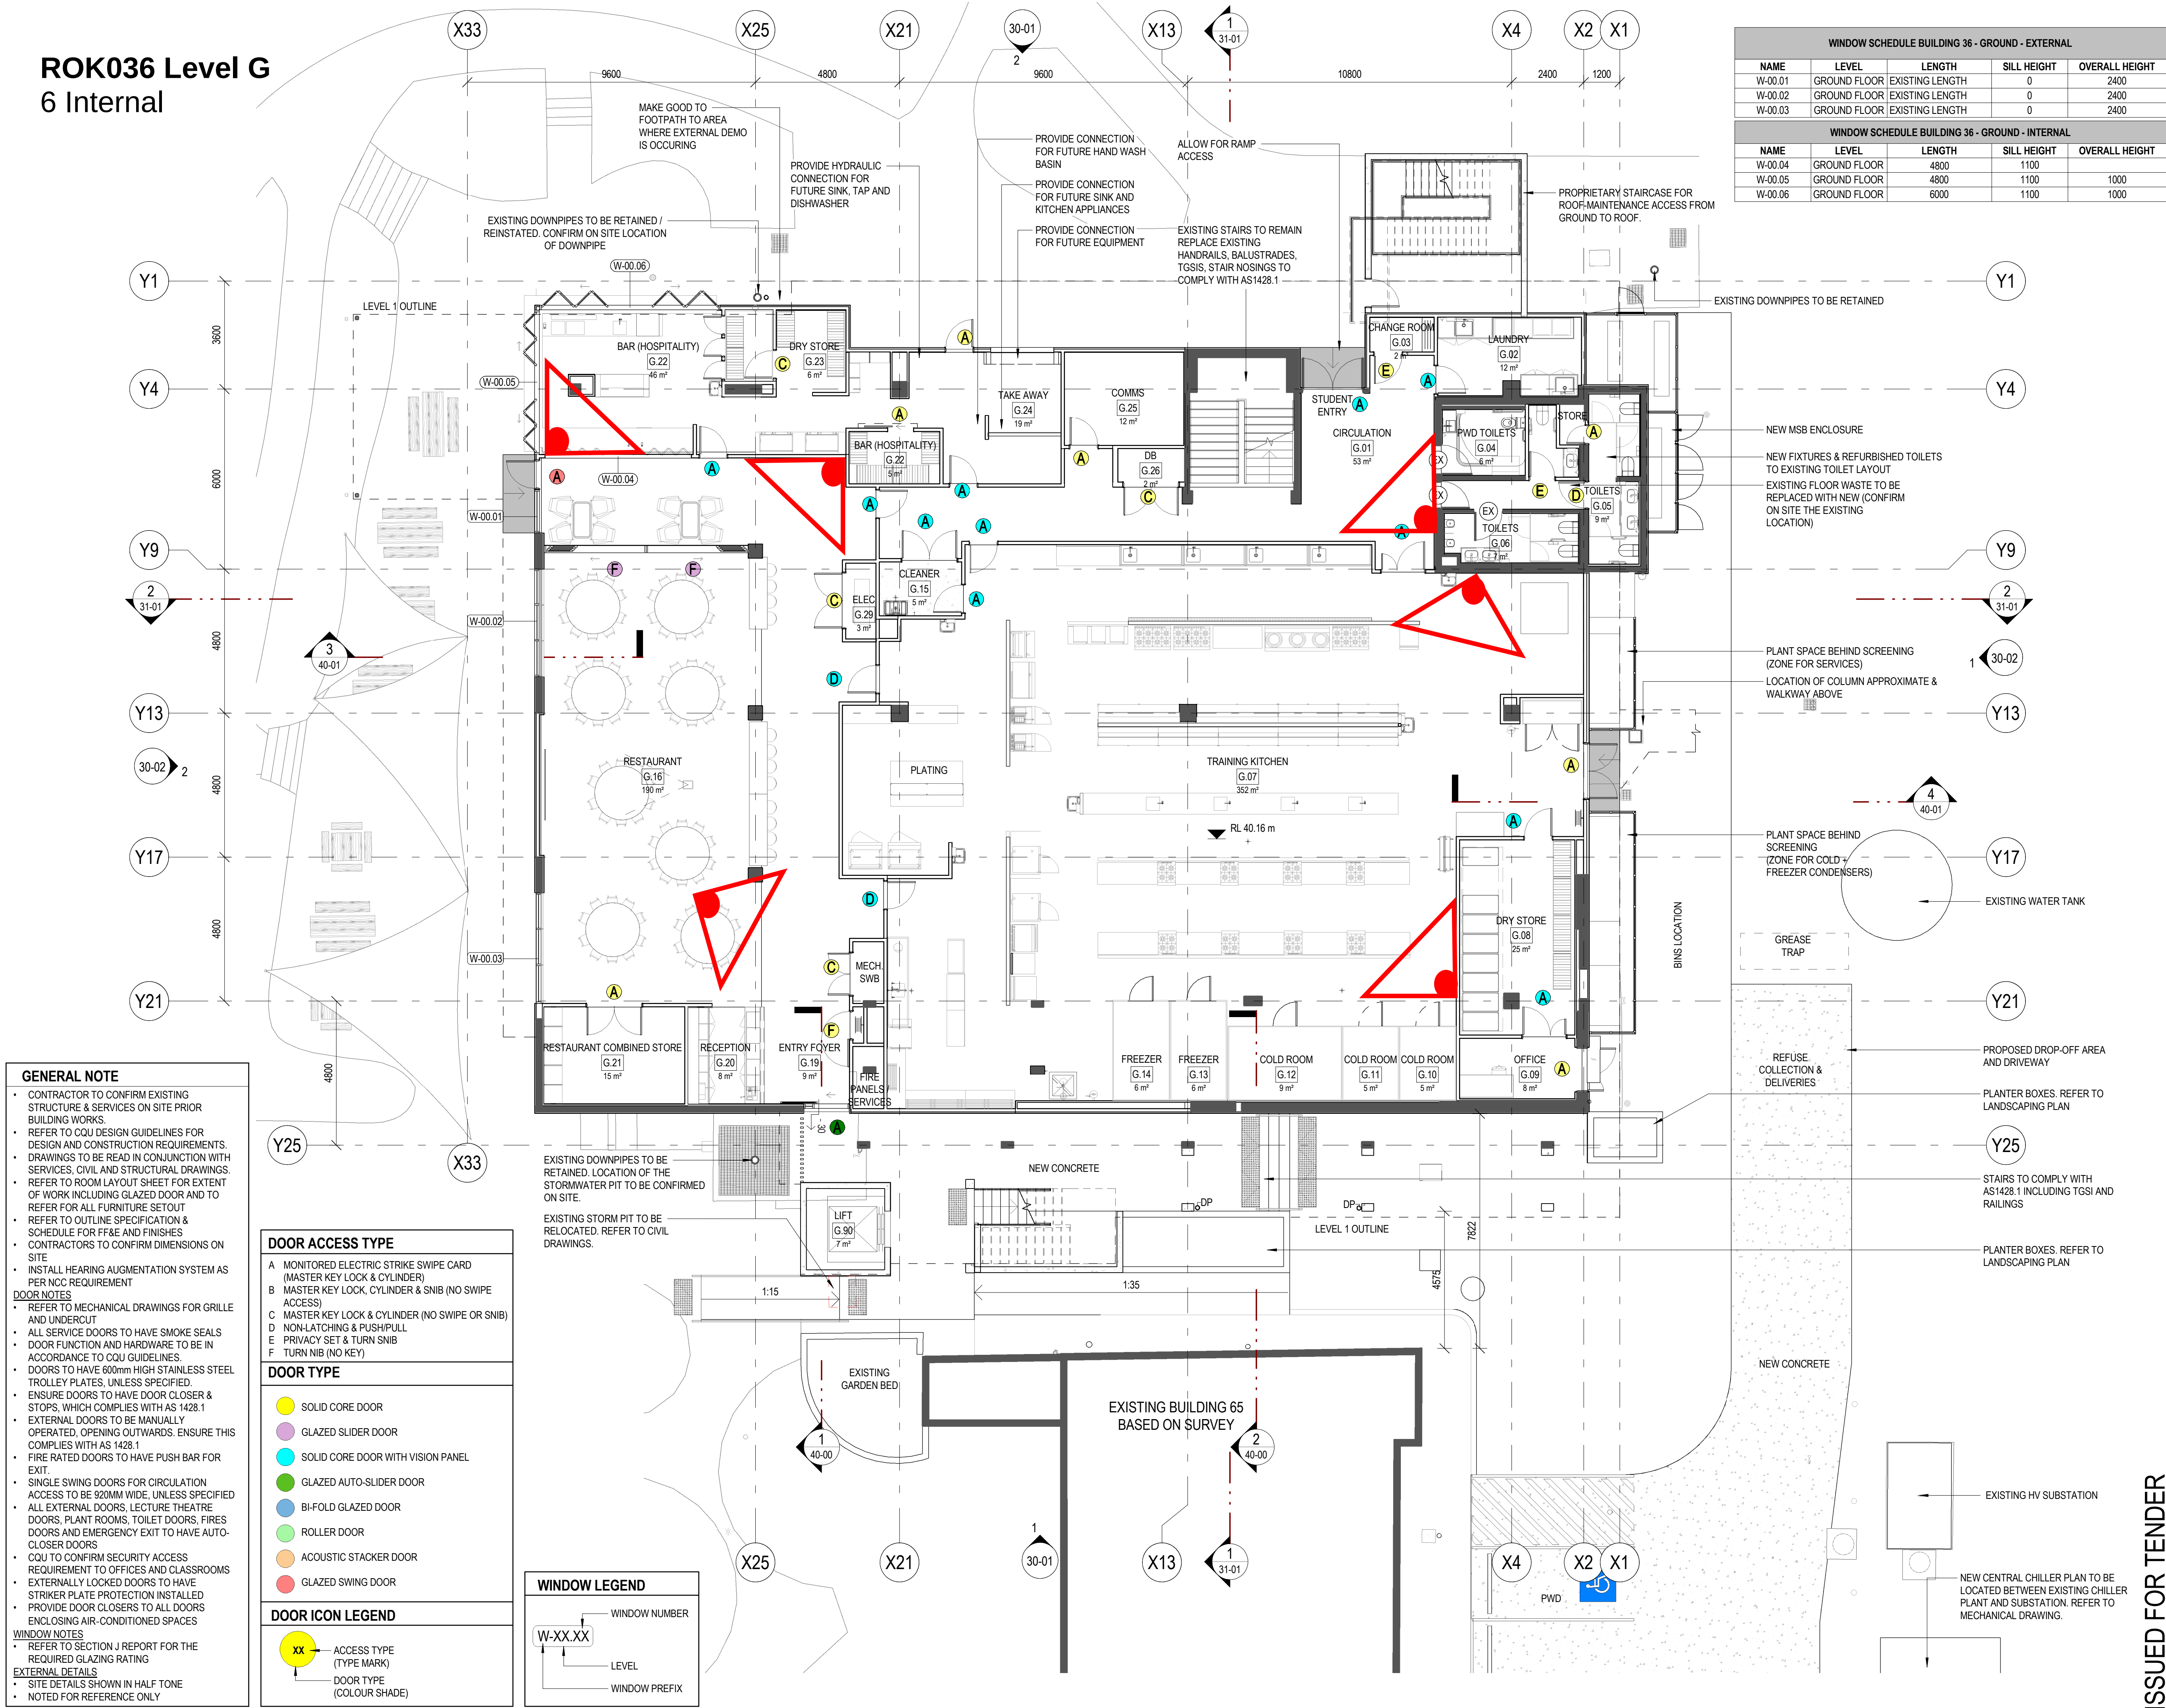

thomson
adsett

PEDDLE THORP
architecture | interiors | health | planning

Telephone +61 7 3840 9999
bne@thomsonadsett.com
Level 9, 470 St Pauls Terrace
Fortitude Valley
Qld 4006 Australia
thomsonadsett.com


© Copyright
These drawings and designs and the copyright thereof are the property of Thomson Adsett Pty Ltd and must not be used, retained or copied without written permission of Thomson Adsett Pty Ltd. ABN 76 105 314 654 Trading as ThomsonAdsett. Dimensions take precedence over scaling. Do not measure off drawings as print sizes may vary

**CQU ROCKHAMPTON
TAFE
CONSOLIDATION -
STAGE 2**
554/700 Yaamba Rd, Norman
Gardens QLD 4701



B	2026-03-05	UPDATED ISSUED FOR TENDER	BC
A	2026-02-12	ISSUED FOR TENDER	BC
4	2026-01-30	60% DRAFT ISSUE	BC
3	2026-01-23	CONSULTANTS ISSUE	BC
2	2025-12-19	UPDATED ISSUE	BC
1	2025-12-17	CONSULTANTS REVIEW	BC
rev	date	details	init.

drawn	date
JS/BC	19/01/2026
checked	date
SS	12/02/2026
verified	date

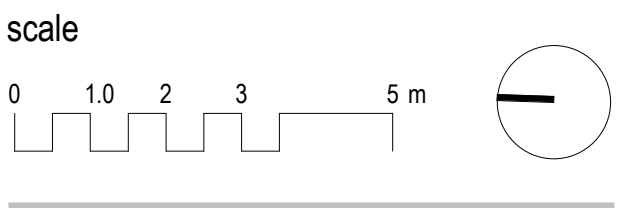


**FLOOR PLAN - GROUND
FLOOR - PROPOSED**

scale	project no.
1 : 100 @ A1	25.0236.17
revision	
B	
sheet no.	
CQU-ROK-036-GN-ARC-21-01	

ROK036 Level 1

5 Internal

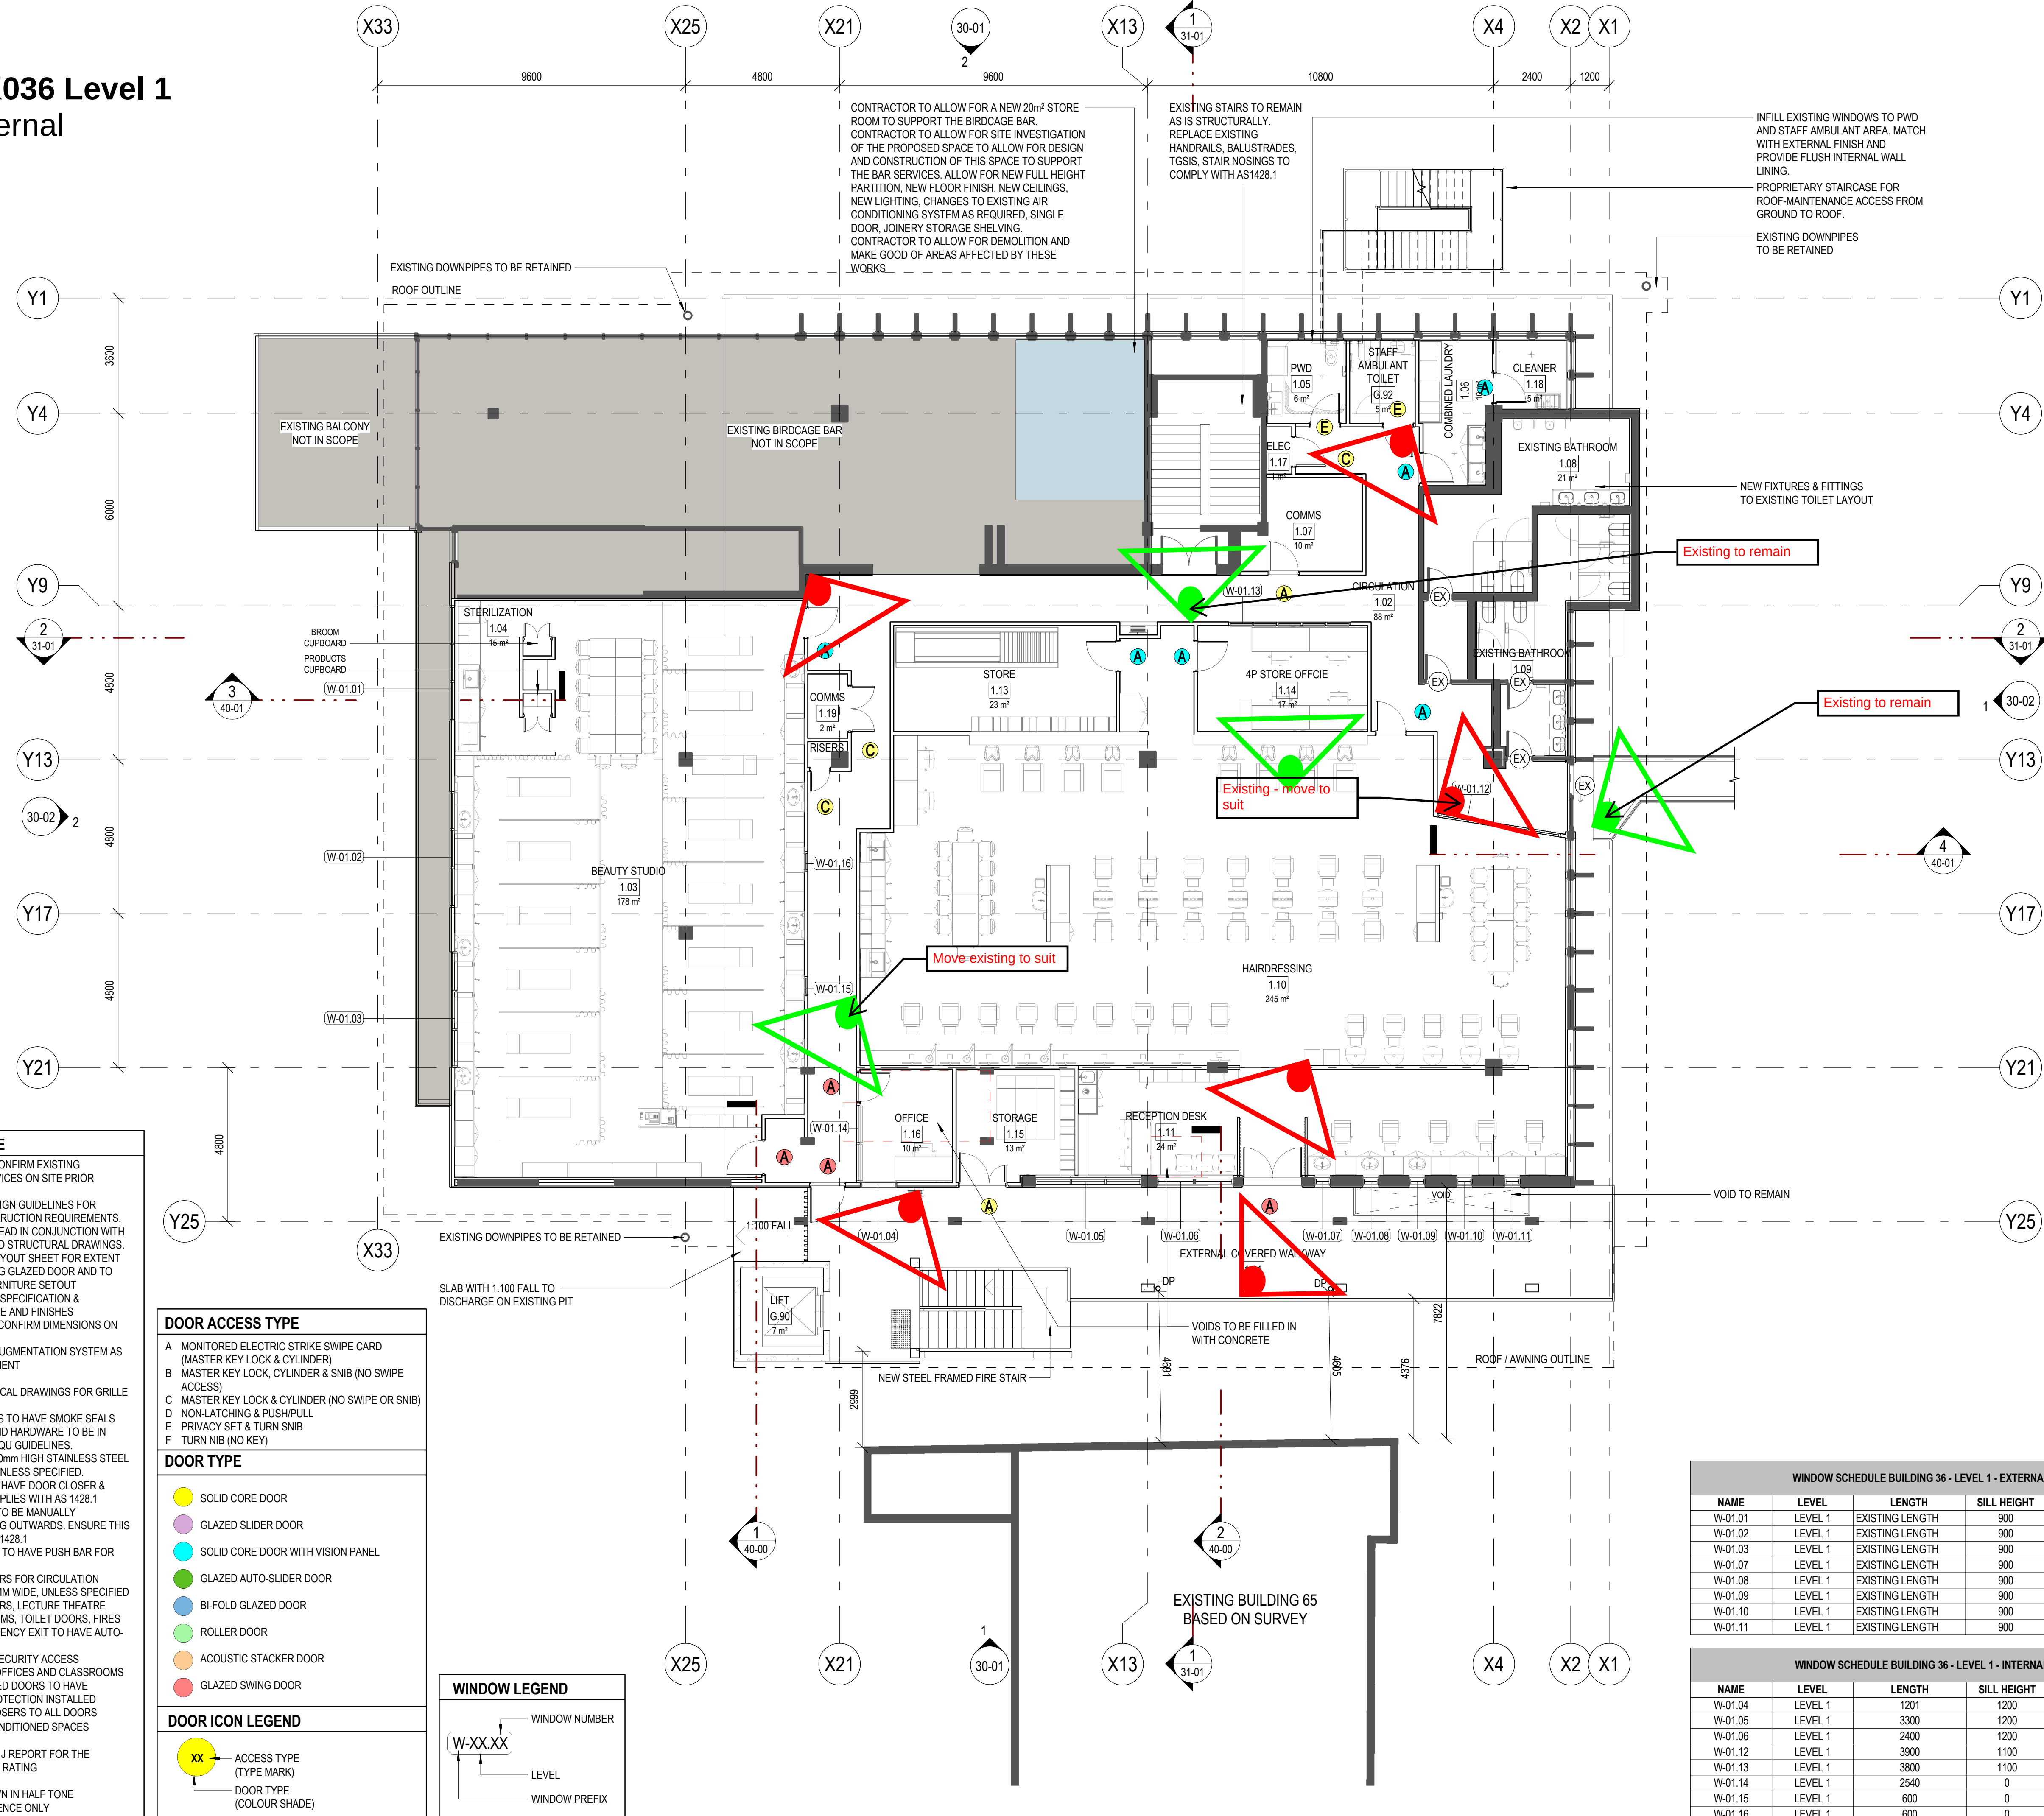

GENERAL NOTE

- CONTRACTOR TO CONFIRM EXISTING STRUCTURE & SERVICES ON SITE PRIOR BUILDING WORKS.
- REFER TO COU DESIGN GUIDELINES FOR DESIGN AND CONSTRUCTION REQUIREMENTS.
- DRAWINGS TO BE READ IN CONJUNCTION WITH SERVICES, CIVIL AND STRUCTURAL DRAWINGS
- REFER TO ROOM LAYOUT SHEET FOR EXTENT OF WORK INCLUDING GLAZED DOOR AND TO REFER FOR ALL FURNITURE SETOUT
- REFER TO OUTLINE SPECIFICATION & SCHEDULE FOR FF&E AND FINISHES
- CONTRACTORS TO CONFIRM DIMENSIONS ON SITE
- INSTALL HEARING AUGMENTATION SYSTEM AS PER NCC REQUIREMENT

DOOR NOTES

- REFER TO MECHANICAL DRAWINGS FOR GRILLS AND UNDERCUT
- ALL SERVICE DOORS TO HAVE SMOKE SEALS
- DOOR FUNCTION AND HARDWARE TO BE IN ACCORDANCE TO CGO GUIDELINES.
- DOORS TO HAVE 600mm HIGH STAINLESS STEEL TROLLEY PLATES, UNLESS SPECIFIED
- STAINLESS DOORS TO HAVE DOOR CLOSER & STOP, AND COMPLY WITH AS 1428.1
- EXTERNAL DOORS TO BE MANUALLY OPERATED, OPENING OUTWARDS. ENSURE THIS COMPLIES WITH AS 1428.1
- FIRE RATED DOORS TO HAVE PUSH BAR FOR EXIT.
- SINGLE SWING DOORS FOR CIRCULATION
- ACCESS TO BE 920mm WIDE, UNLESS SPECIFIED
- ALL EXTERNAL DOORS, LECTURE THEATRE DOORS, PLANT ROOMS, TOILET DOORS, FIRE DOORS AND EMERGENCY EXIT TO HAVE AUTO-CLOSERS
- CGO TO CONFIRM SECURITY ACCESS REQUIREMENT TO OFFICES AND CLASSROOMS
- EXTERNALLY LOCKED DOORS TO HAVE STRIKER PLATE PROTECTION INSTALLED
- PROVIDE DOOR CLOSERS TO ALL DOORS ENCLOSED AIR-CONDITIONED SPACES

WINDOW NOTES

- REFER TO SECTION J REPORT FOR THE REQUIRED GLAZING RATING
- EXTERNAL DETAILS
- SITE DETAILS SHOWN IN HALF TONE
 - NOTED FOR REFERENCE ONLY

DOOR ACCESS TYPE

- A MONITORED ELECTRIC STRIKE SWIPE CARD (MASTER KEY LOCK & CYLINDER)
- B MASTER KEY LOCK, CYLINDER & SNIB (NO SWIPE ACCESS)
- C MASTER KEY LOCK & CYLINDER (NO SWIPE OR SNIB)
- D NON-LATCHING & PUSH/PULL
- E PRIVACY SET & TURN SNIB
- F TURN NIB (NO KEY)


DOOR TYPE

-  SOLID CORE DOOR
-  GLAZED SLIDER DOOR
-  SOLID CORE DOOR WITH VISION PANEL
-  GLAZED AUTO-SLIDER DOOR
-  BI-FOLD GLAZED DOOR
-  ROLLER DOOR
-  ACOUSTIC STACKER DOOR
-  GLAZED SWING DOOR

DOOR ICON LEGEND

- XX — ACCESS TYPE
(TYPE MARK)
- DOOR TYPE
(COLOUR SHADE)

WINDOW LEGEND

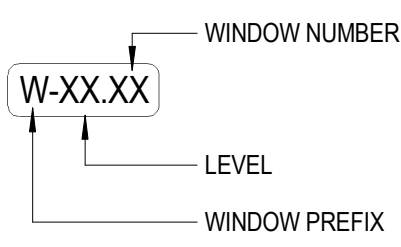

WINDOW SCHEDULE BUILDING 36 - LEVEL 1 - EXTERNAL				
NAME	LEVEL	LENGTH	SILL HEIGHT	OVERALL HEIGHT
W-01.01	LEVEL 1	EXISTING LENGTH	900	1500
W-01.02	LEVEL 1	EXISTING LENGTH	900	1500
W-01.03	LEVEL 1	EXISTING LENGTH	900	1500
W-01.07	LEVEL 1	EXISTING LENGTH	900	1500
W-01.08	LEVEL 1	EXISTING LENGTH	900	1500
W-01.09	LEVEL 1	EXISTING LENGTH	900	1500
W-01.10	LEVEL 1	EXISTING LENGTH	900	1500
W-01.11	LEVEL 1	EXISTING LENGTH	900	1500

WINDOW SCHEDULE BUILDING 36 - LEVEL 1 - INTERNAL				
NAME	LEVEL	LENGTH	SILL HEIGHT	OVERALL HEIGHT
W-01.04	LEVEL 1	1201	1200	1200
W-01.05	LEVEL 1	3300	1200	1200
W-01.06	LEVEL 1	2400	1200	1200
W-01.12	LEVEL 1	3900	1100	1600
W-01.13	LEVEL 1	3800	1100	1300
W-01.14	LEVEL 1	2540	0	2100
W-01.15	LEVEL 1	600	0	2100
W-01.16	LEVEL 1	600	0	2100

ISSUED FOR TENDER

thomson
adsett



PEDDLE THORP
architecture | interiors | health | planning

Telephone +61 7 3840 9999
bne@thomsonadsett.com
Level 9, 470 St Pauls Terrace
Fortitude Valley
Qld 4006 Australia
thomsonadsett.com

© Copyright
These drawings and designs and the copyright thereof are the property of Thomson Adsett Pty Ltd and must not be used, retained or copied without written permission of Thomson Adsett Pty Ltd. ABN 76 105 314 654 Trading as ThomsonAdsett. Dimensions take precedence over scaling. Do not measure off drawings as print sizes may vary

CQU ROCKHAMPTON TAFE CONSOLIDATION - STAGE 2

554/700 Yaamba Rd, Norman
Gardens QLD 4701

for




CQUniversity
AUSTRALIA

B	2026-03-05	UPDATED ISSUED FOR TENDER	BC
A	2026-02-12	ISSUED FOR TENDER	BC
4	2026-01-30	60% DRAFT ISSUE	BC
3	2026-01-23	CONSULTANTS ISSUE	BC
2	2025-12-19	UPDATED ISSUE	BC
1	2025-12-17	CONSULTANTS REVIEW	BC

rev	date	details	init.
-----	------	---------	-------

drawn	date
JS/BC	19/01/2026
checked	date
SS	12/02/2026
verified	date

scale

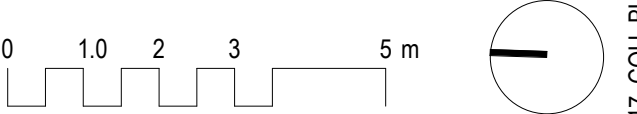

**FLOOR PLAN - LEVEL 1 -
PROPOSED**

scale project no.
1 : 100 @ A1 25.0236.17


B
sheet no.
CQU-ROK-036-01-ARC-21-02

original sheet size - A1 (594mm x 841mm)

6/03/2026 12:11:01 PM AUTODESK DOCS/CQU ROK 1AFE23.0236.17_CQU_BLDG-36_2023.M

ROK076
4 External mounted on surrounding buildings
(Locations yet to be confirmed)

CONTRACTOR TO ALLOW FOR
DEMOLITION OF EXISTING STRUCTURES
TO MAKE WAY FOR HORTICULTURE
DEPARTMENT. REFER TO SURVEY

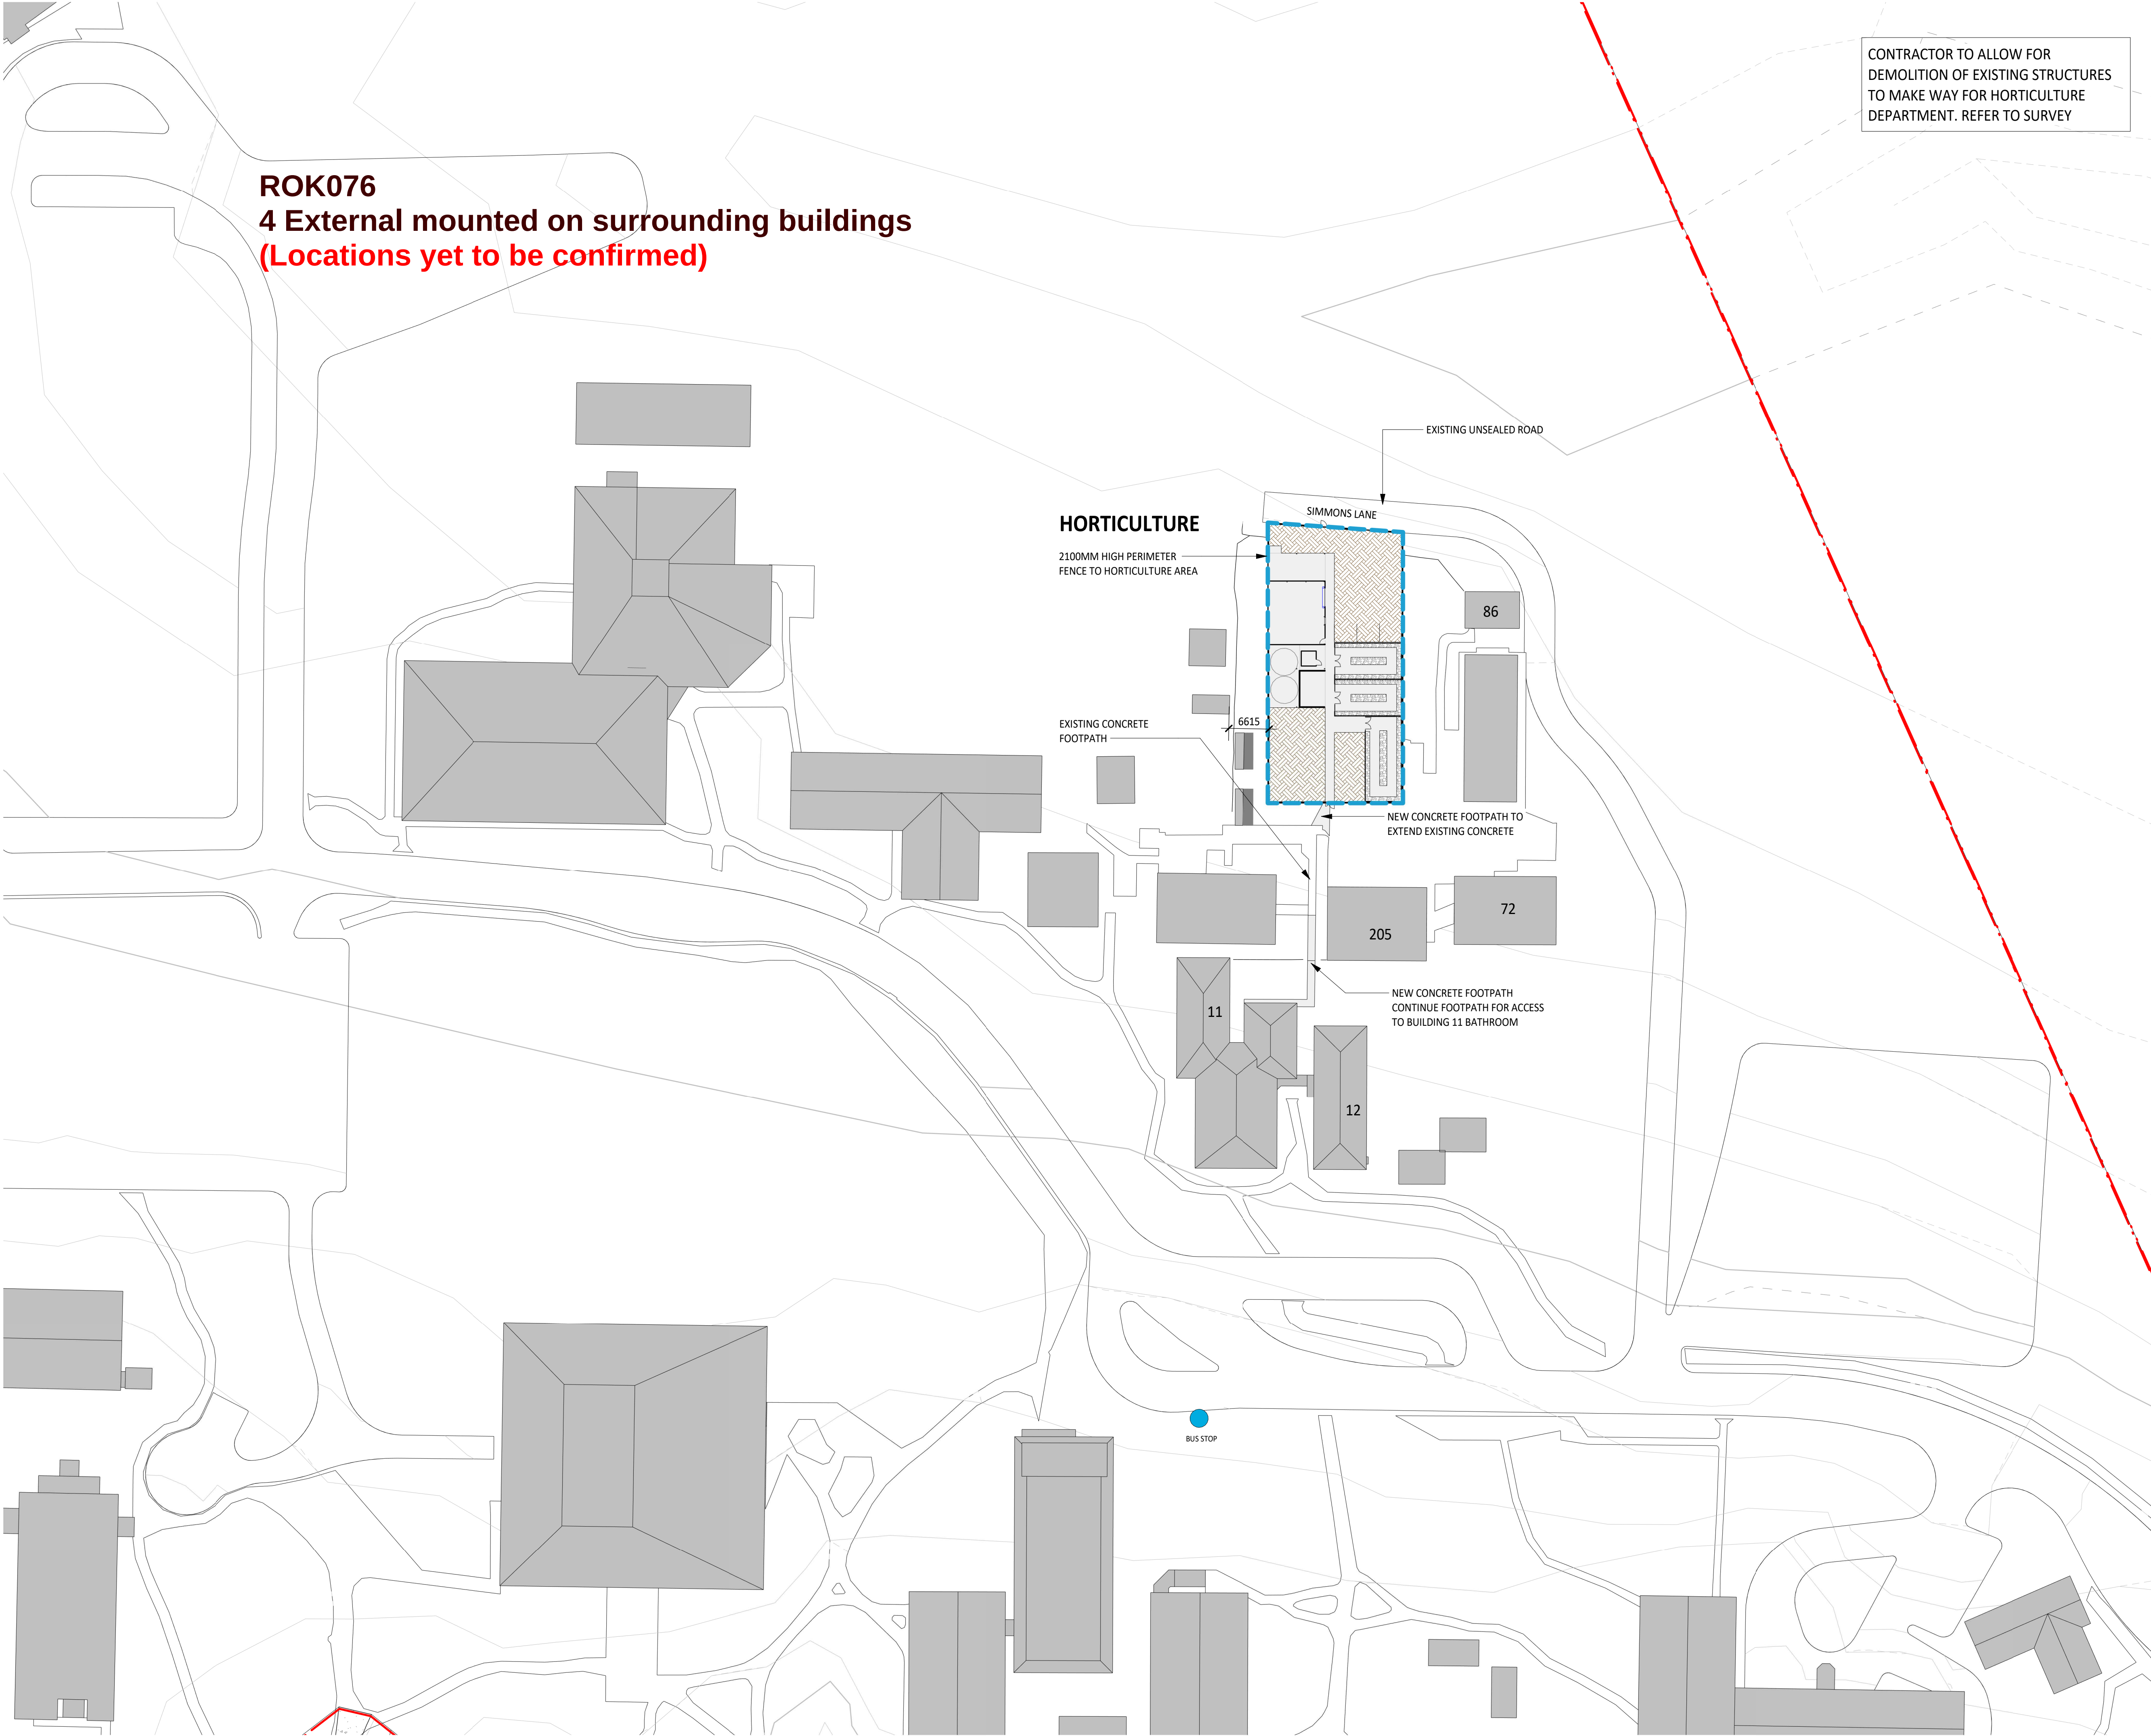

thomson
adsett

**PEDDLE THORP**
architecture | interiors | health | planning

Telephone +61 7 3840 9999
bne@thomsonadsett.com
Level 9, 470 St Pauls Terrace
Fortitude Valley
Qld 4006 Australia
thomsonadsett.com

© Copyright
These drawings and designs and the copyright thereof are the property of Thomson Adsett Pty Ltd and must not be used, retained or copied without written permission of Thomson Adsett Pty Ltd. ABN 76 105 314 654 Trading as ThomsonAdsett. Dimensions take precedence over scaling. Do not measure off drawings as print sizes may vary

CQU ROCKHAMPTON
TAFE

554/700 Yaamba Rd, Norman
Gardens QLD 4701


for

**CQUniversity**
AUSTRALIA

A	12/02/26	ISSUED FOR TENDER	BS
2	30/01/26	DRAFT 60% ISSUE	BS
1	19/12/25	ISSUED FOR COORDINATION	KM
rev\	date	details	init.

drawn	date
PT	19/12/25
checked	date
BS	19/12/25
verified	date
BS	19/12/25

scale

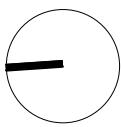

HORTICULTURE SITE PLAN

scale
1 : 500 @ A1

project no.
260018

revision
A

sheet no.
CQU-ROK-076-GN-ARC-10-00

ISSUED FOR TENDER

ROK092
12 External

ENGINEERING TECHNOLOGY BUILDING

GLENISTER SHEIL ROAD

YAAMBA ROAD

TRADES FACILITY BUILDING

MINING & MANUFACTURING FACILITY

- GENERAL NOTES
1. DO NOT SCALE DRAWINGS. FIGURED DIMENSIONS HAVE PREFERENCE OVER SCALED DIMENSIONS.
 2. ANY DISCREPANCIES MUST BE REPORTED IMMEDIATELY TO THE SUPERINTENDENT.
 3. THESE DRAWINGS ARE TO BE READ IN CONJUNCTION WITH THE DETAILS, SPECIFICATIONS AND ENGINEERING DOCUMENTS.
 4. LOCATE AND PROTECT ALL UNDERGROUND SERVICES PRIOR TO ANY EXCAVATION. MAKE GOOD ALL DAMAGE TO EXISTING WORKS CAUSED BY THE ACTIVITY OF THESE WORKS.
 5. THESE DRAWINGS ARE TO BE PRINTED IN COLOUR.
- These designs, plans and specifications and the copyright therein are the property of TRACT CONSULTANTS PTY. LTD. and must not be used, reproduced or copied, wholly or in part, without the written permission of TRACT CONSULTANTS PTY. LTD.

60% DD
NOT FOR CONSTRUCTION

REV	DESCRIPTION	DATE	DRWN	CHKD
1	Revision 1	Date 1	STa	BM
2	Draft Issue	30/01/2026	STa	BM
3	60% DD	11/02/2026	STa	BM

Tract
Landscape Architects
Urban Designers
Town Planners

Melbourne P: 03 9429 6133
Brisbane P: 07 3002 6400
Sydney P: 02 9954 3733
Geelong P: 03 5221 0105
Adelaide P: 08 8223 1324

www.tract.com.au

PROJECT
CENTRAL QUEENSLAND UNIVERSITY
(CQU) ROCKHAMPTON NORTH
CAMPUS

CLIENT
CENTRAL QUEENSLAND UNIVERSITY
(CQU)

DRAWING TITLE
GENERAL ARRANGEMENT PLAN -
OVERALL

DRAWING NUMBER
725-0085-L-00-DR300

REVISION
3

DRAWN
STa

CHECKED
BM

APPROVED
BM


DATE
11/02/2026

SCALE 1:200

A1

0 2 4 10

ROK092 Level G
6 Internal (plus 1 additional)

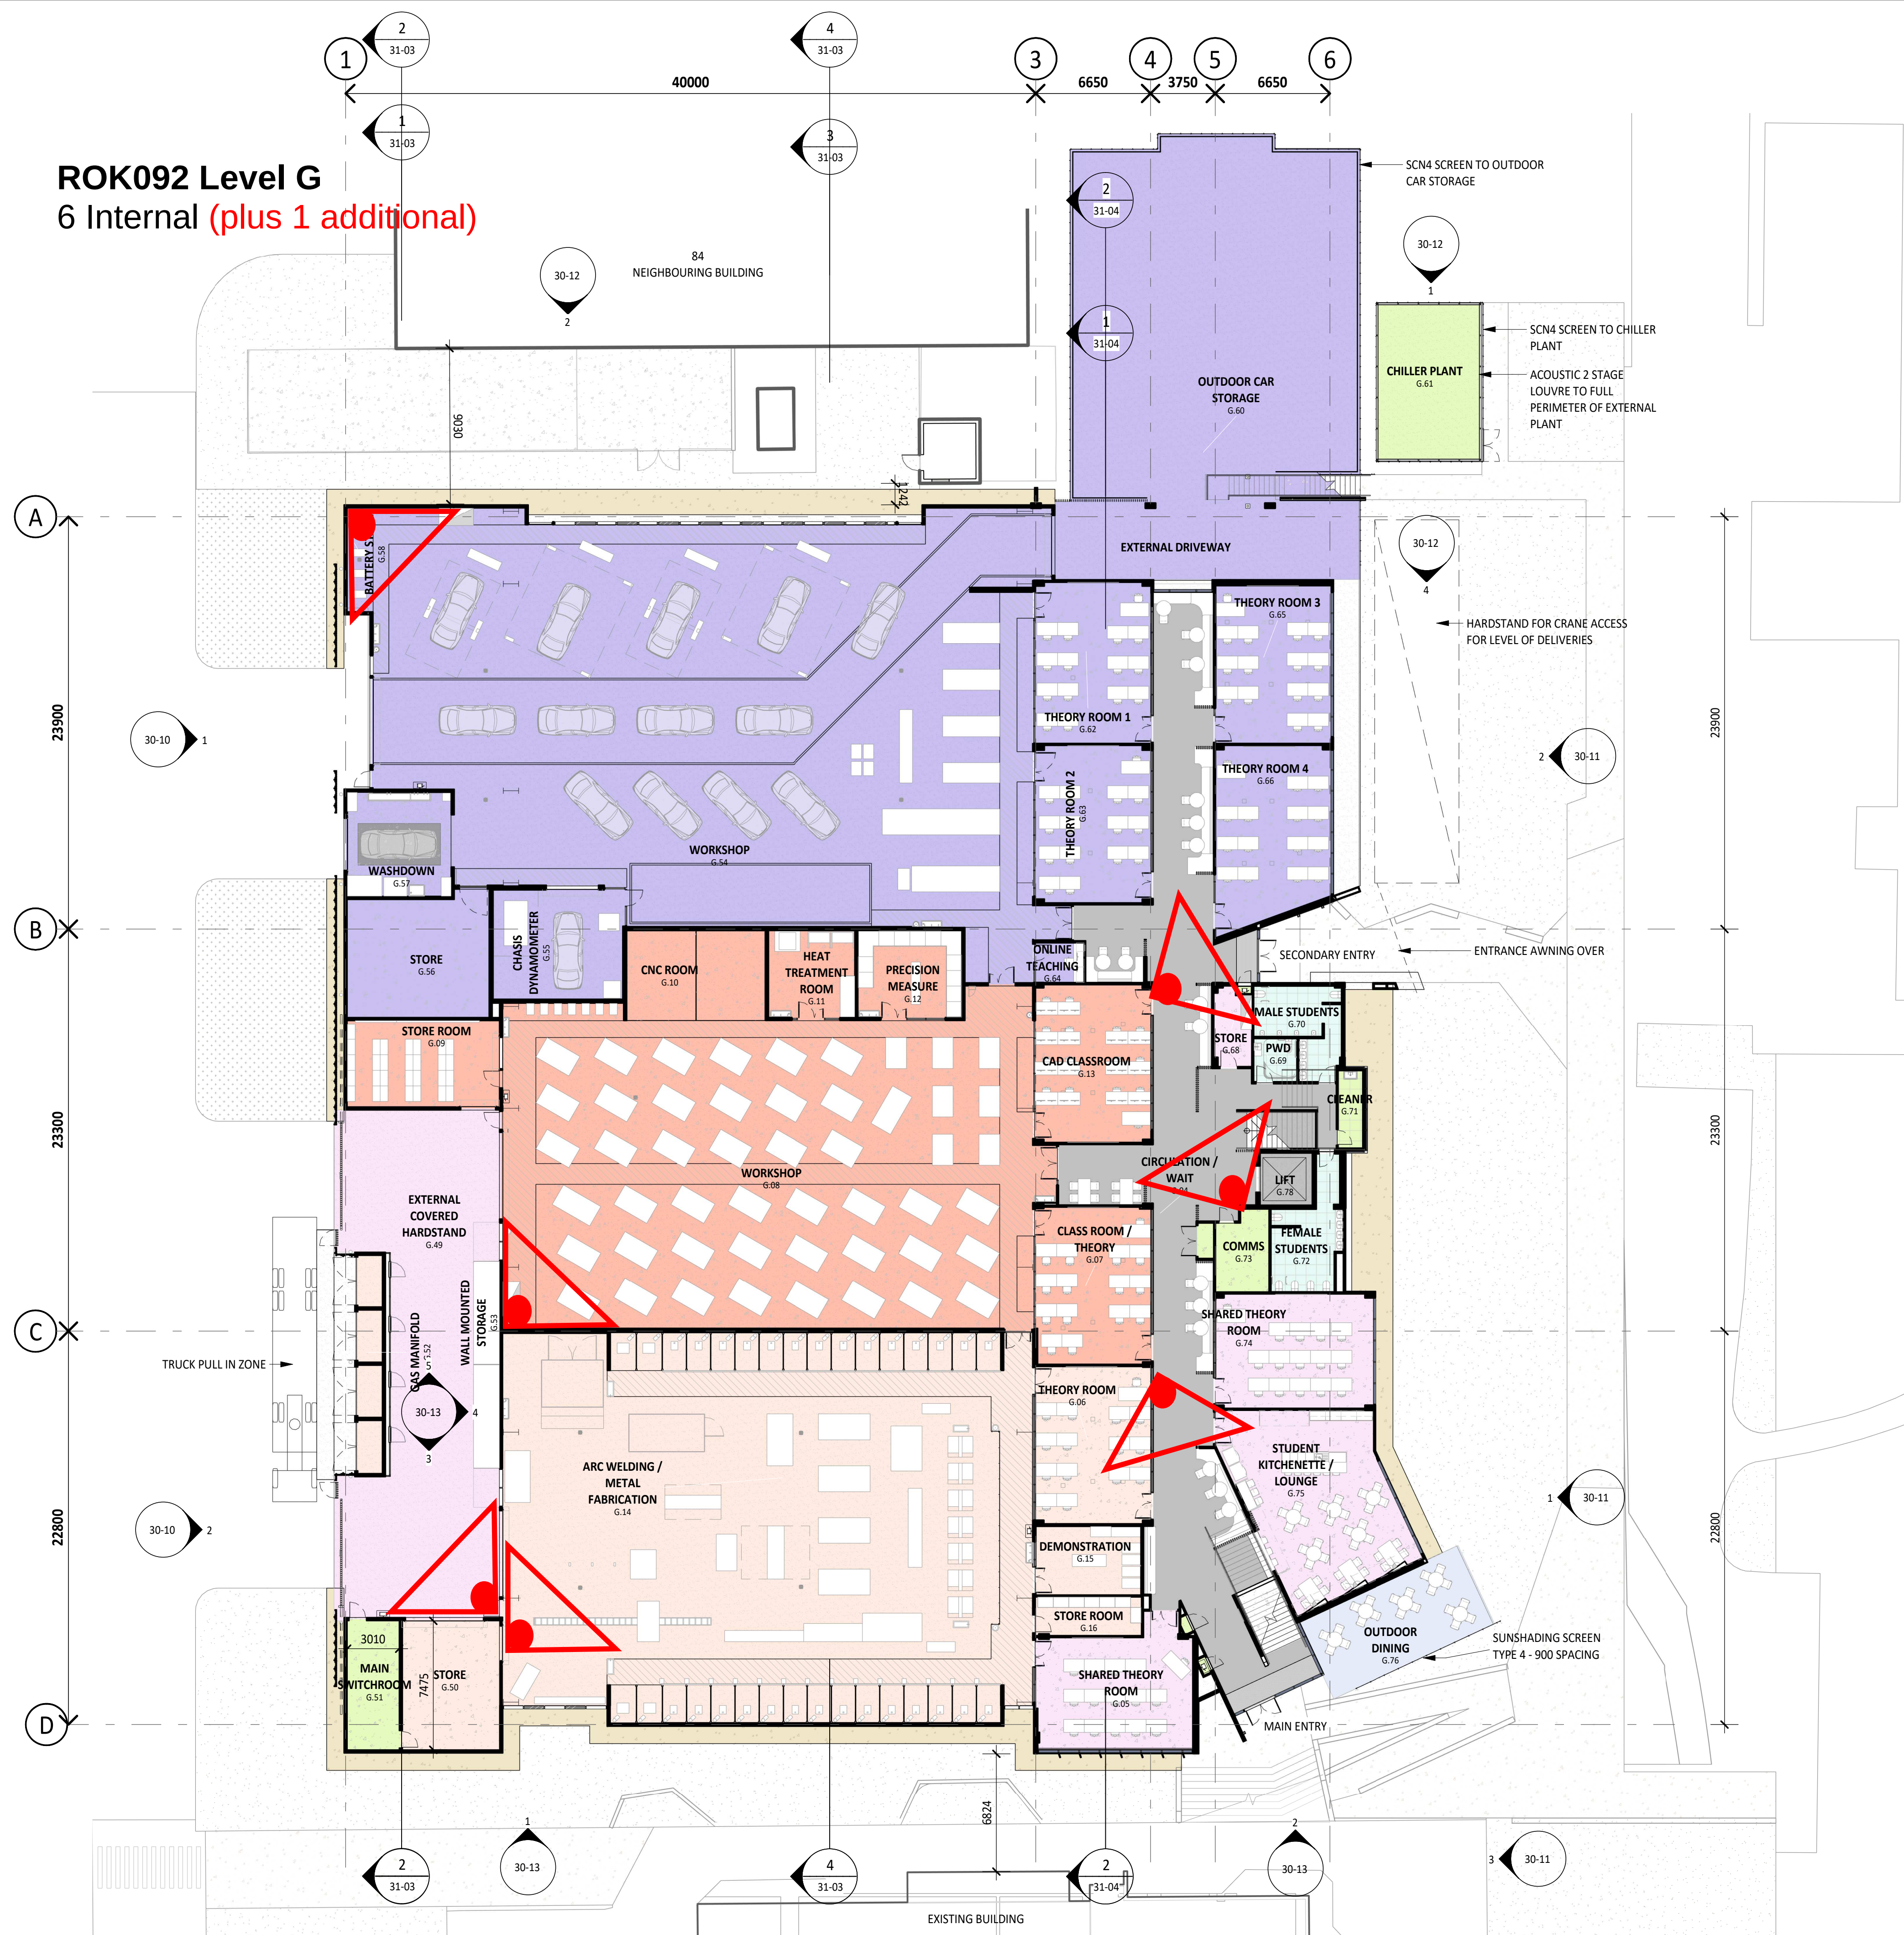

DEPARTMENT COLOUR LEGEND

- AMENITIES
- CIRCULATION
- FITTING & MACHINING
- LIGHT AUTOMOTIVE + AUTO ELECTRICS
- METAL FABRICATION
- OUTDOOR
- SERVICES
- SHARED

thomson
adsett



Telephone +61 7 3840 9999
bne@thomsonadsett.com
Level 9, 470 St Pauls Terrace
Fortitude Valley
Qld 4006 Australia
thomsonadsett.com

© Copyright
These drawings and designs and the copyright thereof are the property of Thomson Adsett Pty Ltd and must not be used, retained or copied without written permission of Thomson Adsett Pty Ltd. ABN 76 105 314 654 Trading as ThomsonAdsett. Dimensions take precedence over scaling. Do not measure off drawings as print sizes may vary

**CQU ROCKHAMPTON
TAFE
CONSOLIDATION -
STAGE 2**

554/700 Yaamba Rd, Norman
Gardens QLD 4701

for




A	12/02/26	ISSUED FOR TENDER	BS
8	30/01/26	DRAFT 60% ISSUE	BS
7	23/01/26	COORDINATION ISSUE FOR CONSULTANTS	BS
6	19/12/25	ISSUE FOR COORDINATION	BS
5	24/11/25	50% COSTING ISSUE	BS
4	18/11/25	USER GROUP PRESENTATION	
3	14/11/25	USER GROUP PRESENTATION	SG
2	13/11/25	USER GROUP PRESENTATION	SG
1	12/11/25	USER GROUP PRESENTATION	SG

rev	date	details	init.
-----	------	---------	-------

drawn	date
PT	19/12/25
checked	date
use 'Approved By' only	19/12/25
verified	date
BS	19/12/25

scale

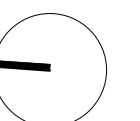

GA PLAN GROUND LEVEL

scale
1 : 200 @ A1

project no.
260018

revision
A

sheet no.
CQU-ROK-092-GN-ARC-21-00

ISSUED FOR TENDER

original sheet size - A1 (594mm x 841mm)

2/02/2026 4:32:20 PM Autodesk Docs://CQU ROK TAFE/260018_A_CQ-UNIVERSITY_BLD-TRADES_R25.nt

ROK092 Level 1
4 Internal



DEPARTMENT COLOUR LEGEND

- AMENITIES
- CIRCULATION
- DEPARTMENT 20
- OUTDOOR
- REFRIDGERATION
- SERVICES
- SHARED
- STAFF

© Copyright
These drawings and designs and the copyright thereof are the property of Thomson Adsett Pty Ltd and must not be used, retained or copied without written permission of Thomson Adsett Pty Ltd. ABN 76 105 314 654 Trading as ThomsonAdsett. Dimensions take precedence over scaling. Do not measure off drawings as print sizes may vary

CQU ROCKHAMPTON
TAFE
CONSOLIDATION -
STAGE 2

554/700 Yaamba Rd, Norman
Gardens QLD 4701



A	12/02/26	ISSUED FOR TENDER	BS
8	30/01/26	DRAFT 60% ISSUE	BS
7	23/01/26	COORDINATION ISSUE FOR CONSULTANTS	BS
6	19/12/25	ISSUE FOR COORDINATION	BS
5	24/11/25	50% COSTING ISSUE	BS
4	18/11/25	USER GROUP PRESENTATION	
3	14/11/25	USER GROUP PRESENTATION	SG
2	13/11/25	USER GROUP PRESENTATION	SG
1	12/11/25	USER GROUP PRESENTATION	SG

rev	date	details	init.
-----	------	---------	-------

drawn	date
PT	19/12/25
checked	date
BS	19/12/25
verified	date
BS	19/12/25

scale

GA PLAN LEVEL 01

scale	project no.
1 : 200 @ A1	260018
revision	
A	
sheet no.	
CQU-ROK-092-01-ARC-21-10	

ISSUED FOR TENDER